


FED. ROAD DIST. NO.	STATE	PROJ. NO.	FISCAL YEAR	SHEET NO.	TOTAL SHEETS
HAWAII	HAW.	50C-01-99	2000	5	10

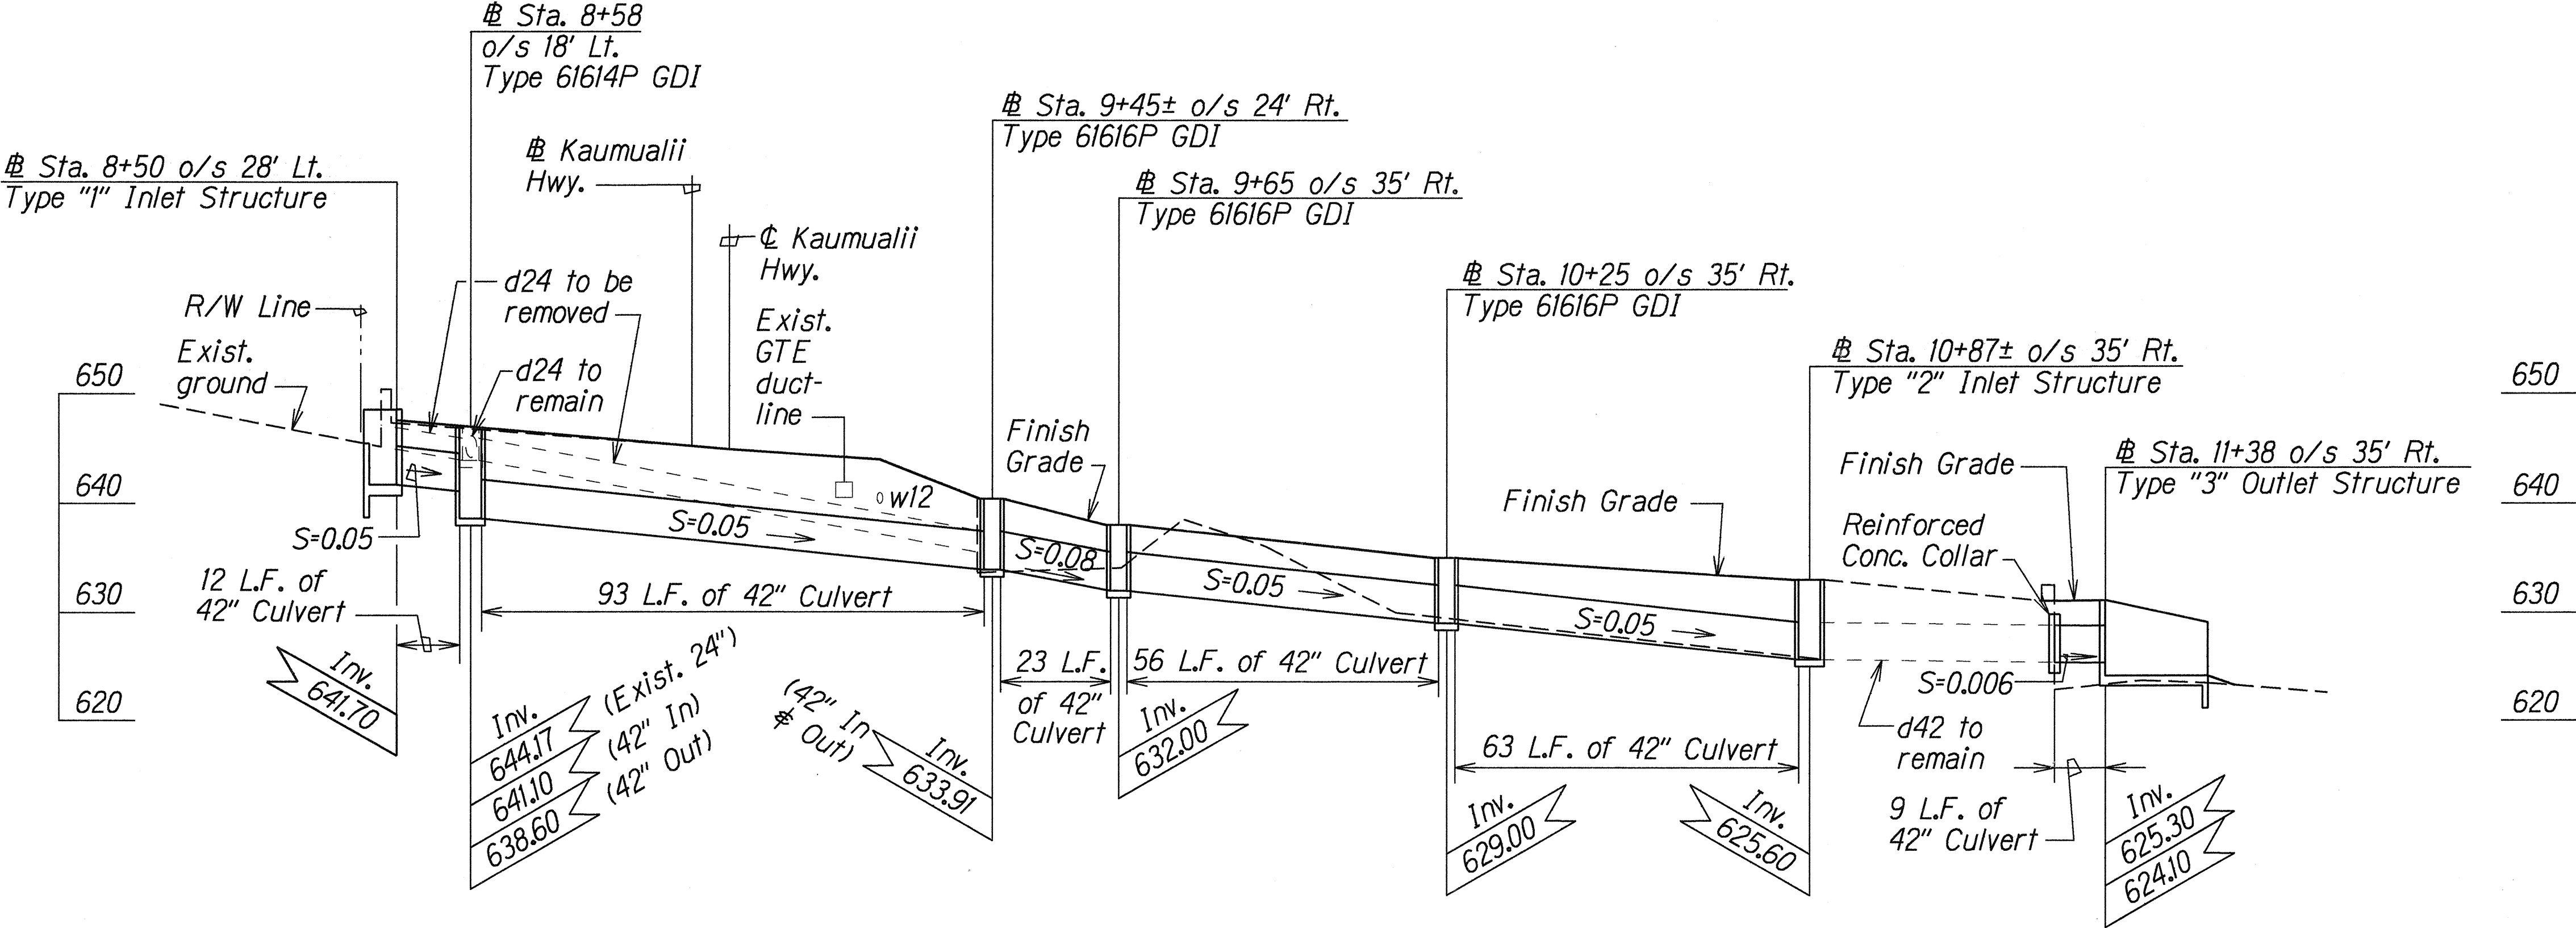

CL PROFILE-FROM # STA. 8+50 o/s 28' LT. TO # STA. 11+38 o/s 35' RT.
 Scale: Horiz. 1"=20'
 Vert. 1"=10'

Note: Finish Grade of GDI and swale established to meet 6:1 slope from shoulder pavement edge to GDI and bottom of swale.

SURVEY PLOTTED BY	DATE
DRAWN BY A. Noma	10/19/99
TRACED BY B. Kawamura	
NOTE BOOK	
QUANTITIES BY	
CHECKED BY	

APPROVED:
Edward F. Schupp
 MANAGER & CHIEF ENGINEER, DEPARTMENT OF WATER
 DATE 1/25/00

STATE OF HAWAII
DEPARTMENT OF TRANSPORTATION
HIGHWAYS DIVISION

DRAINAGE PROFILE

KAUMUALII HWY. DRAINAGE IMPROVEMENTS

Vicinity of Hokua Road

Project No. 50C-01-99

Scale: As Shown Date: Oct. 1999

SHEET No. H2 OF 7 SHEETS

"AS-BUILT"