	INDEX TO DRAWINGS
SHEET NO.	DESCRIPTION
1	TITLE SHEET
2	STANDARD PLANS SUMMARY
3	GENERAL NOTES AND LEGEND
4	DRAINAGE PLAN
5	DRAINAGE PROFILE
6–10	DRAINAGE DETAILS

JAN. 2000 DATE

STATE OF HAWAII

DEPARTMENT OF TRANSPORTATION

HIGHWAYS DIVISION HONOLULU, HAWAII


"AS-BUILT"

PLANS FOR

KAUMUALII HIGHWAY DRAINAGE IMPROVEMENTS


VICINITY OF HOKUA ROAD PROJECT NO. 50C-01-99


> DISTRICT OF KOLOA ISLAND OF KAUAI

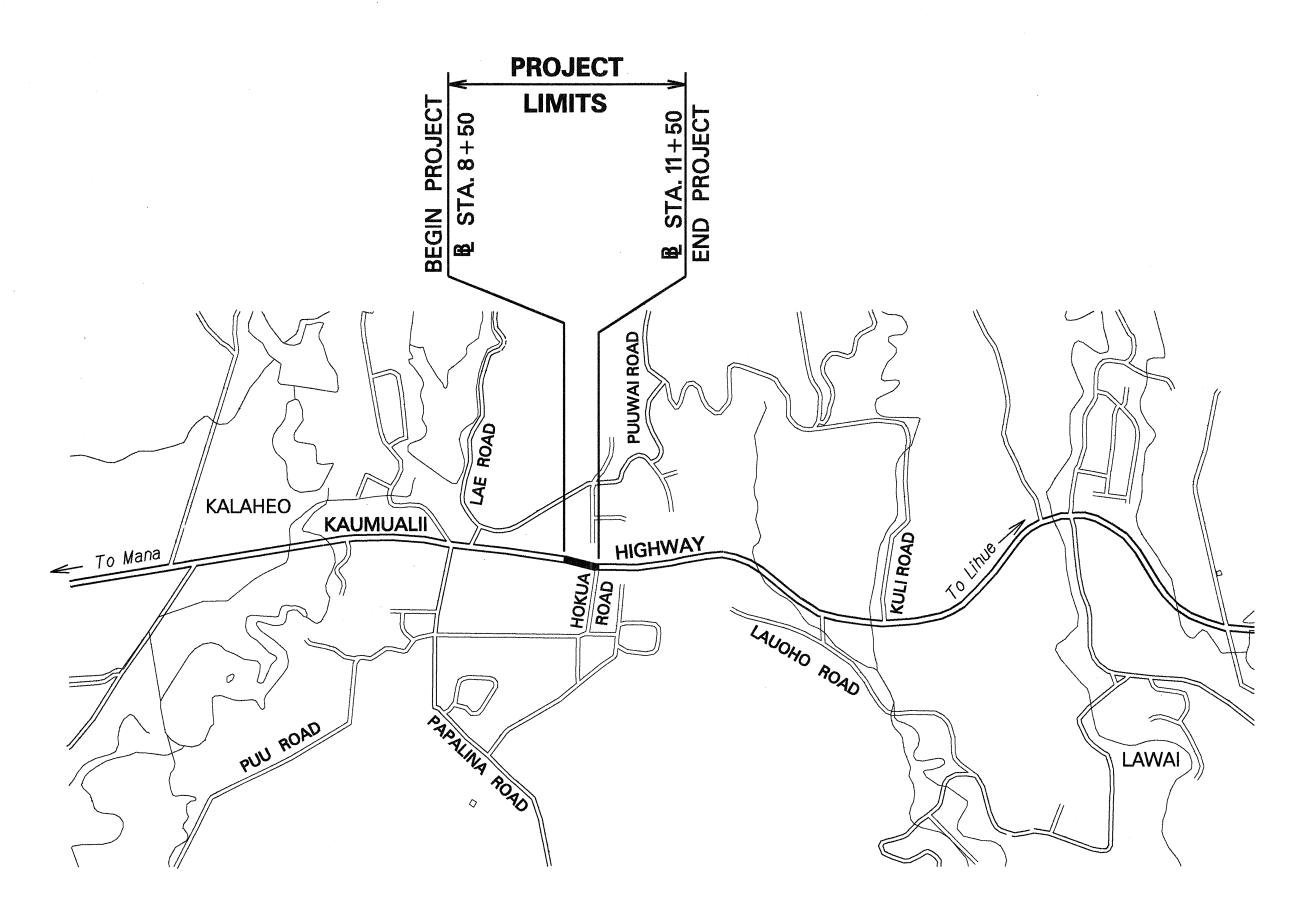

FED. ROAD DIST. NO. PROJ. NO. 50C-01-99



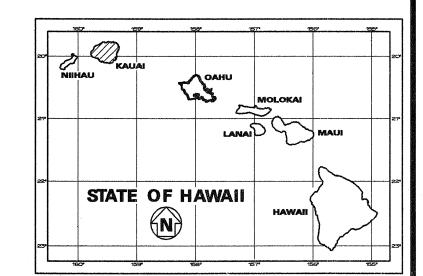

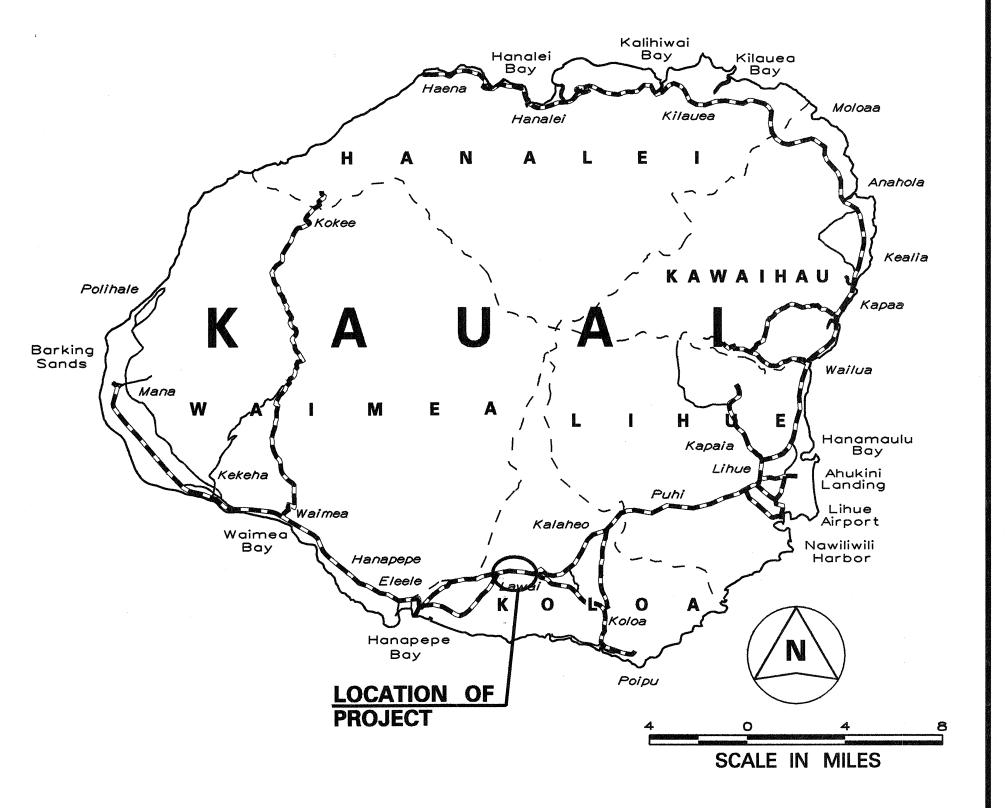

FEDERAL AID PROJECTS PREVIOUSLY CONSTRUCTED OR UNDER CONSTRUCTION

MILE POST 11.55 TO MILE POST 11.49

SCALE IN THOUSAND FEET

LAYOUT PLAN

LENGTH OF PROJECT.....0.06 MILES

 $\{N\}$

APPROVED: 1/25/00 DATE MANAGER & CHIEF ENGINEER, DEPARTMENT OF WATER

DEPARTMENT OF TRANSPORTATION STATE OF HAWAII

APPROVED: Kann Bayacheda DATE

DIR. OF TRANSPORTATION