



FED. ROAD DIST. NO.	STATE	PROJ. NO.	FISCAL YEAR	SHEET NO.	TOTAL SHEETS
HAWAII	HAW.	50C-01-00M	2000	13	24

BEGIN PROJECT
Project No. 50C-01-00M
P.T. Sta. 94+85.51

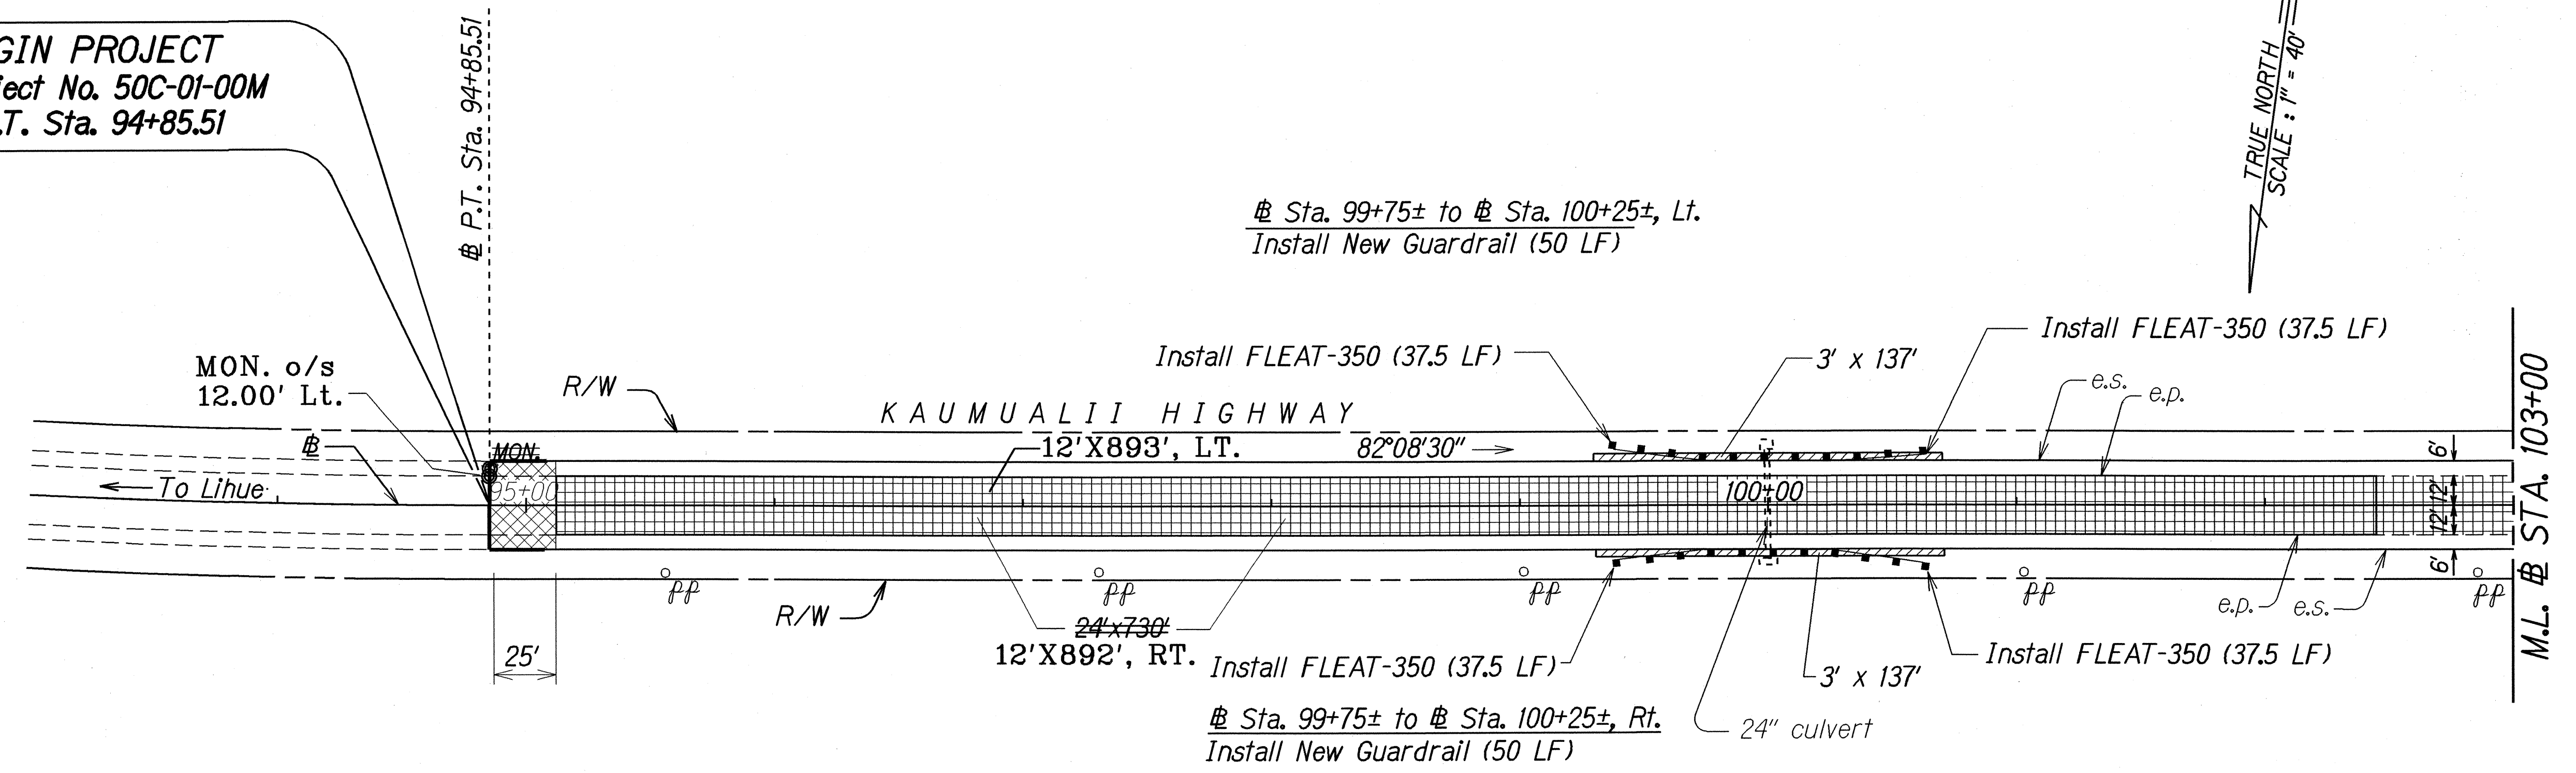

CURVE DATA
 $\Delta = 06^\circ 28' 30''$
 $R = 3,000.00'$
 $T = 169.70'$
 $C = 338.85'$
 $L_c = 339.03'$

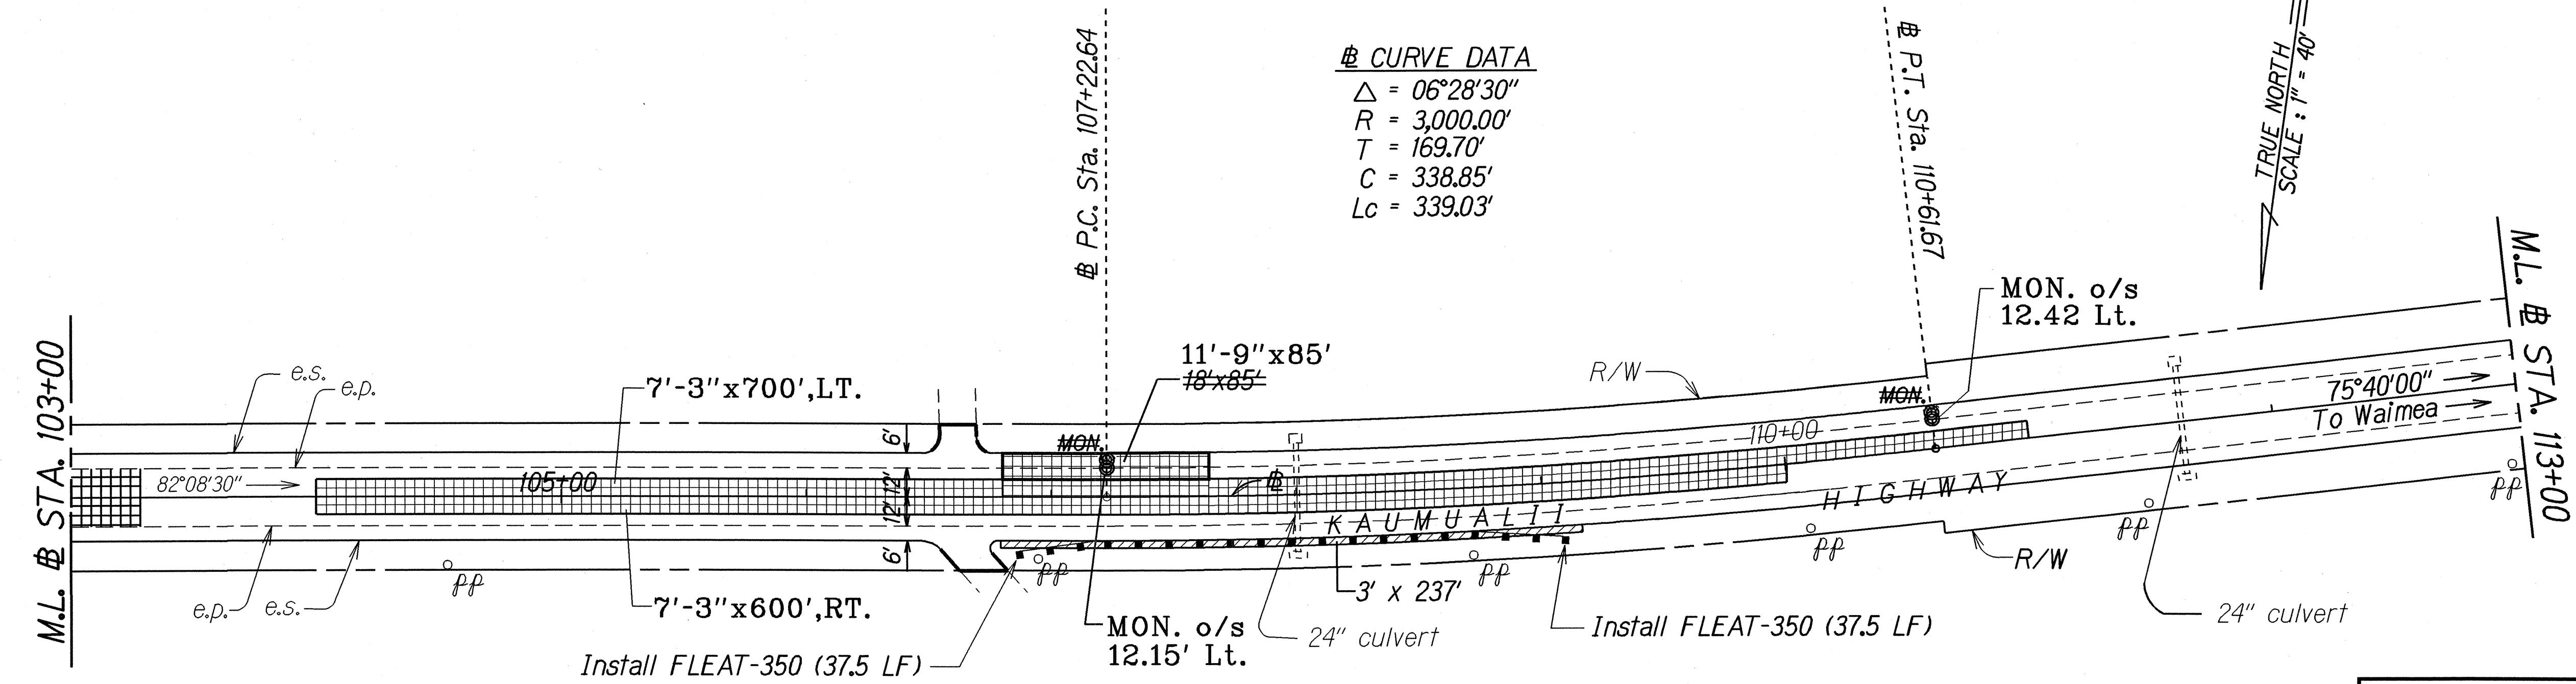

LEGEND FOR AS-BUILT POSTINGS

	Squiggly line for as-built deletion
	Double line for as-built deletion
Roadway	Text for as-built posting

STATE OF HAWAII
DEPARTMENT OF TRANSPORTATION
HIGHWAYS DIVISION

ROADWAY PLAN
KAUMUALII HIGHWAY RESURFACING
Vicinity of Wahiawa Bridge
to Laulea Street
Project No. 50C-01-00M



Scale: 1"=40' Date: April, 2000

SHEET No. 1 OF 4 SHEETS

ORIGINAL PLAN	DATE: 4/28/00
SURVEY PLOTTED BY: [Signature]	
DRAWN BY: [Signature]	
NOTE BOOK: [Signature]	
QUANTITIES BY: [Signature]	
CHECKED BY: [Signature]	

"AS-BUILT"

FED. ROAD DIST. NO.	STATE	PROJ. NO.	FISCAL YEAR	SHEET NO.	TOTAL SHEETS
HAWAII	HAW.	50C-01-00M	2000	14	24

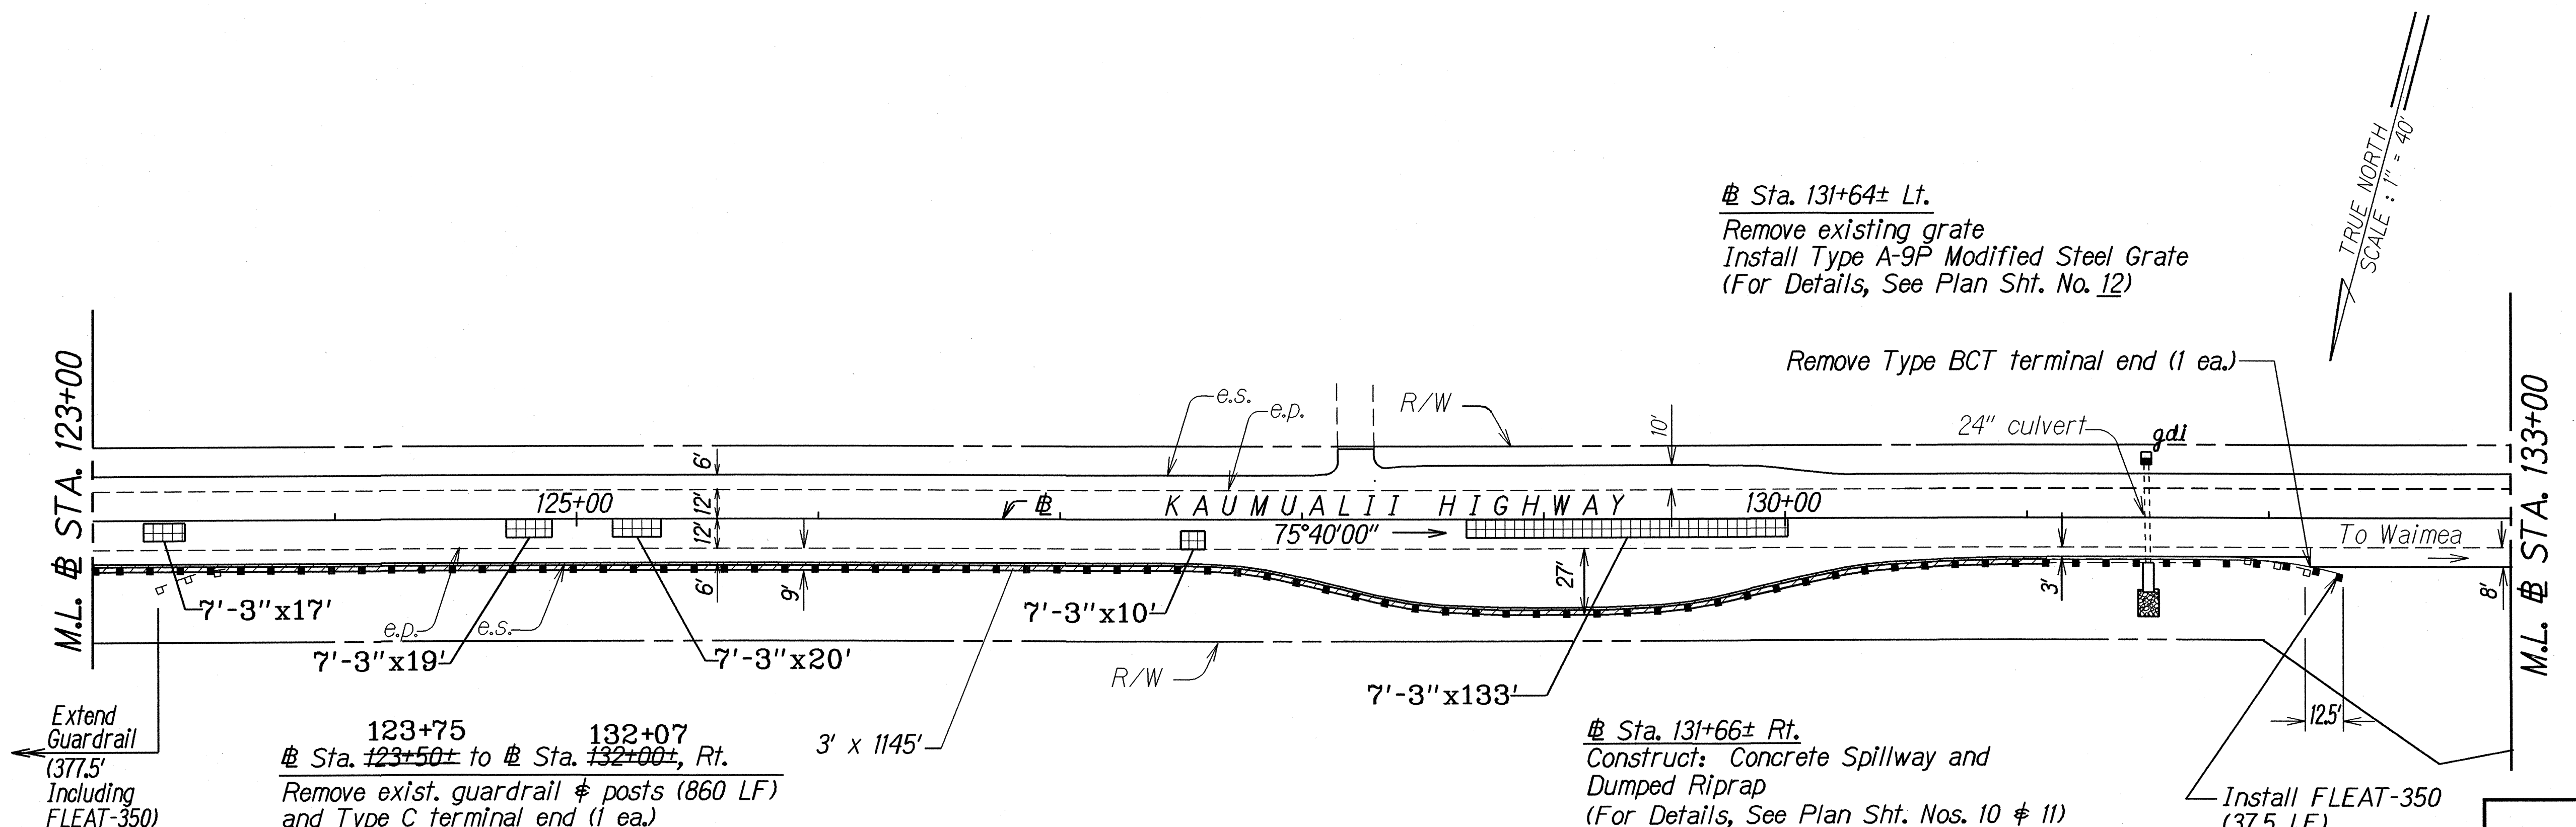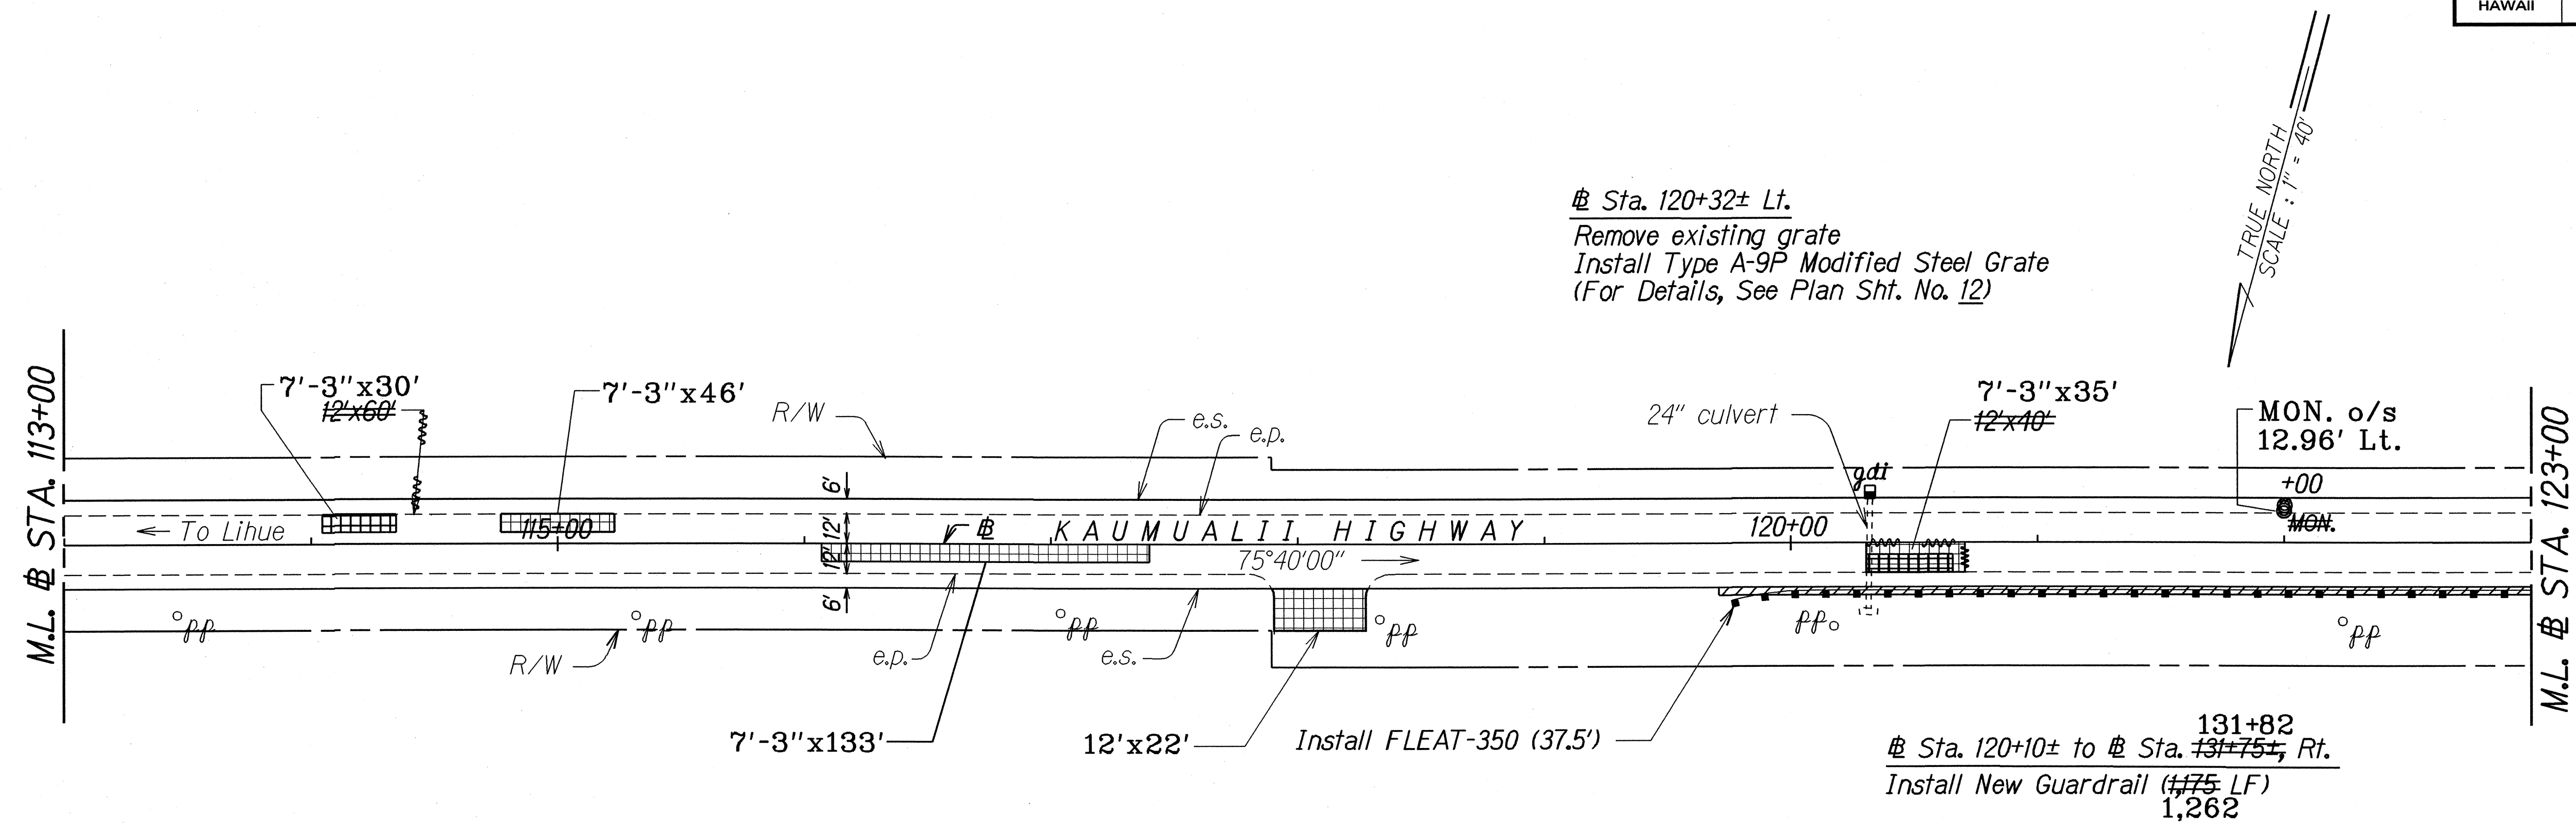

LEGEND FOR AS-BUILT POSTINGS	
	Squiggly line for as-built deletion
	Double line for as-built deletion
	Text for as-built posting

Estimated Quantities	
Embankment	= 10 C.Y.
Concrete for Outlet Structure	= 5 C.Y.
Dumped Riprap	= 8 C.Y.
Aggregate Base	= 10 C.Y.

STATE OF HAWAII
DEPARTMENT OF TRANSPORTATION
HIGHWAYS DIVISION


ROADWAY PLAN

KAUMUALII HIGHWAY RESURFACING
Vicinity of Wahiawa Bridge
to Laulea Street
Project No. 50C-01-00M


Scale: 1"=40'
Date: April, 2000

SURVEY PLOTTED BY	DATE
DRAWN BY	4/24/00
TRACED BY	
CHECKED BY	
NOTED BY	
QUANTITIES BY	
CHECKED BY	

FED. ROAD DIST. NO.	STATE	PROJ. NO.	FISCAL YEAR	SHEET NO.	TOTAL SHEETS
HAWAII	HAW.	50C-01-00M	2000	16	24

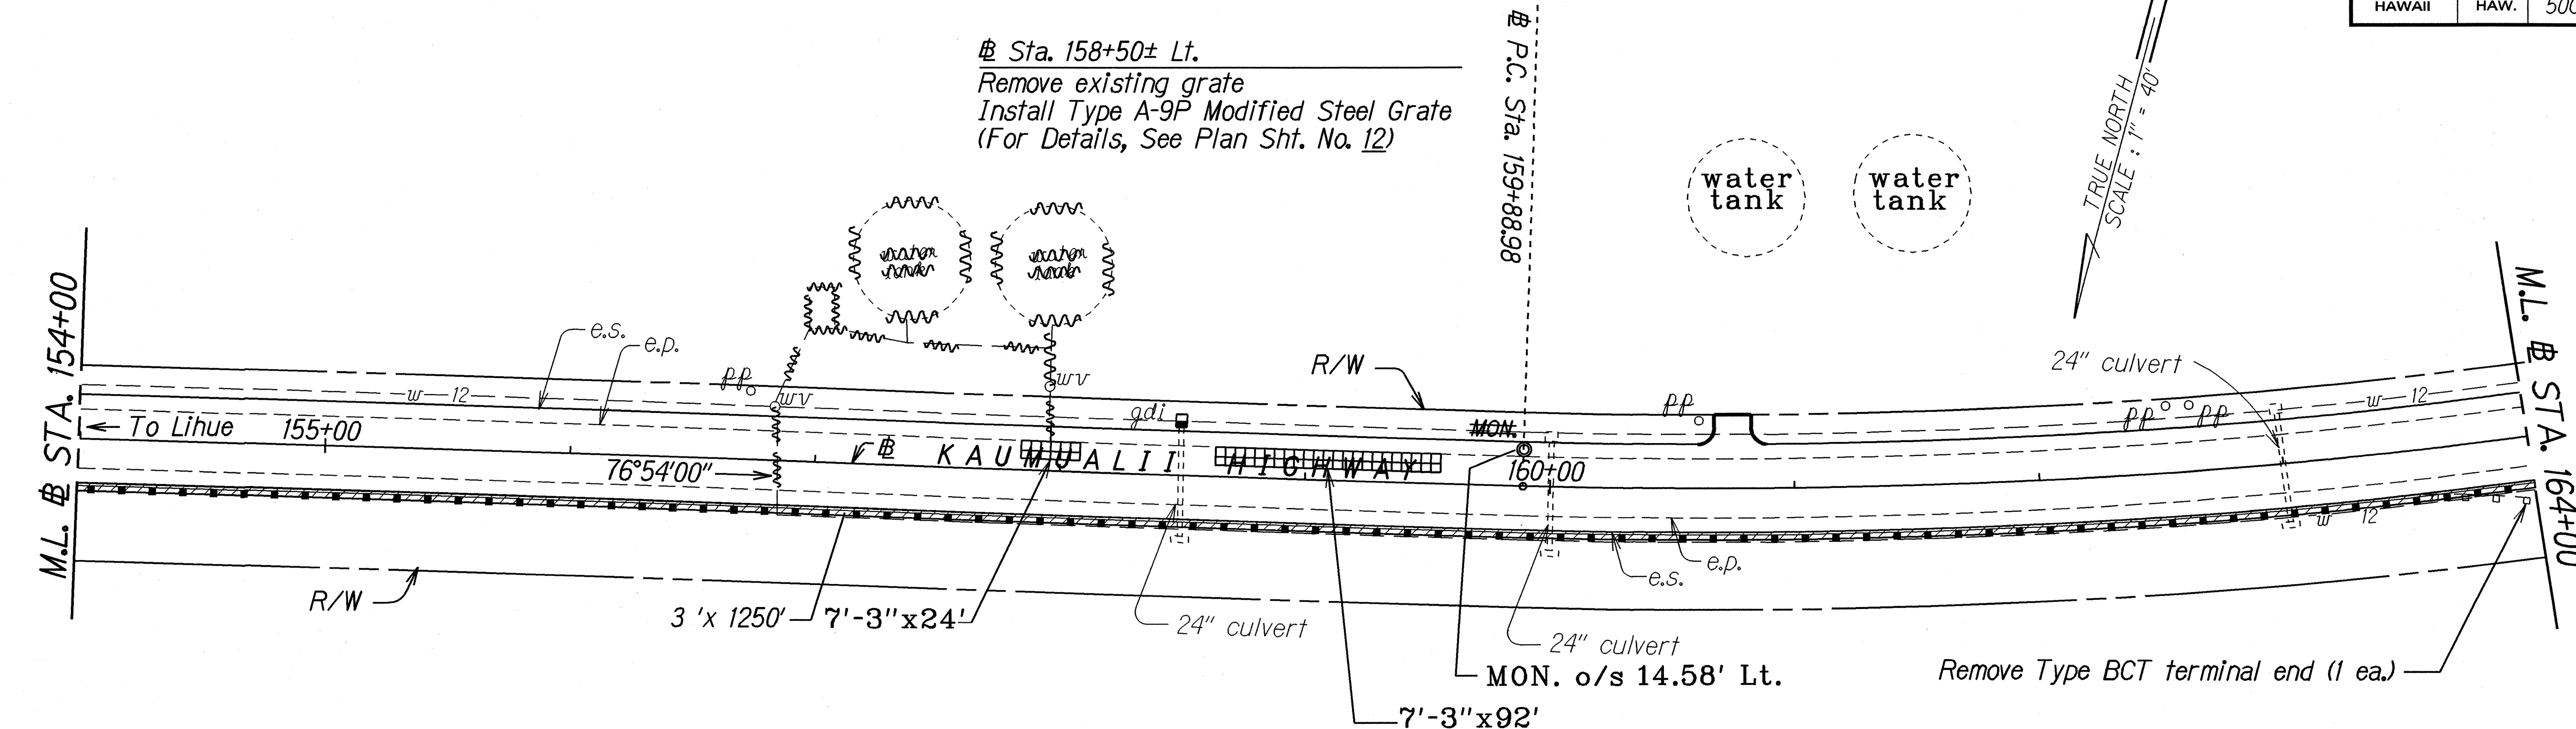

CURVE DATA
 $\Delta = 30^\circ 13' 00''$
 $R = 2500'$
 $T = 674.94'$
 $C = 1303.22'$
 $L_c = 1318.45'$

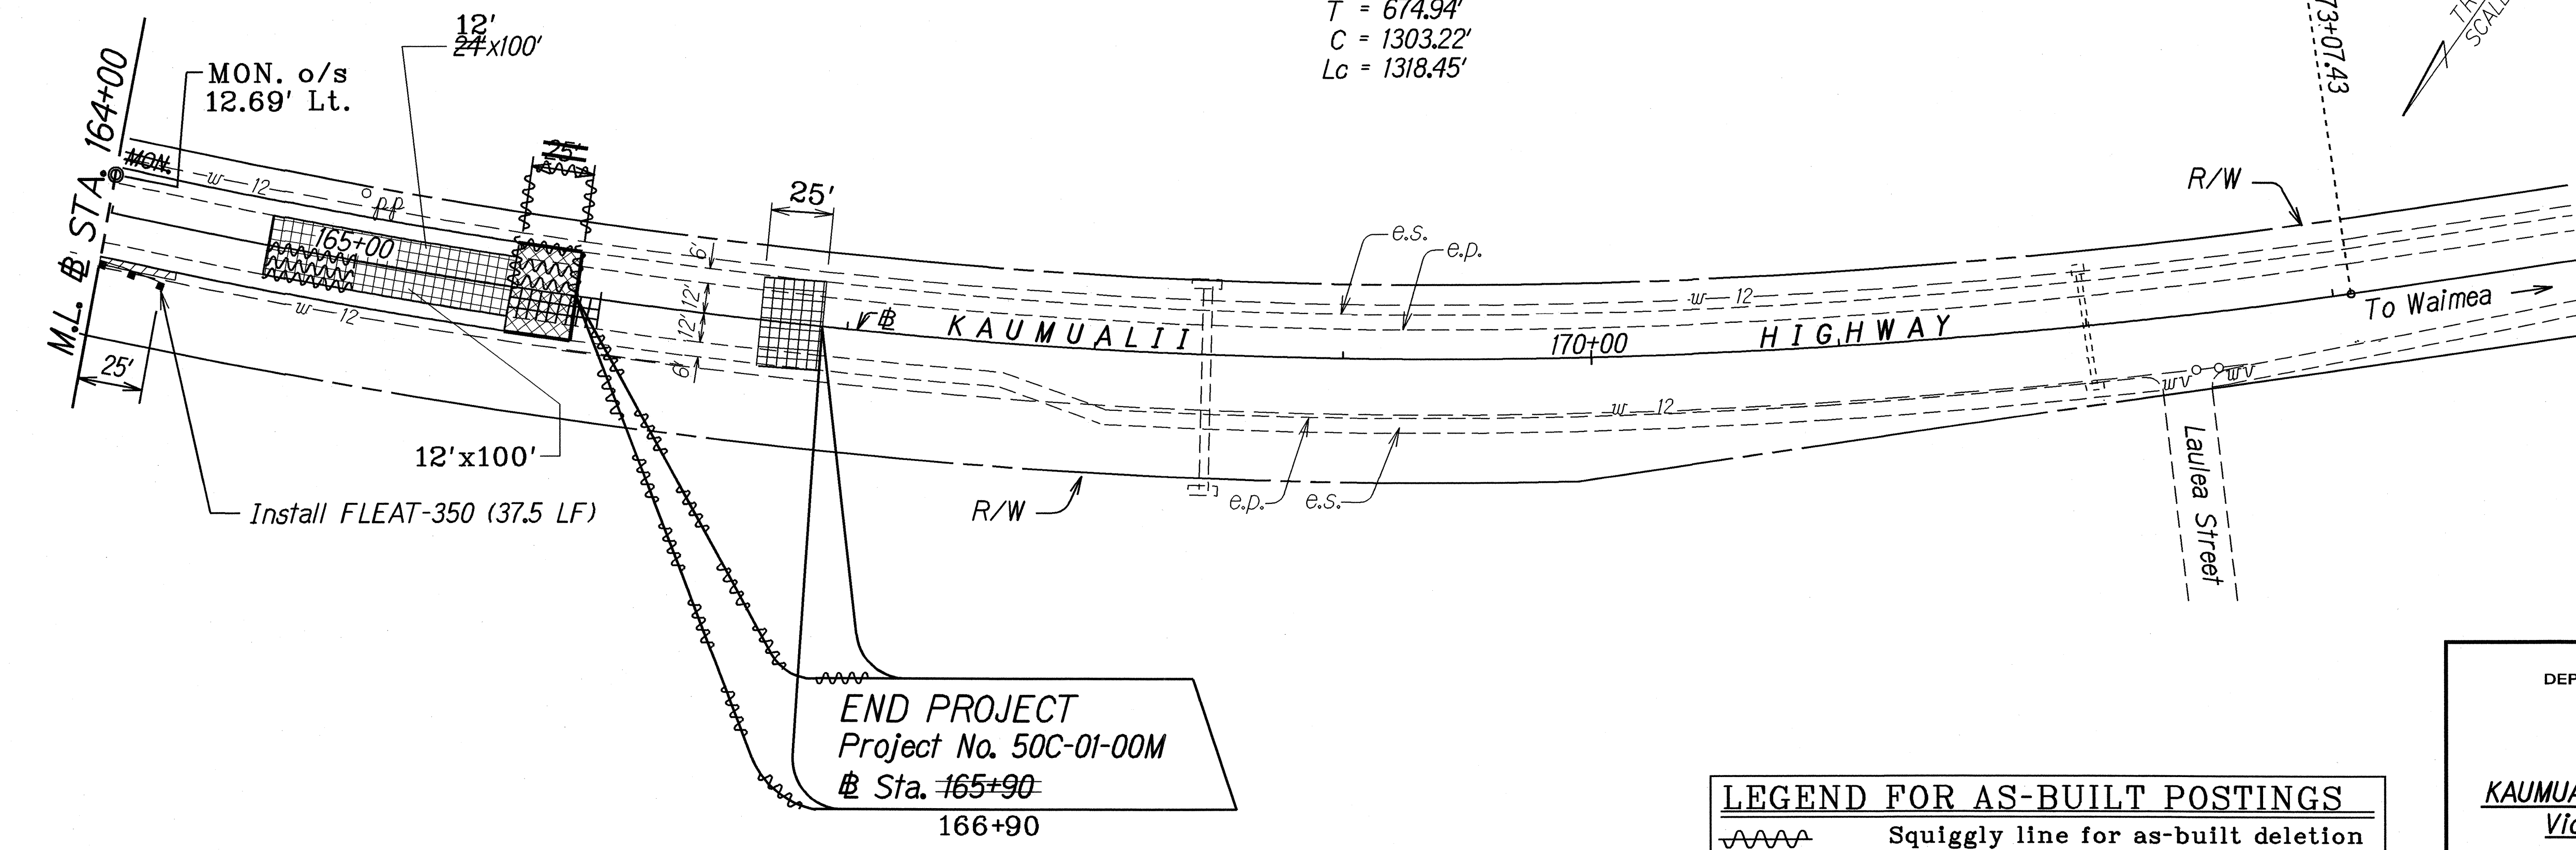

END PROJECT
 Project No. 50C-01-00M
 # Sta. 165+90
 166+90

LEGEND FOR AS-BUILT POSTINGS	
	Squiggly line for as-built deletion
	Double line for as-built deletion
Roadway	Text for as-built posting

STATE OF HAWAII
 DEPARTMENT OF TRANSPORTATION
 HIGHWAYS DIVISION

ROADWAY PLAN
KAUMUALII HIGHWAY RESURFACING
 Vicinity of Wahiawa Bridge
 to Laulea Street
 Project No. 50C-01-00M

Scale: 1"=40' Date: April, 2000

SHEET No. 4 OF 4 SHEETS

"AS-BUILT"

ORIGINAL PLAN	DATE
SURVEY PLOTTED BY	4/2/00
DRAWN BY	bedg
TRACED BY	
NOTED BY	F. Rogers
CHECKED BY	