

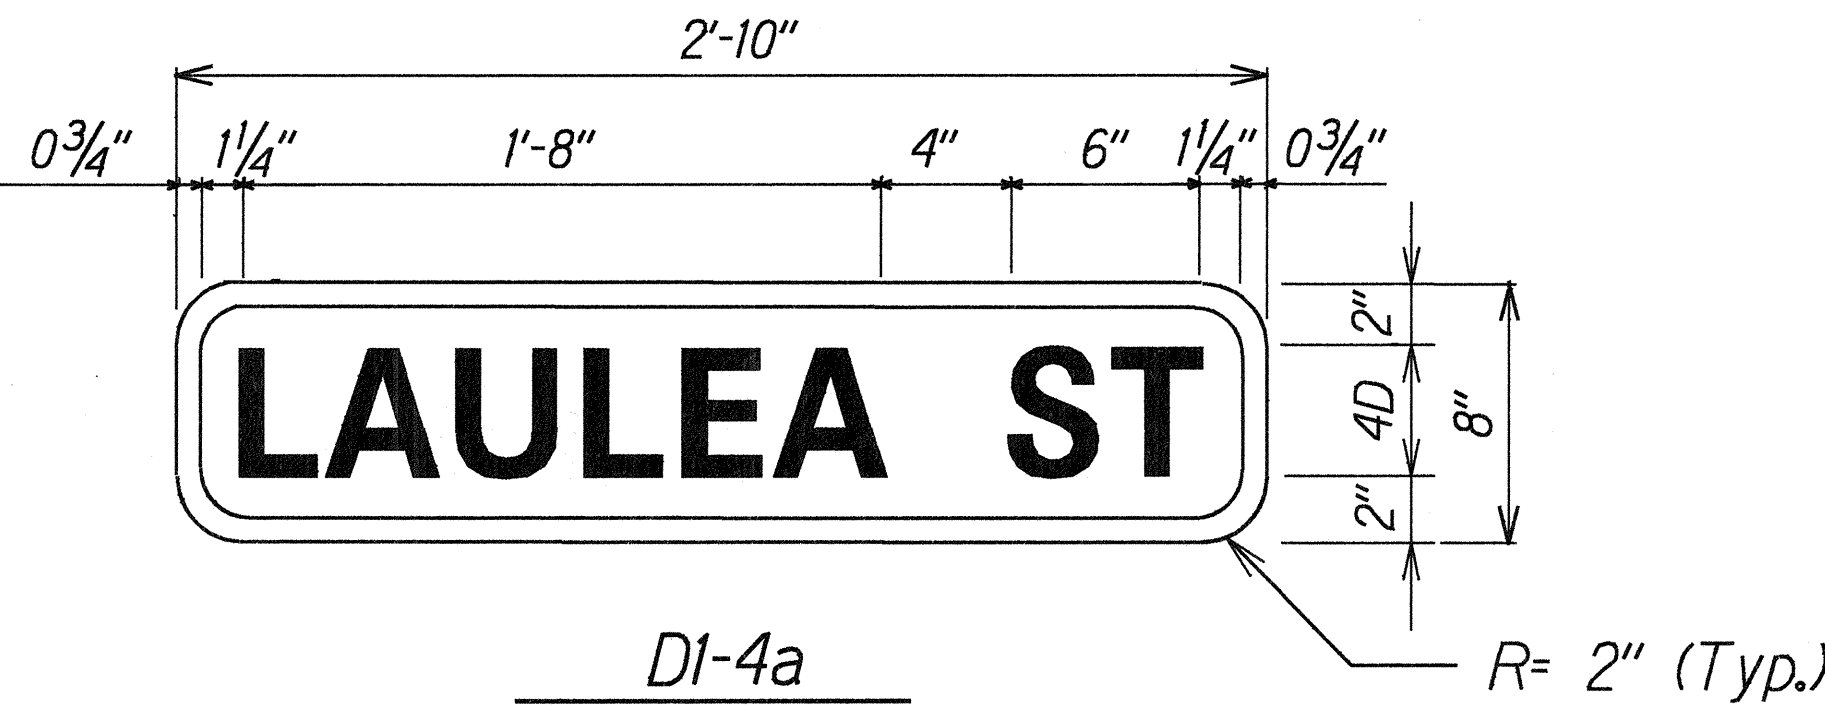
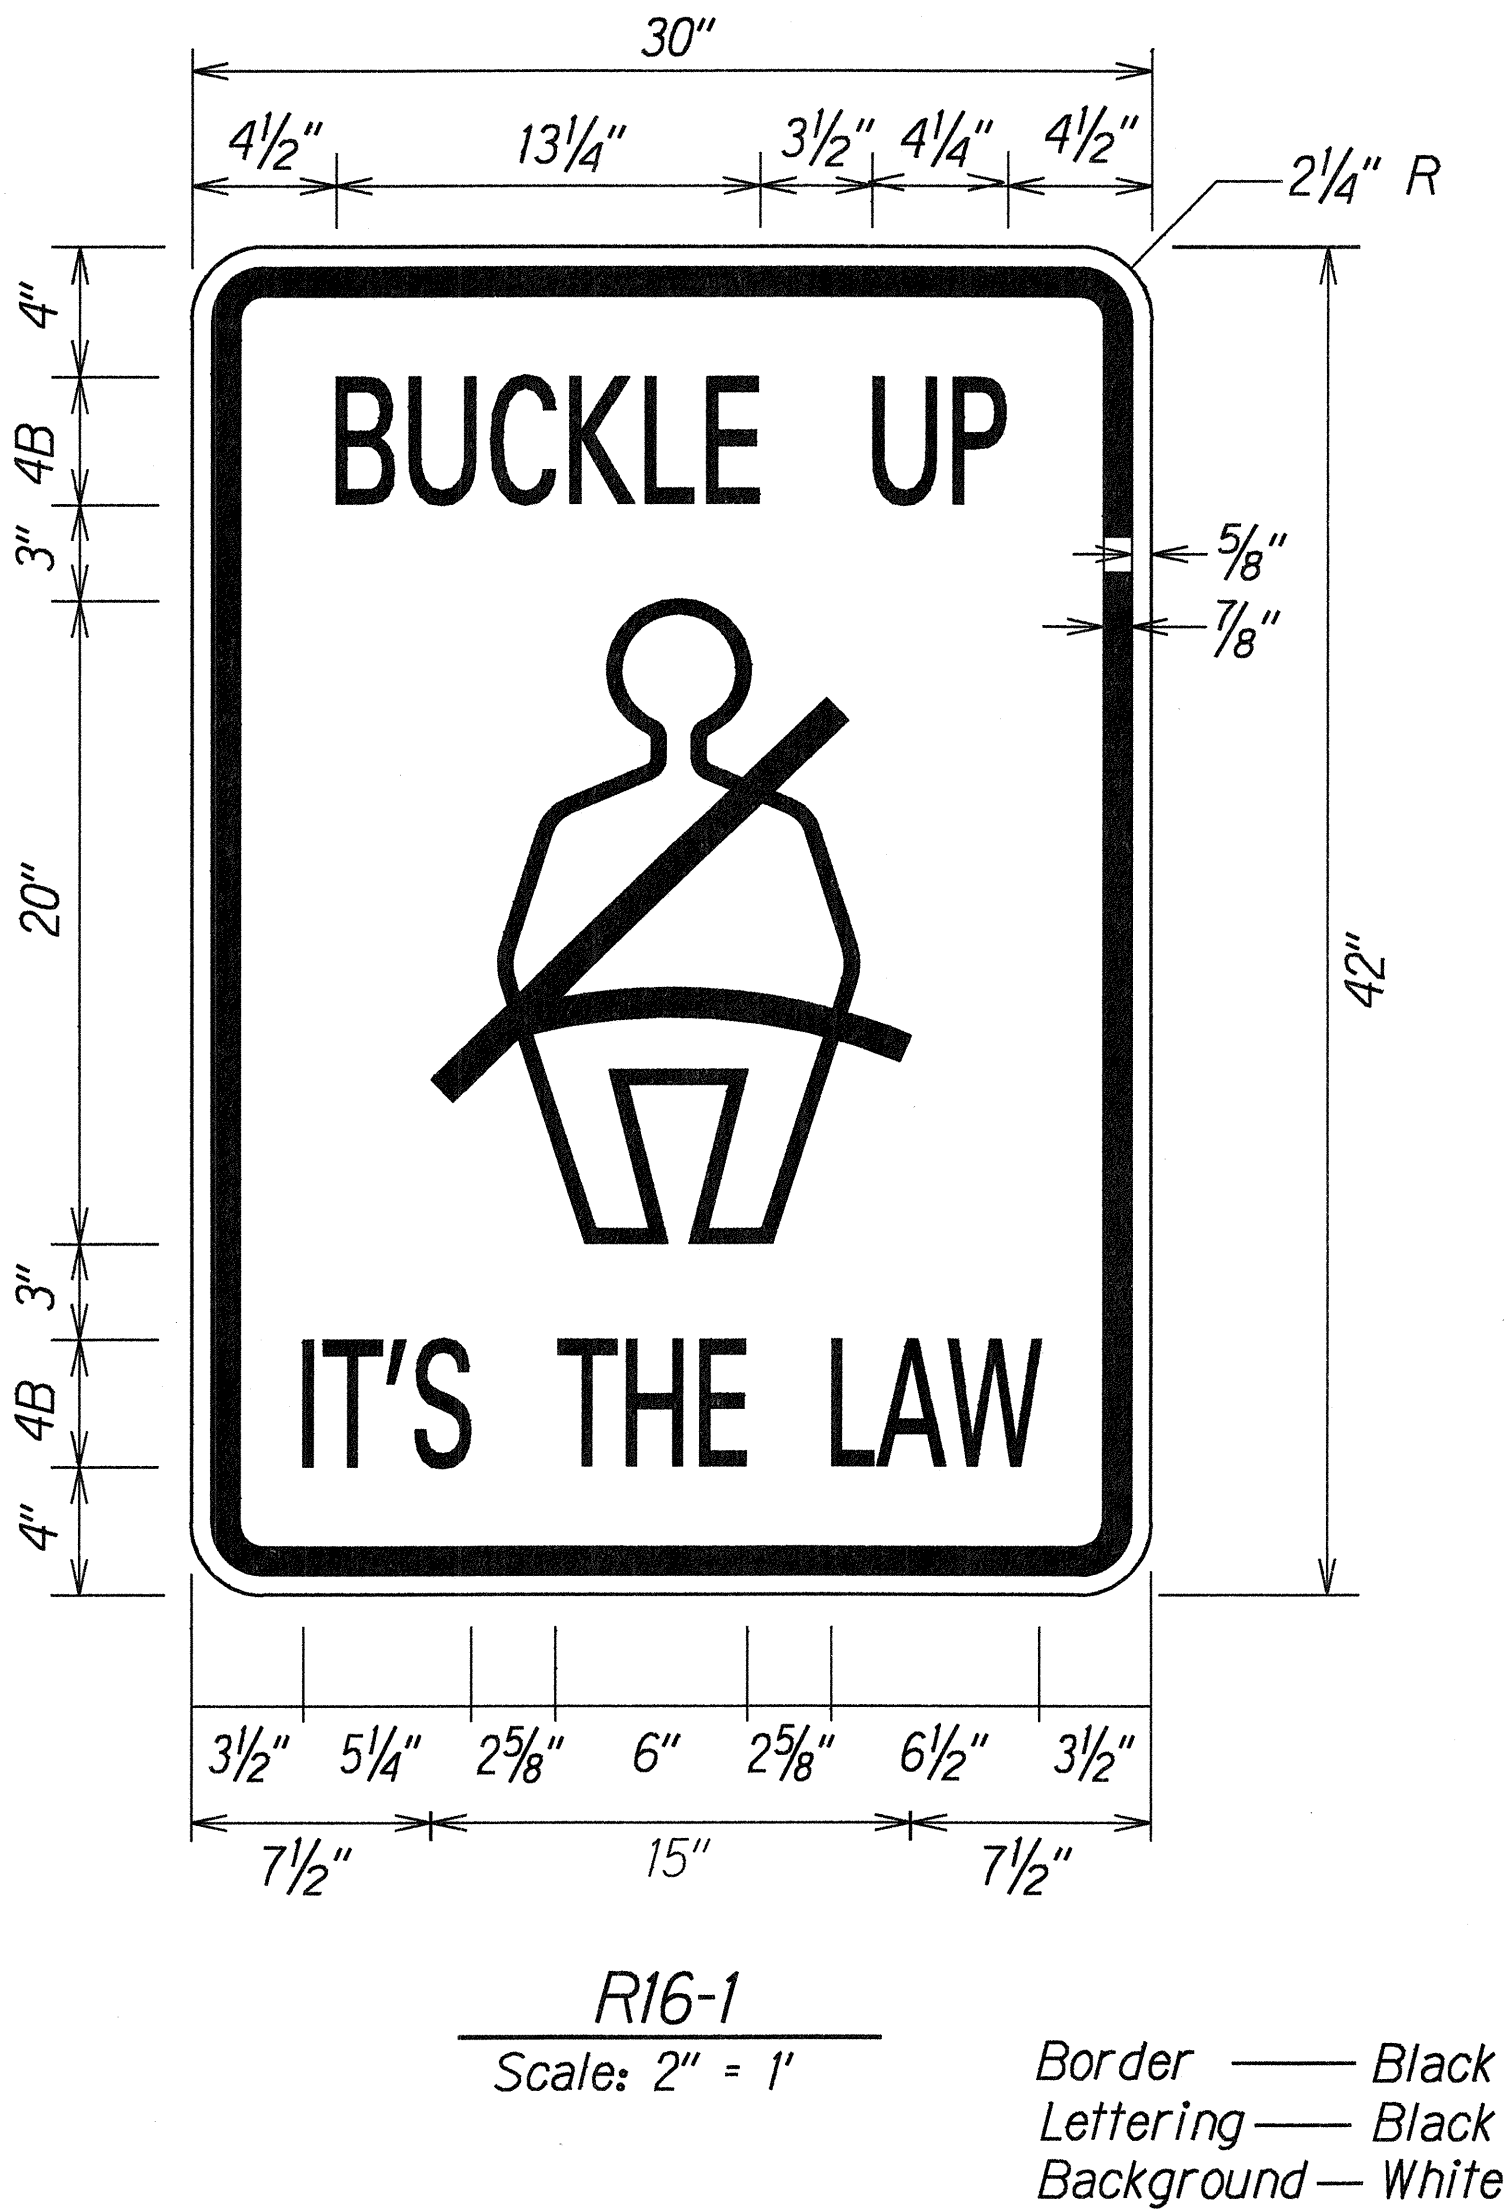


| FED. ROAD DIST. NO. | STATE | PROJ. NO.  | FISCAL YEAR | SHEET NO. | TOTAL SHEETS |
|---------------------|-------|------------|-------------|-----------|--------------|
| HAWAII              | HAW.  | 50C-01-00M | 2000        | 24        | 24           |

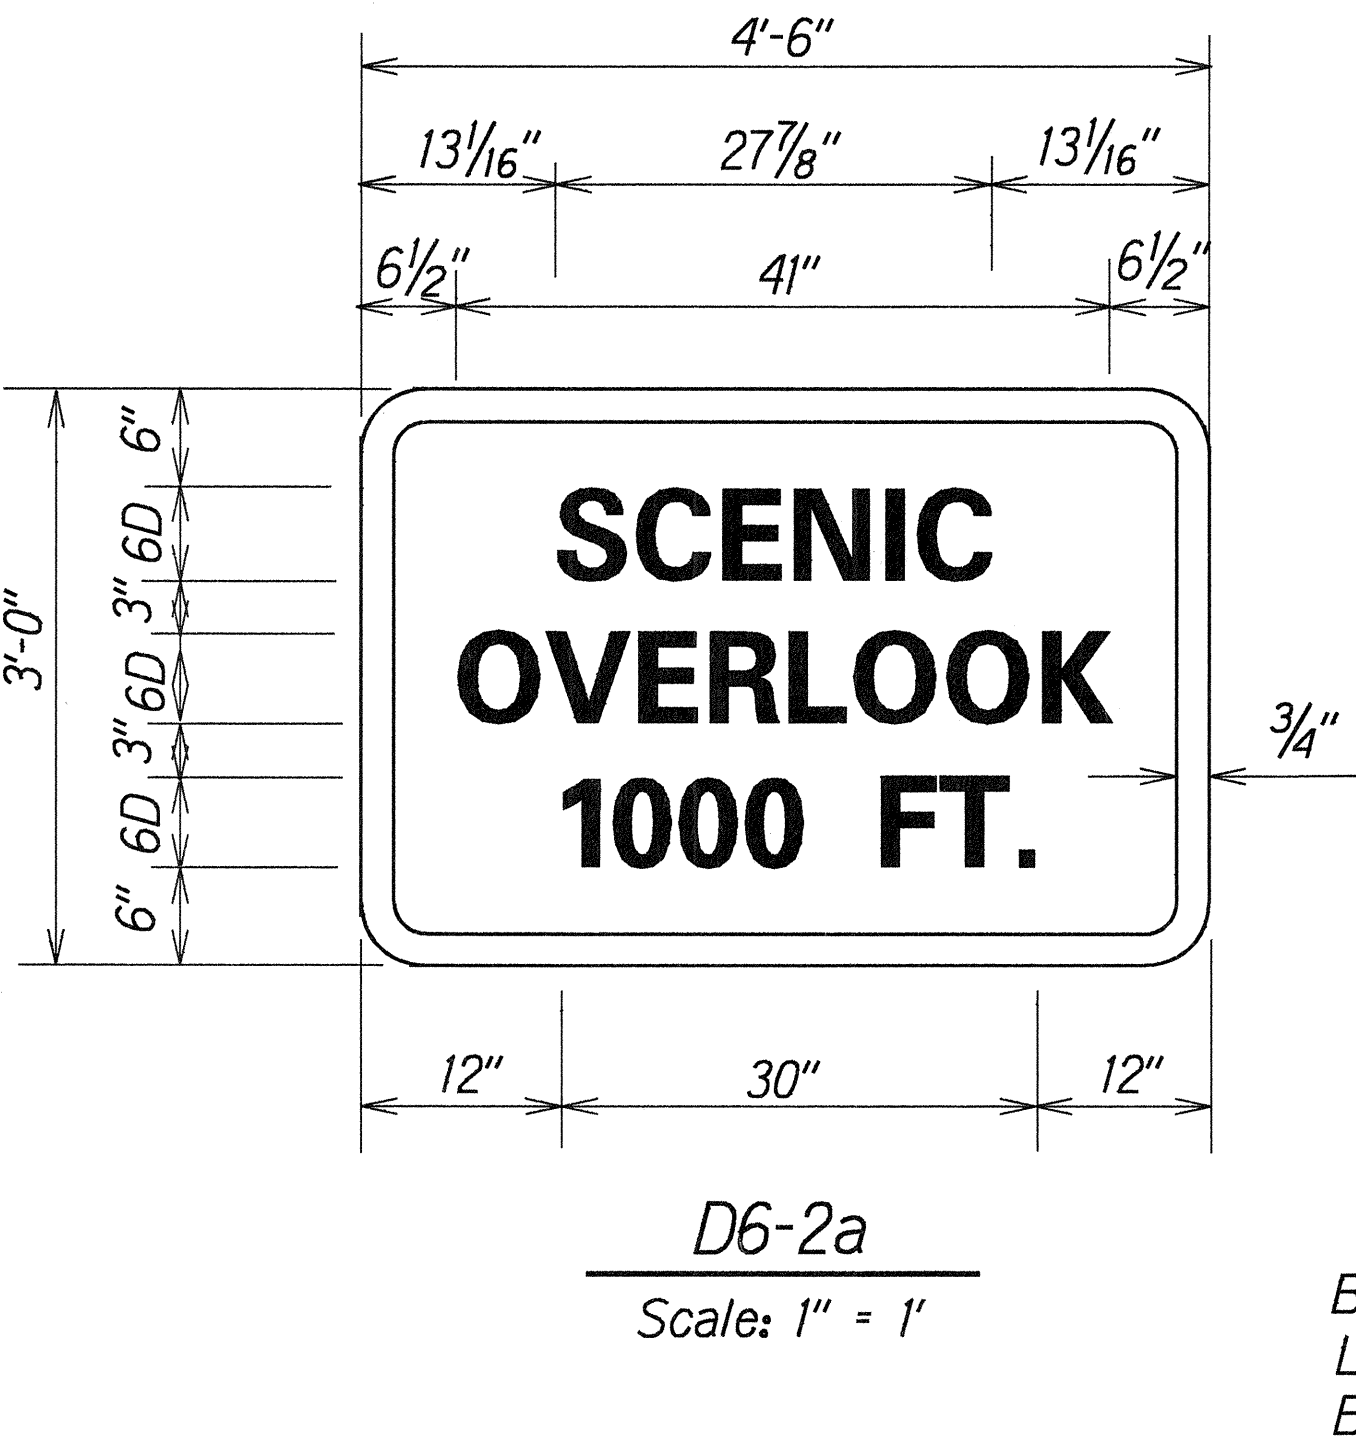

NOTE: Sign No. I-14 similar to I-12.

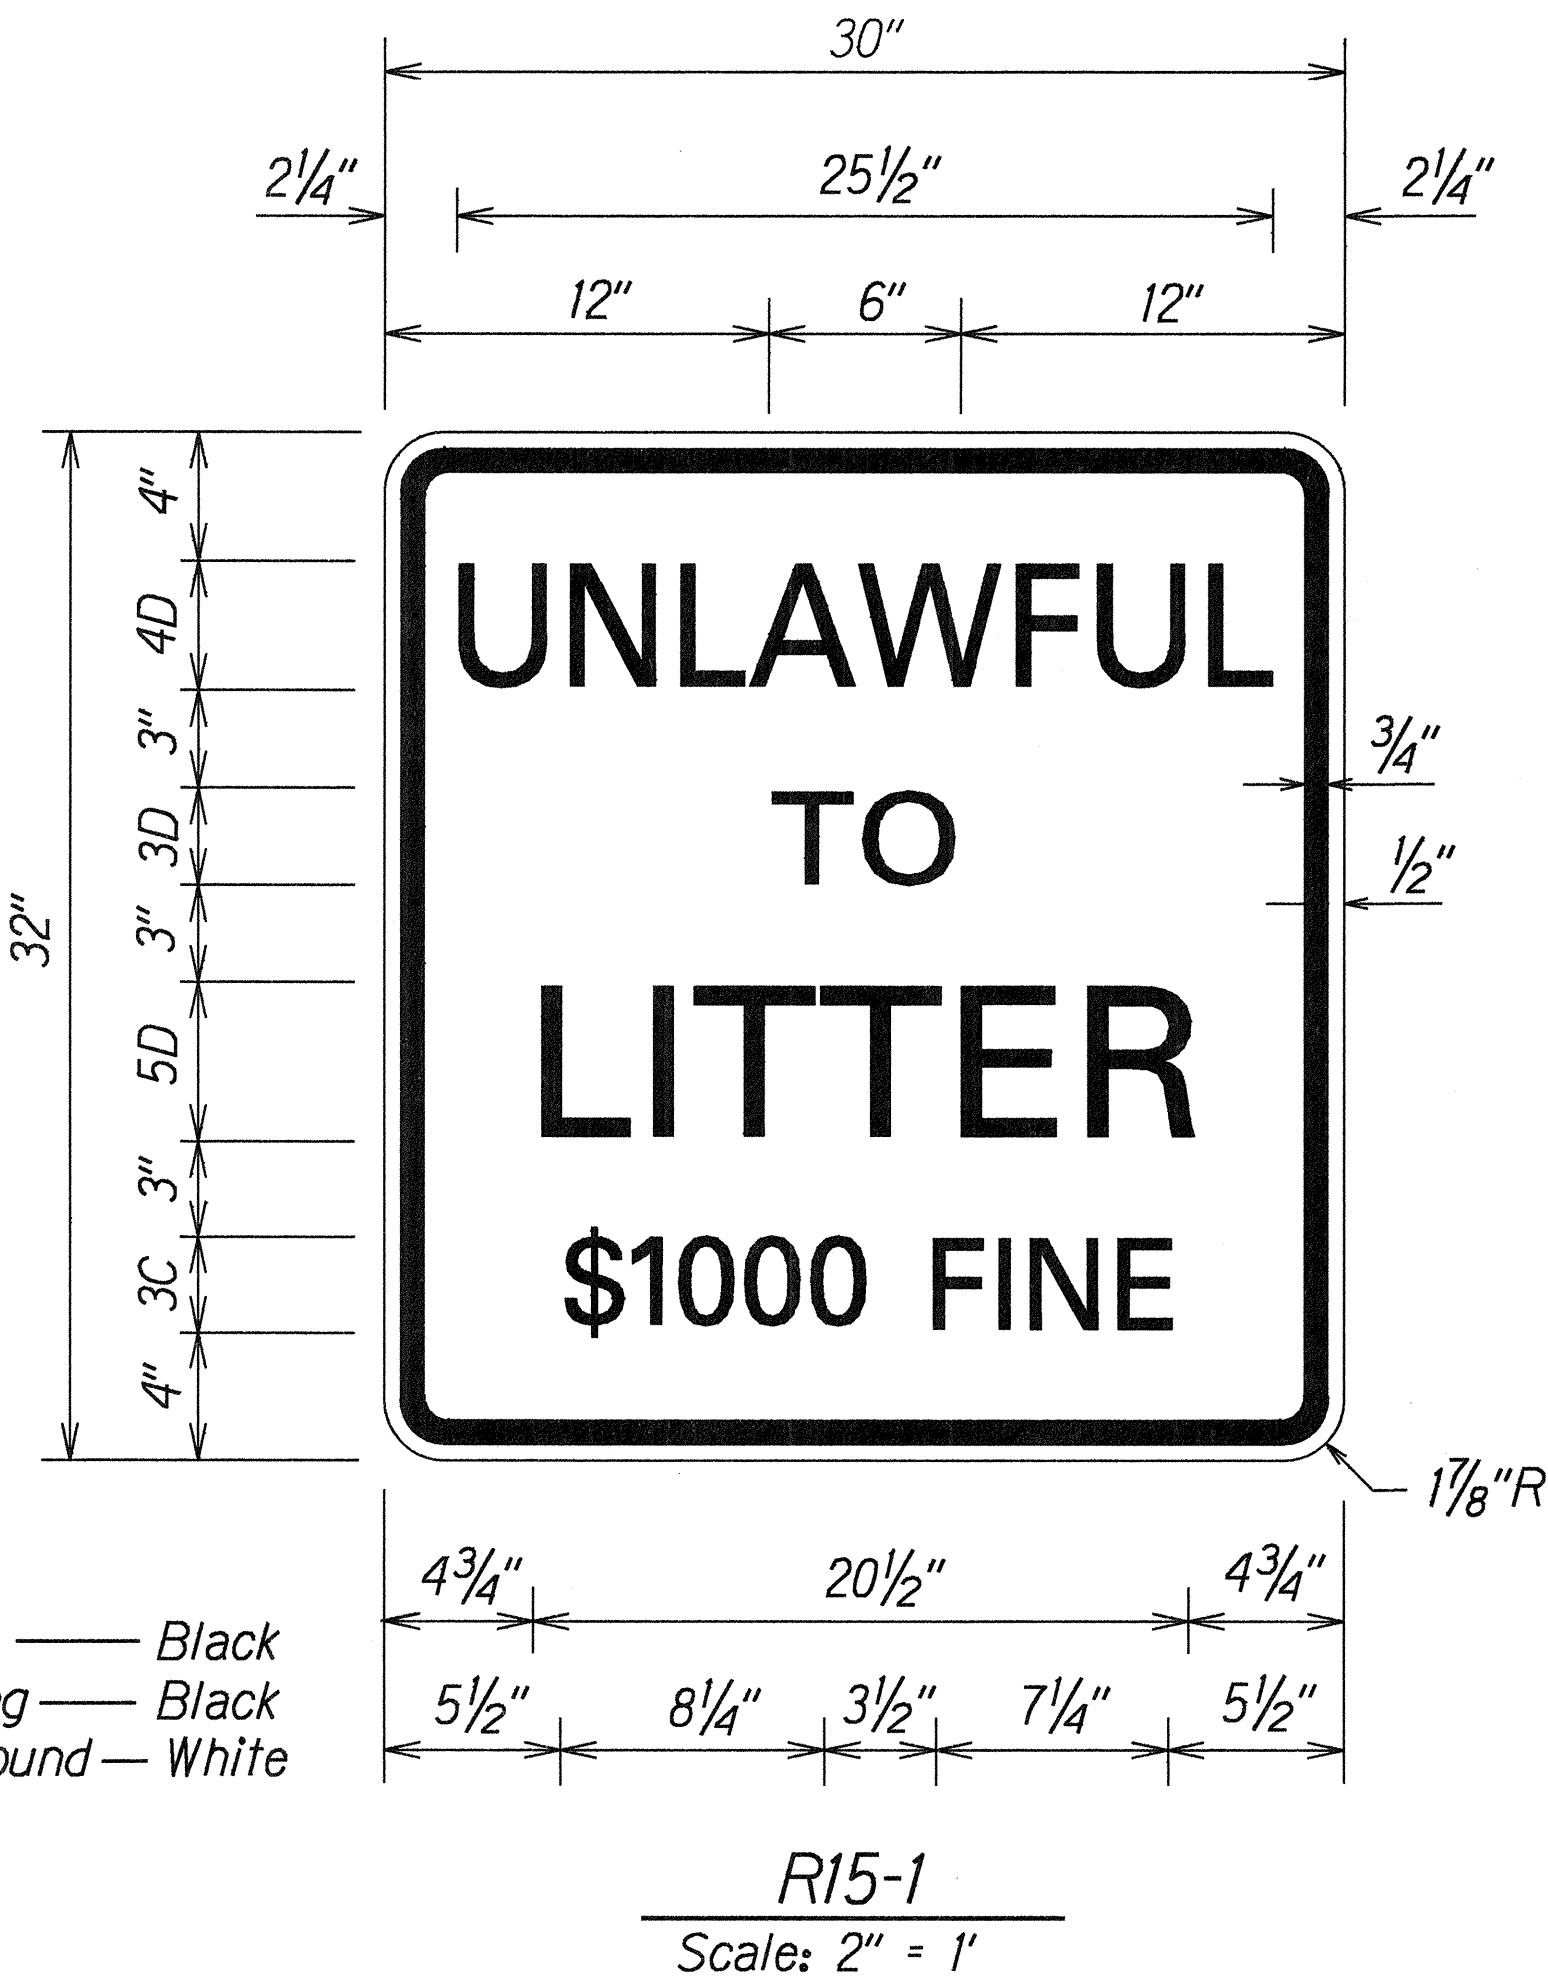

STATE OF HAWAII

DEPARTMENT OF TRANSPORTATION

HIGHWAYS DIVISION

**SIGN DETAILS**

KAUMUALII HIGHWAY RESURFACING

Vicinity of Wahiawa Bridge

to Laulea Street

Project No. 50C-01-00M

Scale: As Shown

Date: April, 2000

SHEET No. 1 OF 1 SHEETS

24