



FED. ROAD DIST. NO.	STATE	PROJ. NO.	FISCAL YEAR	SHEET NO.	TOTAL SHEETS
HAWAII	HAW.	50C-01-00M	2000	4	24

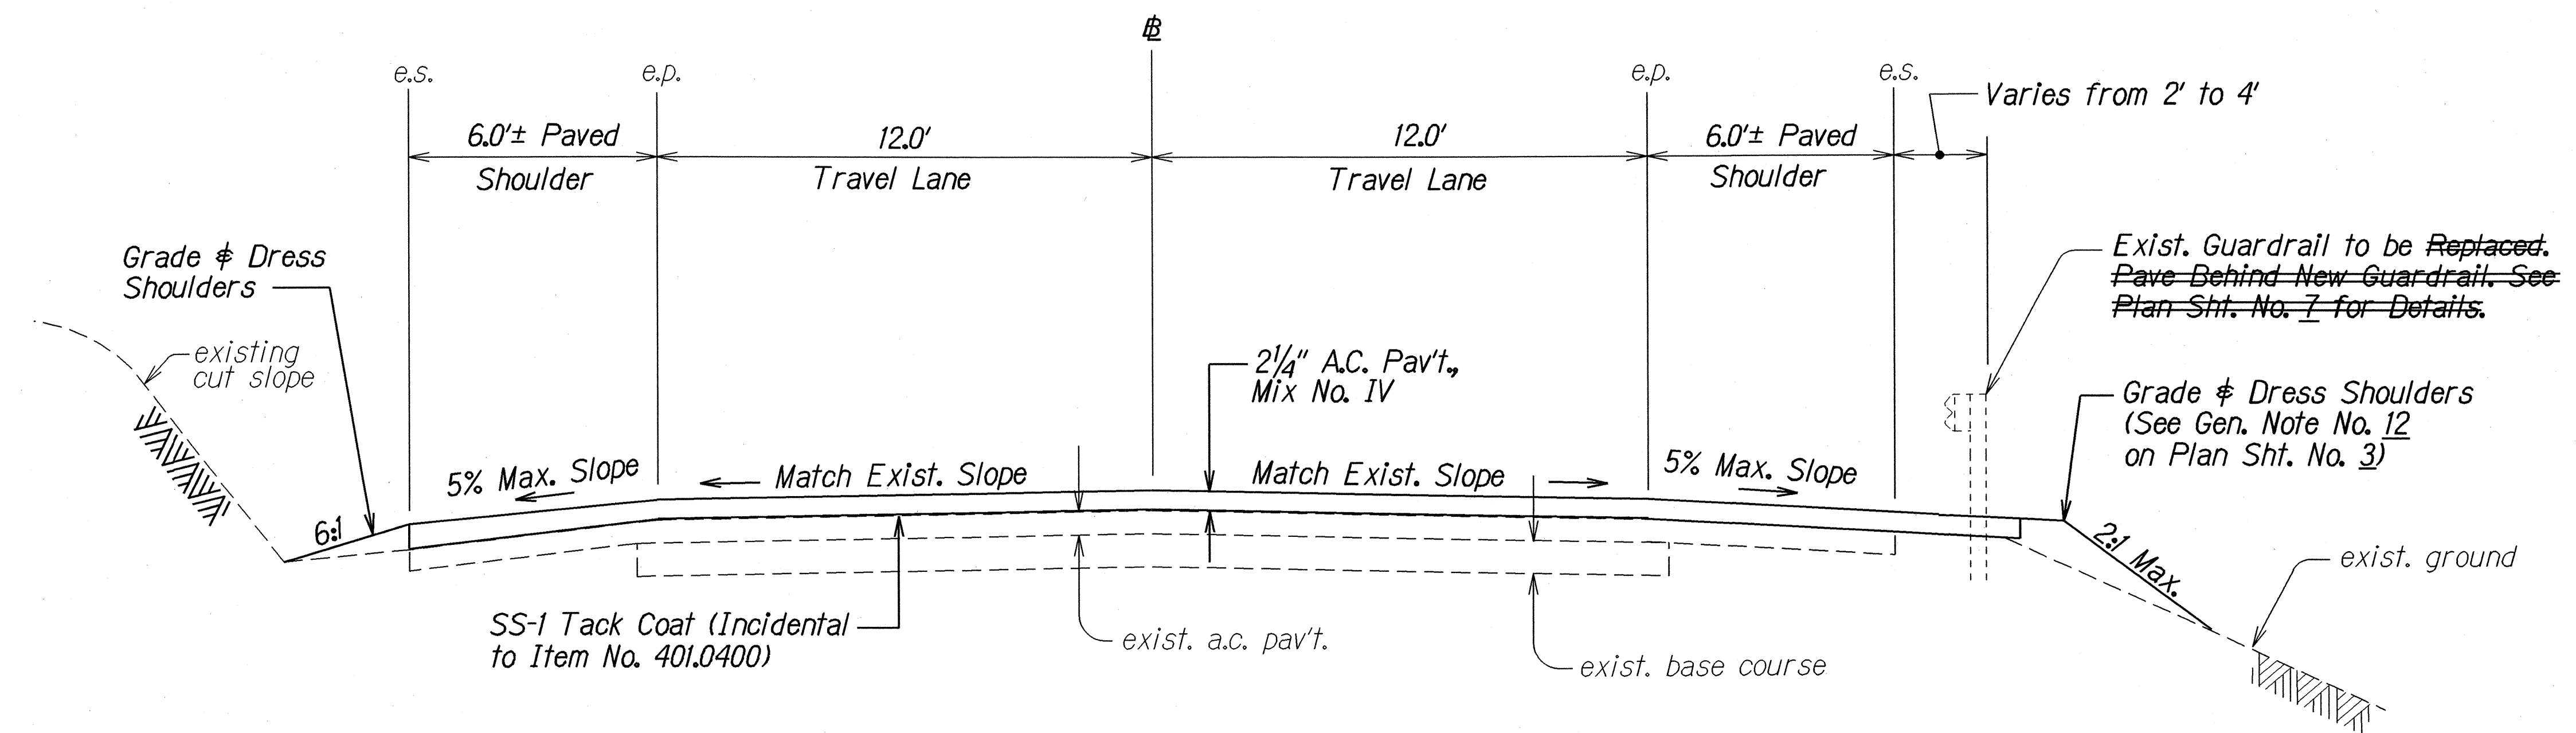

TANGENT SECTION
Scale: 3/8" = 1'-0"

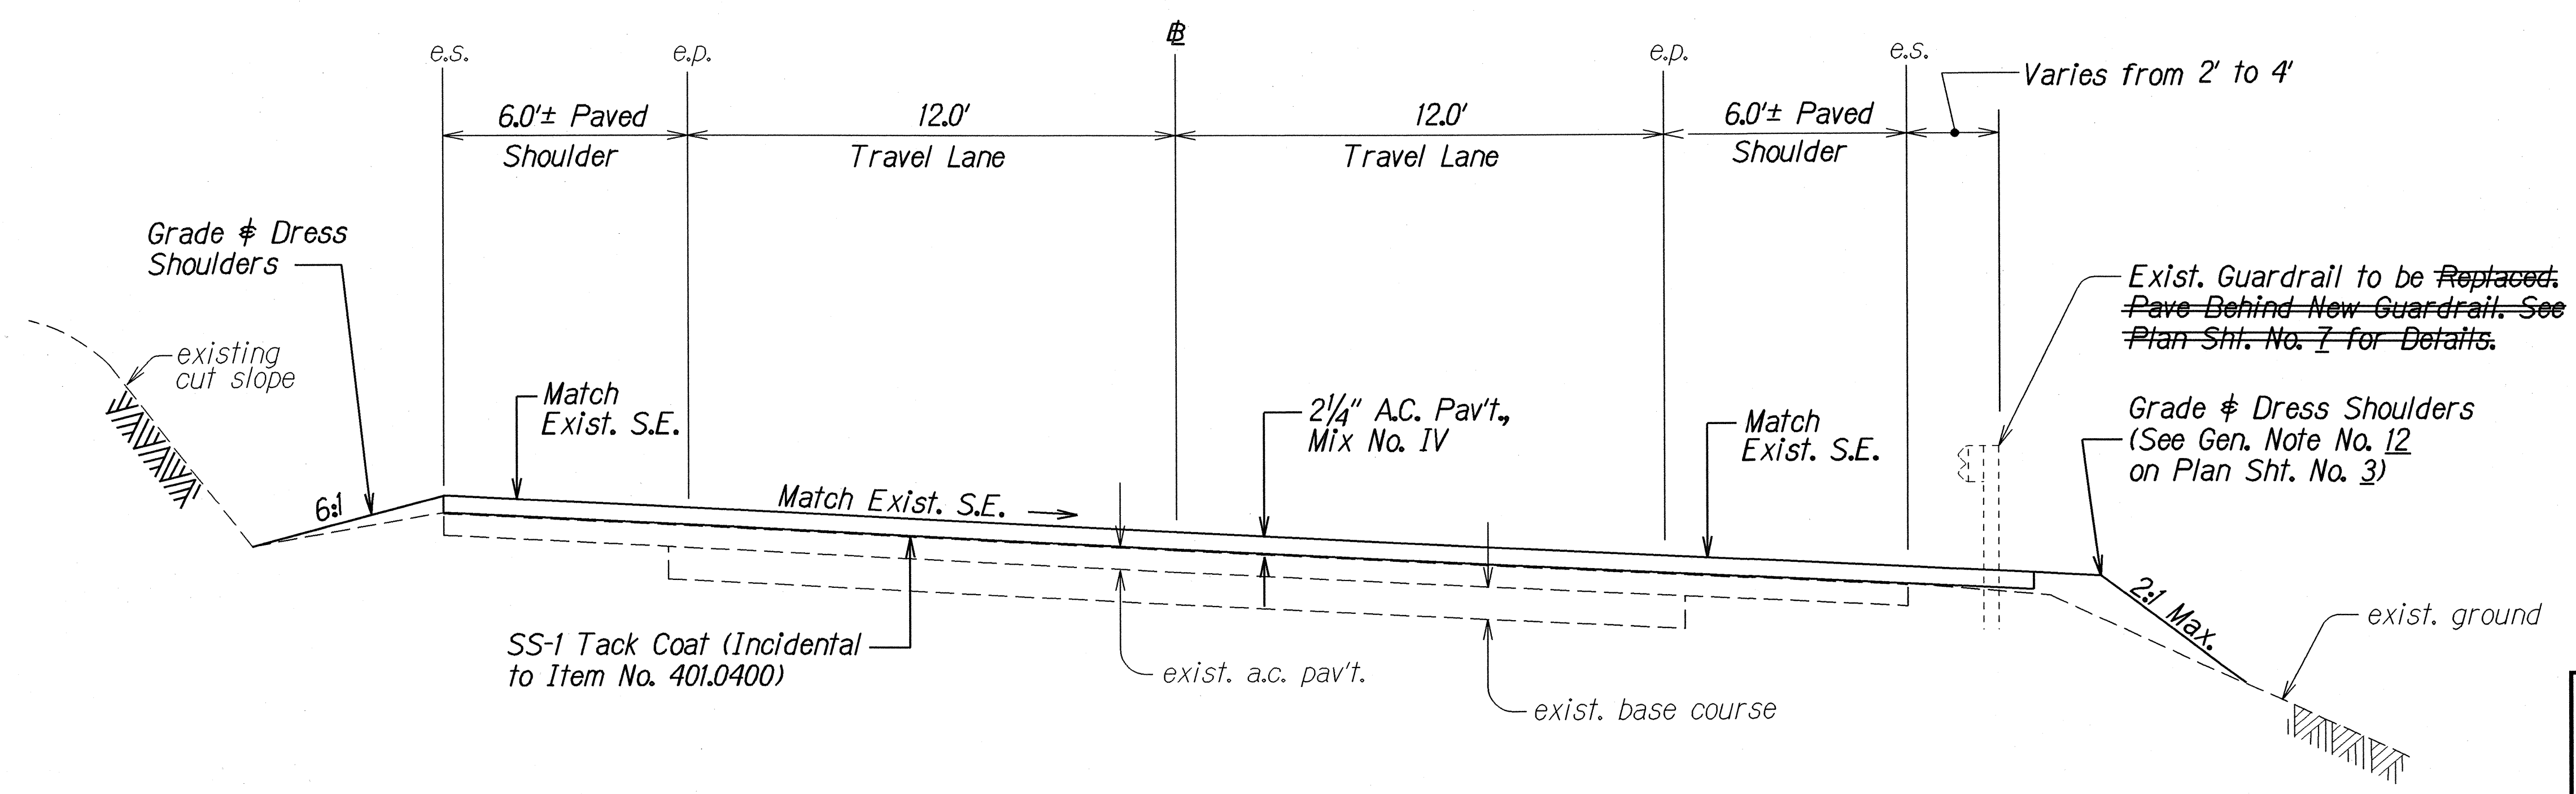

SUPERELEVATED SECTION
Scale: 3/8" = 1'-0"


LEGEND FOR AS-BUILT POSTINGS	
	Squiggly line for as-built deletion
	Double line for as-built deletion
Roadway	Text for as-built posting

STATE OF HAWAII
DEPARTMENT OF TRANSPORTATION
HIGHWAYS DIVISION


TYPICAL SECTIONS
KAUMUALII HIGHWAY RESURFACING
Vicinity of Wahiawa Bridge
to Laulea Street
Project No. 50C-01-00M
Scale: As Shown Date: April, 2000
SHEET No. 1 OF 3 SHEETS

"AS-BUILT"


FED. ROAD DIST. NO.	STATE	PROJ. NO.	FISCAL YEAR	SHEET NO.	TOTAL SHEETS
HAWAII	HAW.	50C-01-00M	2000	5	24

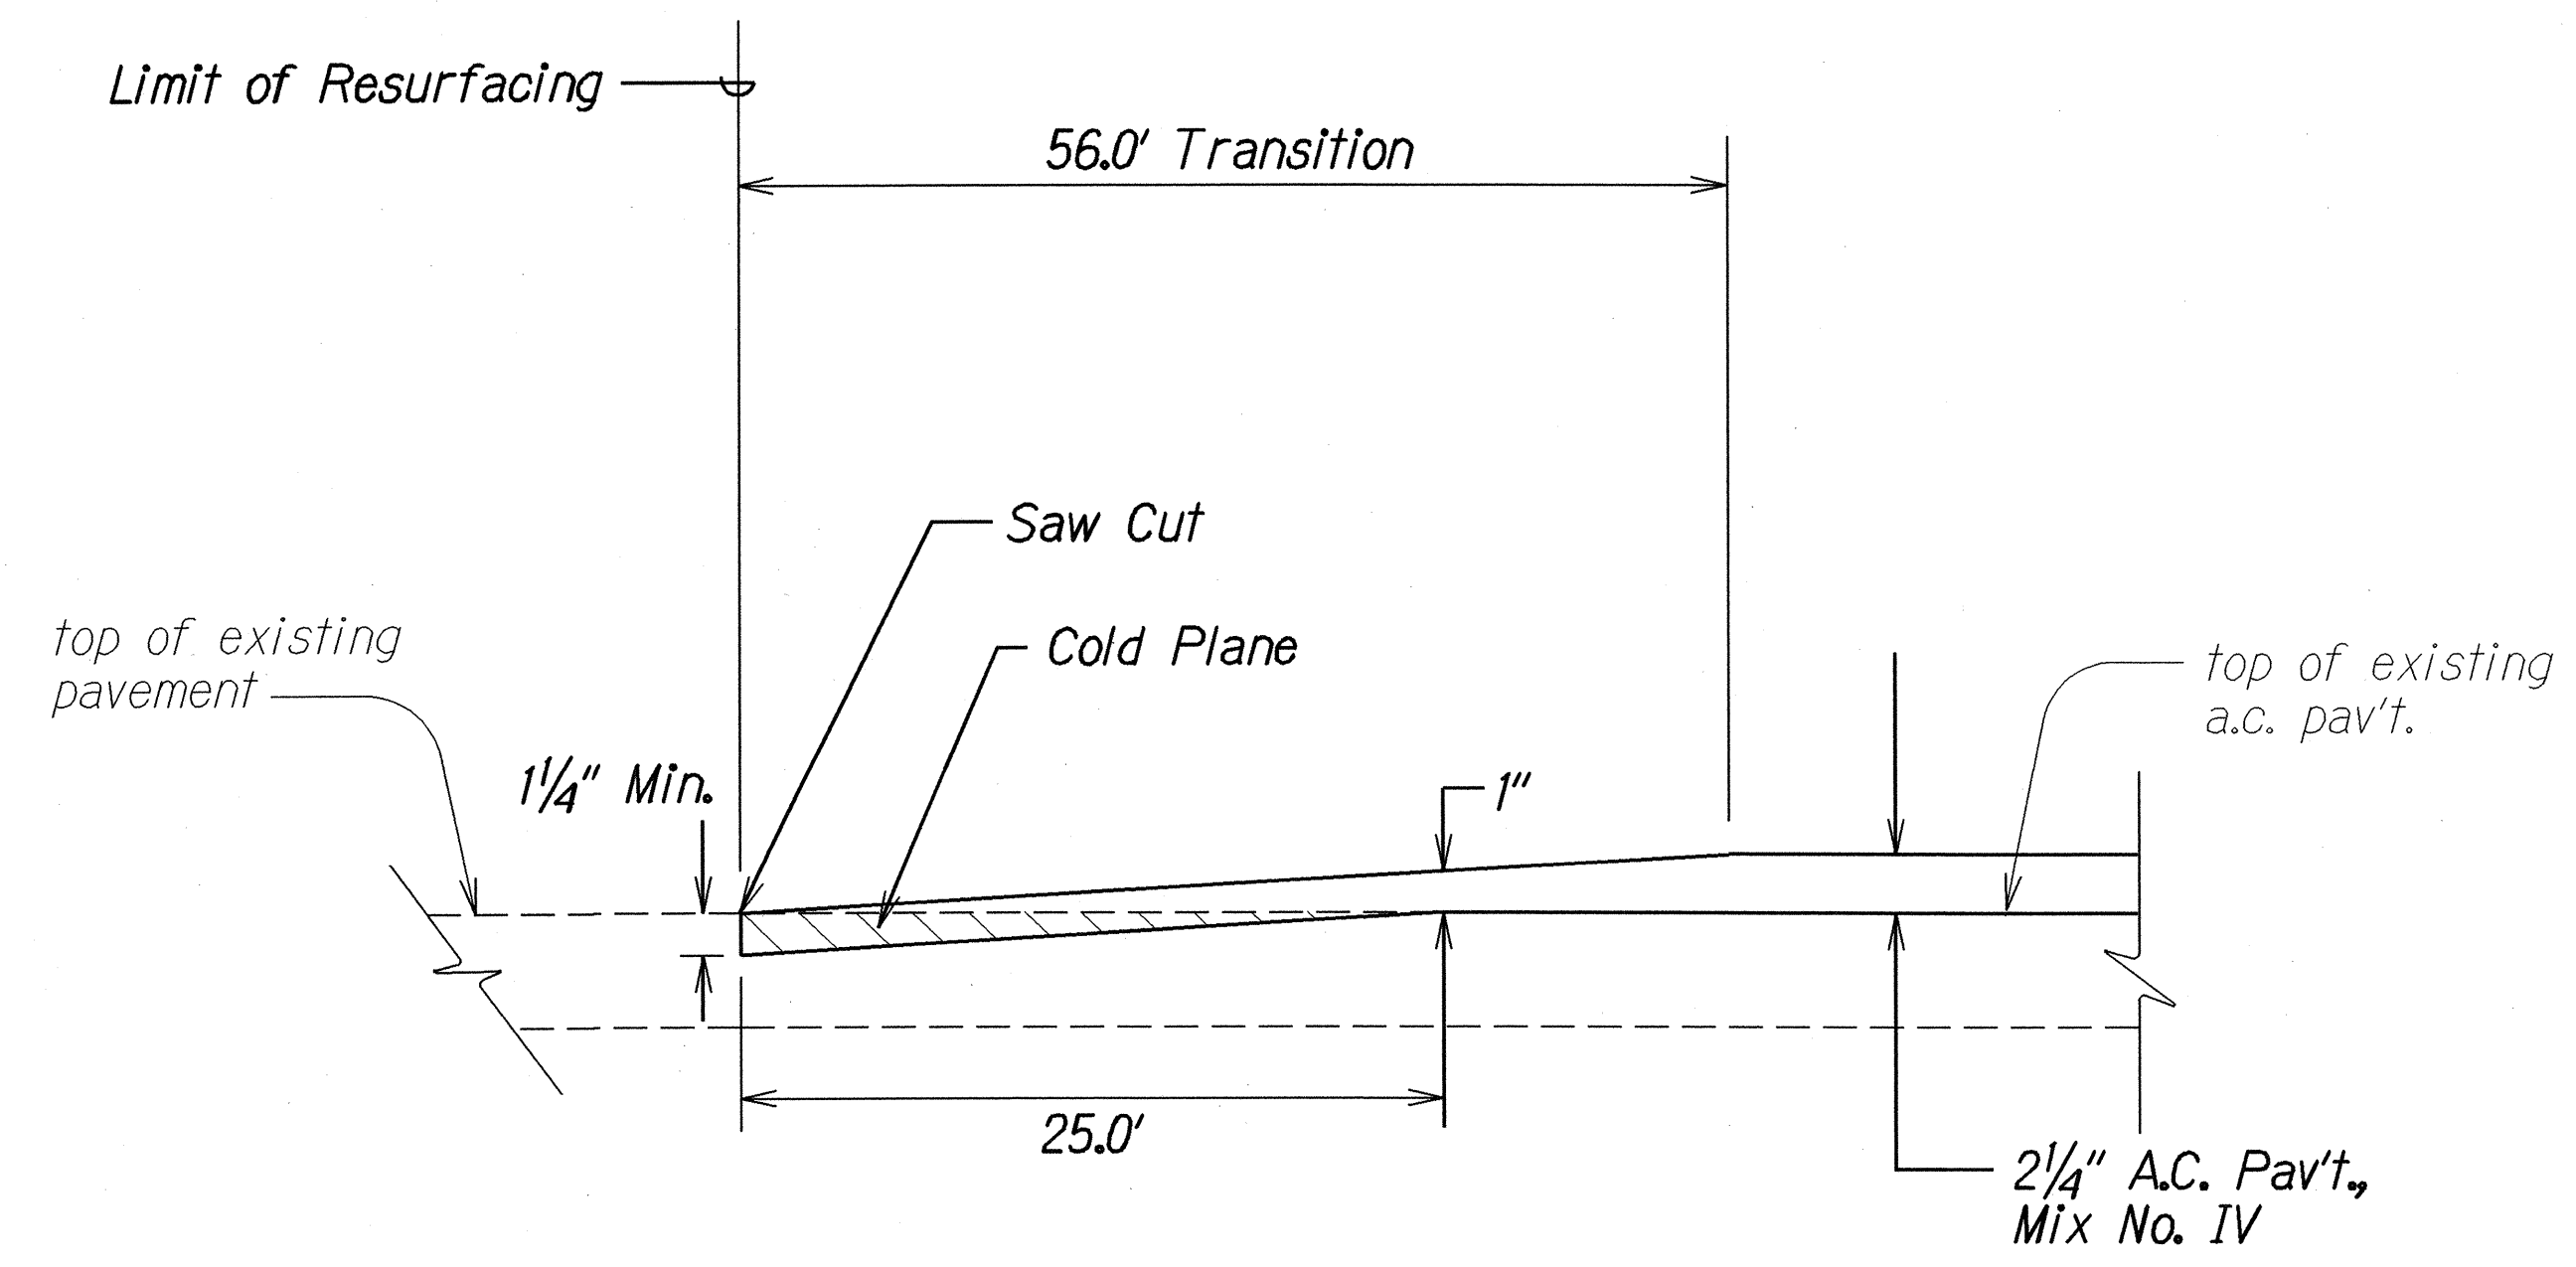

COLD PLANED TRANSITION AT BEGINNING & END OF WORK
Not to Scale

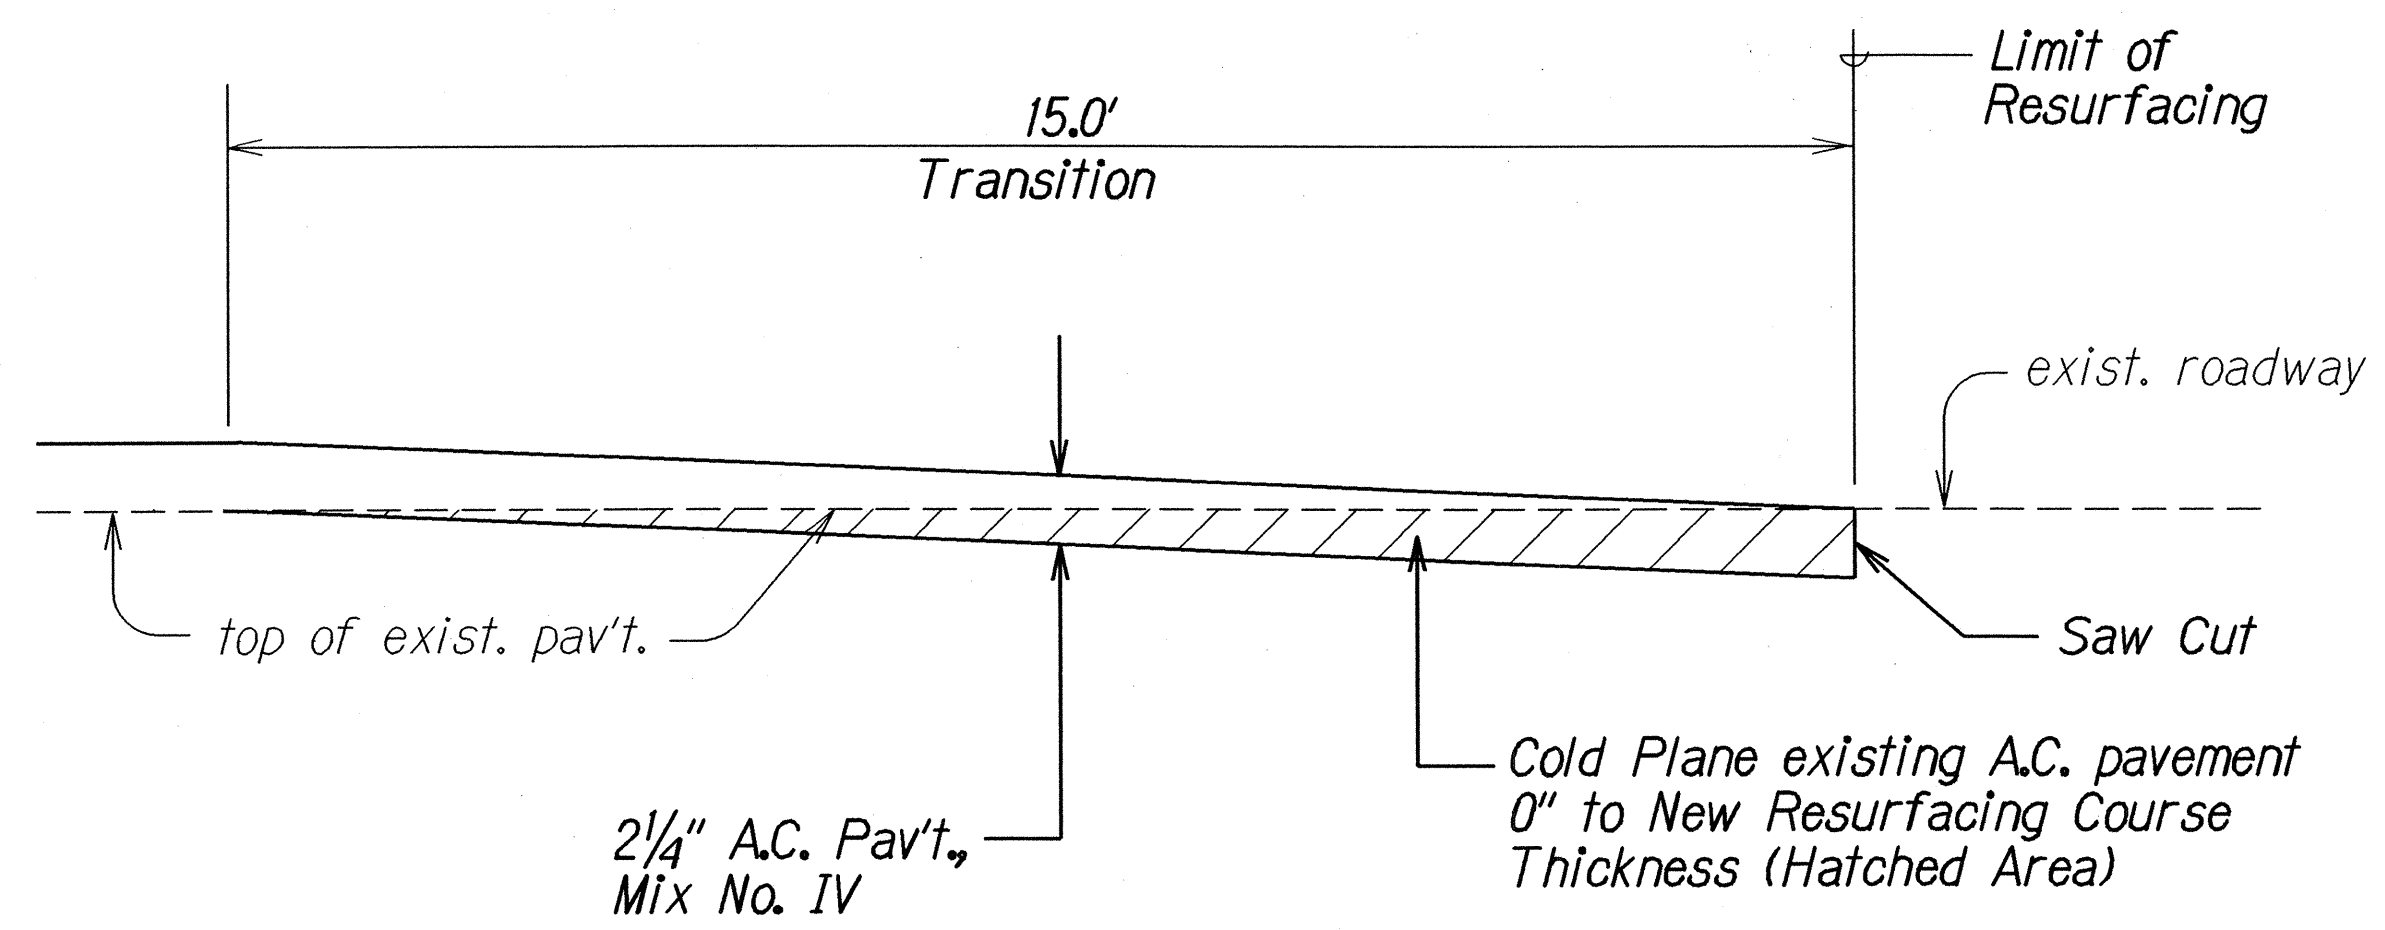


COLD PLANED TRANSITION AT EXISTING ROADWAY
Not To Scale

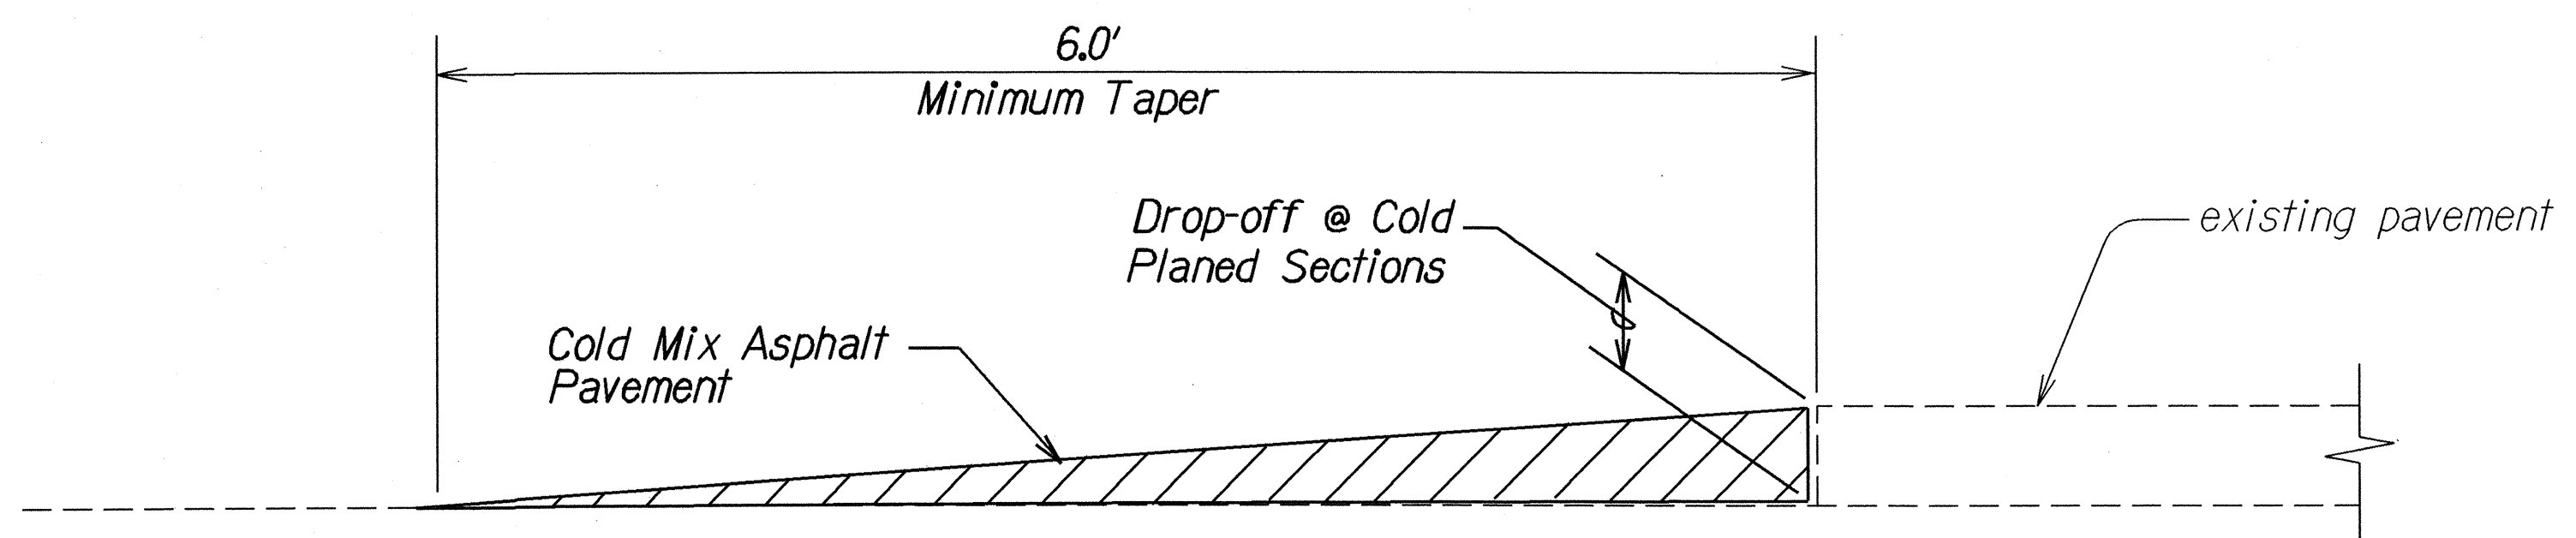

TEMPORARY TRANSITION AT COLD PLANED AREAS
Not to Scale

Note:
Contractor shall construct temporary pavement taper to prevent sharp pavement drop-offs at all cold planed sections. Prior to final A.C. Mix No. IV placement, temporary pavement taper shall be removed.

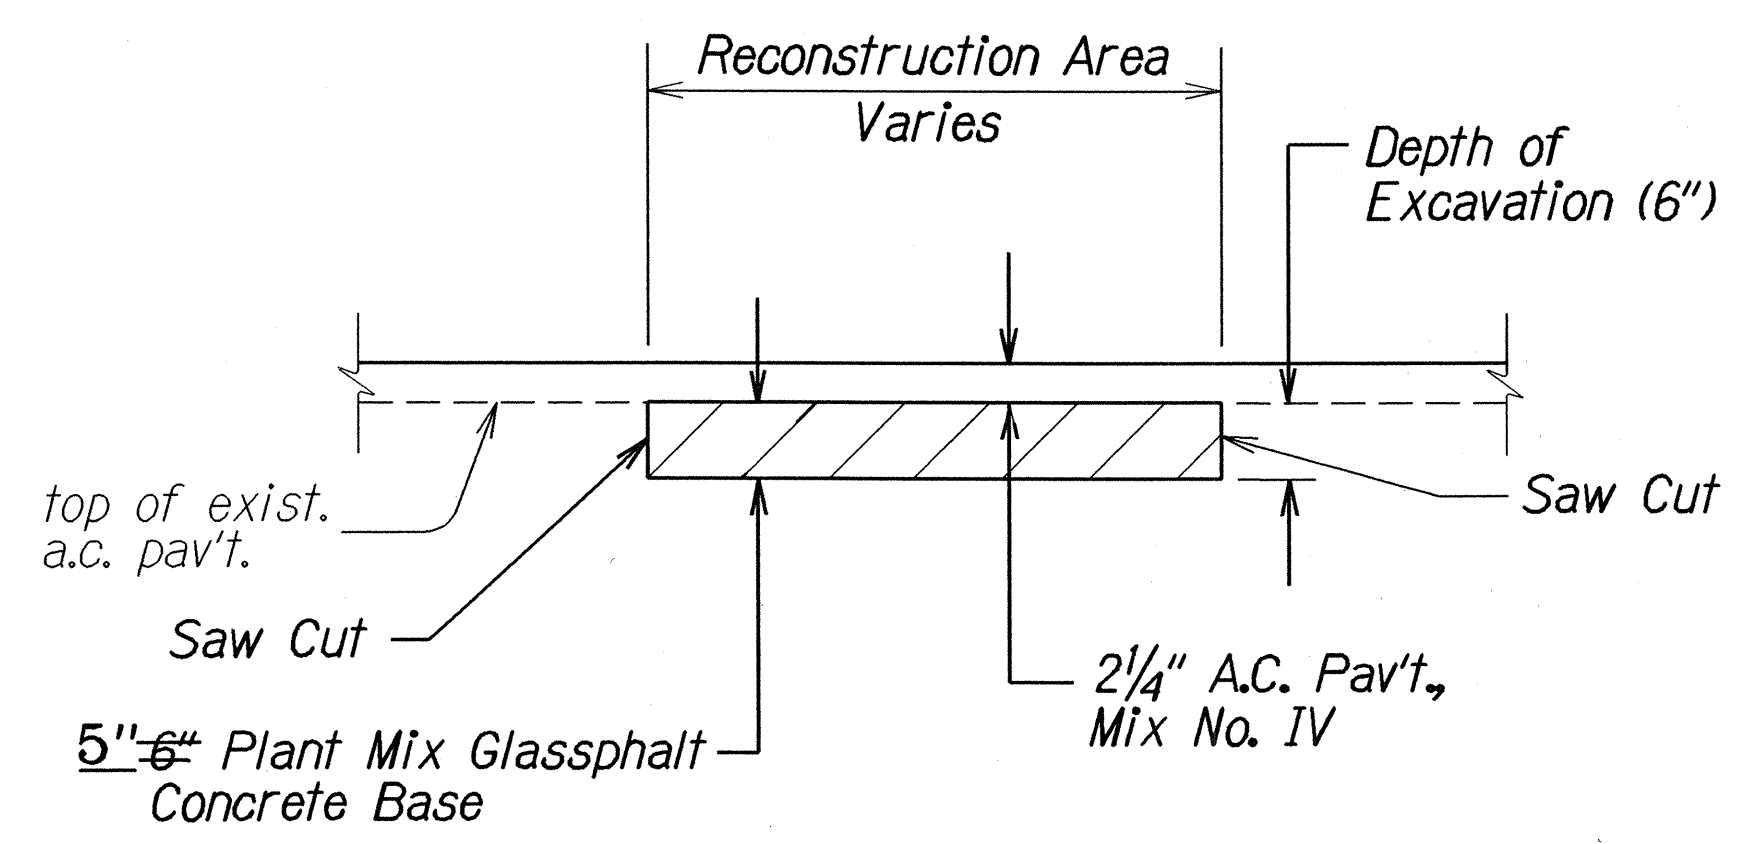

A.C. PAVEMENT RECONSTRUCTION DETAIL
Not To Scale


LEGEND FOR AS-BUILT POSTINGS	
	Squiggly line for as-built deletion
	Double line for as-built deletion
Roadway	Text for as-built posting

STATE OF HAWAII
DEPARTMENT OF TRANSPORTATION
HIGHWAYS DIVISION


TYPICAL SECTIONS
KAUMUALII HIGHWAY RESURFACING
Vicinity of Wahiawa Bridge
to Laulea Street
Project No. 50C-01-00M
Scale: As Shown Date: April, 2000
SHEET No. 2 OF 3 SHEETS

DESIGNED BY	DATE
TRACED BY	4-7-00
NOTED BY	
QUANTITIES BY	
CHECKED BY	


FED. ROAD DIST. NO.	STATE	PROJ. NO.	FISCAL YEAR	SHEET NO.	TOTAL SHEETS
HAWAII	HAW.	50C-01-00M	2000	6	24

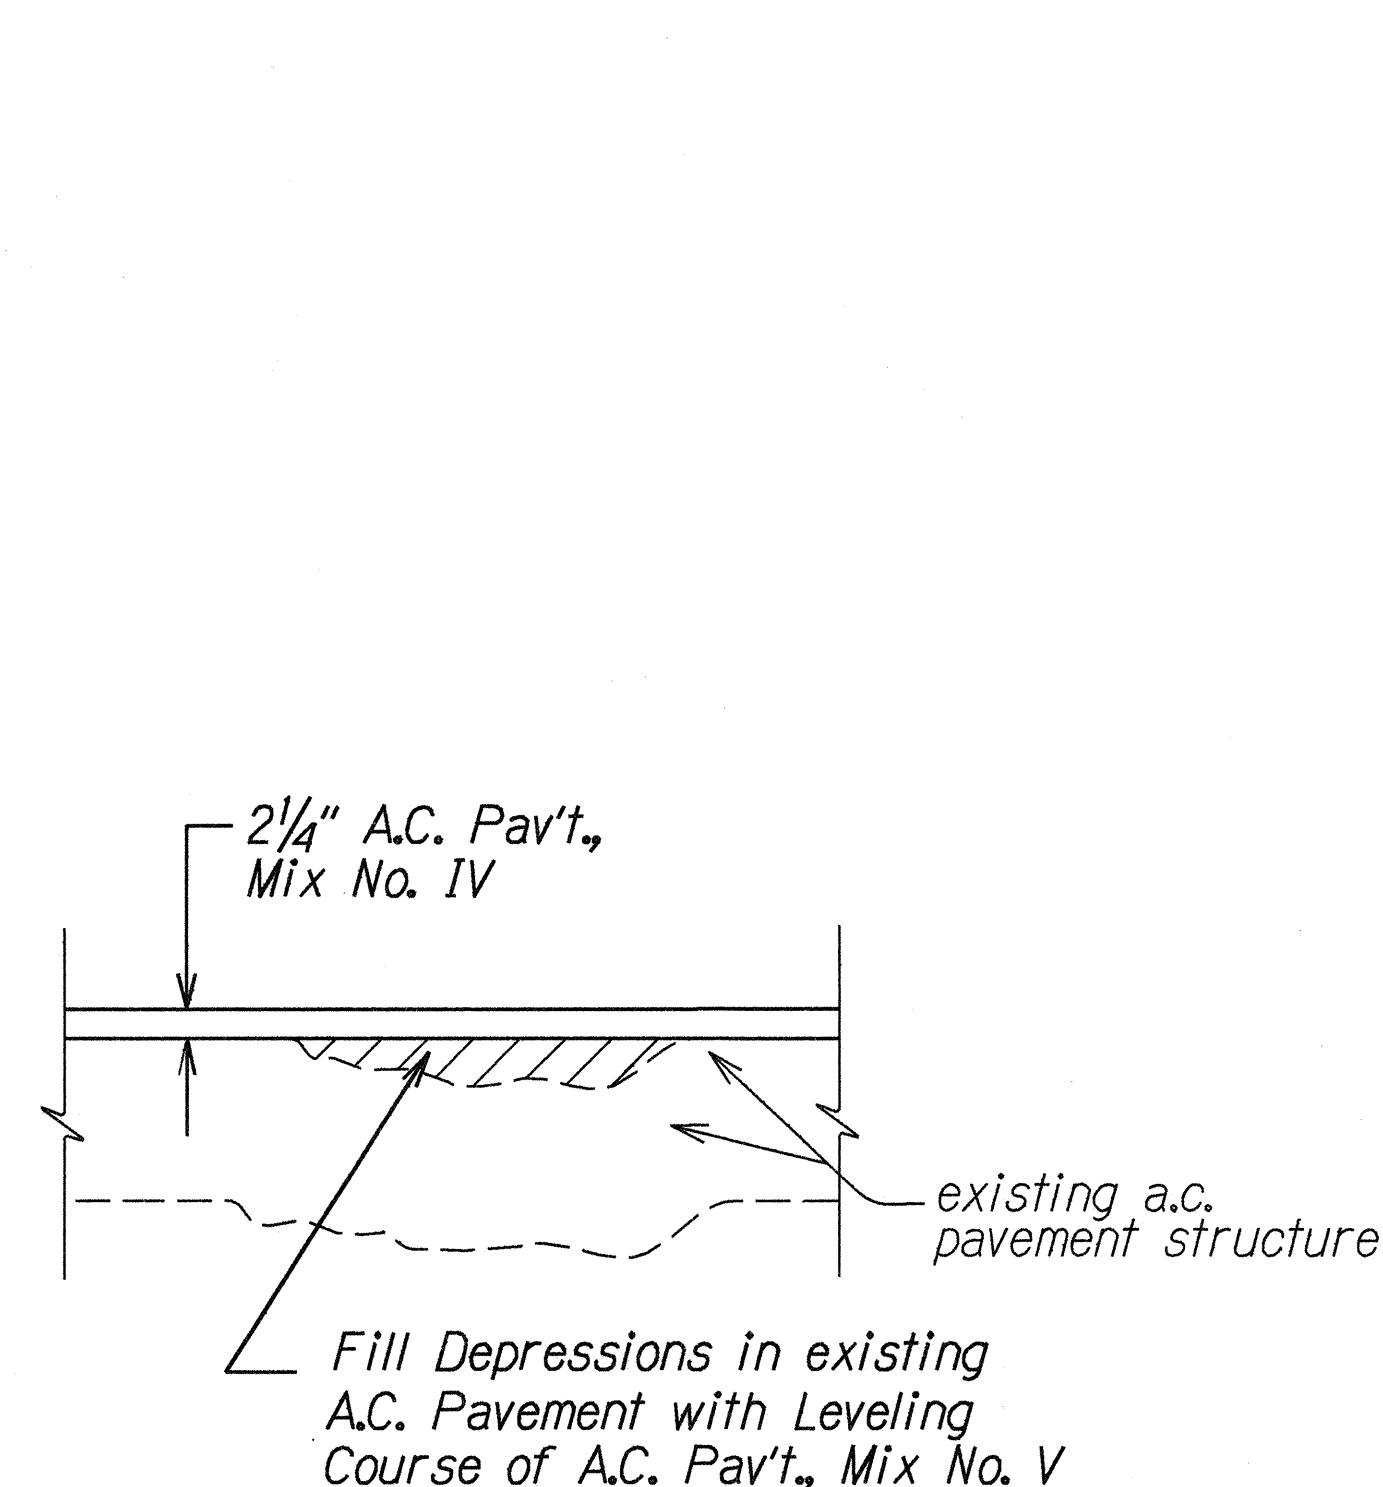

LEVELING COURSE DETAIL
Not To Scale

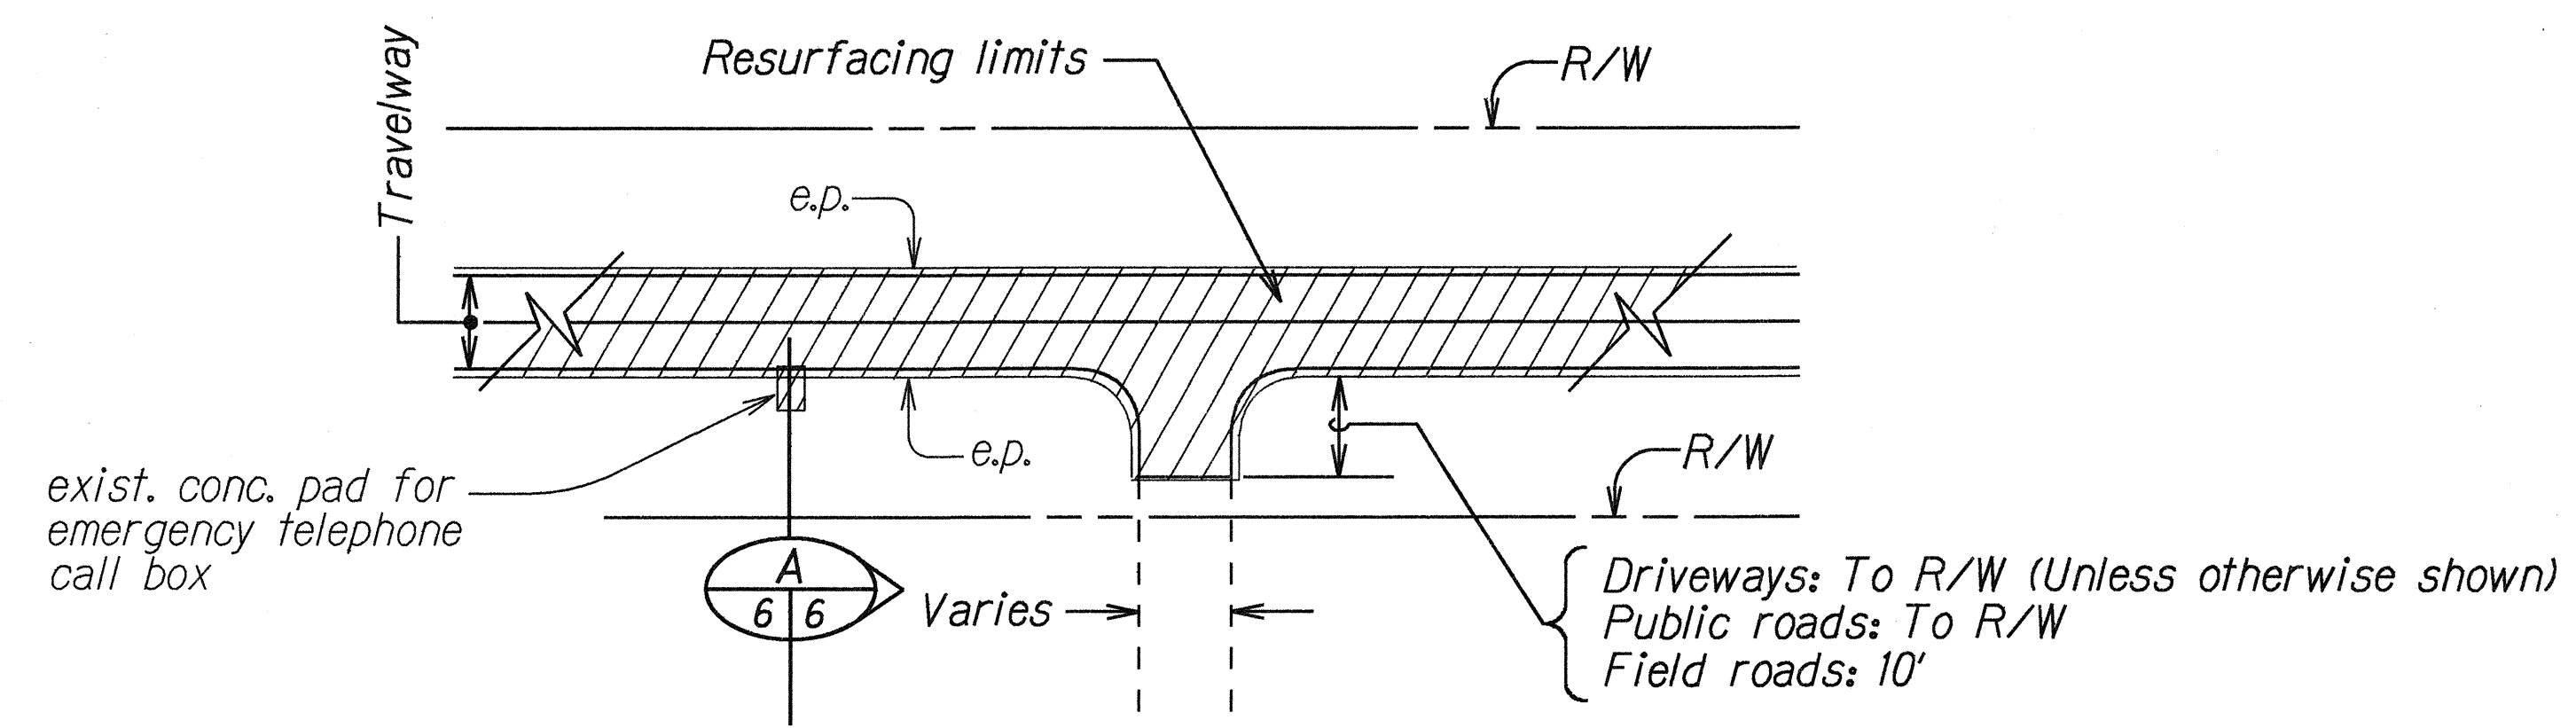

PLAN
TYPICAL RESURFACING LIMITS
Not To Scale

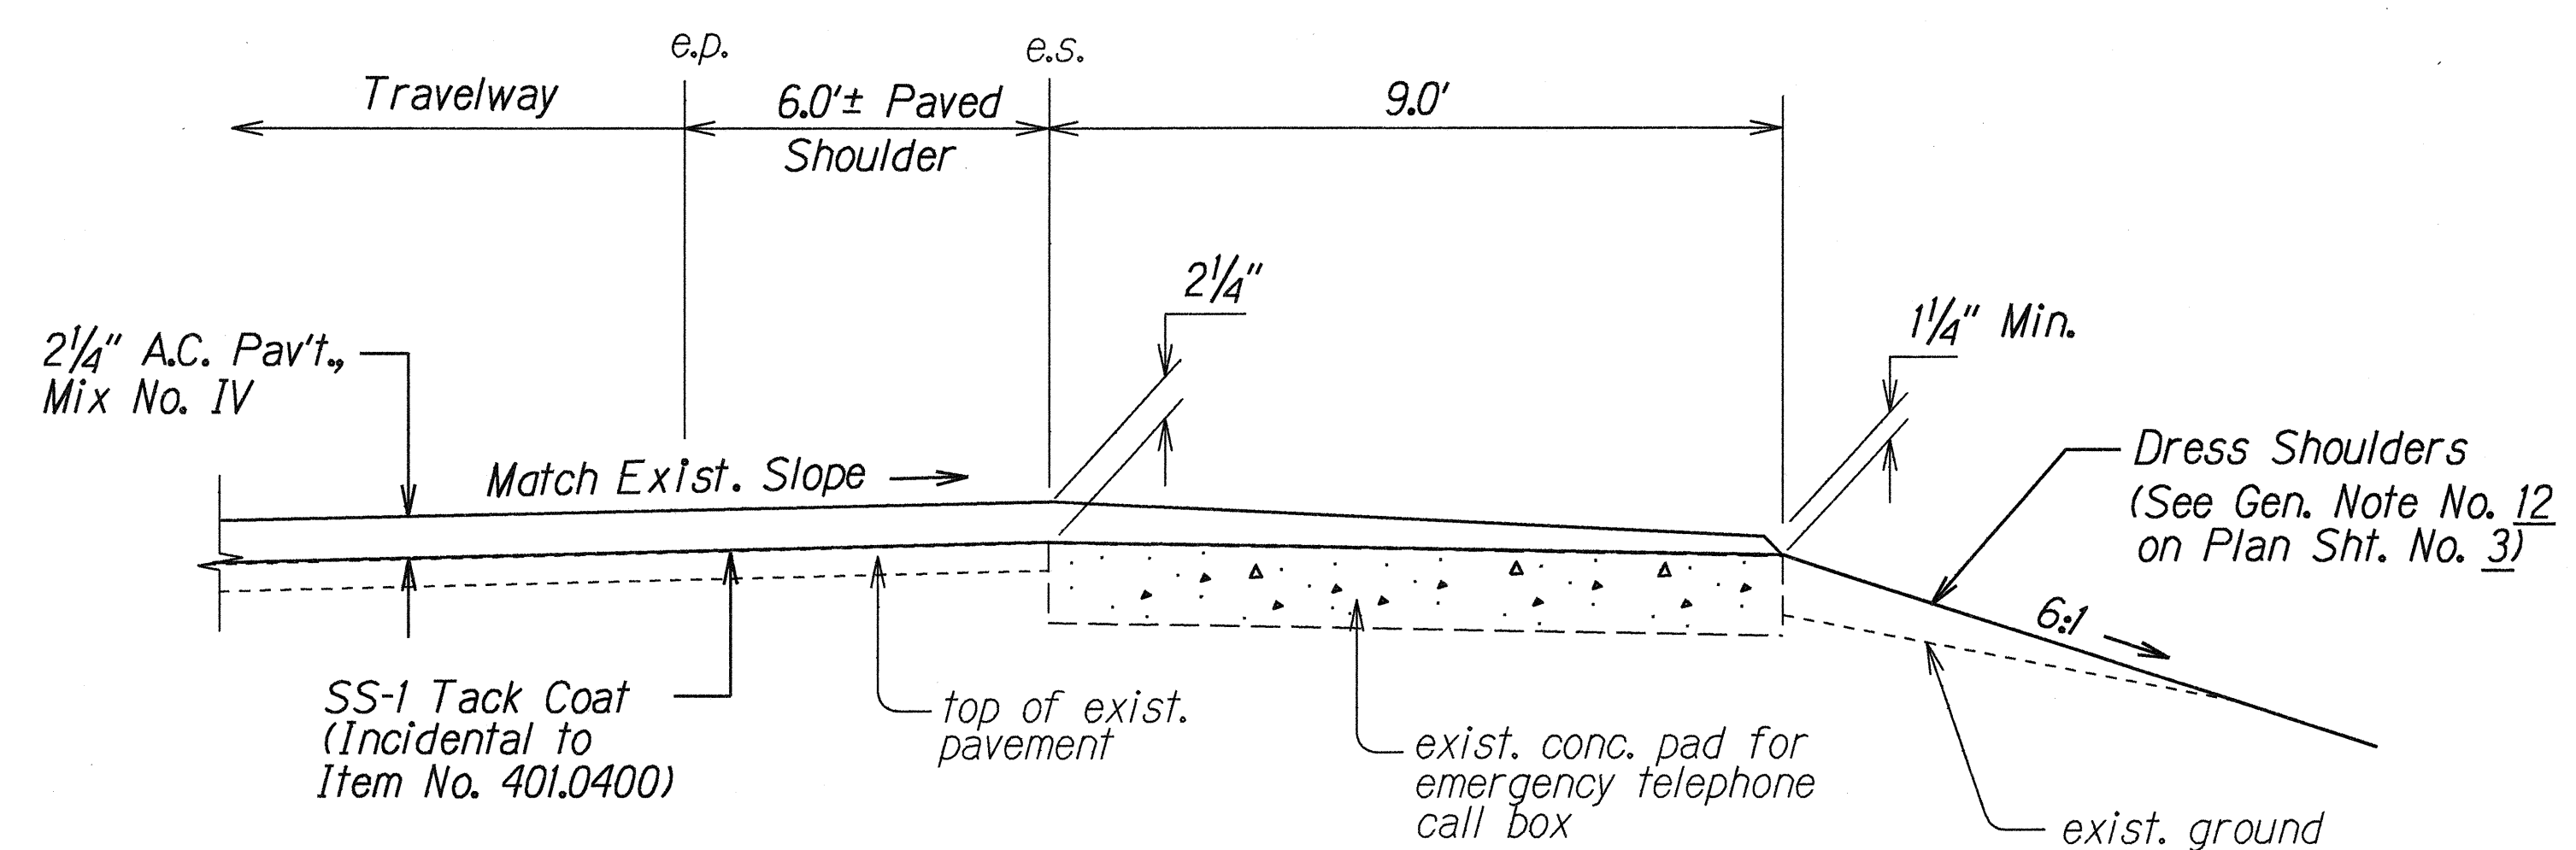

SECTION
Not to Scale

ORIGINAL PLAN	SURVEY PLOTTED BY	DATE
NOTED BY	DRAWN BY	4-7-00
DESIGNED BY	CHECKED BY	
CHECKED BY		

STATE OF HAWAII
DEPARTMENT OF TRANSPORTATION
HIGHWAYS DIVISION

TYPICAL SECTIONS

KAUMUALII HIGHWAY RESURFACING
Vicinity of Wahiawa Bridge
to Laulea Street
Project No. 50C-01-00M

Scale: As Shown Date: April, 2000

SHEET No. 3 OF 3 SHEETS