


FED. ROAD DIST. NO.	STATE	PROJ. NO.	FISCAL YEAR	SHEET NO.	TOTAL SHEETS
HAWAII	HAW.	50B-01-06M	2006	14	20

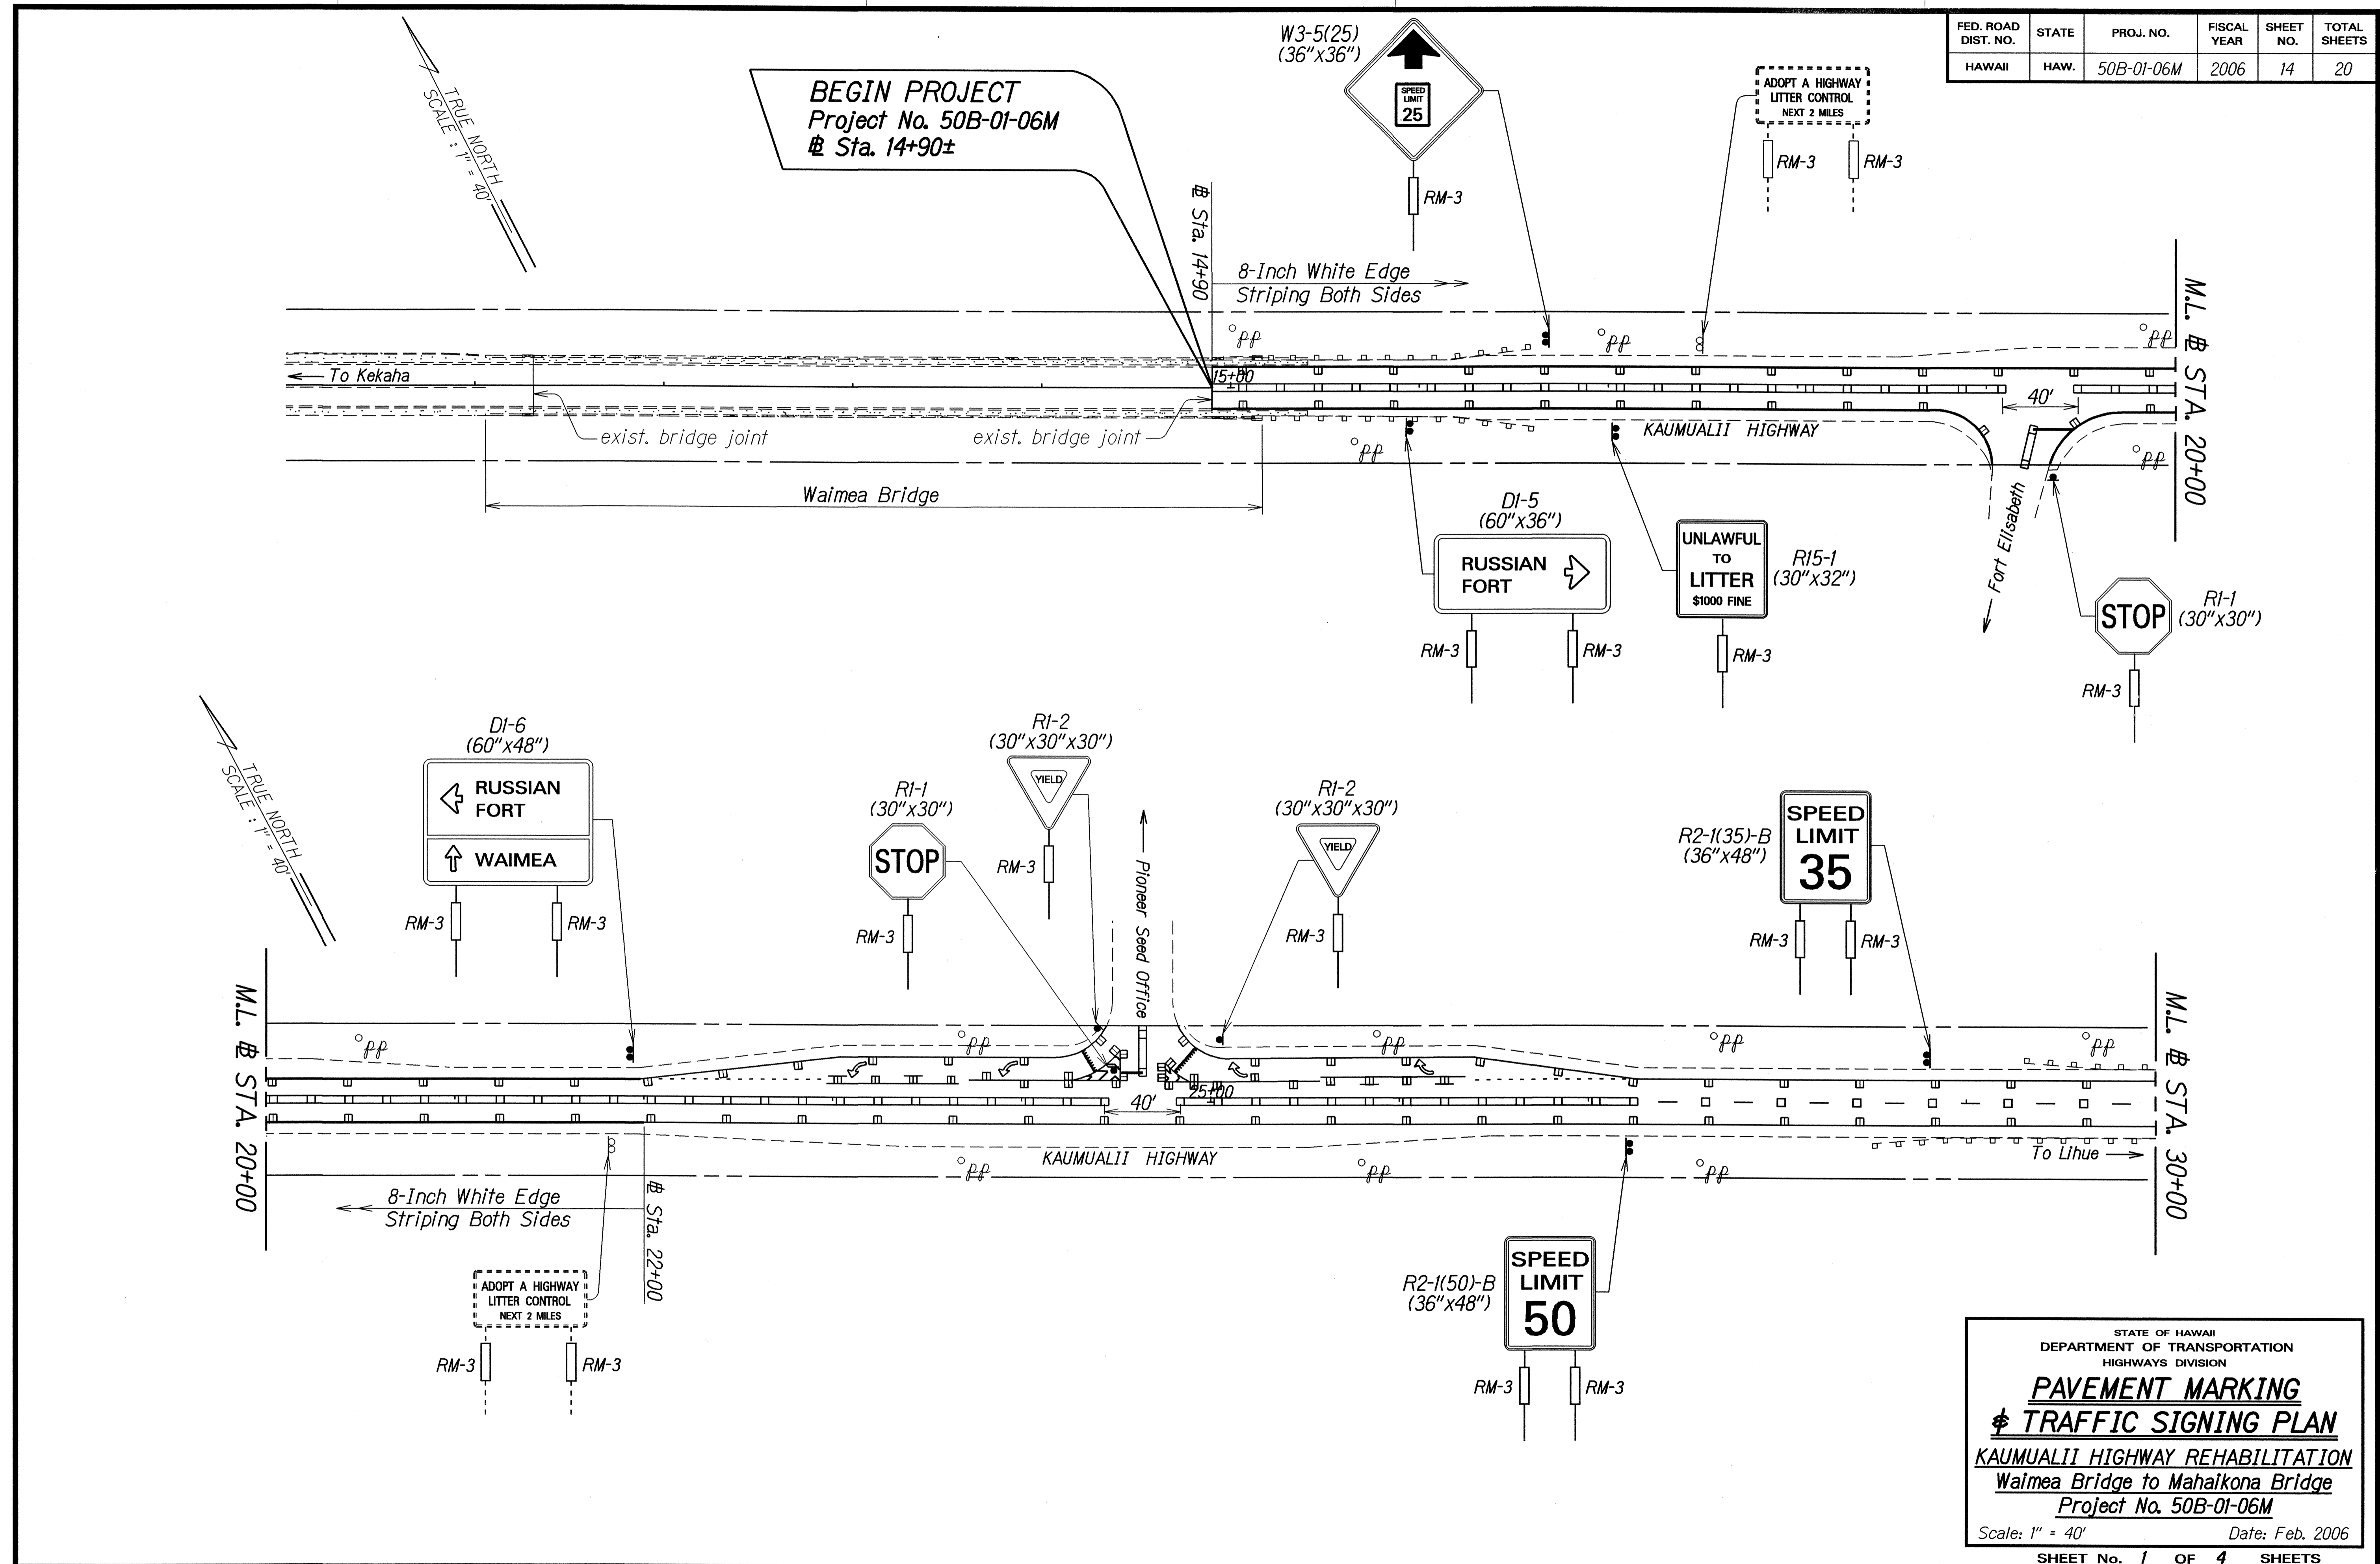

DATE	02/06
DESIGNED BY	K. Wilson
CHECKED BY	K. Wilson
DRAWN BY	K. Wilson
TRACED BY	K. Wilson
PLOTTED BY	K. Wilson
ORIGINAL PLAN	


STATE OF HAWAII
DEPARTMENT OF TRANSPORTATION
HIGHWAYS DIVISION

PAVEMENT MARKING & TRAFFIC SIGNING PLAN

KAUMUALII HIGHWAY REHABILITATION
Waimea Bridge to Mahaikona Bridge
Project No. 50B-01-06M

Scale: 1" = 40' Date: Feb. 2006



FED. ROAD DIST. NO.	STATE	PROJ. NO.	FISCAL YEAR	SHEET NO.	TOTAL SHEETS
HAWAII	HAW.	50B-01-06M	2006	ADD.15	20

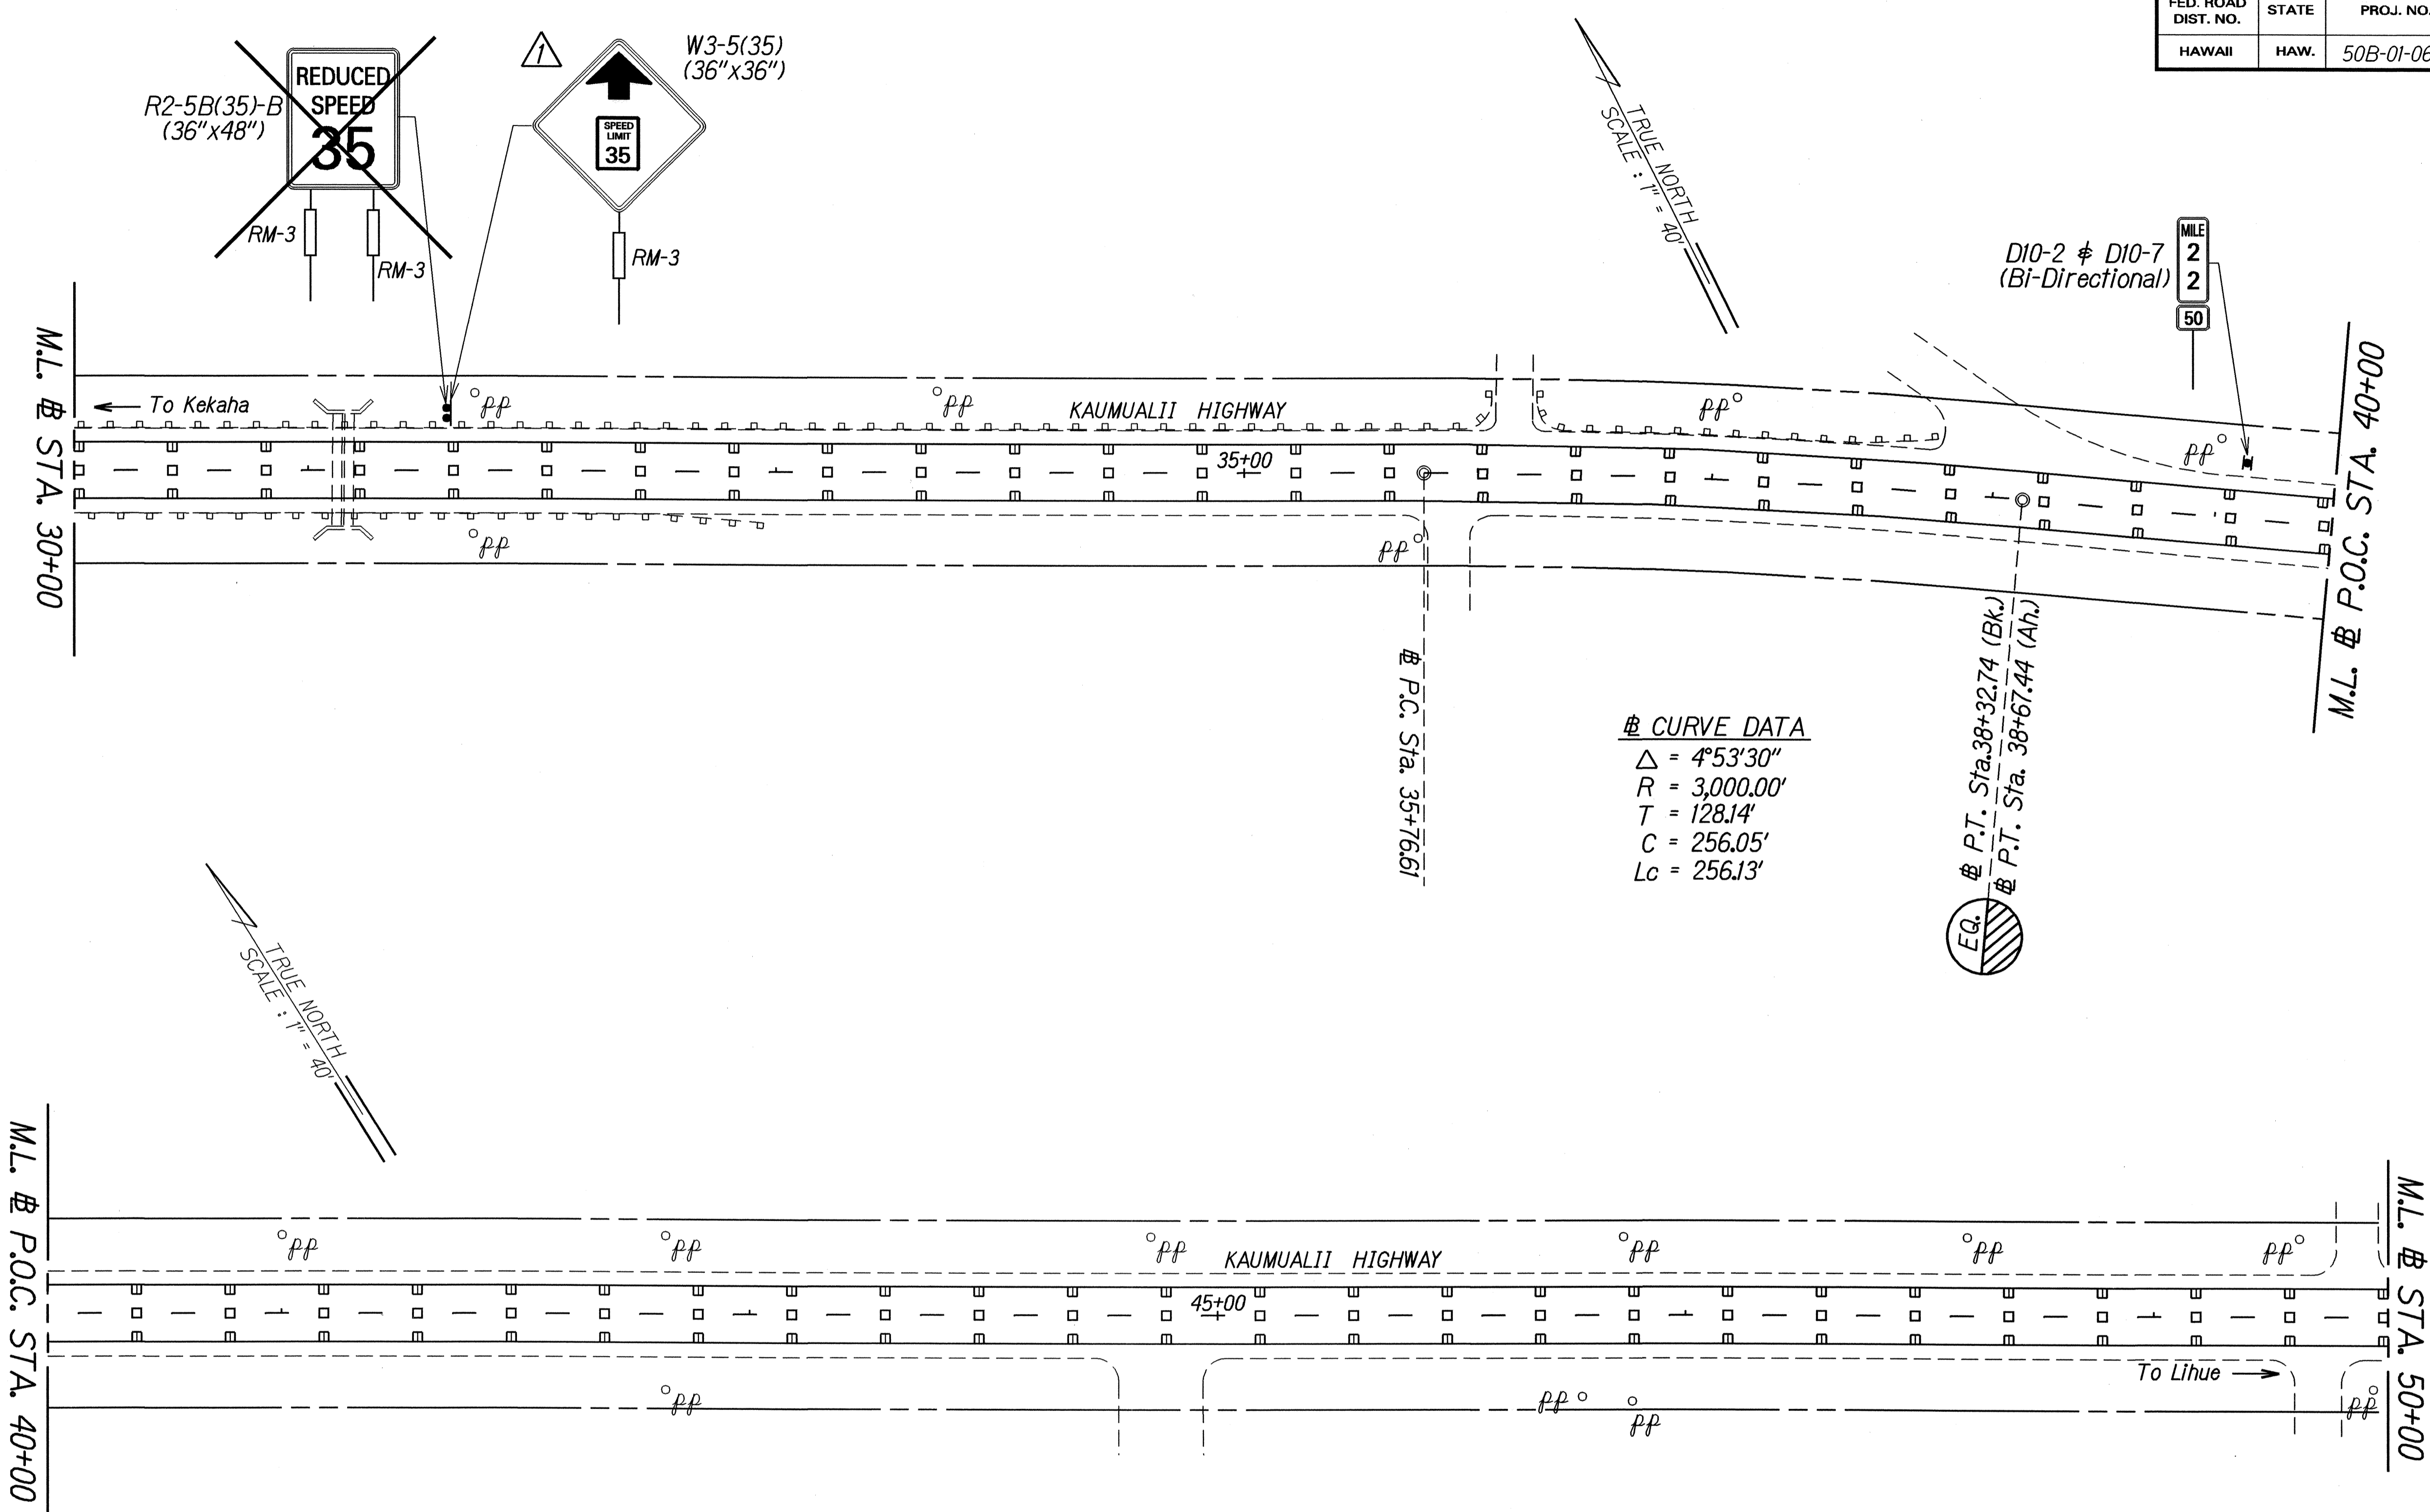

DATE	10/20/05
REVISION	
DESIGNED BY	
CHECKED BY	
DATE	
DESIGNED BY	
CHECKED BY	

4/10/06		Revised Traffic Sign
DATE		REVISION
STATE OF HAWAII DEPARTMENT OF TRANSPORTATION HIGHWAYS DIVISION		
PAVEMENT MARKING TRAFFIC SIGNING PLAN		
KAUMUALII HIGHWAY REHABILITATION Waimea Bridge to Mahaikona Bridge Project No. 50B-01-06M		
Scale: 1" = 40'		Date: April 2006
SHEET No. 2 OF 4 SHEETS		

FED. ROAD DIST. NO.	STATE	PROJ. NO.	FISCAL YEAR	SHEET NO.	TOTAL SHEETS
HAWAII	HAW.	50B-01-06M	2006	16	20

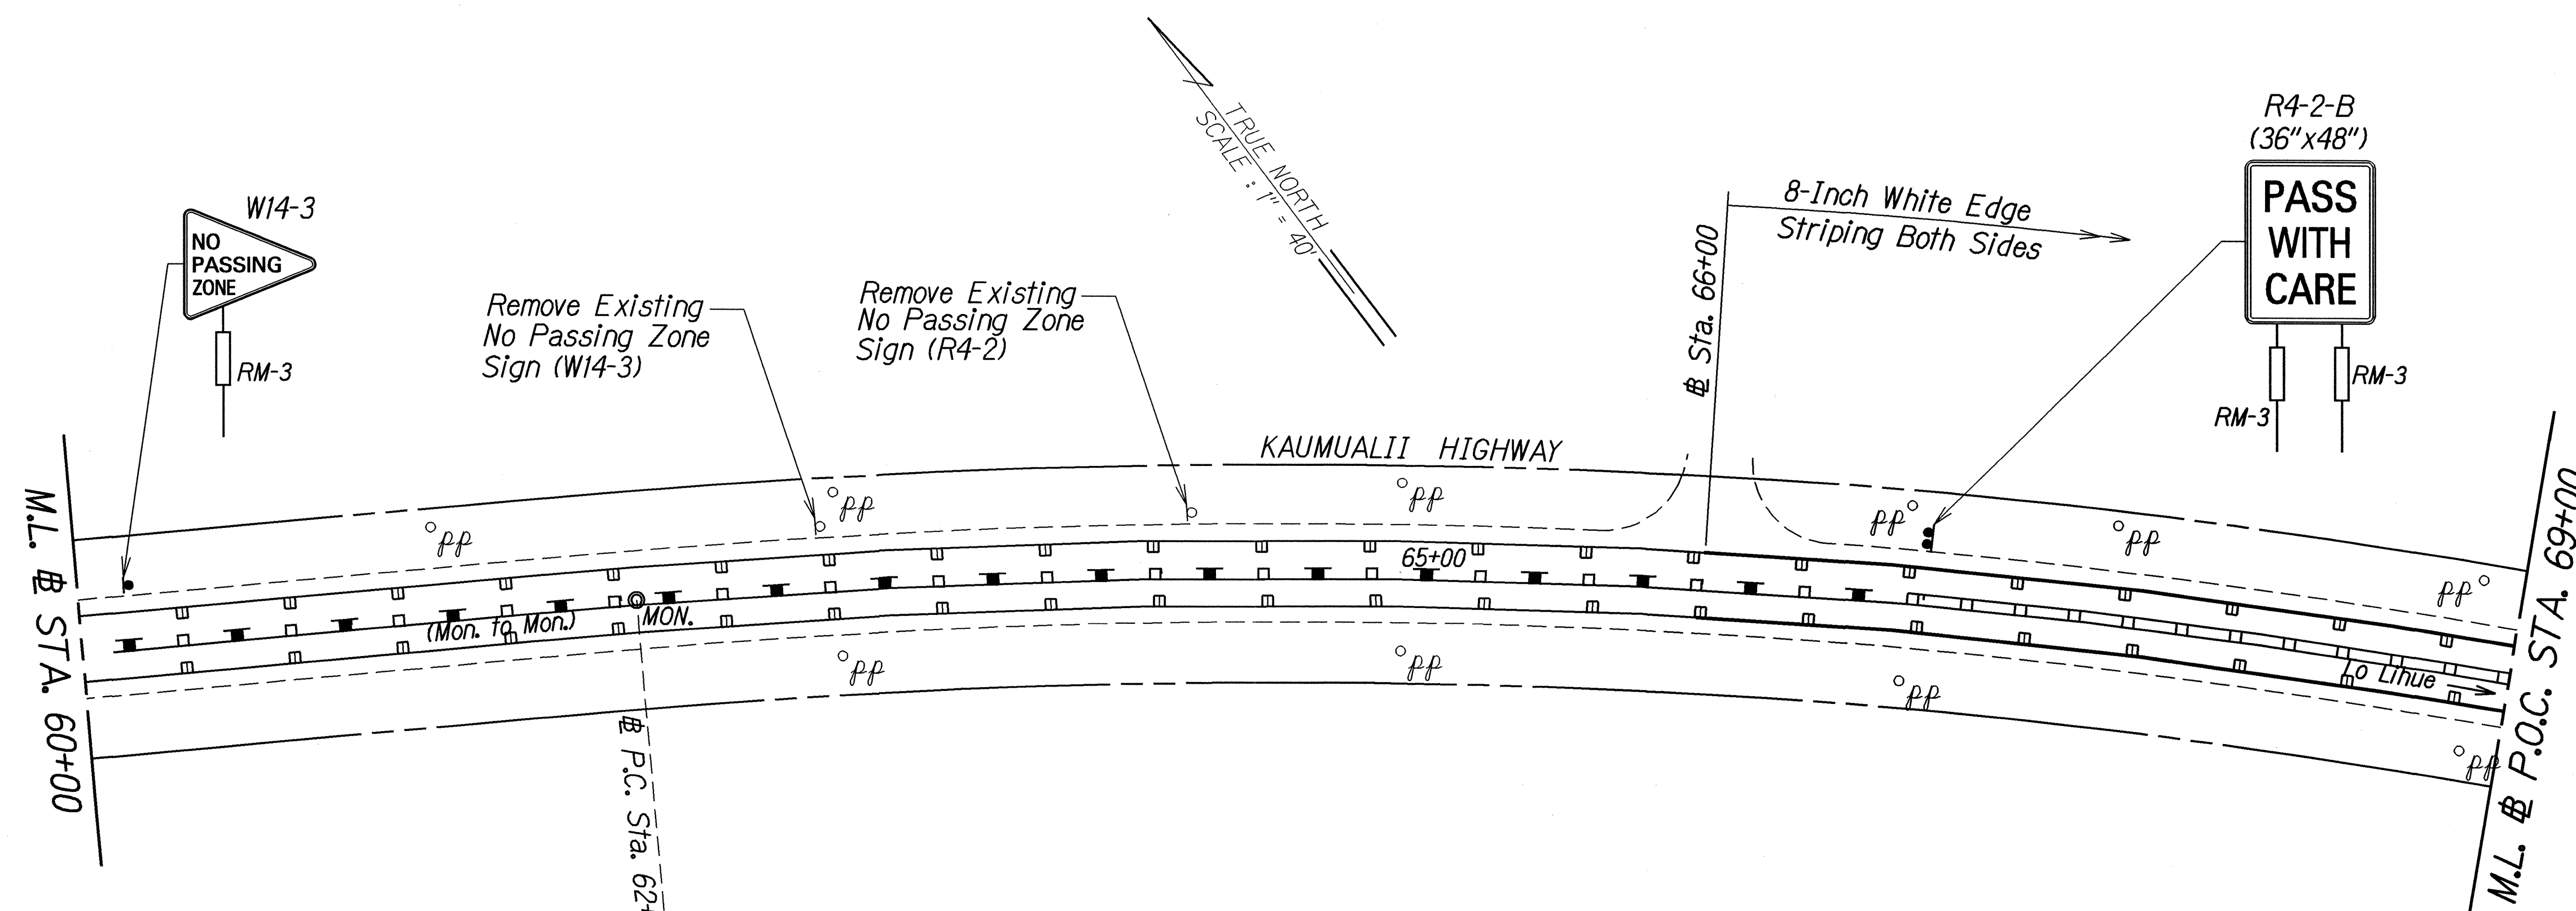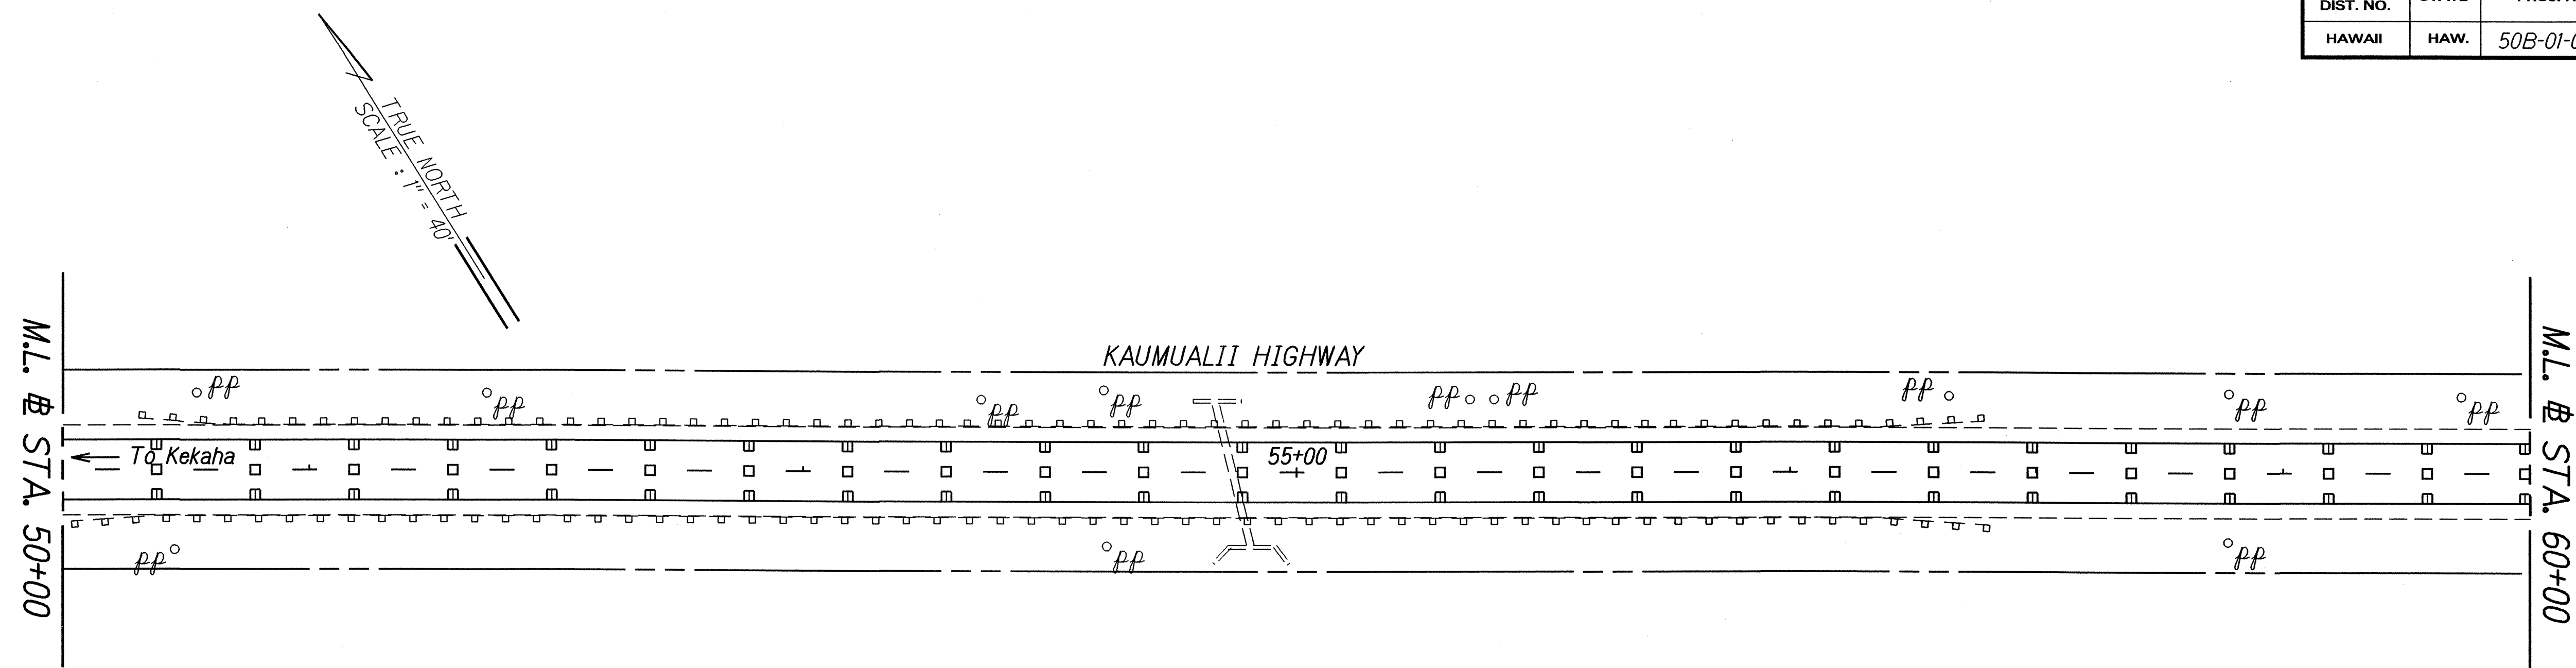


☯ CURVE DATA
 $\Delta = 43^\circ 41' 30''$
 $R = 2,700.00'$
 $T = 1,082.43'$
 $C = 2,009.40'$
 $Lc = 2,058.92'$

ORIGINAL PLAN	DATE
DESIGNED BY	
CHECKED BY	
DRAWN BY	
DATE	

STATE OF HAWAII
 DEPARTMENT OF TRANSPORTATION
 HIGHWAYS DIVISION
PAVEMENT MARKING
☯ TRAFFIC SIGNING PLAN
KAUMUALII HIGHWAY REHABILITATION
 Waimea Bridge to Mahaikona Bridge
 Project No. 50B-01-06M
 Scale: 1" = 40' Date: Feb. 2006
 SHEET No. 3 OF 4 SHEETS

FED. ROAD DIST. NO.	STATE	PROJ. NO.	FISCAL YEAR	SHEET NO.	TOTAL SHEETS
HAWAII	HAW.	50B-01-06M	2006	17	20

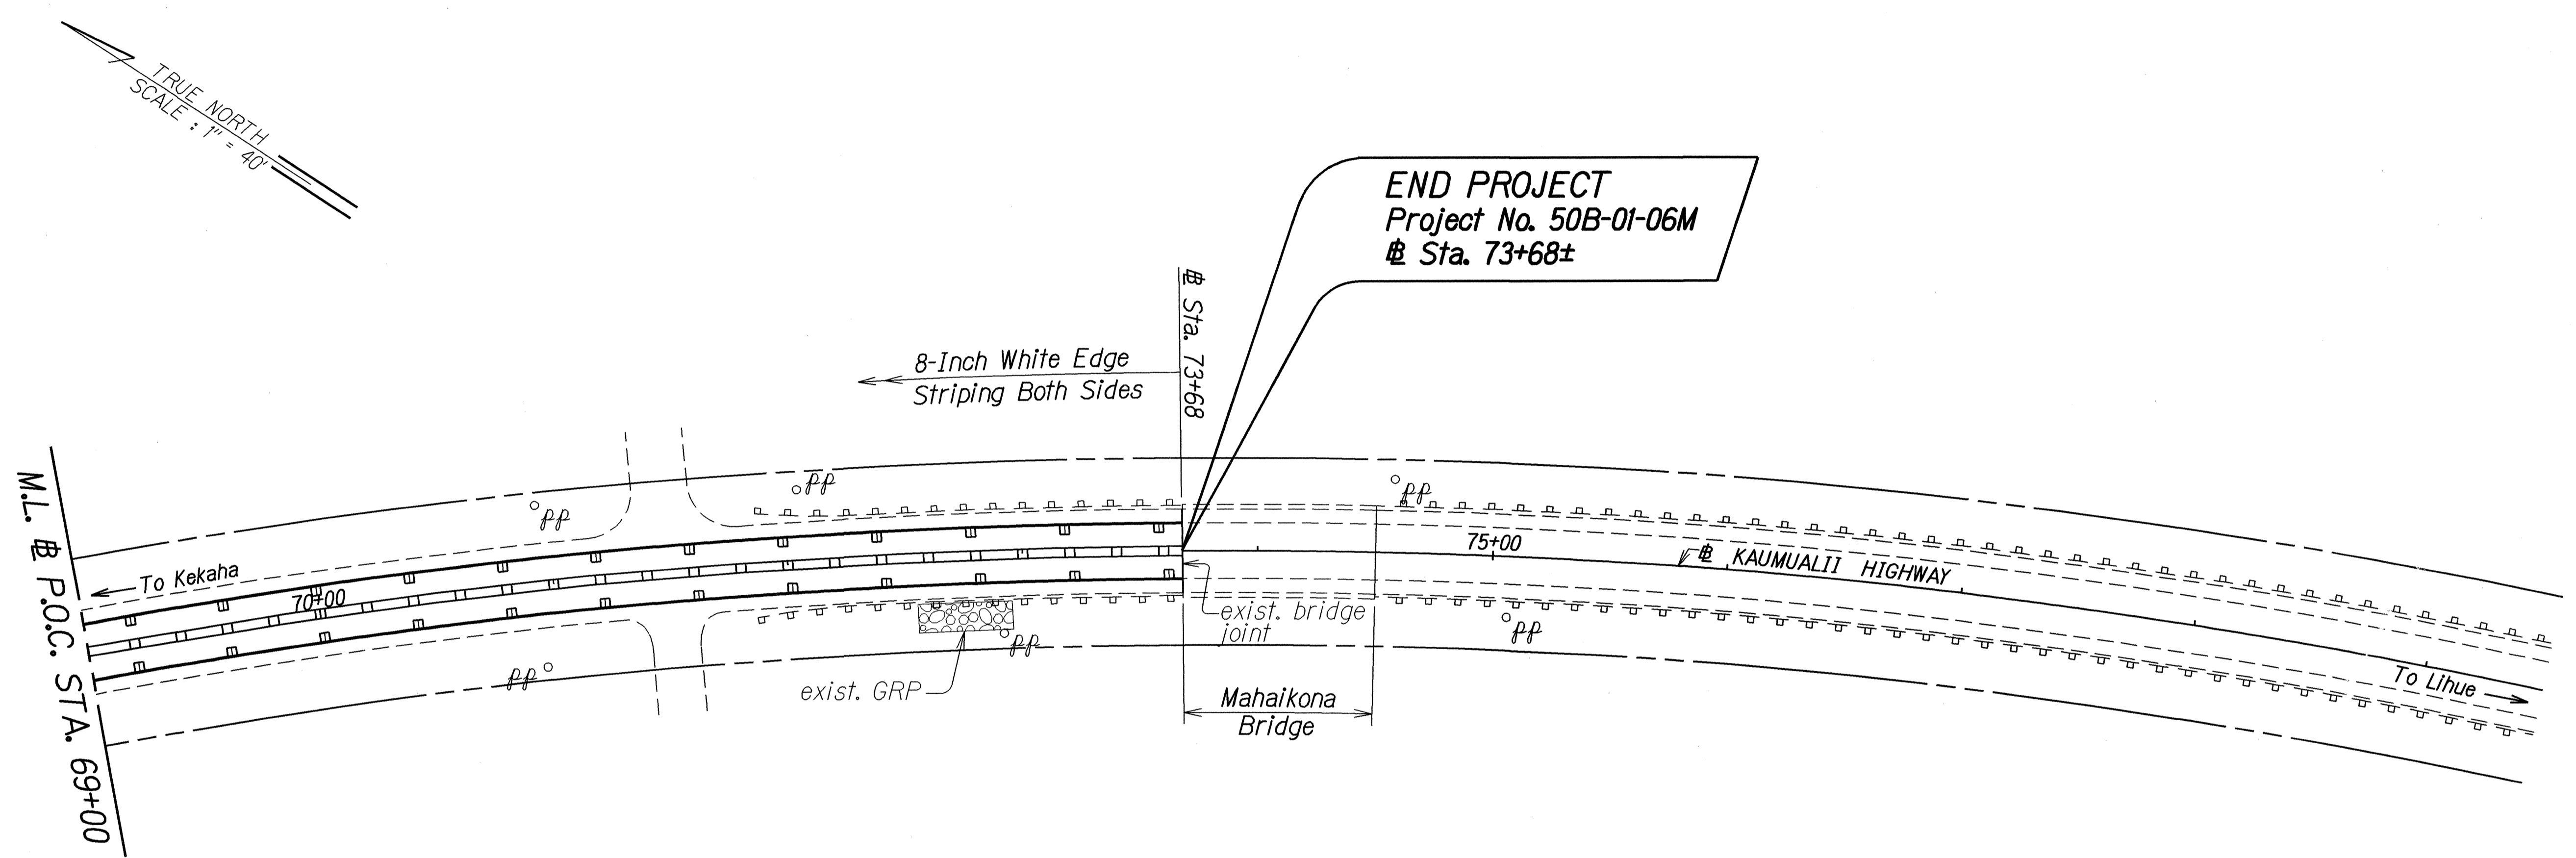

⊕ CURVE DATA
 $\Delta = 43^{\circ}41'30''$
 $R = 2,700.00'$
 $T = 1,082.43'$
 $C = 2,009.40'$
 $Lc = 2,058.92'$

DATE	10/20/05
SURVEY PLOTTED BY	
DRAWN BY	
DESIGNED BY	
CHECKED BY	
ORIGINAL PLAN	
NOTE BOOK	
DESIGNED BY	
CHECKED BY	

STATE OF HAWAII
DEPARTMENT OF TRANSPORTATION
HIGHWAYS DIVISION

PAVEMENT MARKING
⊕ TRAFFIC SIGNING PLAN

KAUMUALII HIGHWAY REHABILITATION
Waimea Bridge to Mahaikona Bridge
Project No. 50B-01-06M

Scale: 1" = 40' Date: Feb. 2006

SHEET No. 4 OF 4 SHEETS