



FED. ROAD DIST. NO.	STATE	PROJ. NO.	FISCAL YEAR	SHEET NO.	TOTAL SHEETS
HAWAII	HAW.	50C-01-01M	2003	9	32

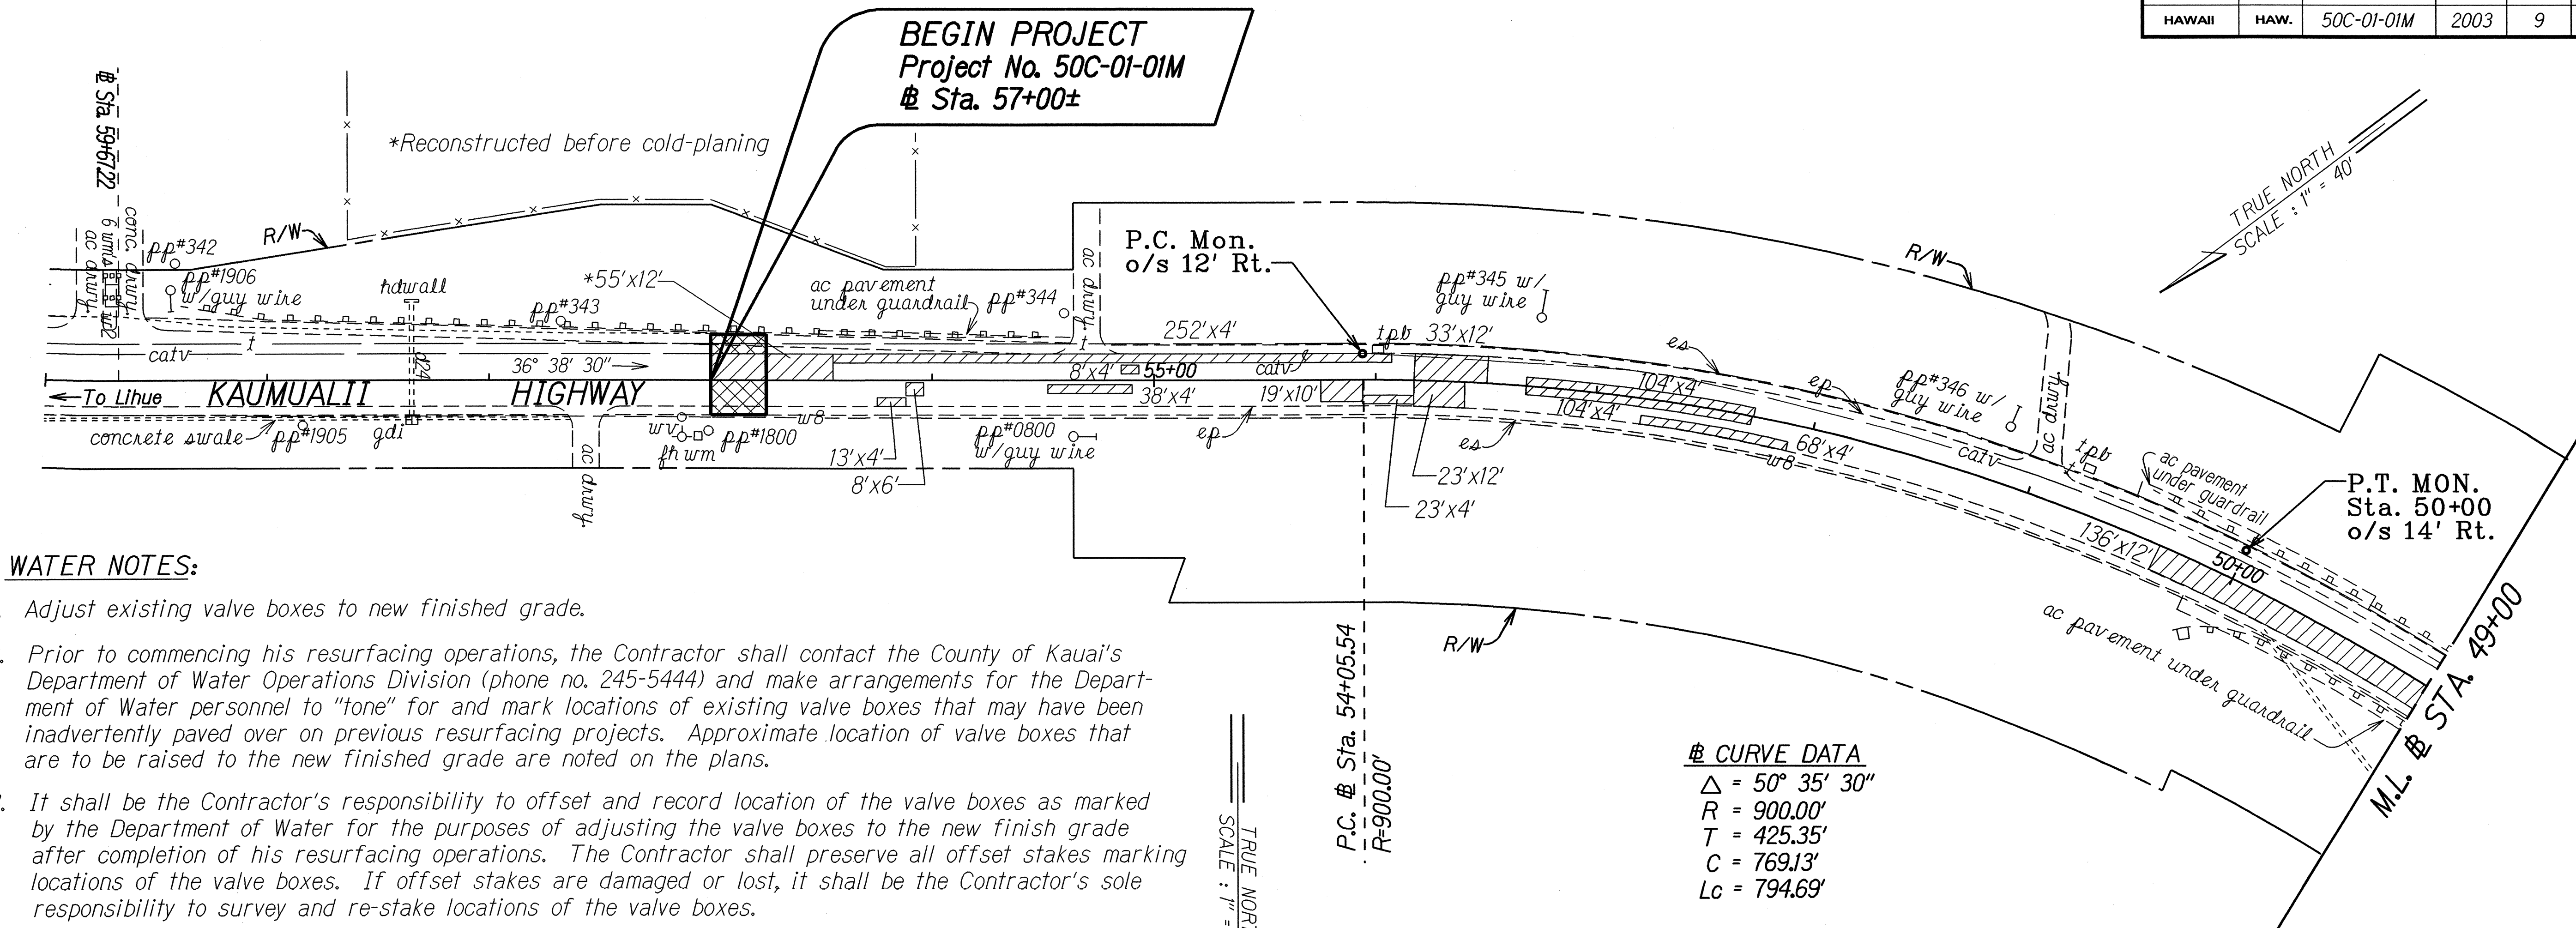

WATER NOTES:

- Adjust existing valve boxes to new finished grade.
- Prior to commencing his resurfacing operations, the Contractor shall contact the County of Kauai's Department of Water Operations Division (phone no. 245-5444) and make arrangements for the Department of Water personnel to "tone" for and mark locations of existing valve boxes that may have been inadvertently paved over on previous resurfacing projects. Approximate location of valve boxes that are to be raised to the new finished grade are noted on the plans.
- It shall be the Contractor's responsibility to offset and record location of the valve boxes as marked by the Department of Water for the purposes of adjusting the valve boxes to the new finish grade after completion of his resurfacing operations. The Contractor shall preserve all offset stakes marking locations of the valve boxes. If offset stakes are damaged or lost, it shall be the Contractor's sole responsibility to survey and re-stake locations of the valve boxes.


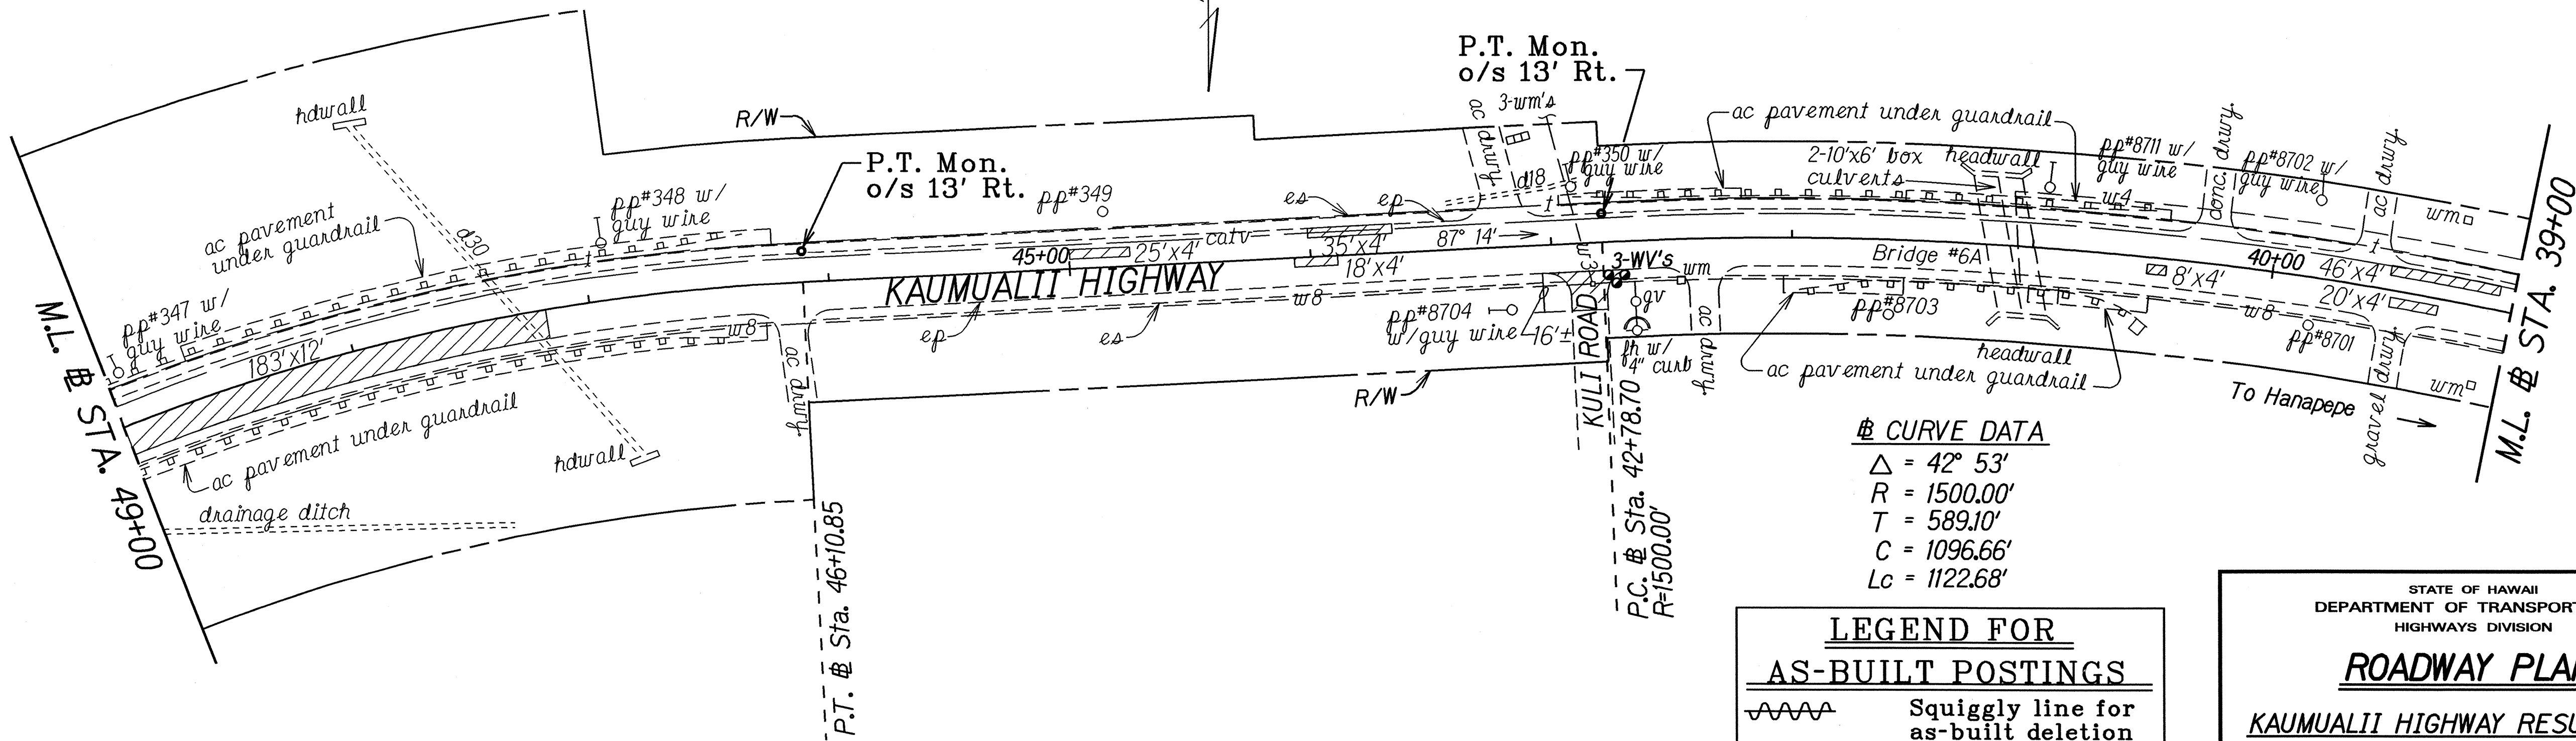


DATE	11/23/02
SURVEY PLOTTED BY	...
DESIGNED BY	...
QUANTITIES BY	...
CHECKED BY	...
ORIGINAL PLAN	...
NOTE BOOK	...
DATE	...

LEGEND FOR AS-BUILT POSTINGS	
	Squiggly line for as-built deletion
	Double line for as-built deletion
Roadway	Text for as-built posting

STATE OF HAWAII
DEPARTMENT OF TRANSPORTATION
HIGHWAYS DIVISION
ROADWAY PLAN
KAUMUALII HIGHWAY RESURFACING
Lawai Bridge to Halewili Road, Kalaheo
Project No. 50C-01-01M
Scale: 1" = 40' Date: March 2003
SHEET No. 1 OF 5 SHEETS

FED. ROAD DIST. NO.	STATE	PROJ. NO.	FISCAL YEAR	SHEET NO.	TOTAL SHEETS
HAWAII	HAW.	50C-01-01M	2003	10	32

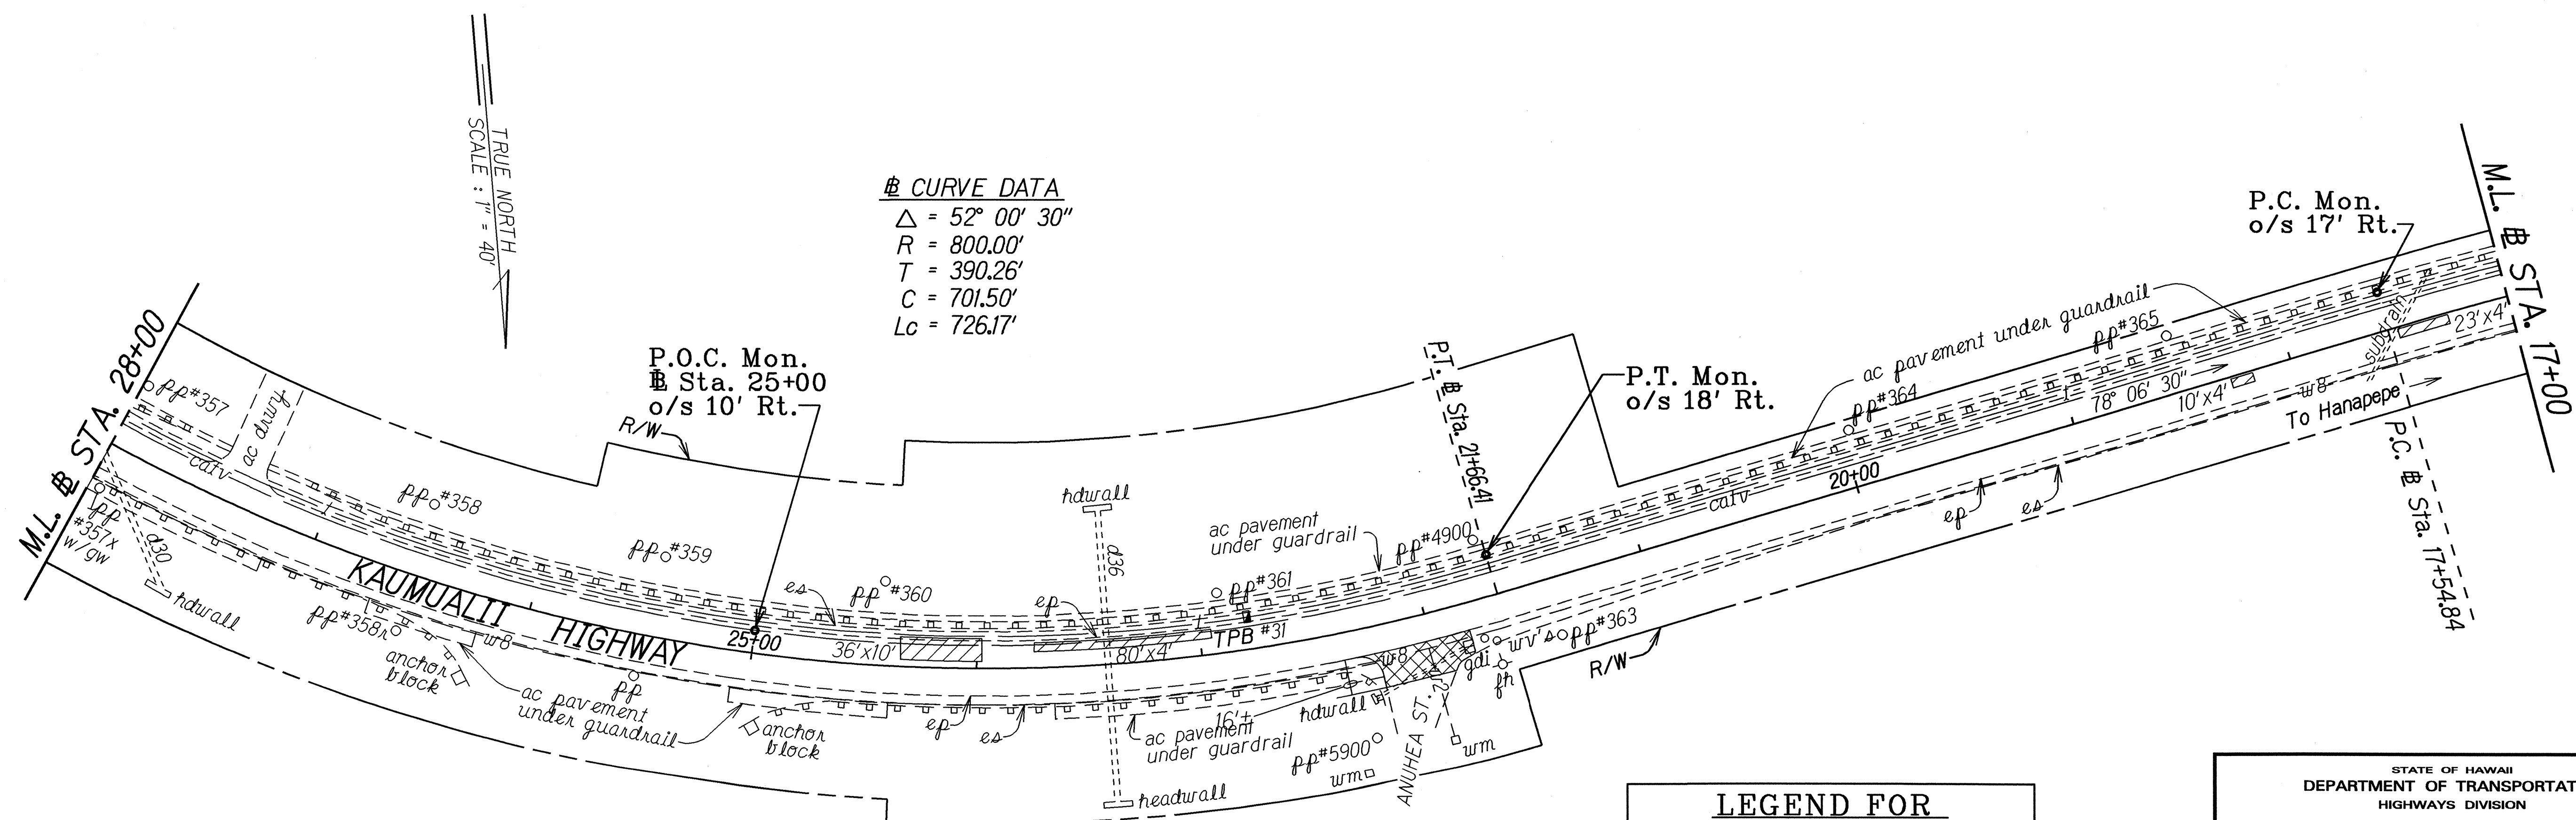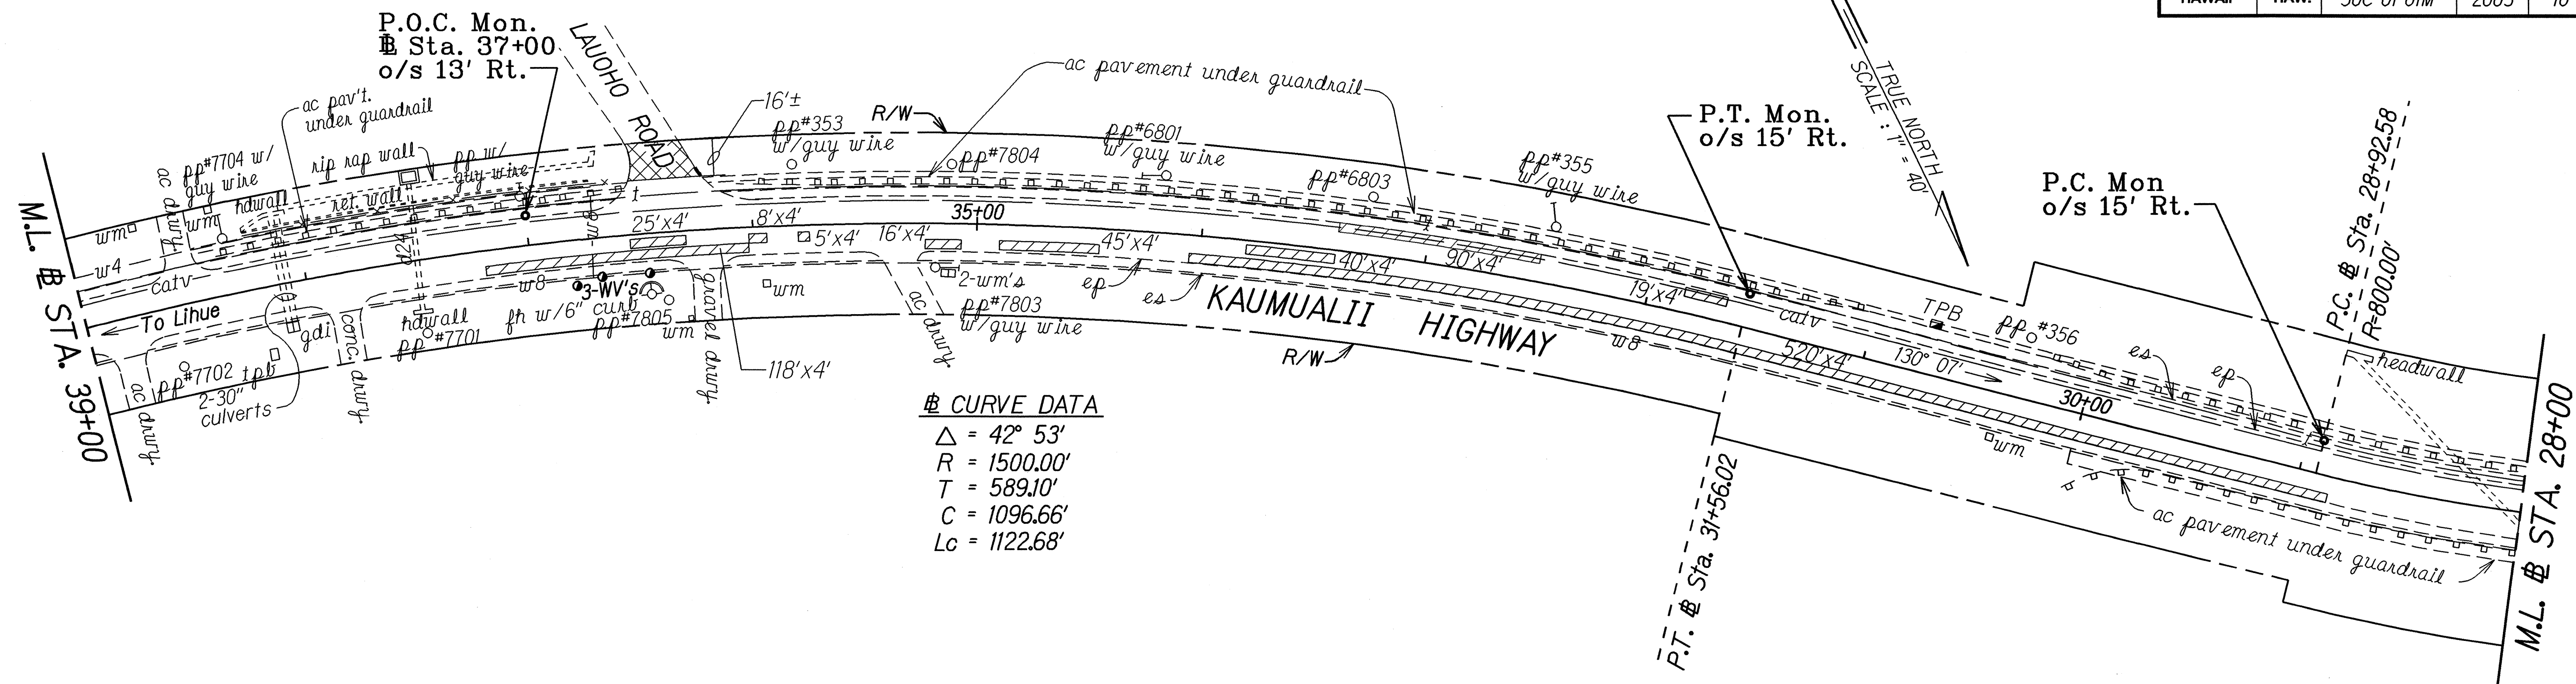

SURVEY PLOTTED BY	DATE
DESIGNED BY	5/28/02
TRACED BY	
NOTE BOOK	
QUANTITIES BY	
CHECKED BY	

LEGEND FOR AS-BUILT POSTINGS	
	Squiggly line for as-built deletion
	Double line for as-built deletion
Roadway	Text for as-built posting

STATE OF HAWAII
DEPARTMENT OF TRANSPORTATION
HIGHWAYS DIVISION



ROADWAY PLAN

KAUMUALII HIGHWAY RESURFACING
Lawai Bridge to Halewill Road, Kalaheo
Project No. 50C-01-01M

Scale: 1" = 40' Date: March 2003

SHEET No. 2 OF 5 SHEETS

"AS-BUILT"

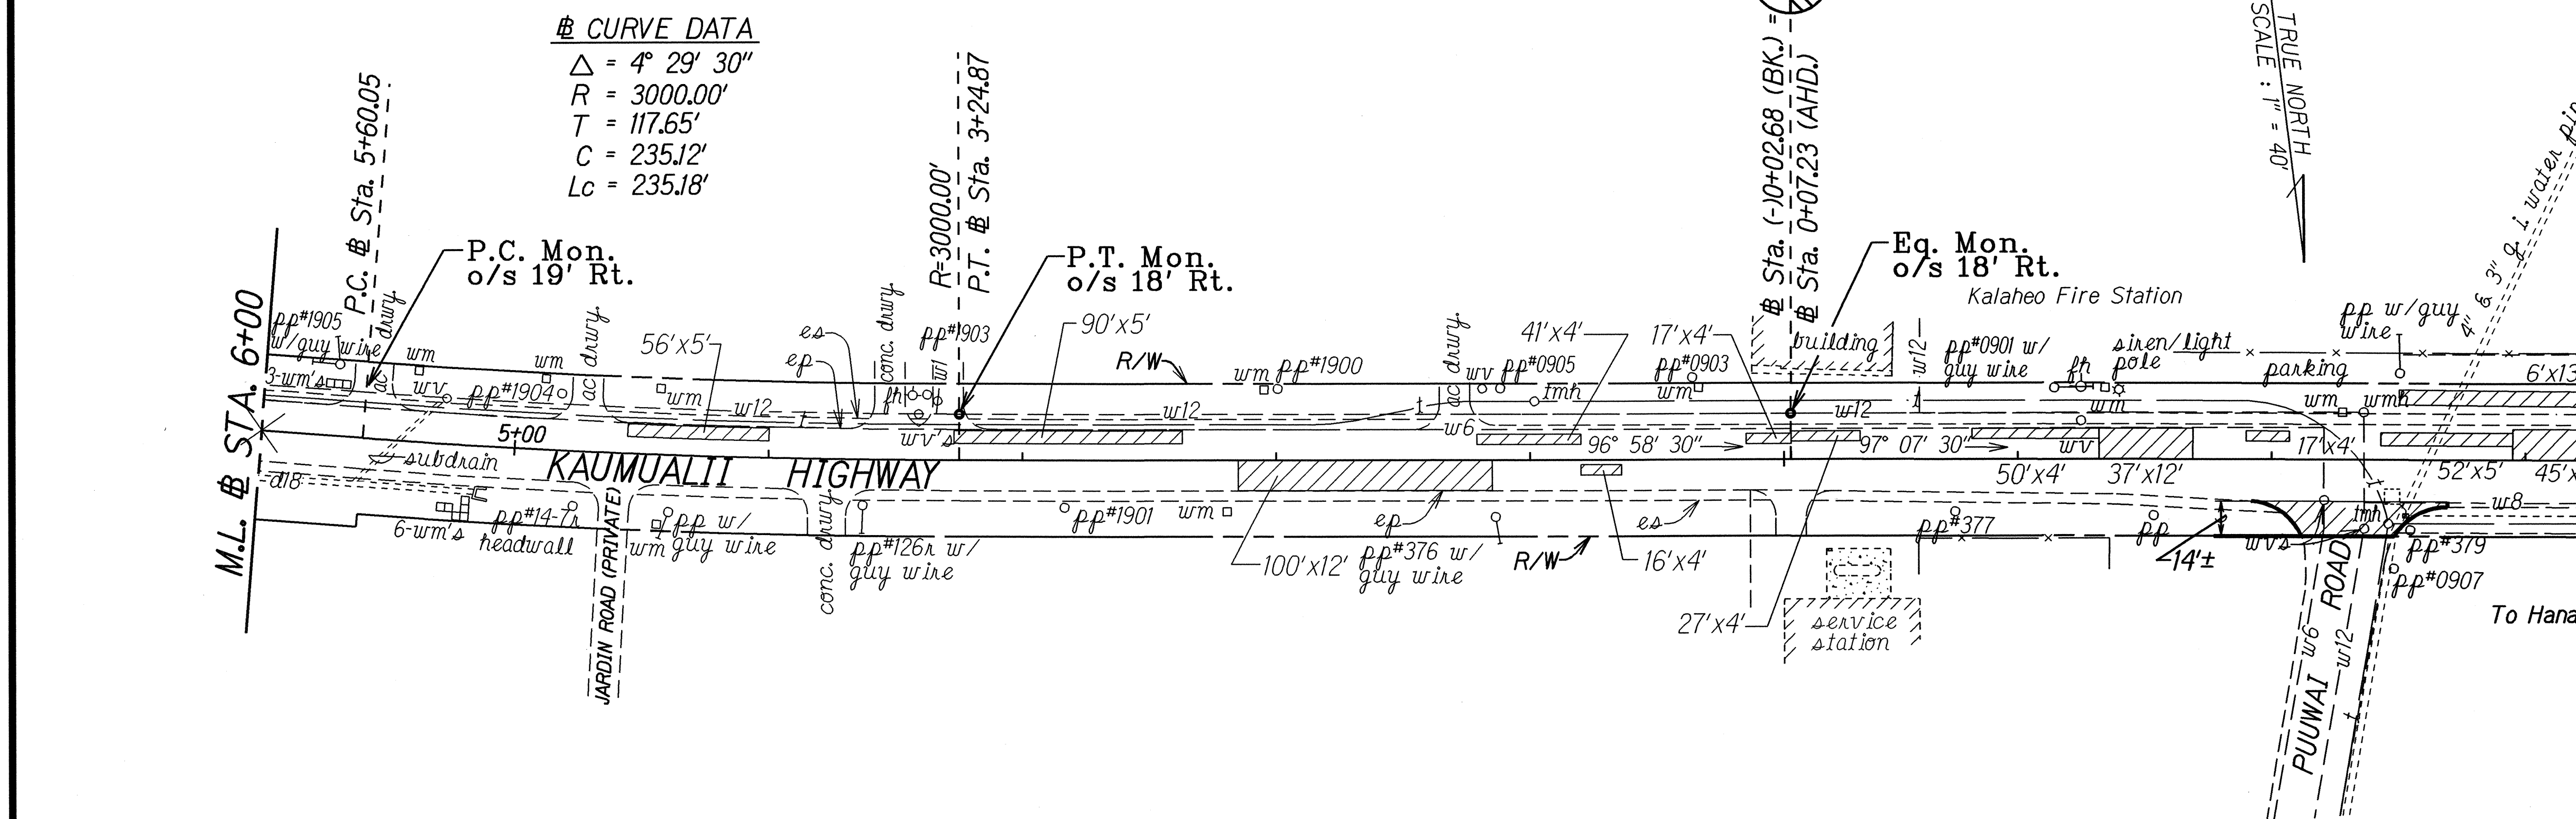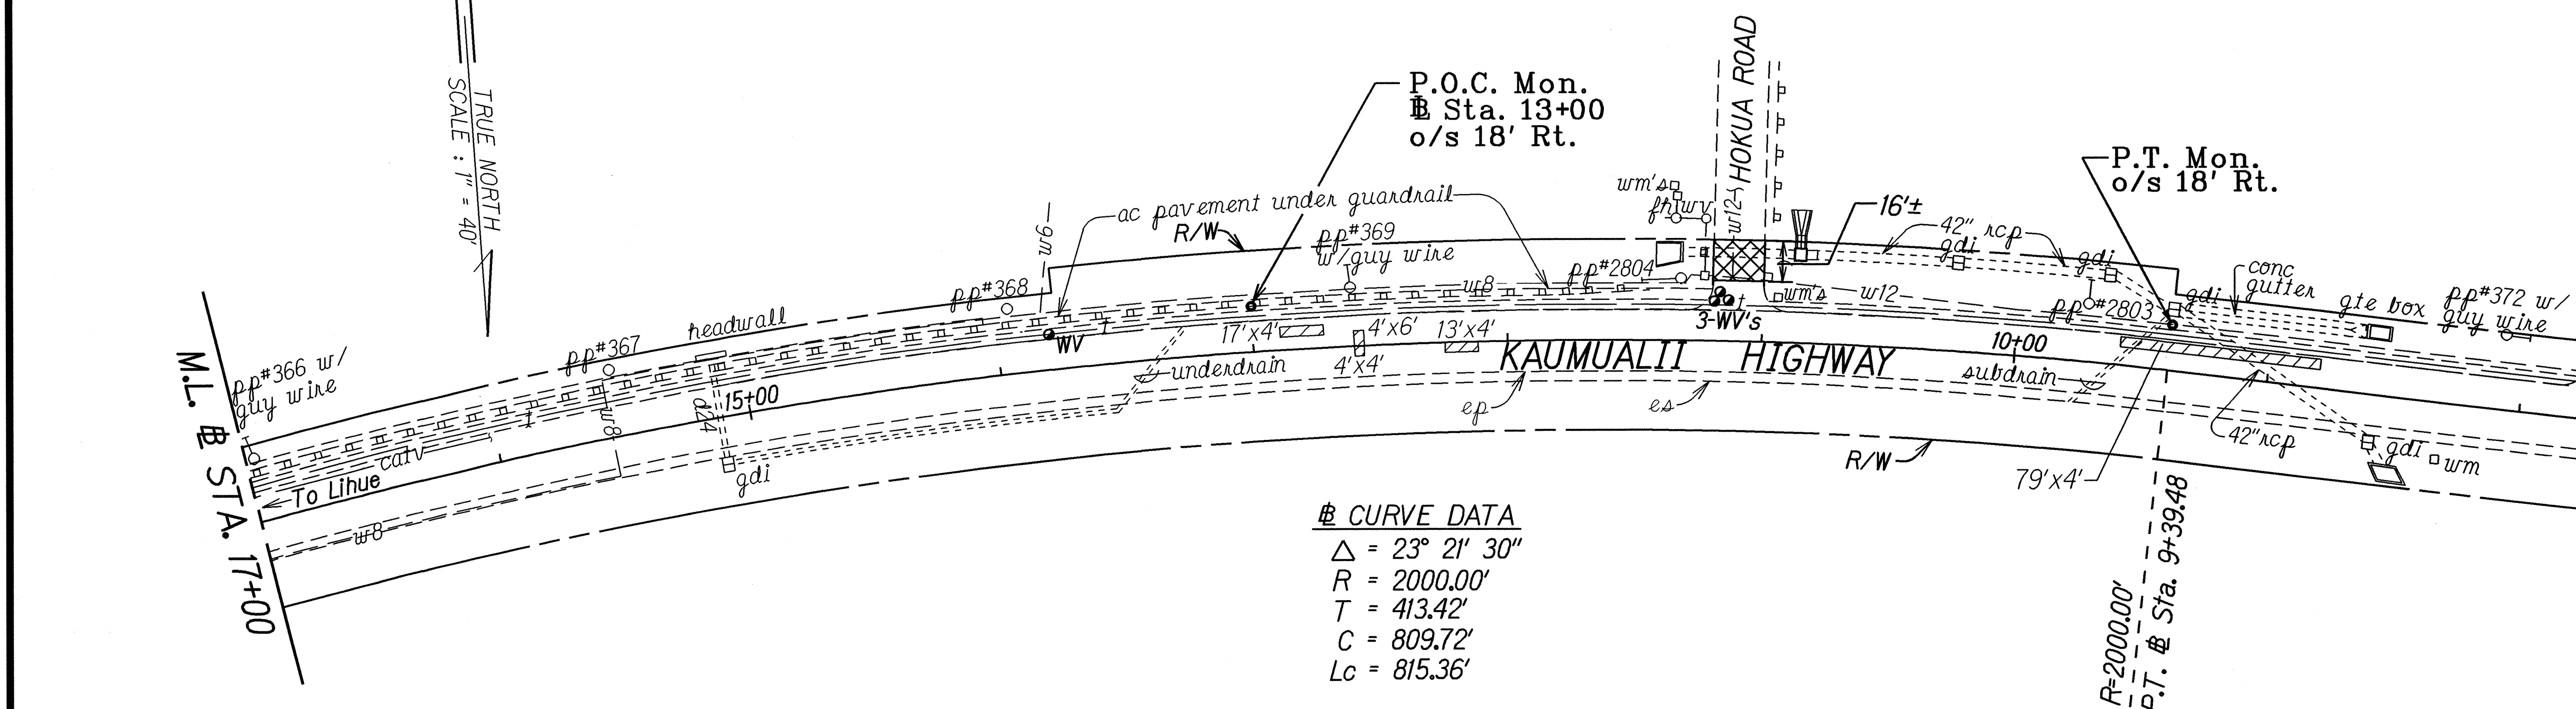

<u>LEGEND FOR</u> <u>AS-BUILT POSTINGS</u>	
	Squiggly line for as-built deletion
100-00	Double line for as-built deletion
Roadway	Text for as-built posting

STATE OF HAWAII
DEPARTMENT OF TRANSPORTATION
HIGHWAYS DIVISION


ROADWAY PLAN

KAUMUALII HIGHWAY RESURFACING
Lawai Bridge to Halewili Road, Kalaheo
Project No. 50C-01-01M

Scale: 1" = 40' Date: March 2003

SHEET No. 3 OF 5 SHEETS

FED. ROAD DIST. NO.	STATE	PROJ. NO.	FISCAL YEAR	SHEET NO.	TOTAL SHEETS
HAWAII	HAW.	50C-01-01M	2003	12	32

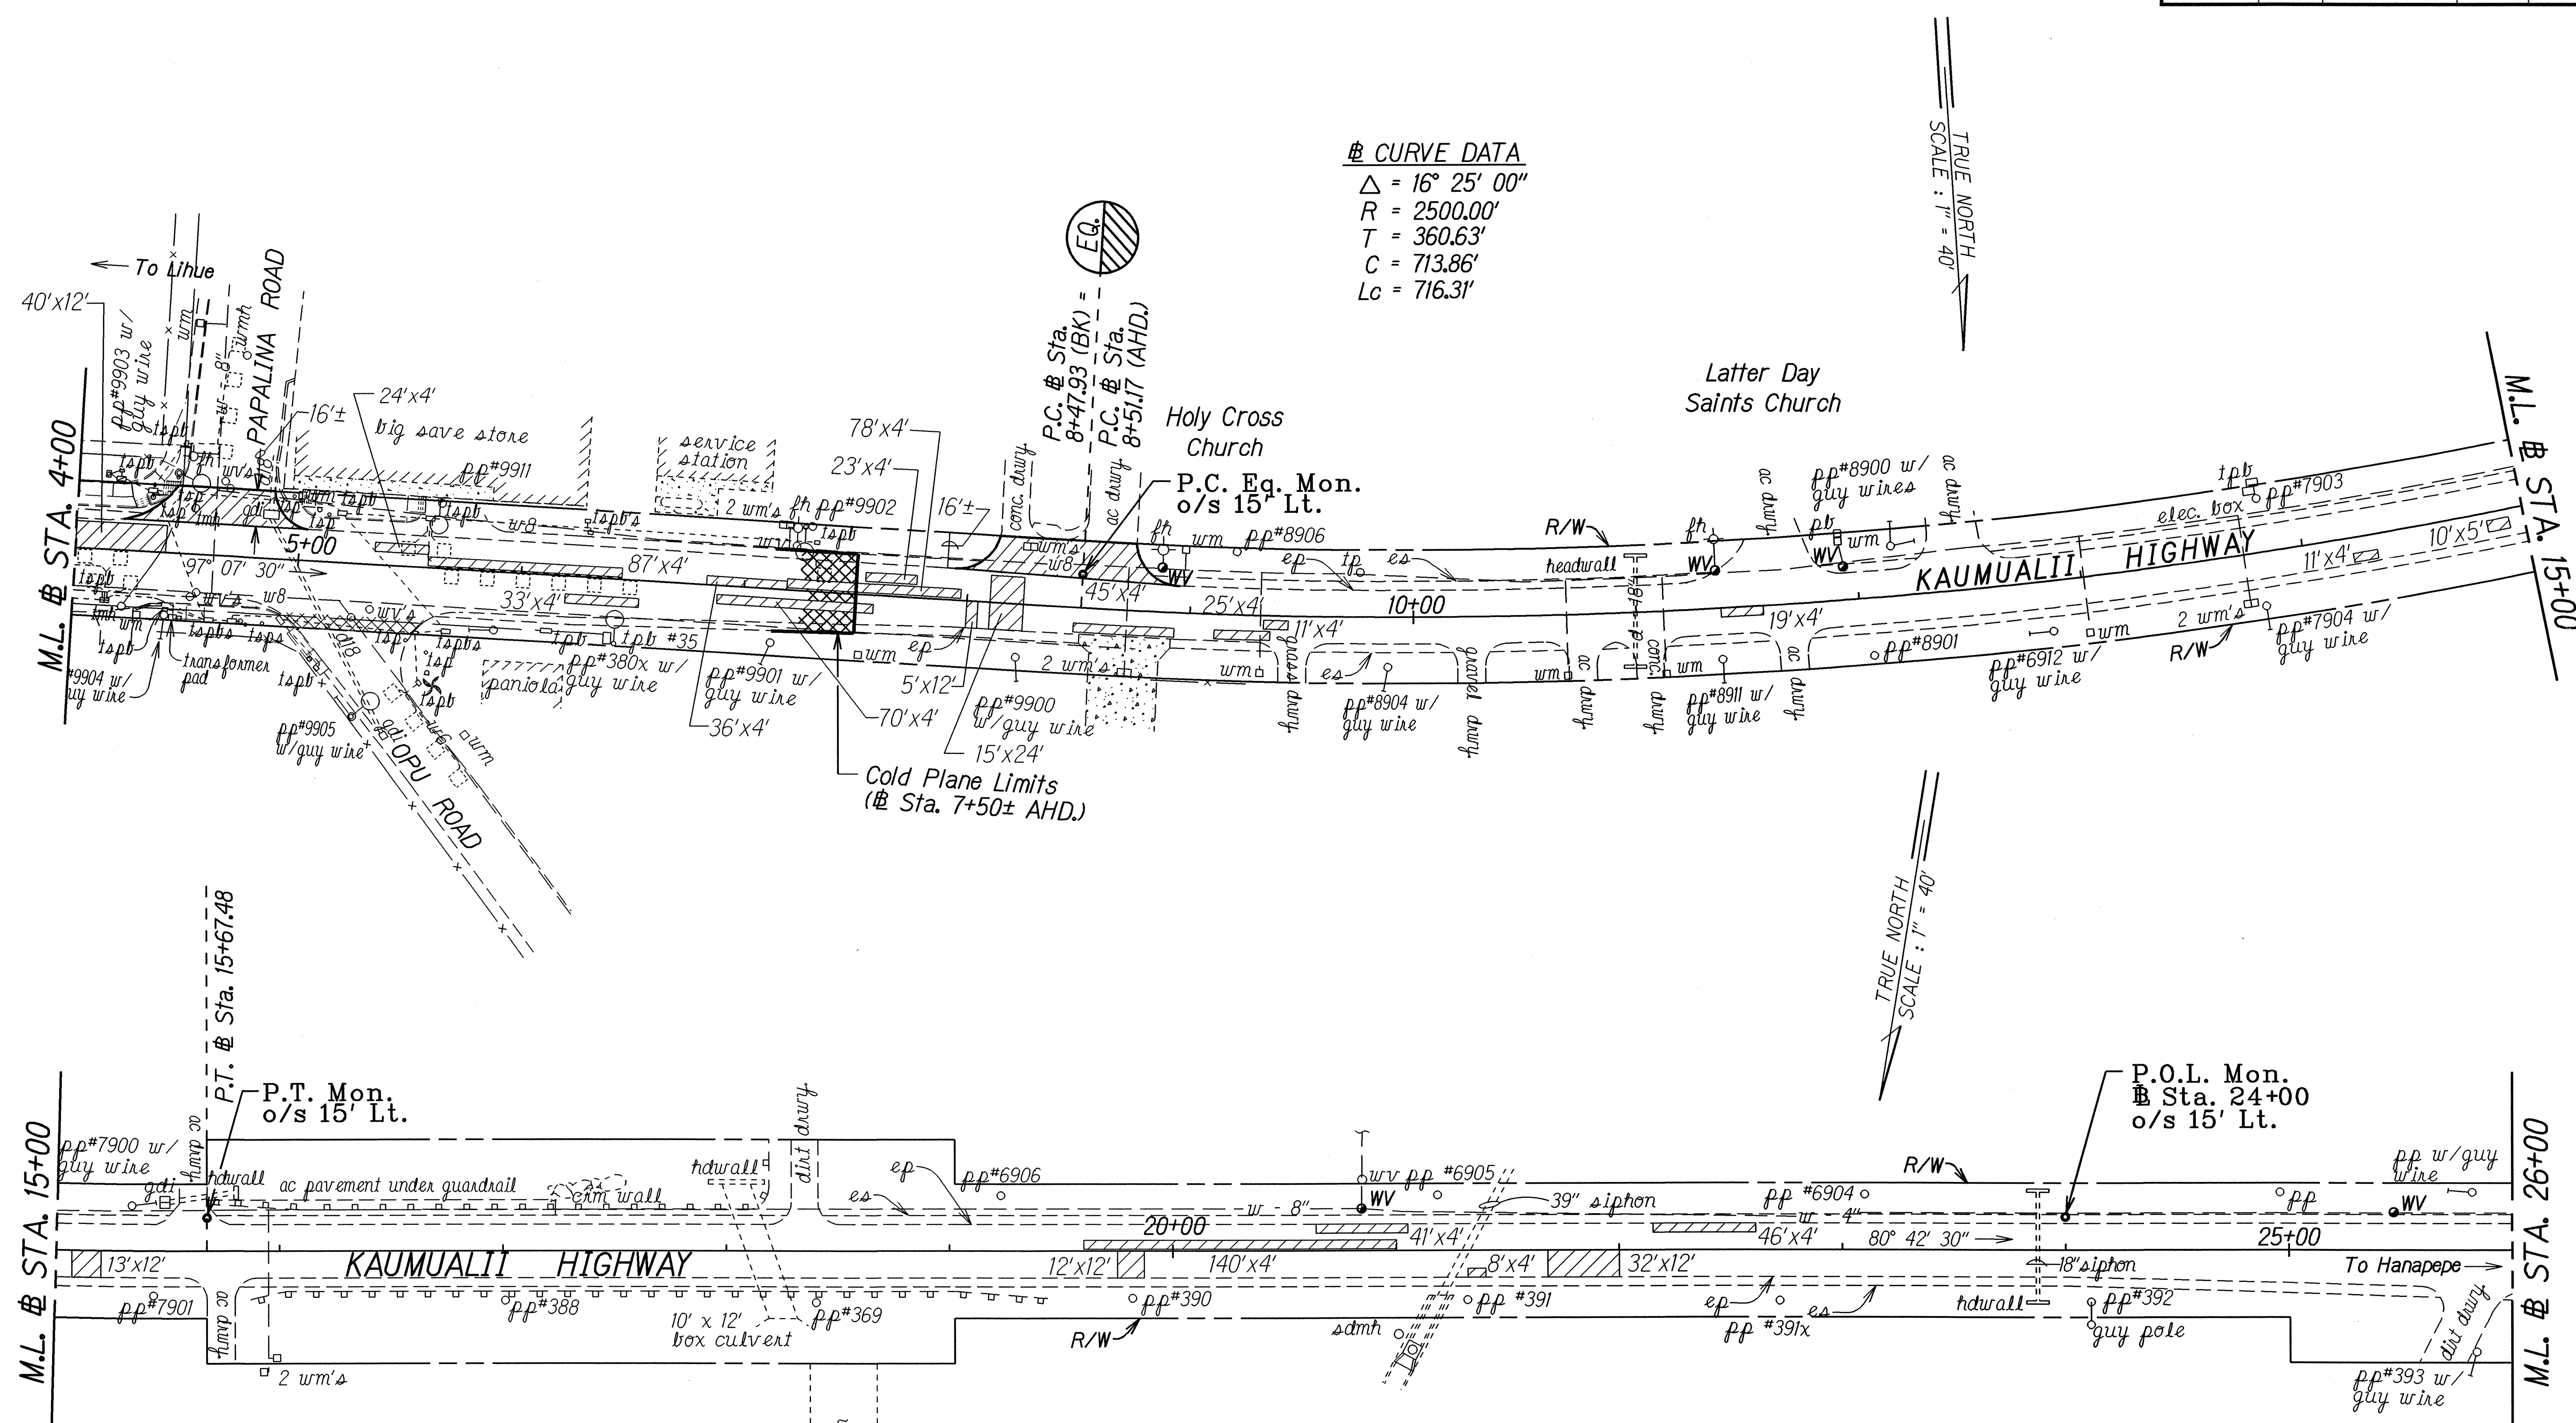

△ CURVE DATA
 $\Delta = 16^\circ 25' 00''$
 $R = 2500.00'$
 $T = 360.63'$
 $C = 713.86'$
 $Lc = 716.31'$

ORIGINAL PLAN	DATE
NOTE BOOK	DESIGNED BY
QUANTITIES BY	CHECKED BY

LEGEND FOR AS-BUILT POSTINGS	
	Squiggly line for as-built deletion
	Double line for as-built deletion
Roadway	Text for as-built posting

STATE OF HAWAII
DEPARTMENT OF TRANSPORTATION
HIGHWAYS DIVISION

ROADWAY PLAN


KAUMUALII HIGHWAY RESURFACING
Lawai Bridge to Halewili Road, Kalaheo
Project No. 50C-01-01M

Scale: 1" = 40' Date: March 2003

SHEET No. 4 OF 5 SHEETS

"AS-BUILT"

FED. ROAD DIST. NO.	STATE	PROJ. NO.	FISCAL YEAR	SHEET NO.	TOTAL SHEETS
HAWAII	HAW.	50C-01-01M	2003	13	32

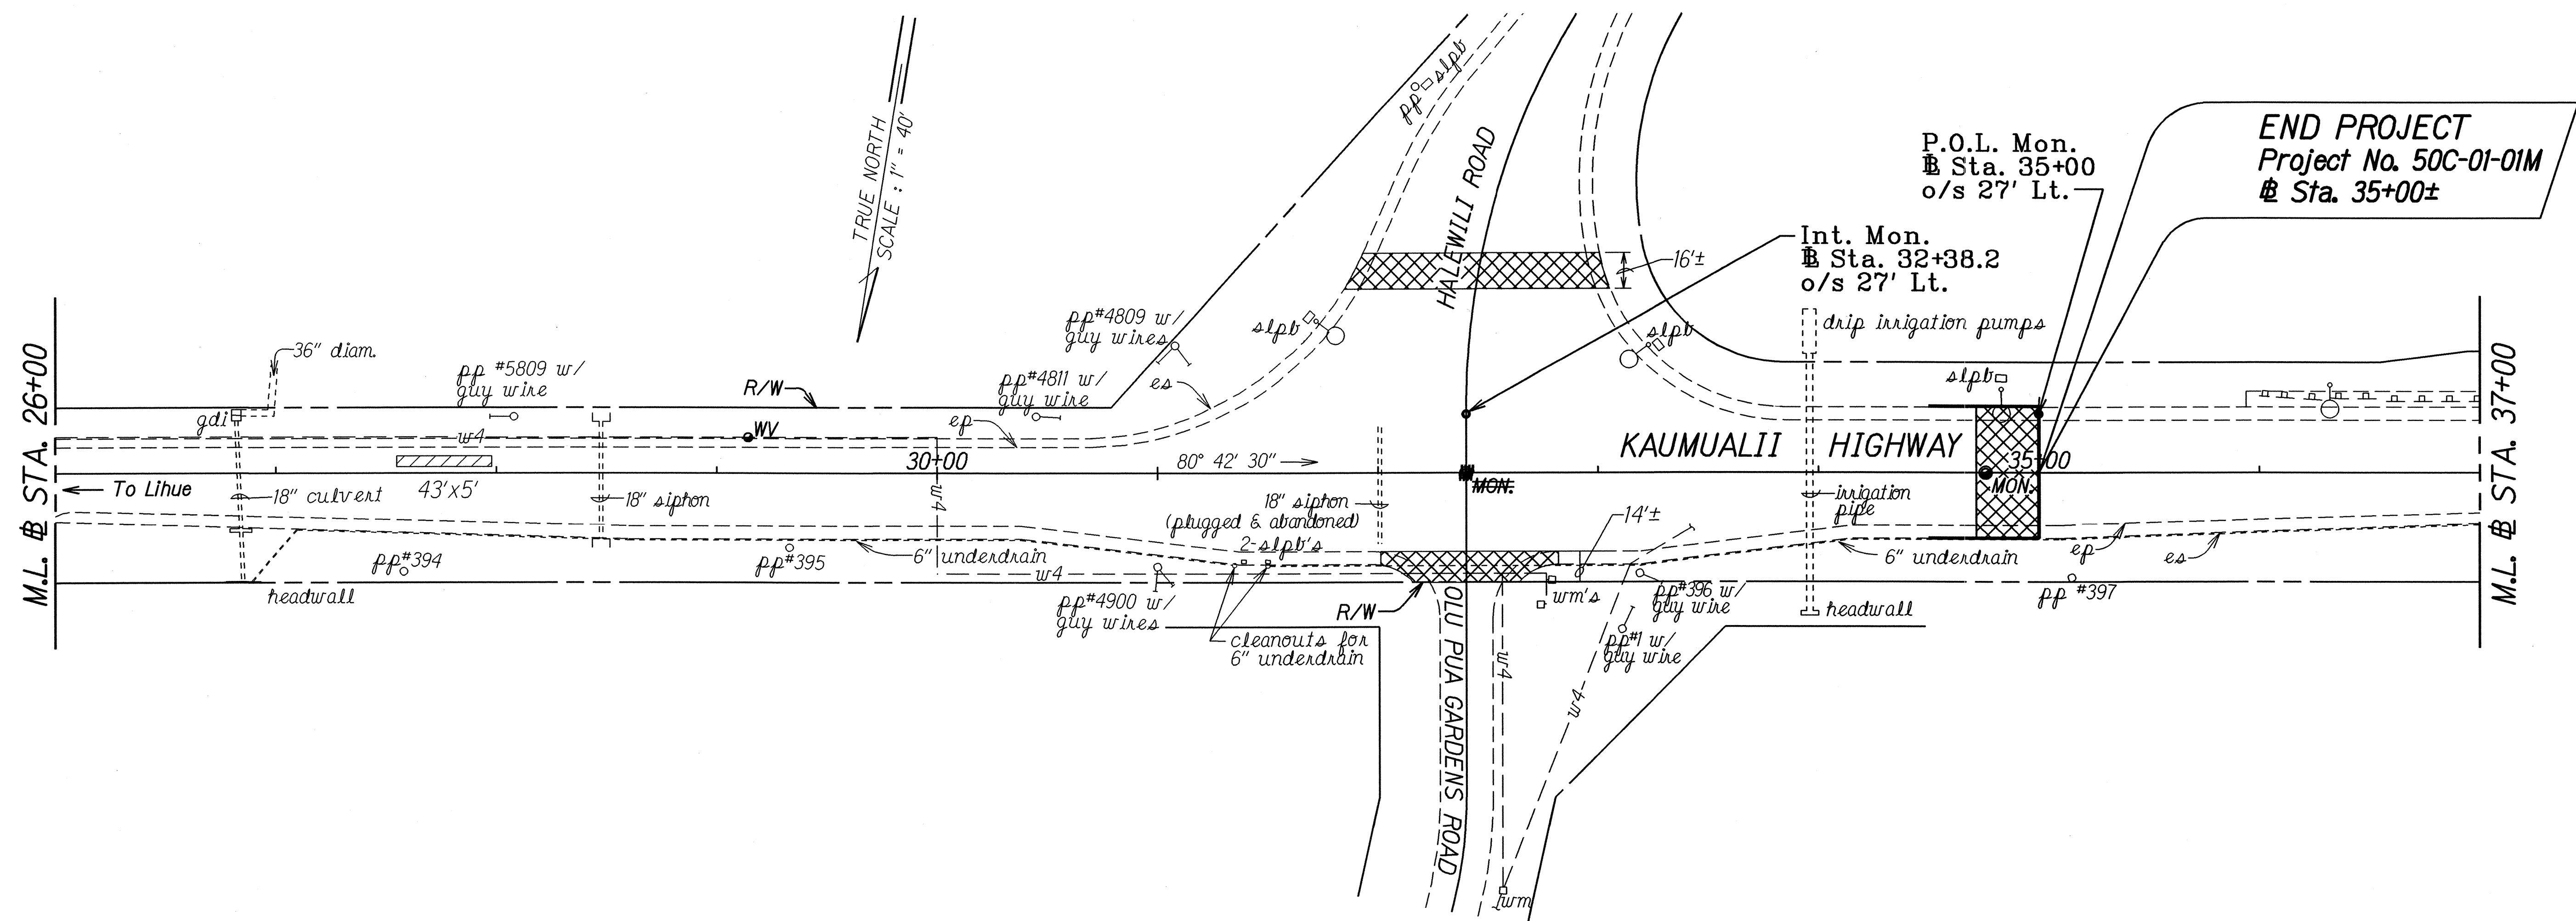

SURVEY PLOTTED BY	DATE
PLAN	11/29/02
NOTE BOOK	
DESIGNED BY	
QUANTITIES BY	
CHECKED BY	

LEGEND FOR AS-BUILT POSTINGS	
	Squiggly line for as-built deletion
	Double line for as-built deletion
Roadway	Text for as-built posting

STATE OF HAWAII
DEPARTMENT OF TRANSPORTATION
HIGHWAYS DIVISION

ROADWAY PLAN

KAUMUALII HIGHWAY RESURFACING
Lawai Bridge to Halewili Road, Kalaheo
Project No. 50C-01-01M

Scale: 1" = 40' Date: March 2003

SHEET No. 5 OF 5 SHEETS

"AS-BUILT"