

INDEX TO DRAWINGS	
SHEET NO.	DESCRIPTION
1	TITLE SHEET
2	STANDARD PLANS SUMMARY
3	GENERAL NOTES & LEGEND
4 - 5	NPDES & EROSION CONTROL NOTES
6 - 8	TYPICAL SECTIONS
9 - 13	ROADWAY PLANS
14 - 22	DRAIN PLAN & DETAILS
23 - 32	PAVEMENT MARKINGS, SIGNING & LOOP DETECTORS

STATE OF HAWAII

DEPARTMENT OF TRANSPORTATION

HIGHWAYS DIVISION

HONOLULU, HAWAII

"AS-BUILT"

PLANS FOR


KAUMUALII HIGHWAY RESURFACING

LAWAI BRIDGE TO HALEWILI ROAD, KALAHEO

PROJECT NO. 50C-01-01M

DISTRICT OF KOLOA


ISLAND OF KAUAI

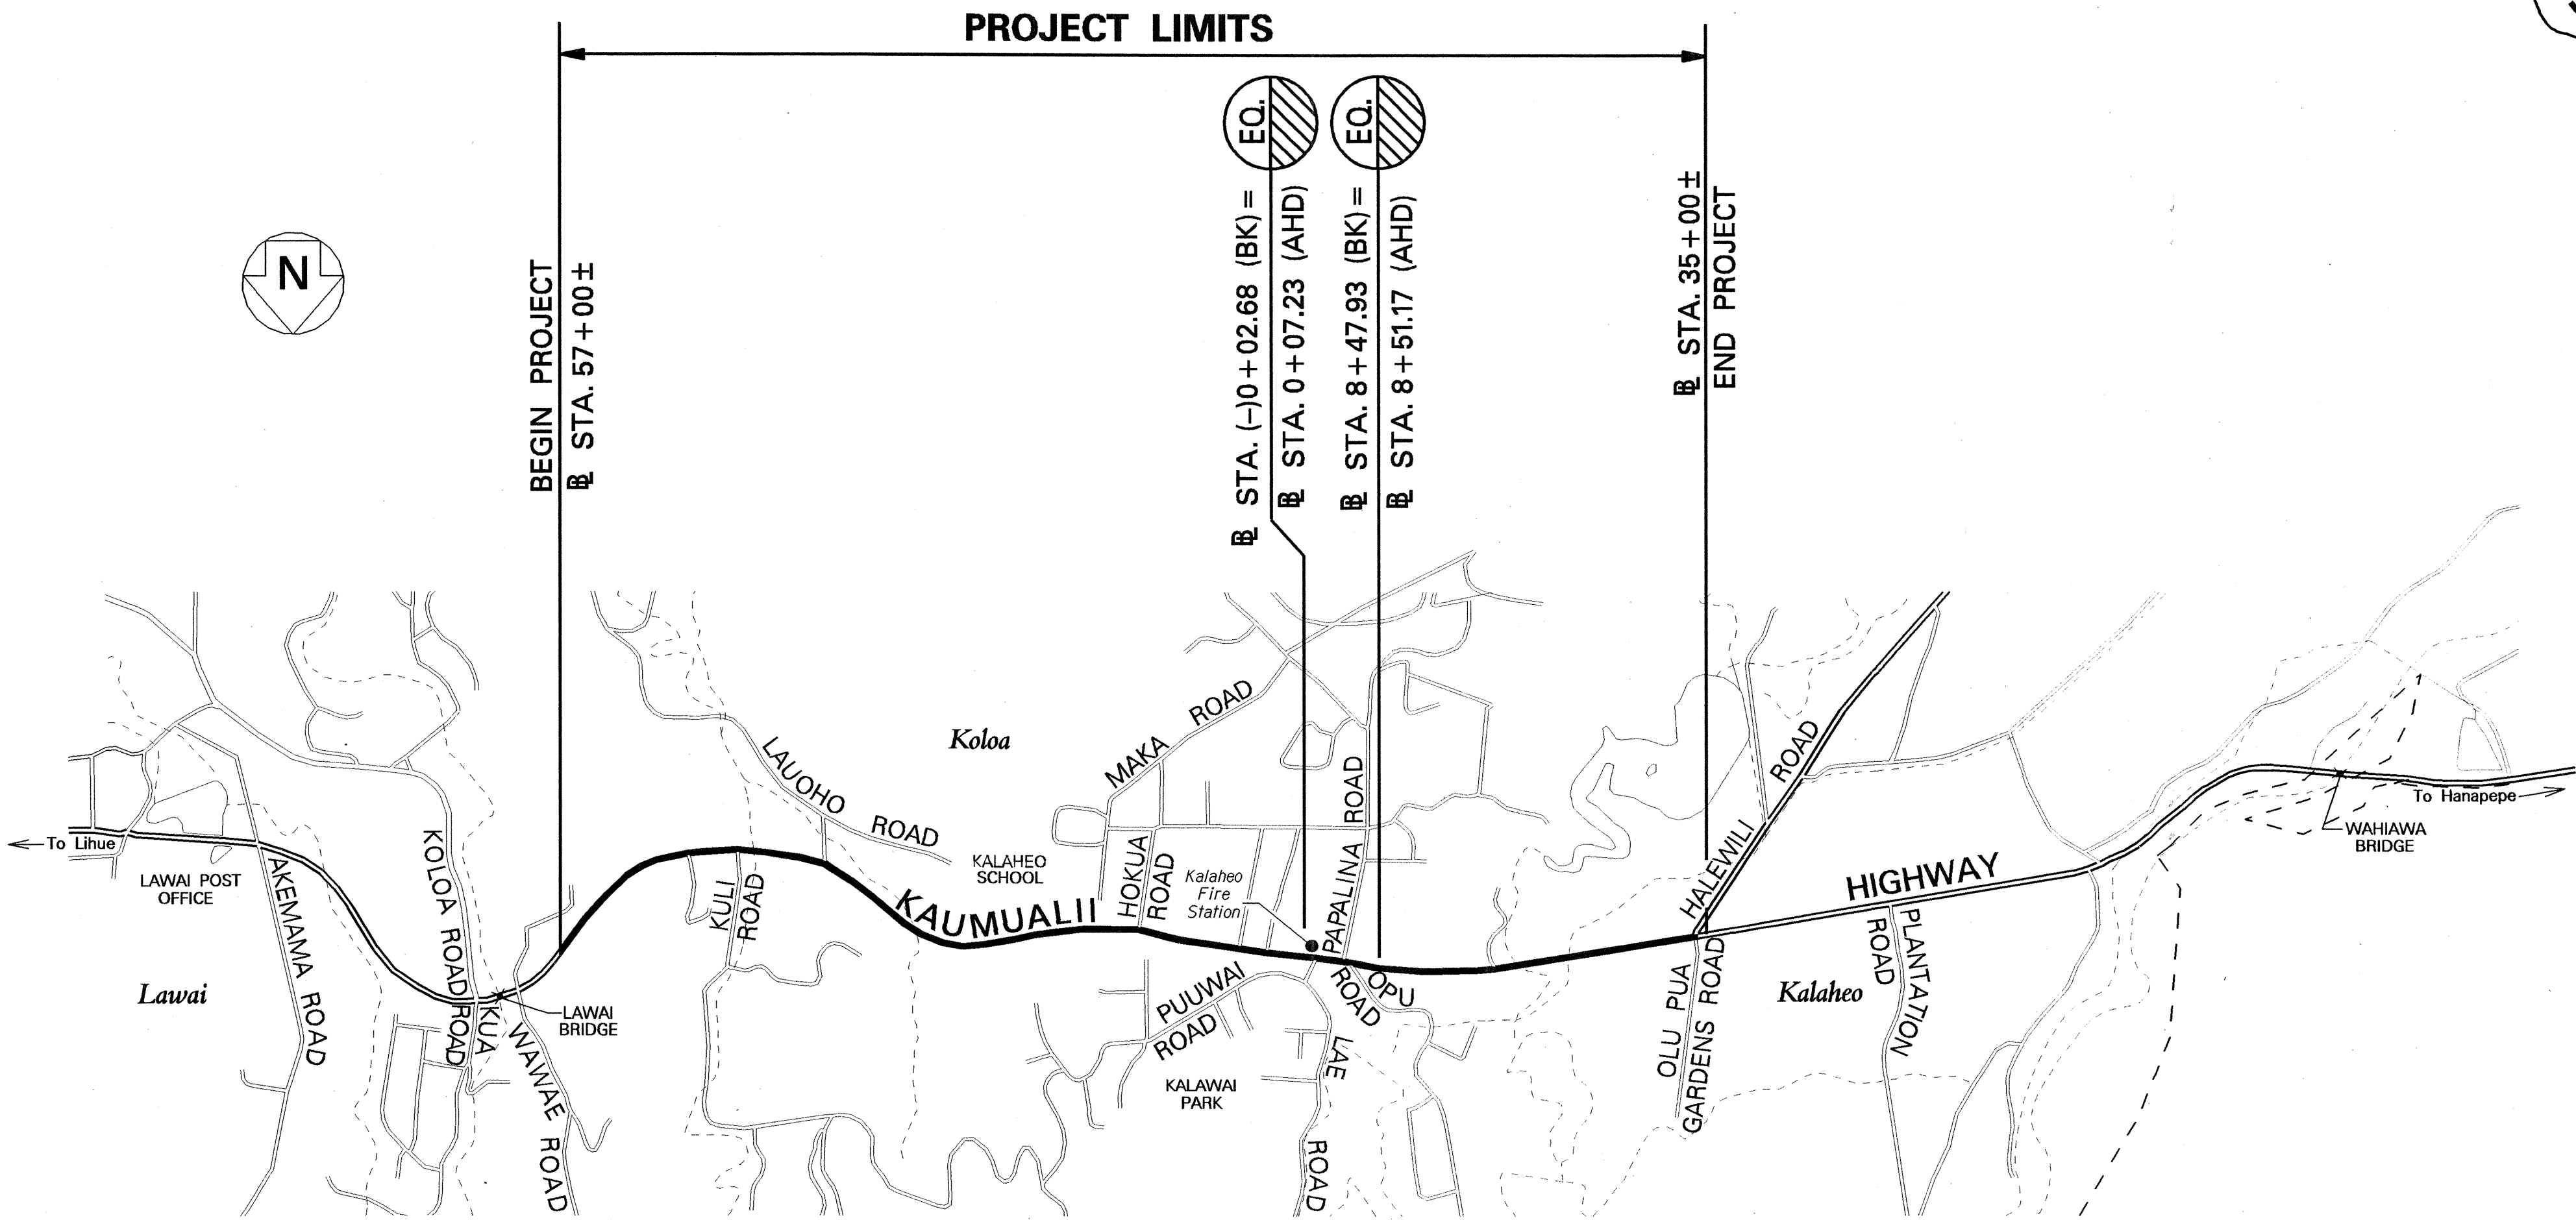



LAYOUT PLAN

GROSS LENGTH OF PROJECT.....1.74 MILES


NET LENGTH OF PROJECT.....1.74 MILES

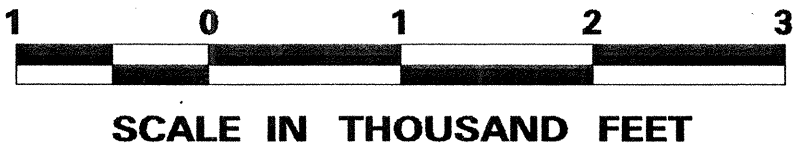

FED. ROAD DIST. NO.	STATE	PROJ. NO.	FISCAL YEAR	SHEET NO.	TOTAL SHEETS
HAWAII	HAW.	50C-01-01M	2003	1	32

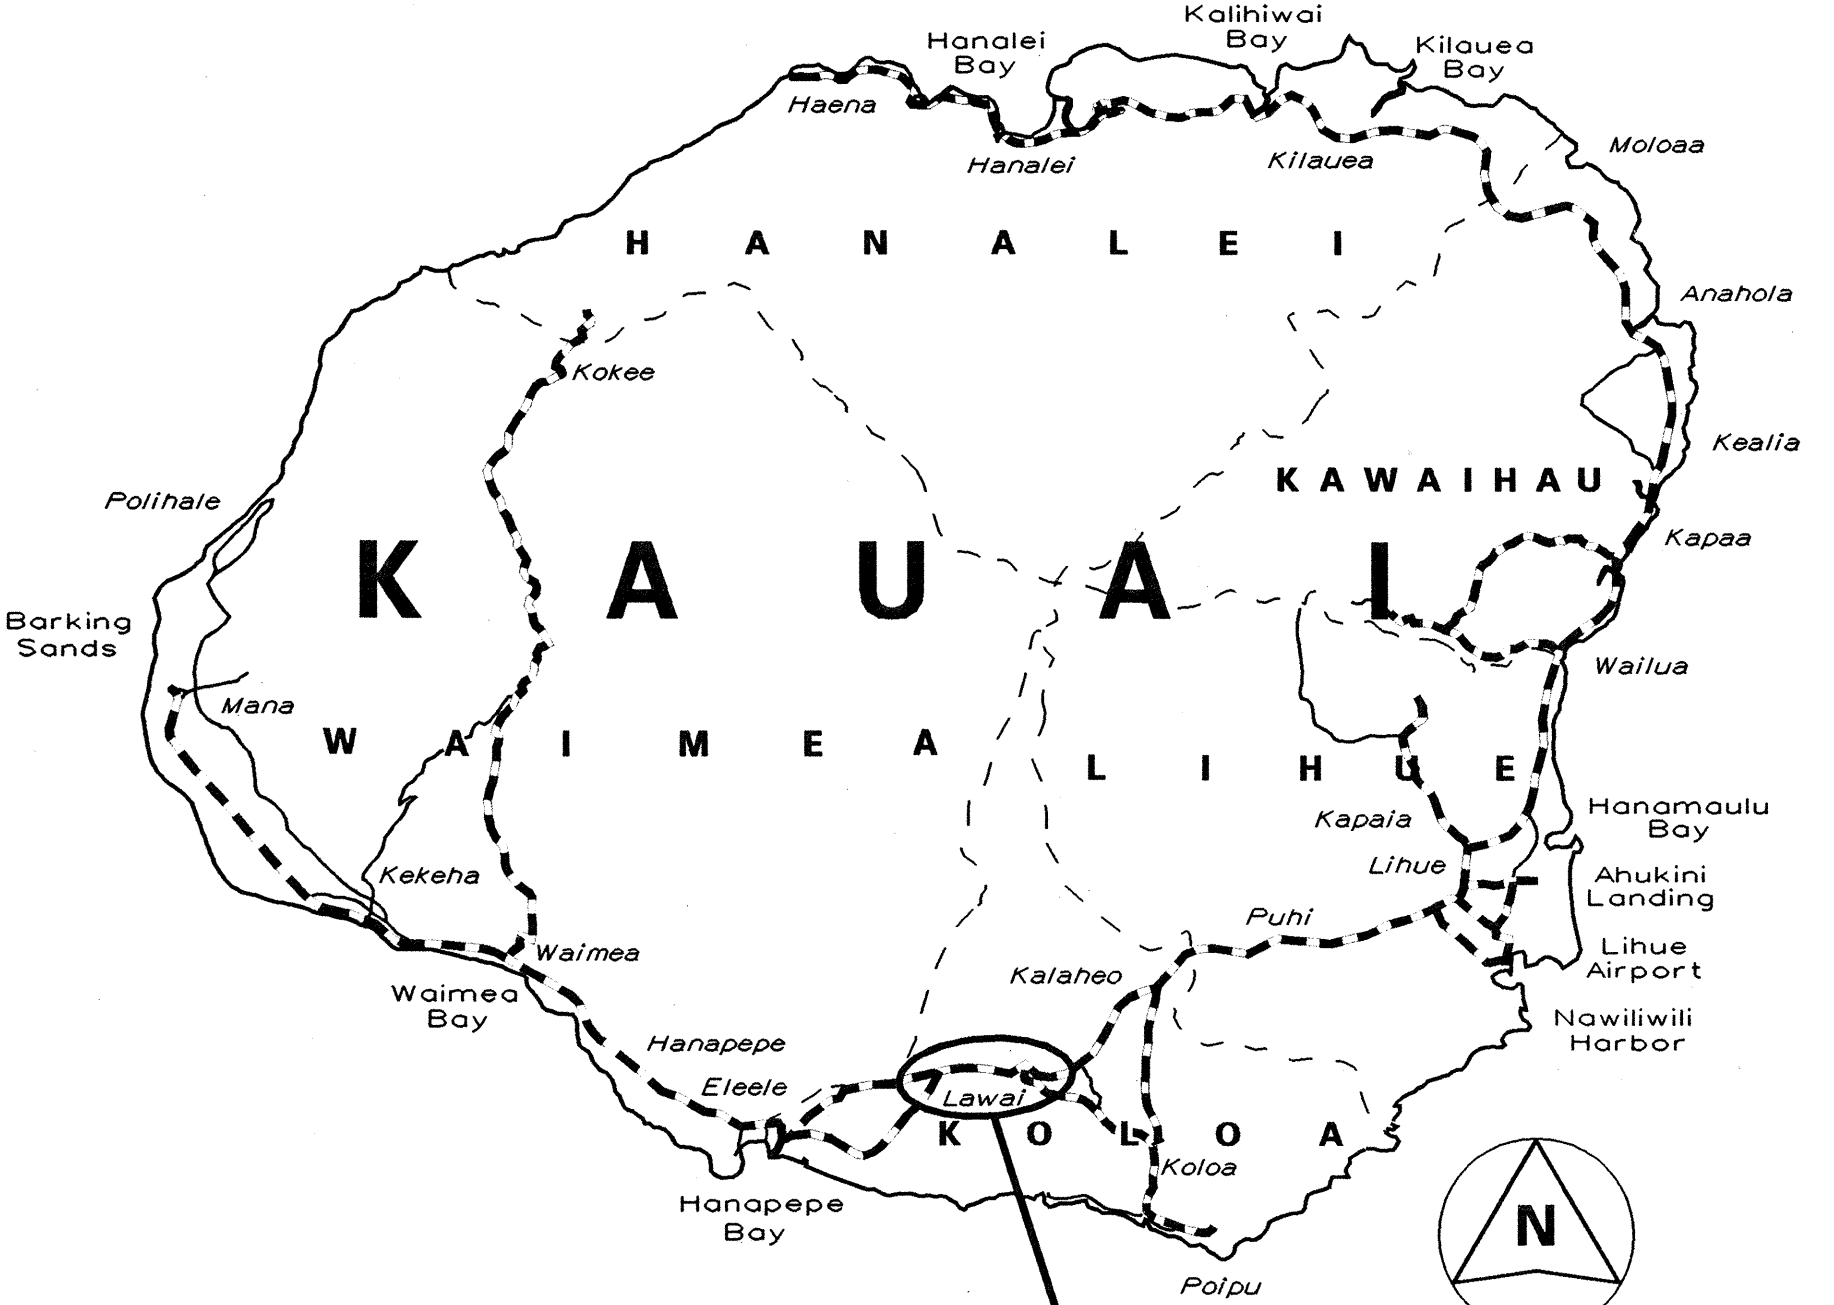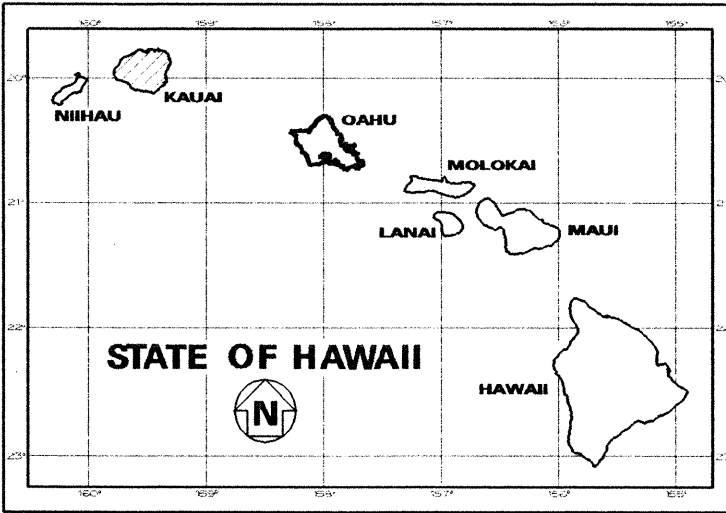

LOCATION OF PROJECT

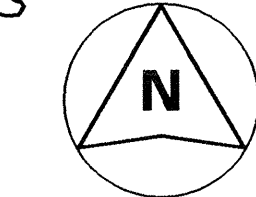

SCALE IN MILES

----- FEDERAL AID PROJECTS PREVIOUSLY CONSTRUCTED OR UNDER CONSTRUCTION

MILE POST 10.56 TO MILE POST 12.30

CHANGES MADE DURING CONSTRUCTION HAVE BEEN INCORPORATED ON THESE PLANS EXCEPT CHANGES IN THE ORIGINAL THEORETICAL QUANTITIES. FOR ACTUAL QUANTITIES, REFER TO PROJECT LEDGER AND/OR COMPUTATION BOOK.

[Signature] 12-15-03

RESIDENT ENGINEER DATE

DEPARTMENT OF TRANSPORTATION STATE OF HAWAII	
APPROVED:	
<i>[Signature]</i> for DIR. OF TRANSPORTATION	4-25-03 DATE

HWY-DD UNIT "C"

DESIGNED BY

R. HIRONAKA

P. S. & E. BY

692-7575

PHONE

APRIL 2003

DATE