

INDEX TO DRAWINGS	
SHEET NO.	DESCRIPTION
1	TITLE SHEET
2	STANDARD PLANS SUMMARY
3	GENERAL NOTES AND LEGENDS
4 - 5	WATER POLLUTION AND EROSION CONTROL NOTES
6 - 10	TYPICAL SECTIONS AND DETAILS
11	GUARDRAIL DETAILS AND NOTES
12	STRONG POST W-BEAM GUARDRAIL
13	FLEAT-350
14 - 20	ROADWAY PLAN
21	PAVEMENT MARKING LEGEND, DETAILS AND NOTES
22 - 28	PAVEMENT MARKING AND TRAFFIC SIGNING PLAN
29	SIGN DETAILS
30	PAVEMENT MARKING SUMMARY
31	TRAFFIC SUMMARIES

STATE OF HAWAII

DEPARTMENT OF TRANSPORTATION

HIGHWAYS DIVISION

HONOLULU, HAWAII

"AS-BUILT"

PLANS FOR


KAUMUALII HIGHWAY RESURFACING

VICINITY OF MANA

PROJECT NO. 50A-01-02M

DISTRICT OF WAIMEA



ISLAND OF KAUAI

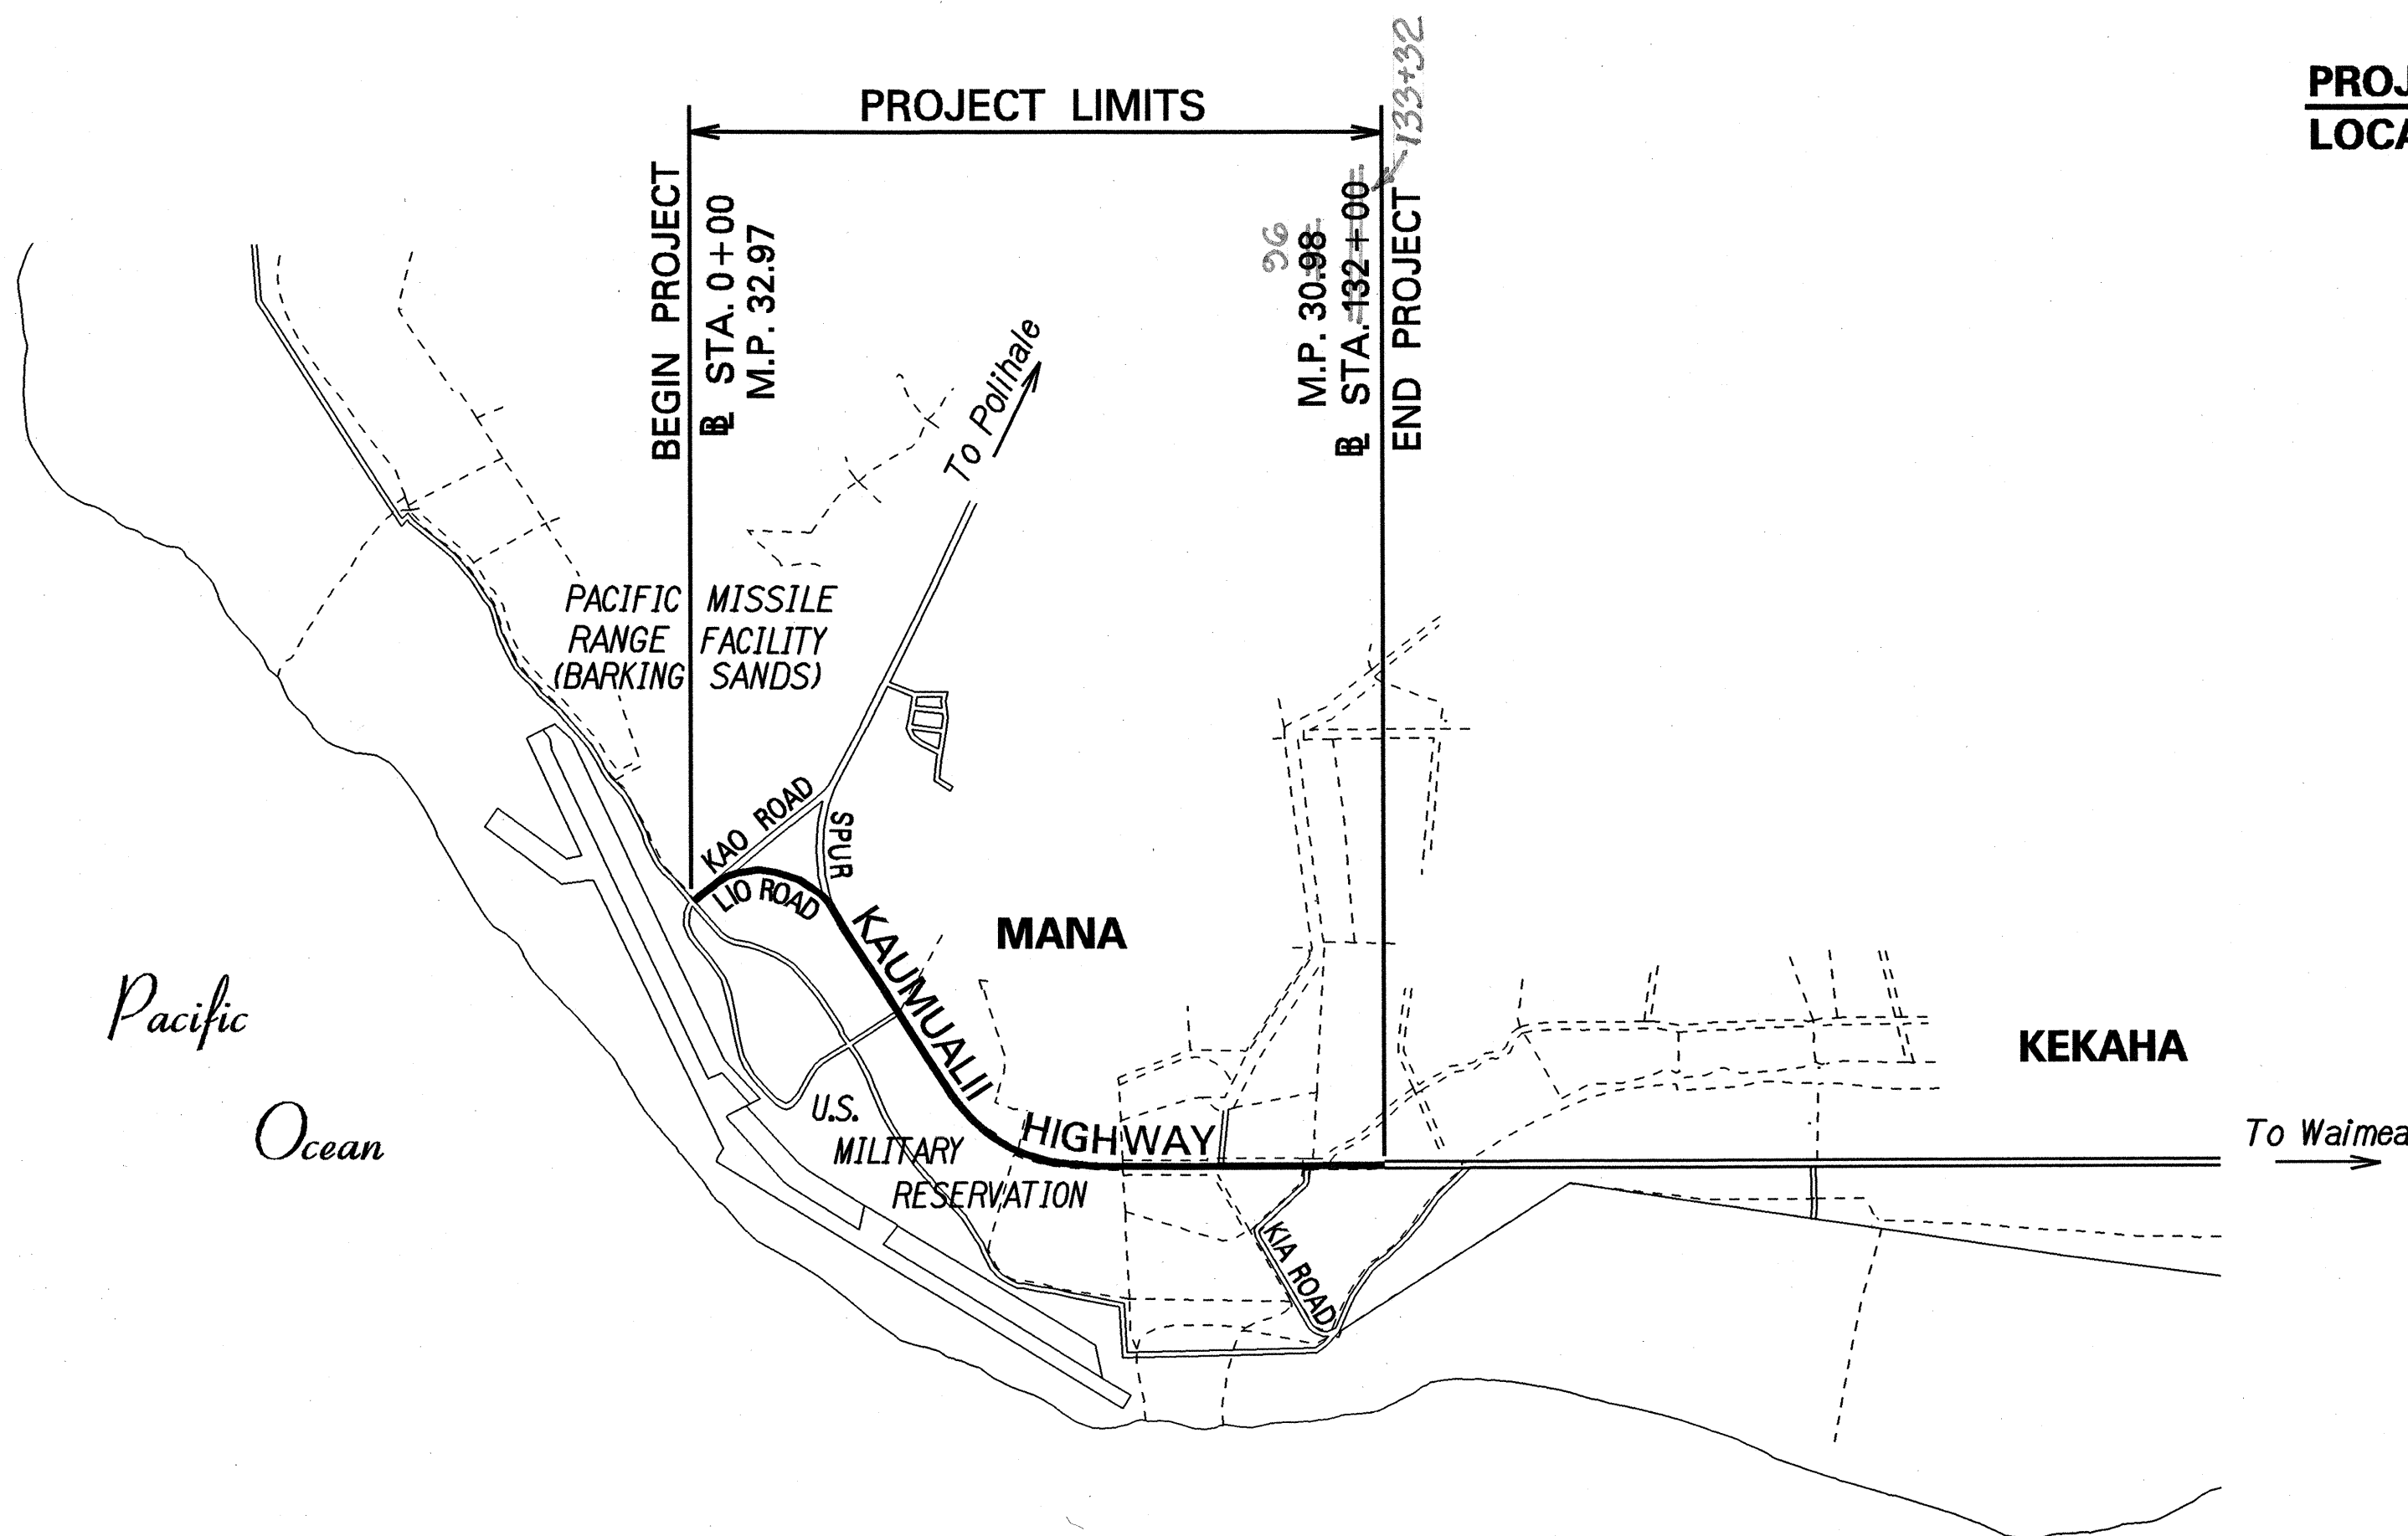

LAYOUT PLAN


GROSS LENGTH OF PROJECT.....1.99 MILES
NET LENGTH OF PROJECT.....1.99 MILES

FED. ROAD DIST. NO.	STATE	PROJ. NO.	FISCAL YEAR	SHEET NO.	TOTAL SHEETS
HAWAII	HAW.	50A-01-02M	2004	1	31

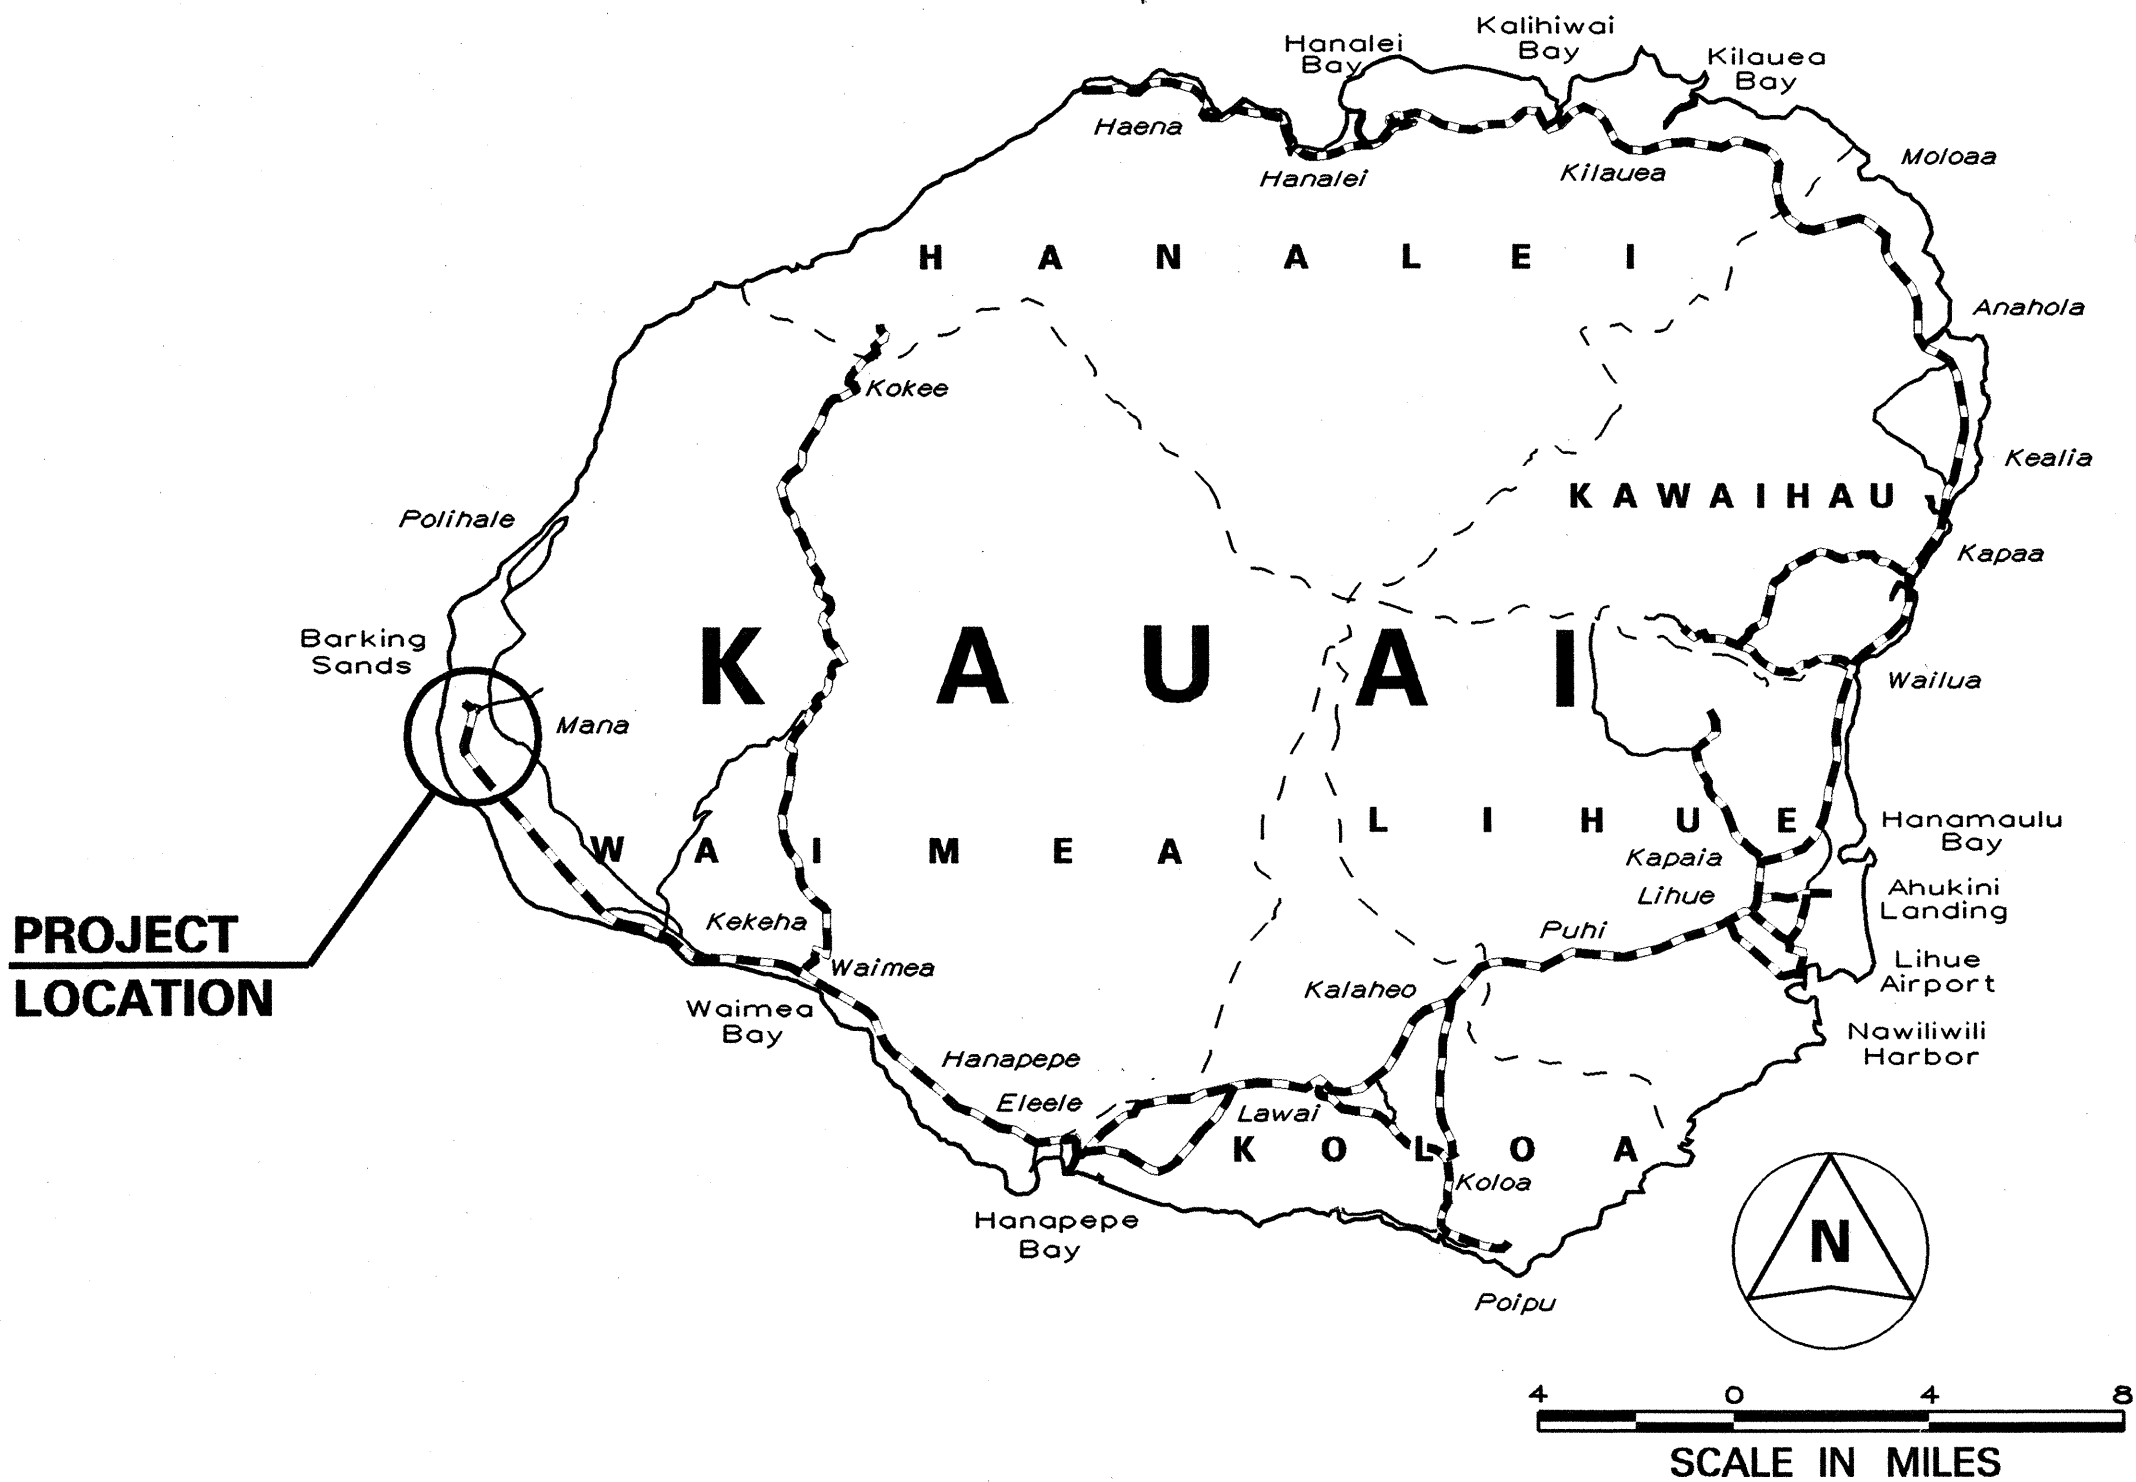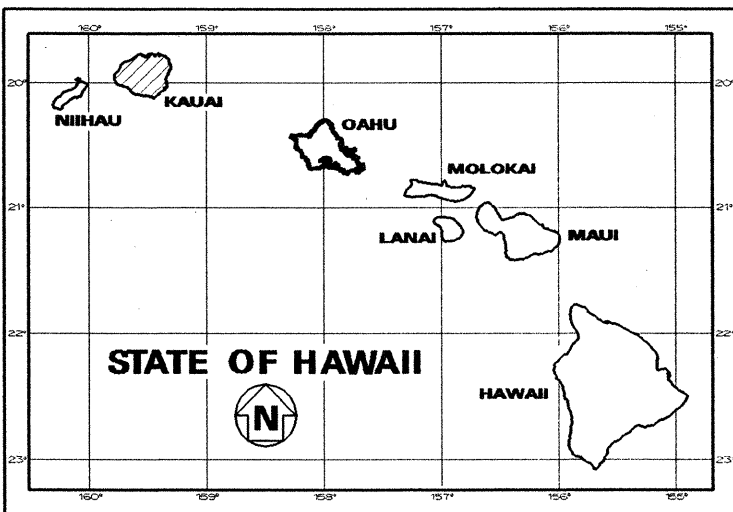

FEDERAL AID PROJECTS PREVIOUSLY CONSTRUCTED OR UNDER CONSTRUCTION

MILE POST 32.97 TO MILE POST 30.98

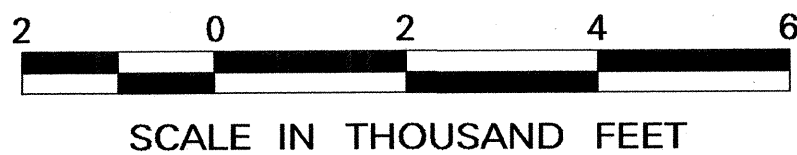

CHANGES MADE DURING CONSTRUCTION HAVE BEEN INCORPORATED ON THESE PLANS EXCEPT CHANGES IN THE ORIGINAL THEORETICAL QUANTITIES. FOR ACTUAL QUANTITIES, REFER TO PROJECT LEDGER AND/OR COMPUTATION BOOK.

7/7/06

DATE

DEPARTMENT OF TRANSPORTATION STATE OF HAWAII	
APPROVED:	
<i>[Signature]</i>	9.12.03
for DIR. OF TRANSPORTATION	DATE

SEPT. 2003

DATE

274-3118

PHONE

HWY-KE

MANAGED BY

HWY-K

DESIGNED BY