












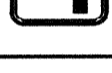




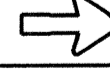
FED. ROAD DIST. NO.	STATE	PROJ. NO.	FISCAL YEAR	SHEET NO.	TOTAL SHEETS
HAWAII	HAW.	50DE-01-05M	2005	25	39

PAVEMENT MARKING SUMMARY	
DESCRIPTION	QUANTITY
PAVEMENT MARKERS	
TYPE A _____	— EA.
TYPE C _____	— EA.
TYPE D _____	— EA.
TYPE H _____	— EA.
TYPE J _____	— EA.
* TAPE - TYPE I OR THERMOPLASTIC EXTRUSION	
4-INCH PAVEMENT STRIPE (WHITE) _____	— LF.
4-INCH PAVEMENT STRIPE (YELLOW) _____	— LF.
8-INCH PAVEMENT STRIPE (WHITE) _____	— LF.
12-INCH PAVEMENT STRIPE (WHITE) _____	— LF.
12-INCH PAVEMENT STRIPE (YELLOW) _____	— LF.
DOUBLE 4-INCH PAVEMENT STRIPE (YELLOW) _____	— LF.
PARKING STALLS _____	— LF.
** TAPE - TYPE II OR THERMOPLASTIC EXTRUSION	
4-INCH PAVEMENT STRIPE (WHITE) _____	— LF.
4-INCH PAVEMENT STRIPE (YELLOW) _____	— LF.
8-INCH PAVEMENT STRIPE (WHITE) _____	— LF.
12-INCH PAVEMENT STRIPE (WHITE) _____	— LF.
12-INCH PAVEMENT STRIPE (YELLOW) _____	— LF.
DOUBLE 4-INCH PAVEMENT STRIPE (YELLOW) _____	— LF.
*** TAPE - TYPE III OR THERMOPLASTIC EXTRUSION	
4-INCH PAVEMENT STRIPE (WHITE) _____	— LF.
4-INCH PAVEMENT STRIPE (YELLOW) _____	— LF.
8-INCH PAVEMENT STRIPE (WHITE) _____	— LF.
12-INCH PAVEMENT STRIPE (WHITE) _____	— LF.
CROSSWALK MARKINGS _____	14 LANE
PAVEMENT ARROW _____	95 EA.
PAVEMENT SYMBOL (SHARK'S TEETH) _____	4 EA.

Notes:

- \* Tape, Type I or Thermoplastic Extrusion ( No passing zones, channelizing lines, solid lines or pavement arrows)
- \*\* Tape, Type II or Thermoplastic Extrusion (Transverse median markings, transverse shoulder markings, channelizing islands, or edge striping
- \*\*\* Tape, Type III, or Thermoplastic Extrusion (Guide lines, stop lines, extension of edge lines, or crosswalk markings)

ROUTE MARKER SUMMARY					
SIGN ASSEMBLY	SIGN NO. AND MESSAGE	TYPE A ASSEMBLY		TYPE B ASSEMBLY	
		W/POST	W/O POST	W/POST	W/O POST
RMA-1	M2-1  M1-6(58)	2	—	—	—
RMA-2	M3-3  M1-6(50)	1	—	—	—
RMA-3	M3-1  M1-6(50)	1	—	—	—
RMA-4	M1-6(50)   M1-6(58) M6-3   M5-1(R)	—	—	1	—
RMA-5	M1-6(50)   M1-6(58) M6-1(L)   M5-1(R)	—	—	1	—
RMA-6	M1-6(58)   M1-6(50) M5-1(L)   M6-3	—	—	1	—
TOTAL		4	0	3	0

DIRECTIONAL SIGN SUMMARY				
SIGN NO.	MESSAGE	SIZE	NEW PANEL AREA (SQ. FT.)	
			W/O POSTS	W/POSTS
DI-1	KAUAI COMMUNITY COLLEGE 	4.0' X 3.3'	—	13.33
D6-2A	SCENIC VIEW 500 FEET	3.3' X 2.5'	—	8.33
D6-3A	SCENIC VIEW 	3.0' X 2.5'	—	7.50
TOTAL				30.00±

STATE OF HAWAII  
DEPARTMENT OF TRANSPORTATION  
HIGHWAYS DIVISION  
**PAVEMENT MARKING  
AND TRAFFIC SUMMARIES**  
KAUMUALII HIGHWAY RESURFACING  
Lihue Mill Bridge to Puhi Road  
Project No. 50DE-01-05M  
Date: January 2005  
SHEET No. 1 OF 1 SHEETS

DATE 1/26

SURVEY PLOTTED BY

DRAWN BY

TRACED BY

NOTED BY

CHECKED BY

ORIGINAL PLAN

NOTE BOOK

REVISIONS

BY

DATE

BY

DATE