
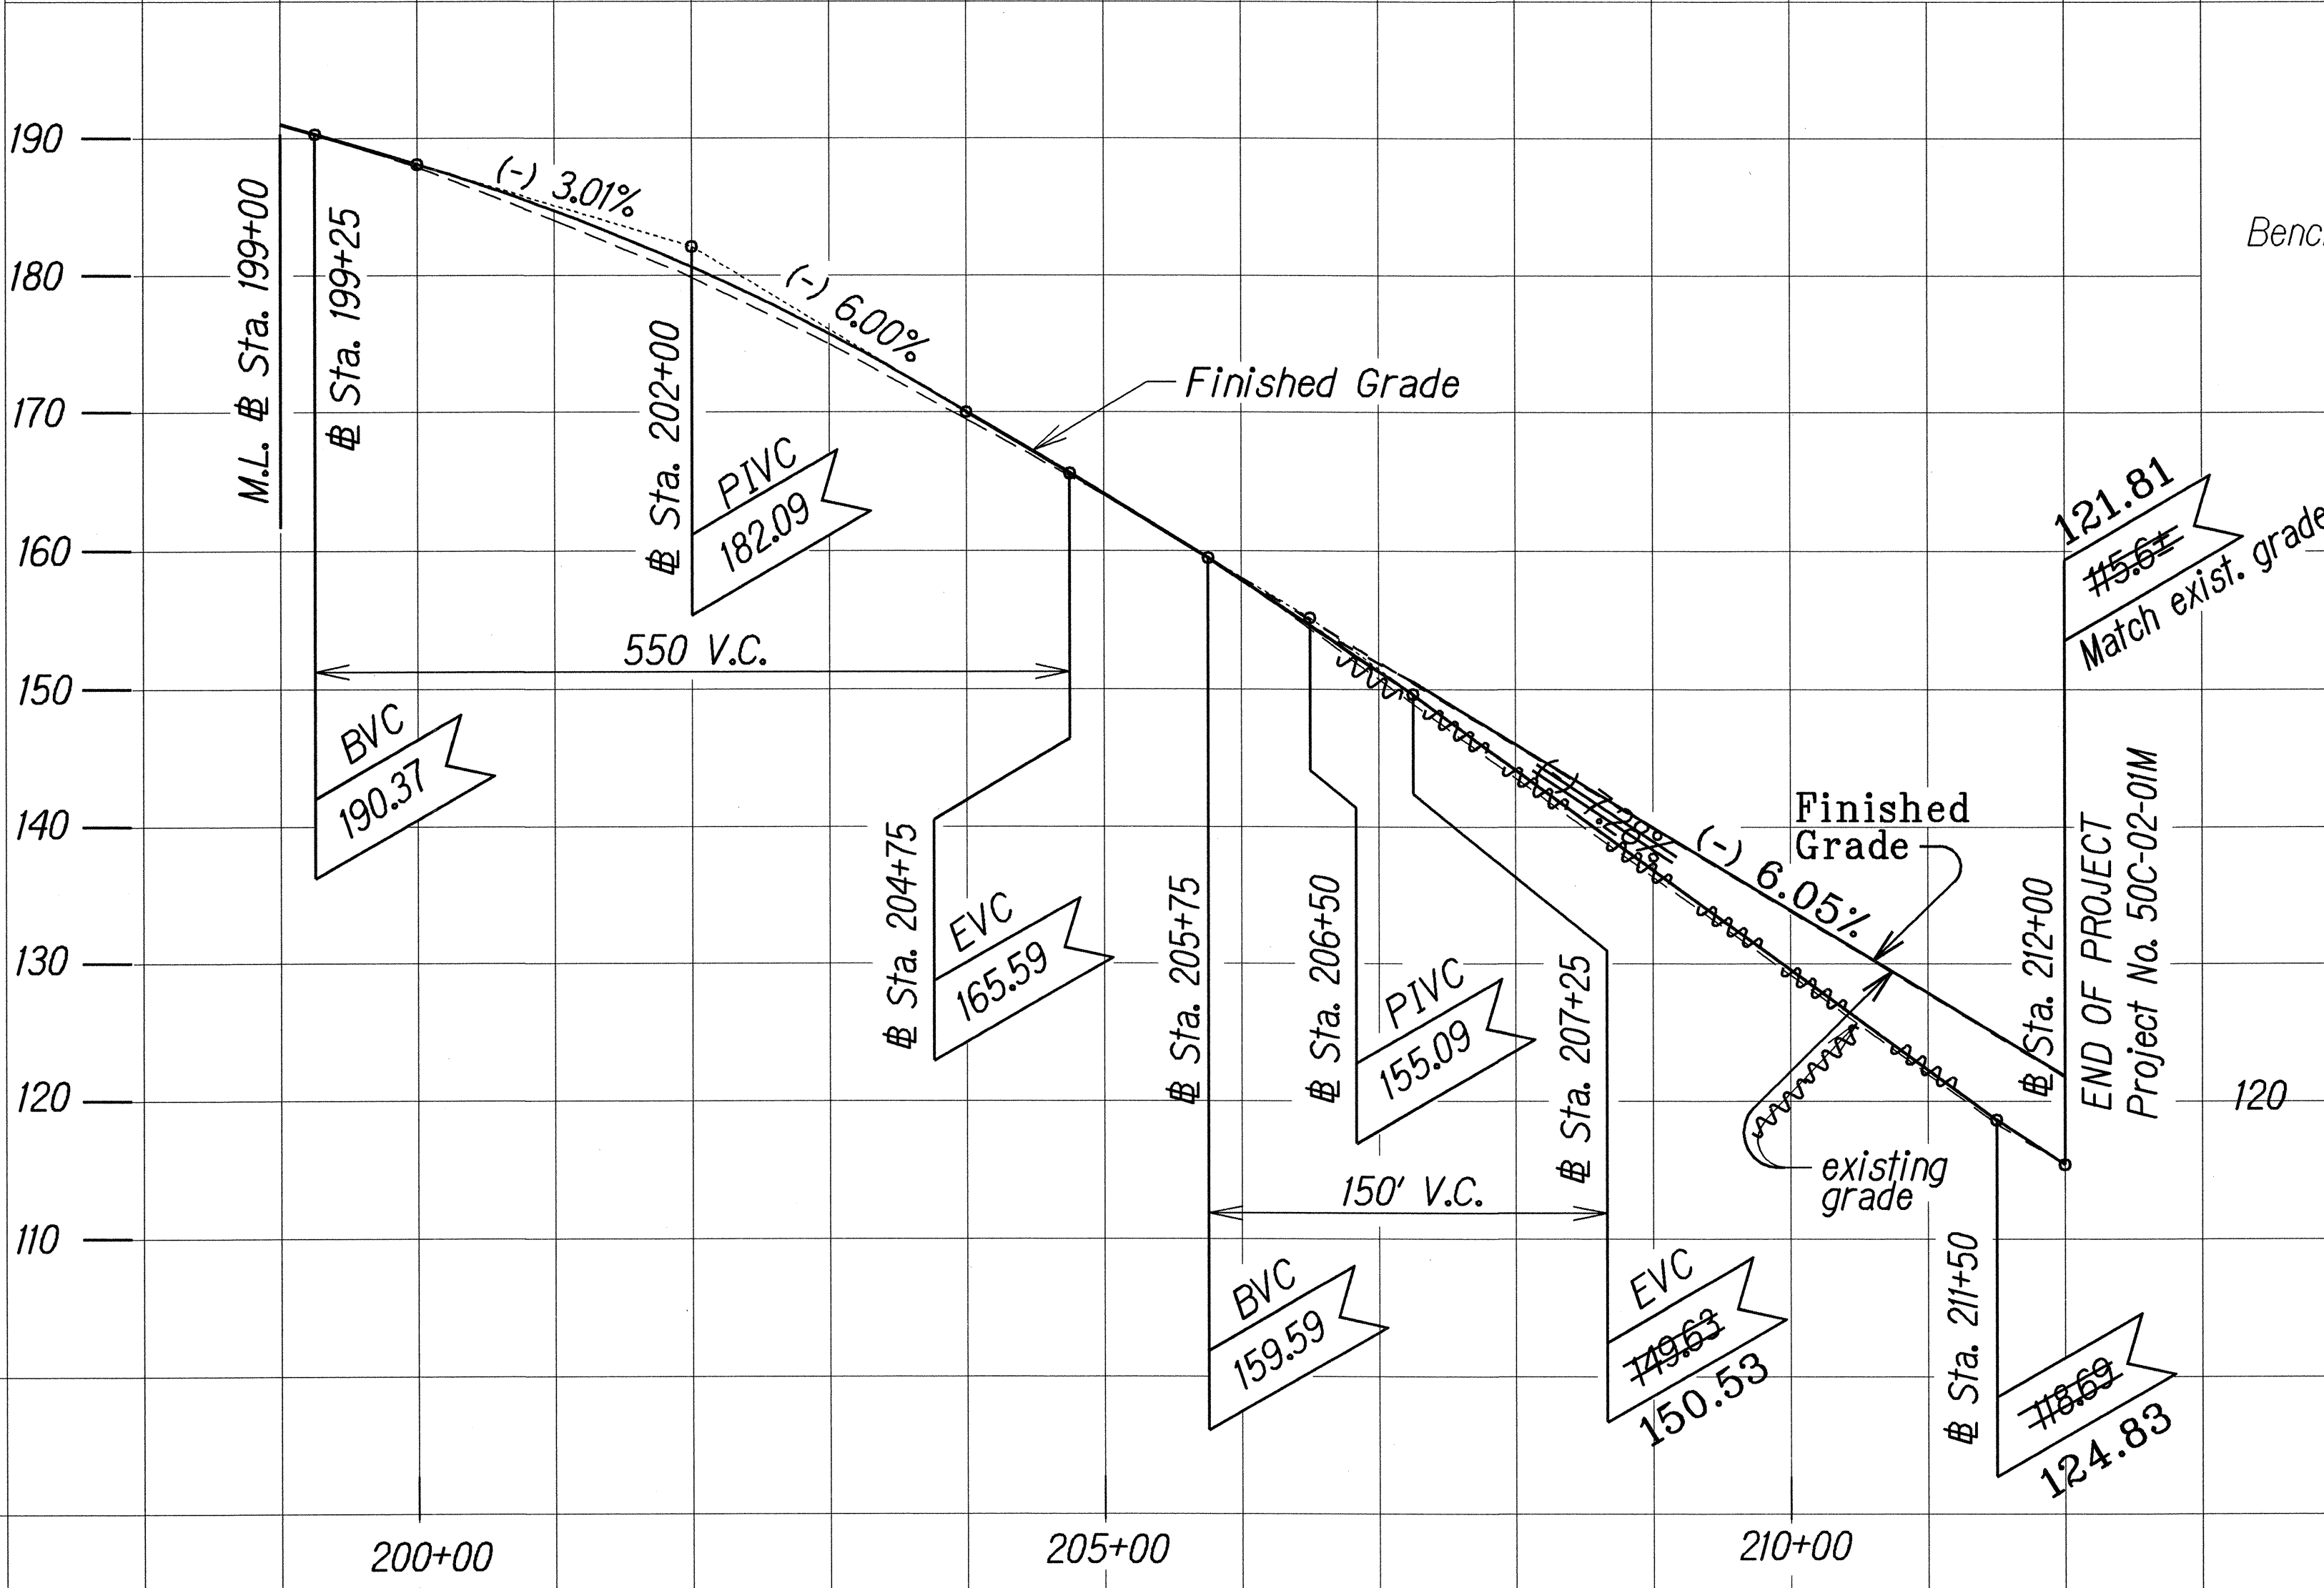


FED. ROAD DIST. NO.	STATE	PROJ. NO.	FISCAL YEAR	SHEET NO.	TOTAL SHEETS
HAWAII	HAW.	50C-02-01M	2003	11	18

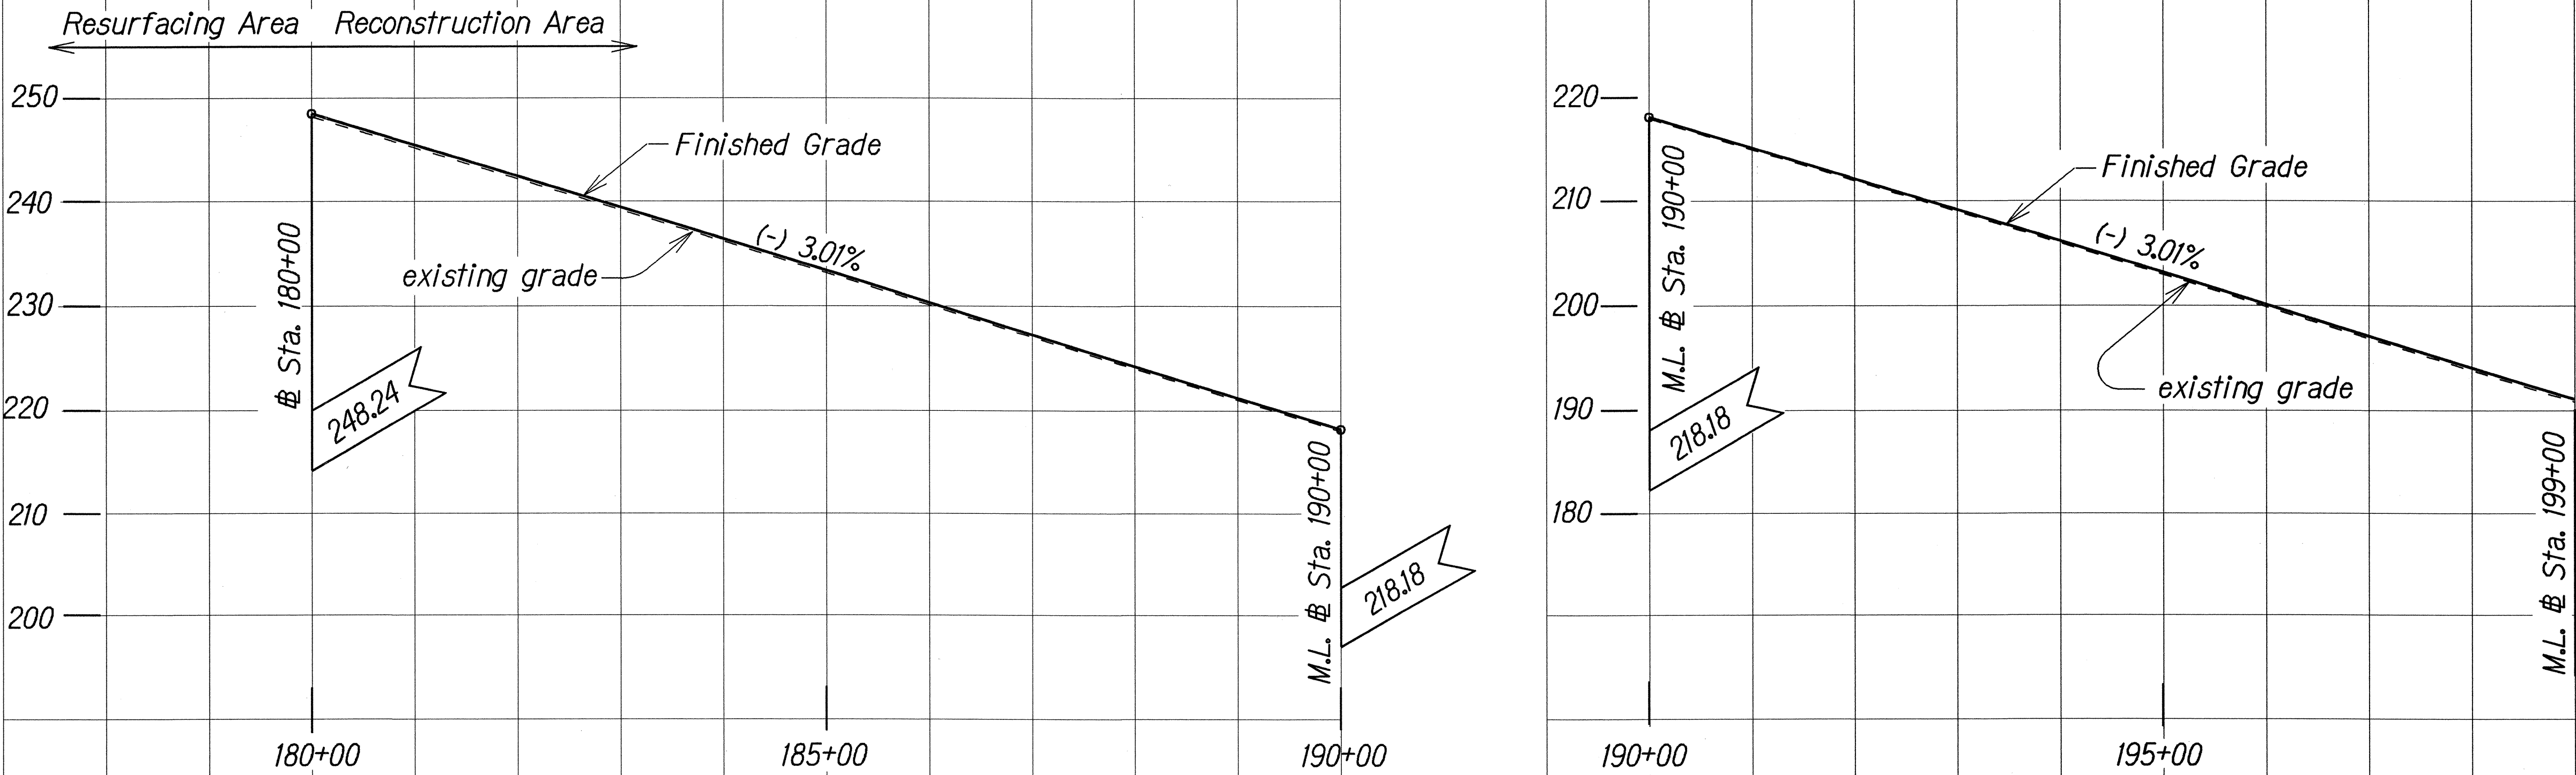

Transition from Sta. 211+50 to Sta. 212+00. See Plan Sheet No. 7 for Transition at End of Project Detail.

Benchmark: " " cut on the southwest corner of the existing concrete headwall at the downstream end of pipe culvert at the Kaumualii Highway-Halewili Road intersection Elev. = 111.10.

ROADWAY PROFILE
Scale: Horiz.: 1"=100'
Vert.: 1"=10'

LEGEND FOR AS-BUILT POSTINGS	
	Squiggly line for as-built deletion
	Double line for as-built deletion
Roadway	Text for as-built posting

STATE OF HAWAII
DEPARTMENT OF TRANSPORTATION
HIGHWAYS DIVISION

ROADWAY PROFILE
KAUMUALII HIGHWAY RESURFACING
Vicinity of Laulea Street to Halewili Road
Project No. 50C-02-01M
Scale: As Shown Date: April, 2003
SHEET No. 1 OF 1 SHEETS

ORIGINAL PLAN	SURVEY PLOTTED BY	DATE
NOTE BOOK	DRAWN BY	4/17/03
add. Show	CHECKED BY	
add. Show	CHECKED BY	

"AS-BUILT"