


FED. ROAD DIST. NO.	STATE	PROJ. NO.	FISCAL YEAR	SHEET NO.	TOTAL SHEETS
HAWAII	HAW.	50C-02-01M	2003	12	18

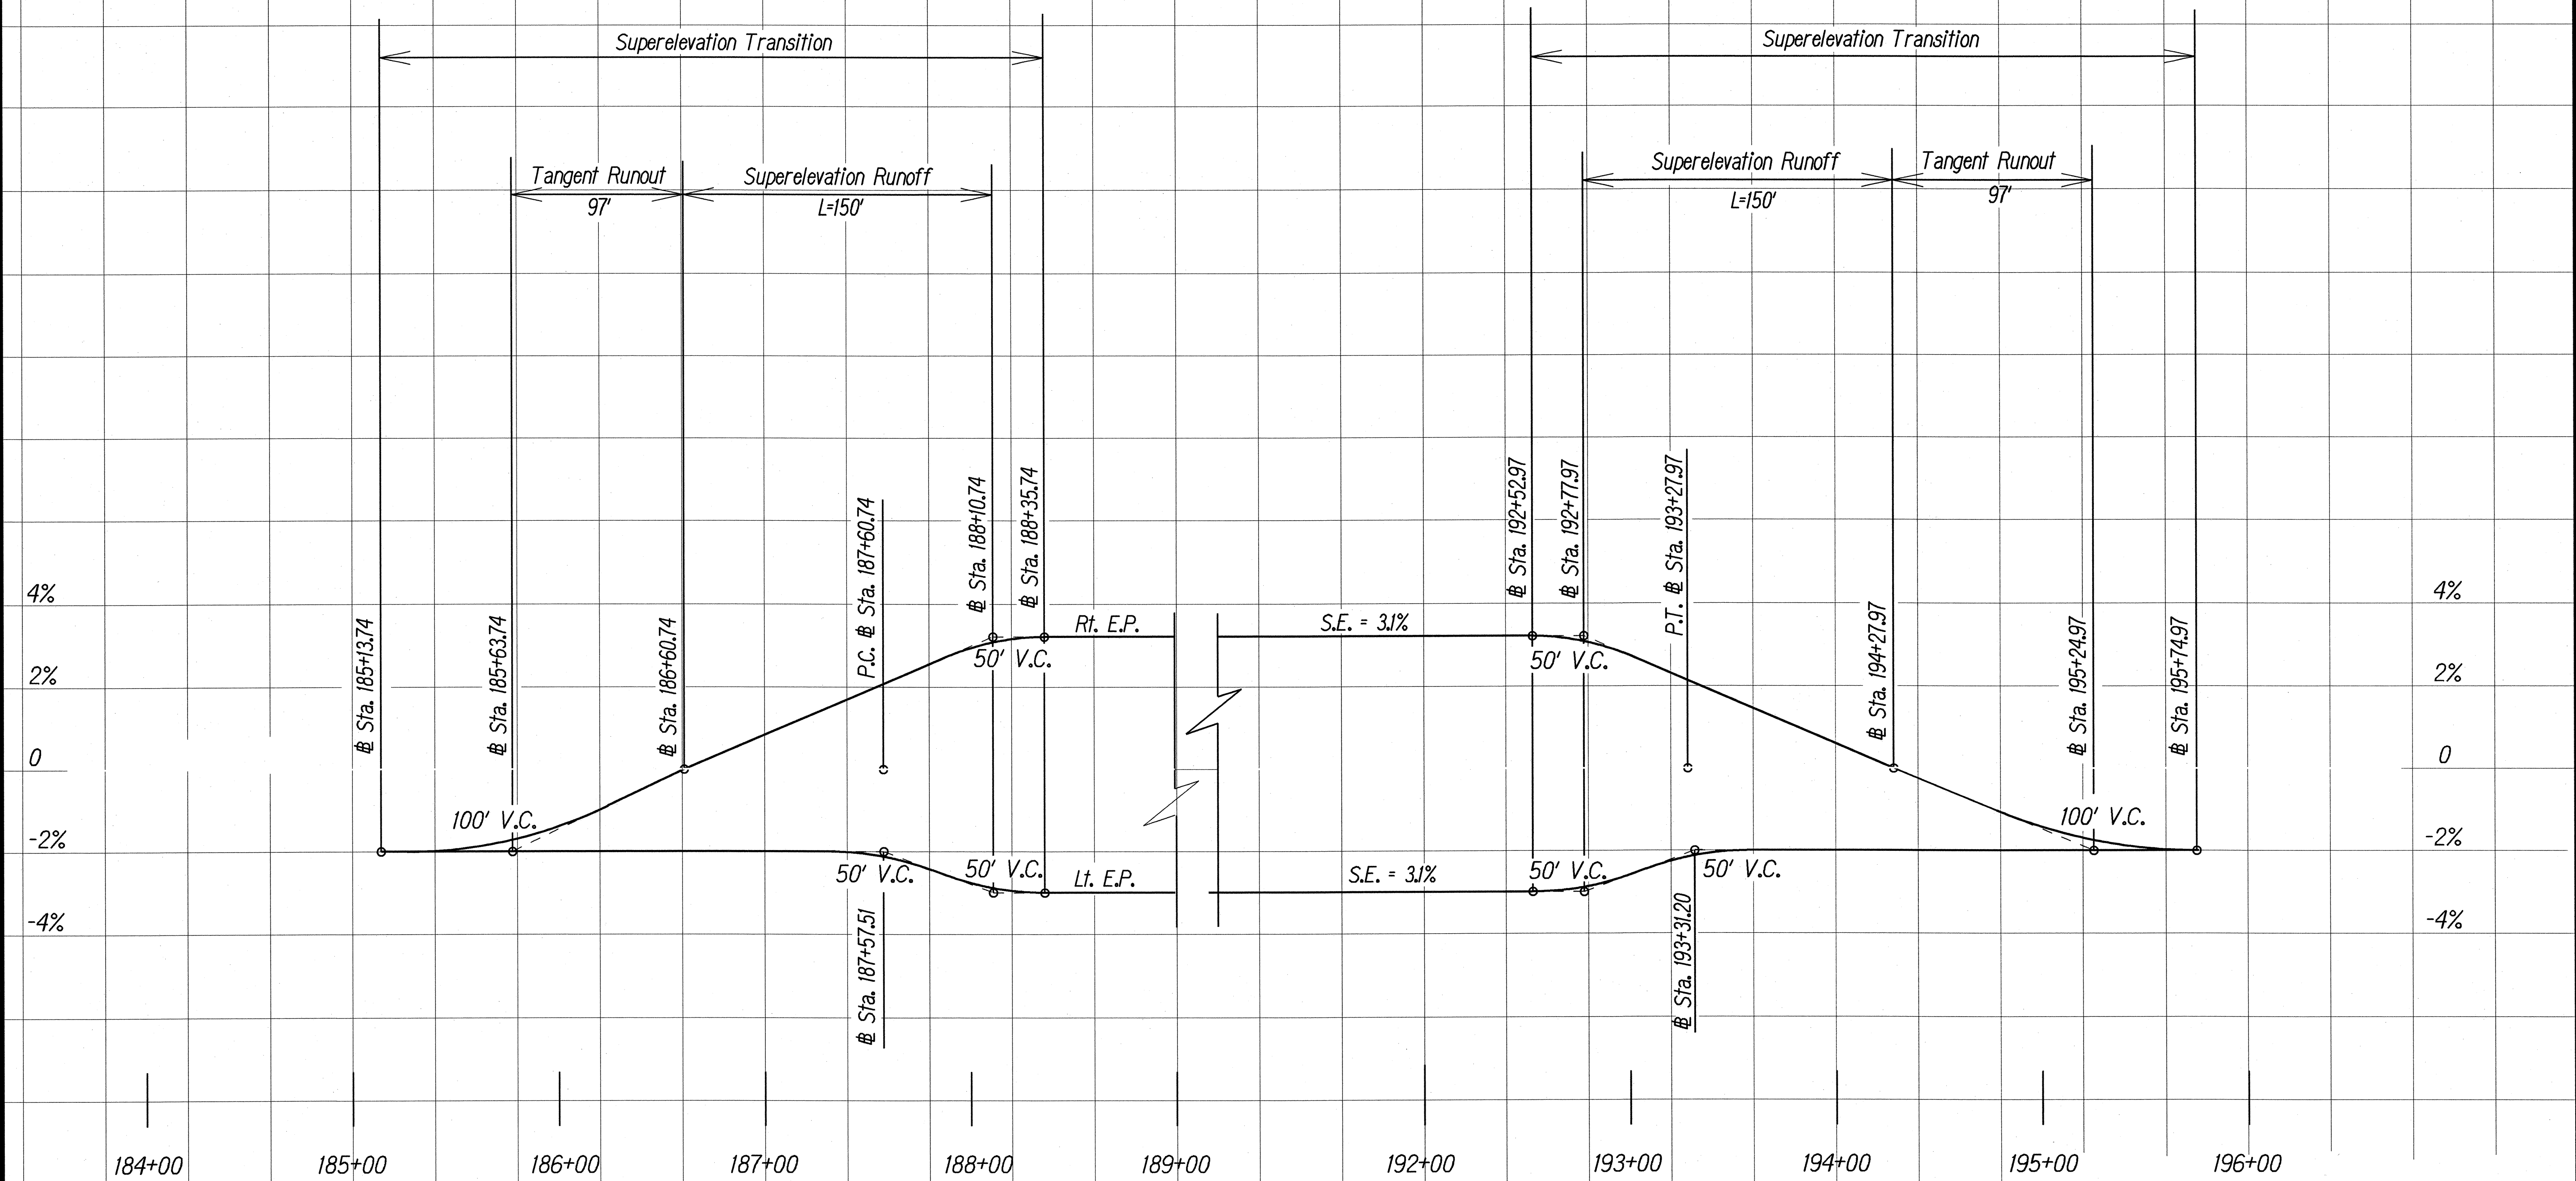

SURVEY PLANNED BY: _____ DATE: 4/15/03
 DRAWN BY: _____
 DESIGNED BY: _____
 QUANTITIES BY: _____
 CHECKED BY: _____

SUPERELEVATION DIAGRAM

Scale: Horiz.: 1"=40'
 Vert.: 1"= 2%

STATE OF HAWAII
 DEPARTMENT OF TRANSPORTATION
 HIGHWAYS DIVISION

SUPERELEVATION DIAGRAM
 KAUNUALII HIGHWAY RESURFACING
 Vicinity of Laulea Street
 to Halewili Road
 Project No. 50C-02-01M
 Scale: As Shown Date: April, 2003
 SHEET No. 1 OF 1 SHEETS