
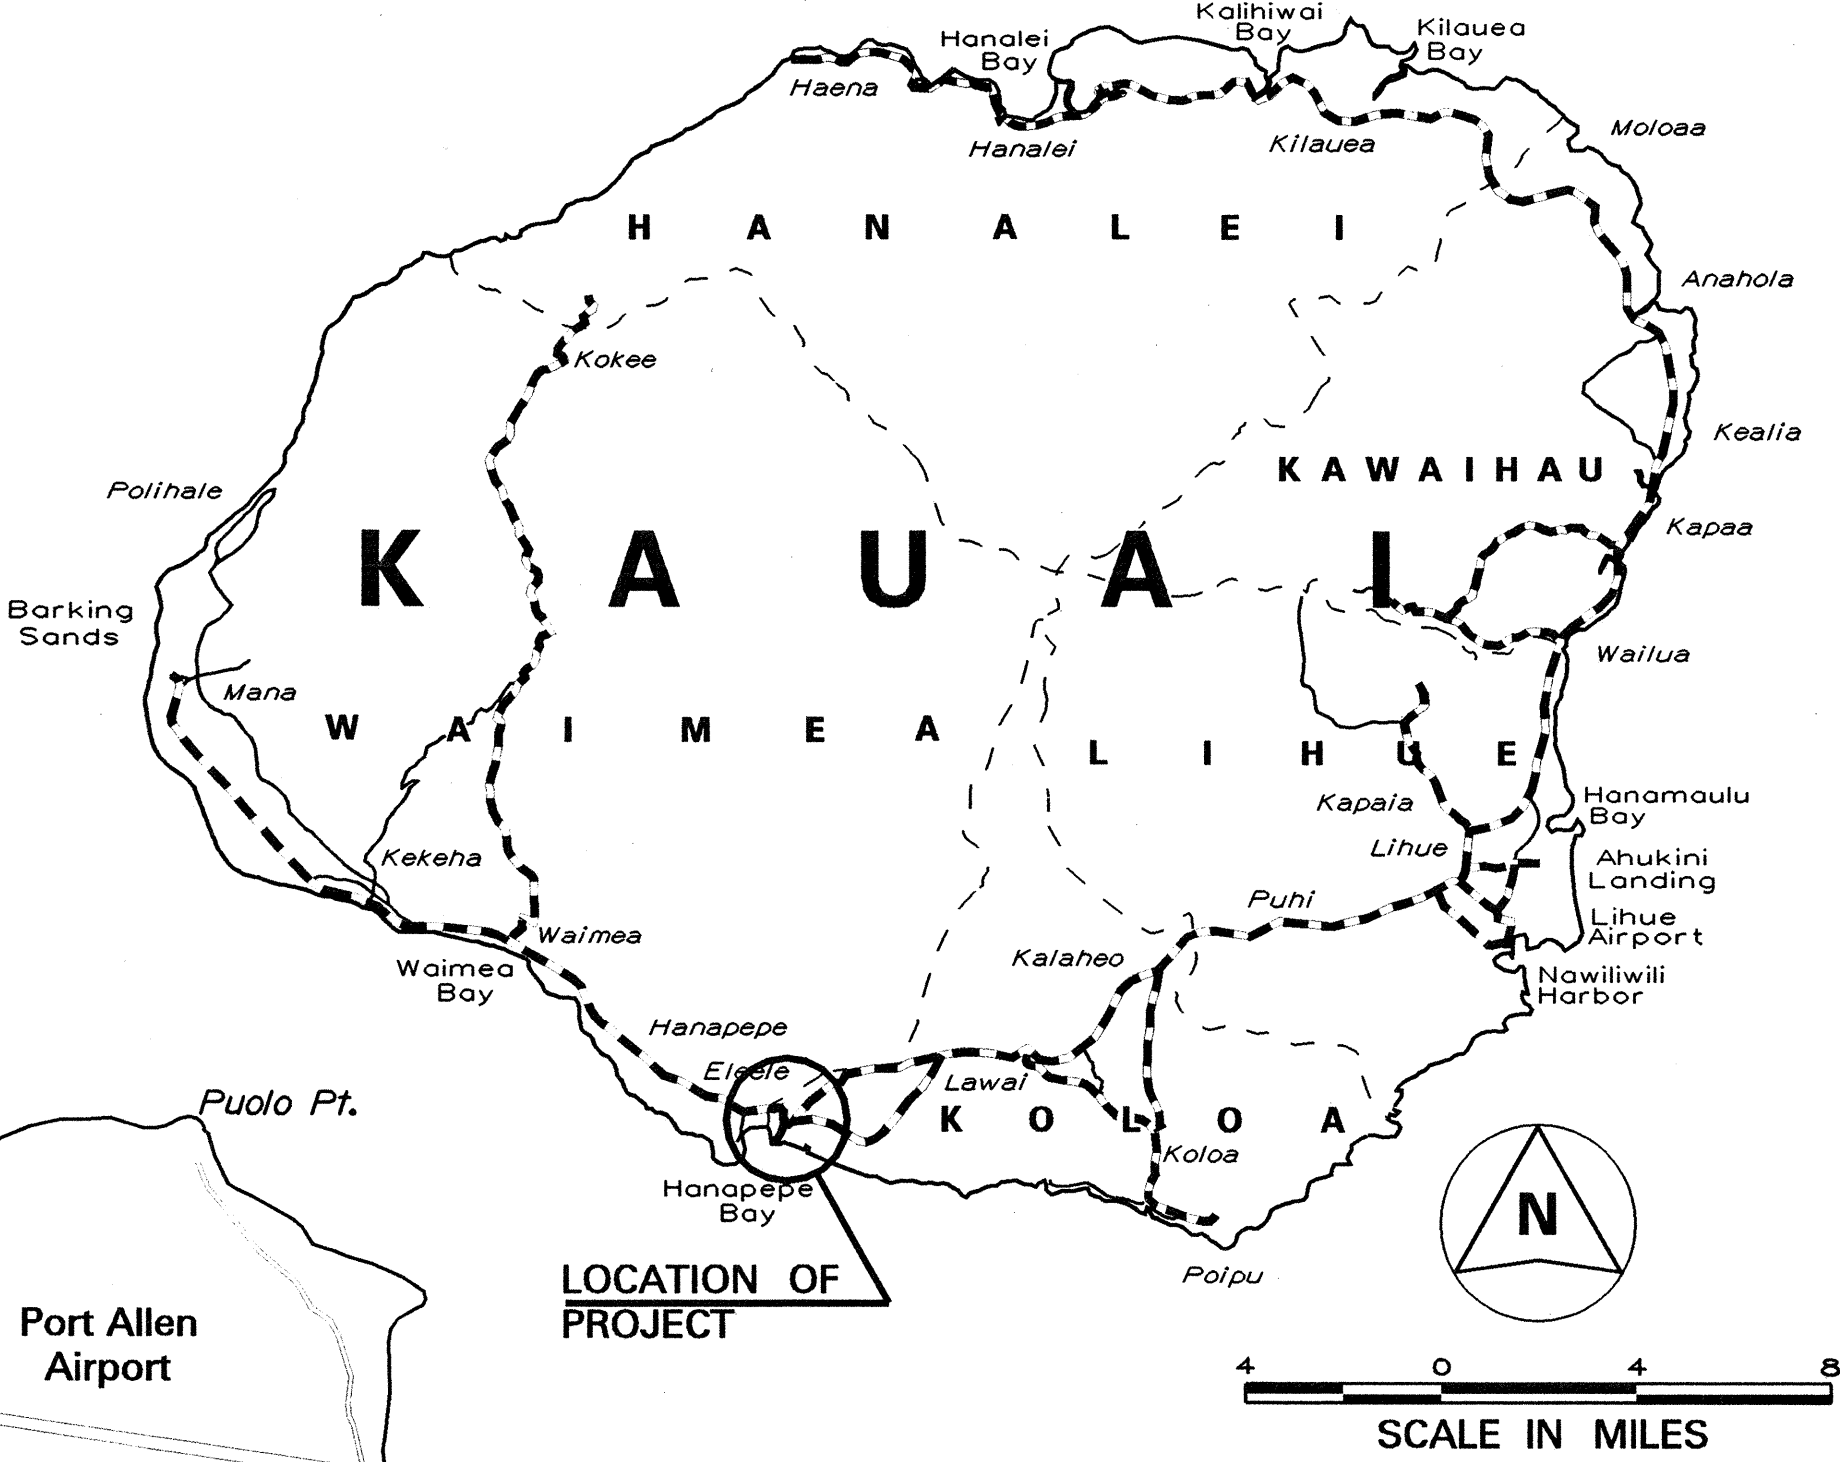
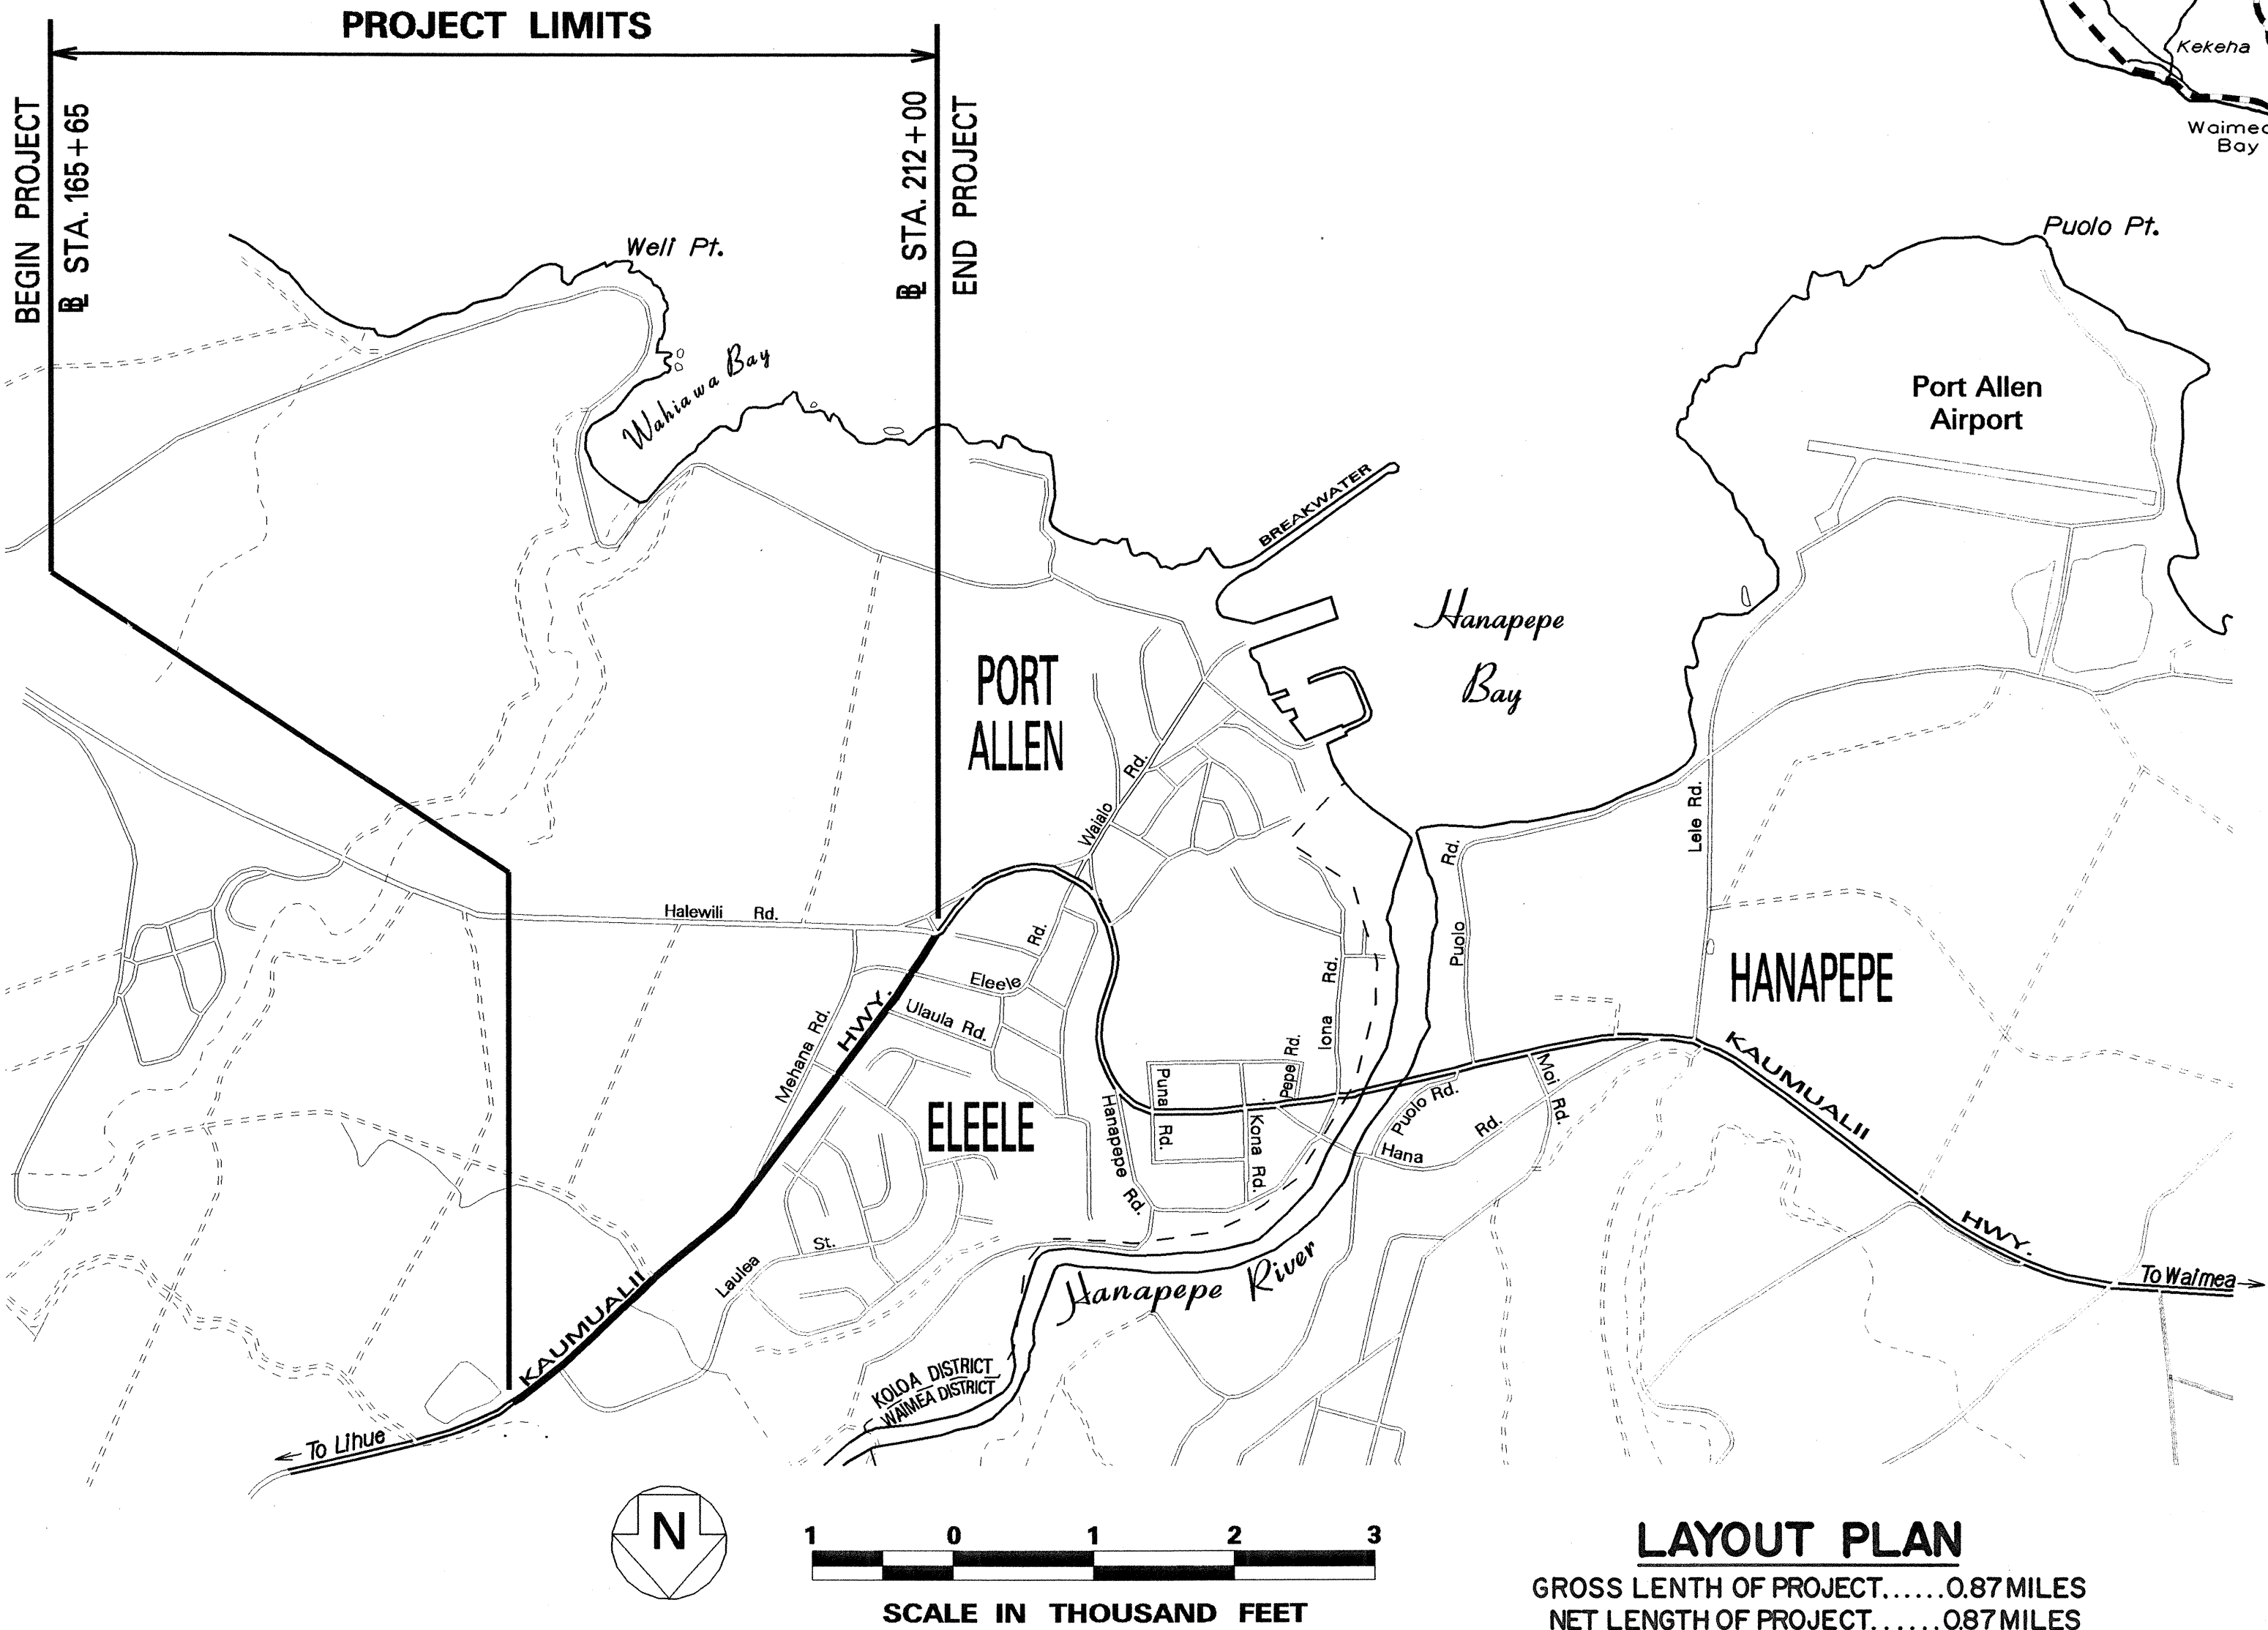


INDEX TO DRAWINGS	
SHEET NO.	DESCRIPTION
1	TITLE SHEET
2	STANDARD PLANS SUMMARY
3	GENERAL NOTES & LEGEND
4 - 5	WATER POLLUTION & EROSION CONTROL NOTES
6 - 7	TYPICAL SECTIONS
8 - 10	ROADWAY PLANS
11	ROADWAY PROFILE
12	SUPERELEVATION DIAGRAM
13	PAVEMENT MARKING LEGEND, DETAILS & NOTES
14-16	PAVEMENT MARKING & STRIPING PLANS
17	STREET NAME & DESTINATION SIGN LAYOUT & DETAILS
18	TRAFFIC SUMMARIES

STATE OF HAWAII
DEPARTMENT OF TRANSPORTATION
HIGHWAYS DIVISION
HONOLULU, HAWAII
"AS-BUILT"
PLANS FOR
KAUMUALII HIGHWAY RESURFACING
VICINITY OF LAULEA STREET TO HALEWILI ROAD
PROJECT NO. 50C-02-01M

DISTRICT OF KOLOA
ISLAND OF KAUAI

FED. ROAD DIST. NO.	STATE	PROJ. NO.	FISCAL YEAR	SHEET NO.	TOTAL SHEETS
HAWAII	HAW.	50C-02-01M	2003	1	18

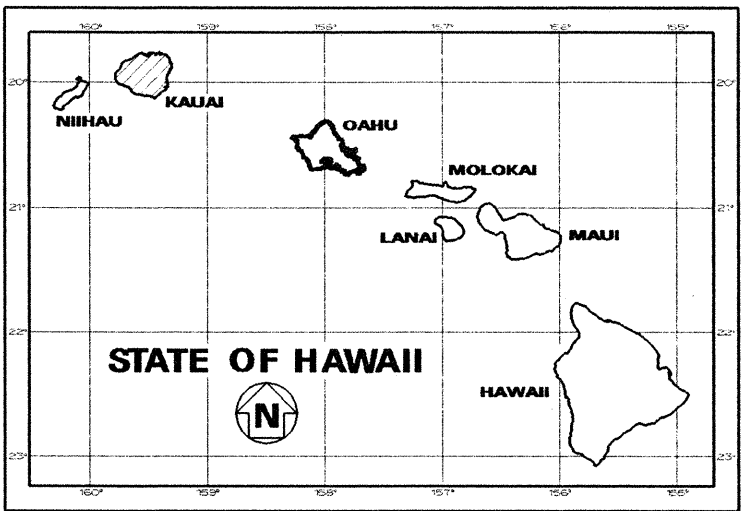

MILE POST 14.80 TO MILE POST 15.67

CHANGES MADE DURING CONSTRUCTION HAVE BEEN INCORPORATED ON THESE PLANS EXCEPT CHANGES IN THE ORIGINAL THEORETICAL QUANTITIES. FOR ACTUAL QUANTITIES, REFER TO PROJECT LEDGER AND/OR CONSTRUCTION BOOK.
[Signature] 9/20/04
RESIDENT ENGINEER DATE

DEPARTMENT OF TRANSPORTATION
STATE OF HAWAII
APPROVED:
[Signature] 4-17-03
for DIR. OF TRANSPORTATION DATE

DESIGN UNIT "D" DESIGNED BY GLENN KURASHIMA 692-7578 APRIL, 2003
P. S. & E. BY PHONE DATE

LAYOUT PLAN
GROSS LENGTH OF PROJECT.....0.87 MILES
NET LENGTH OF PROJECT.....0.87 MILES