

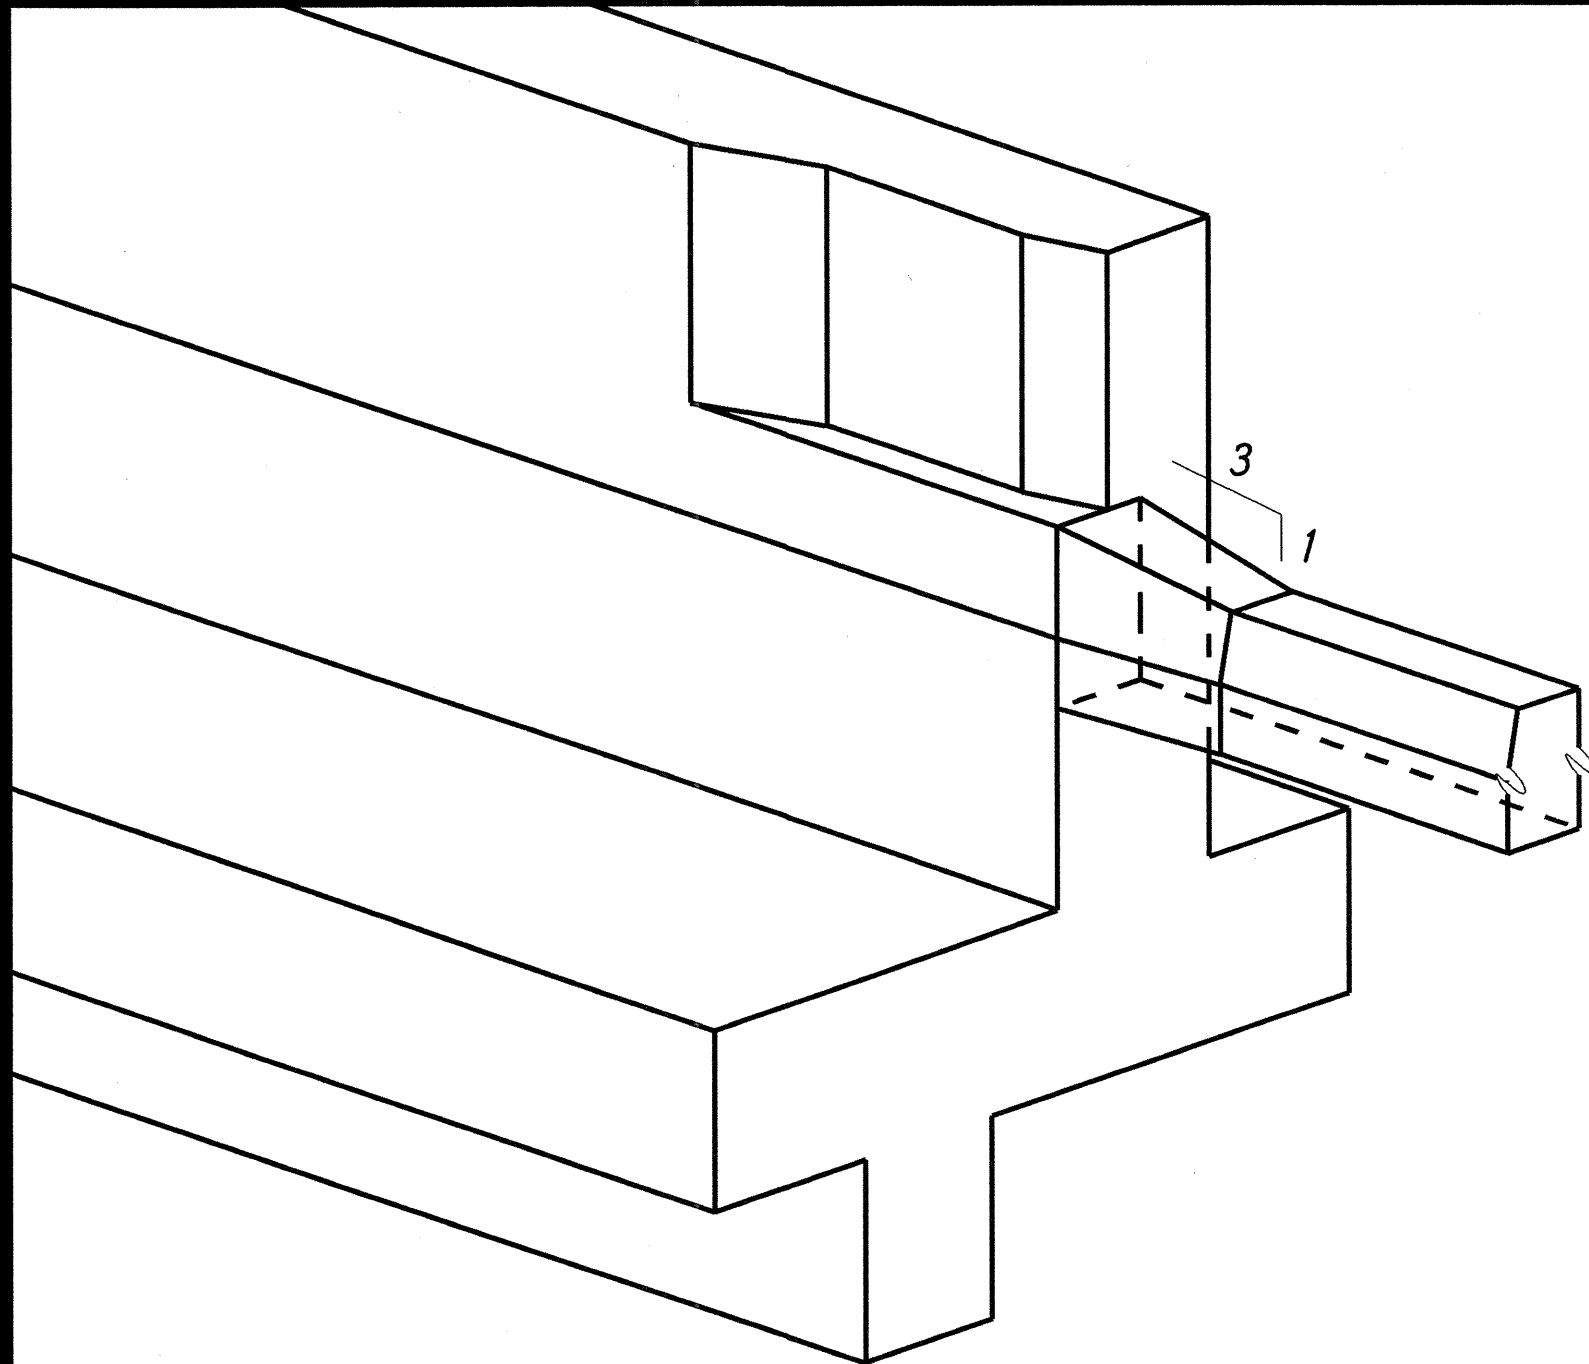
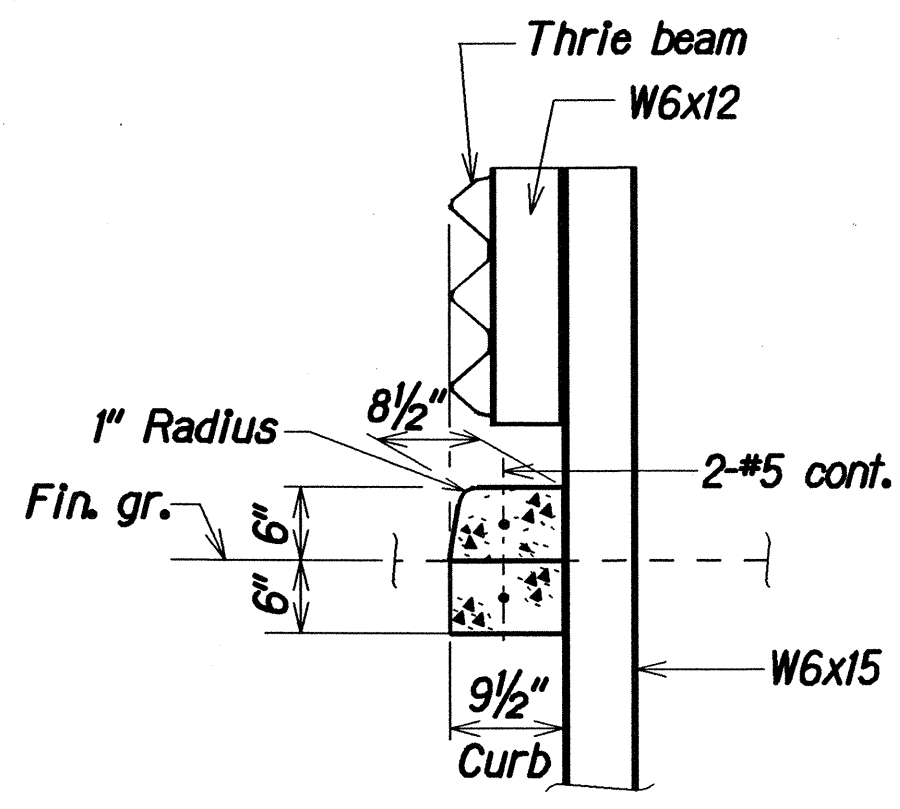
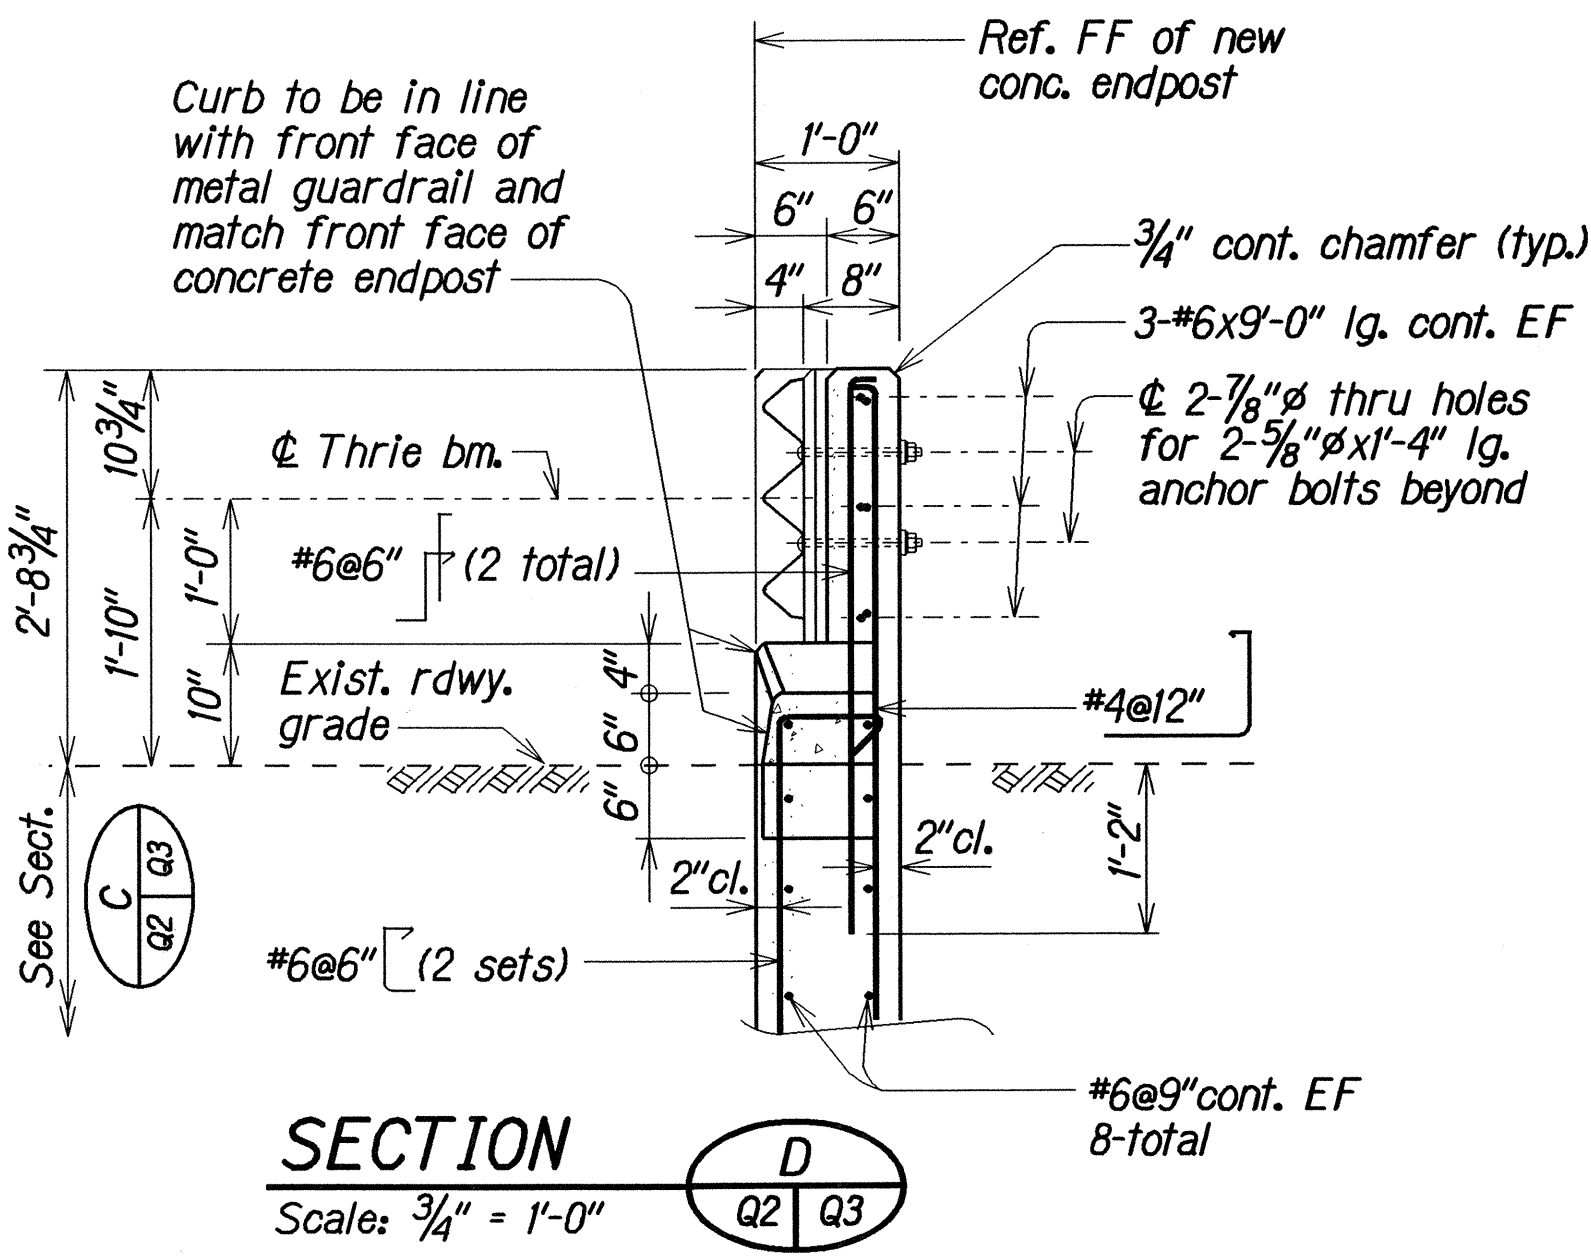
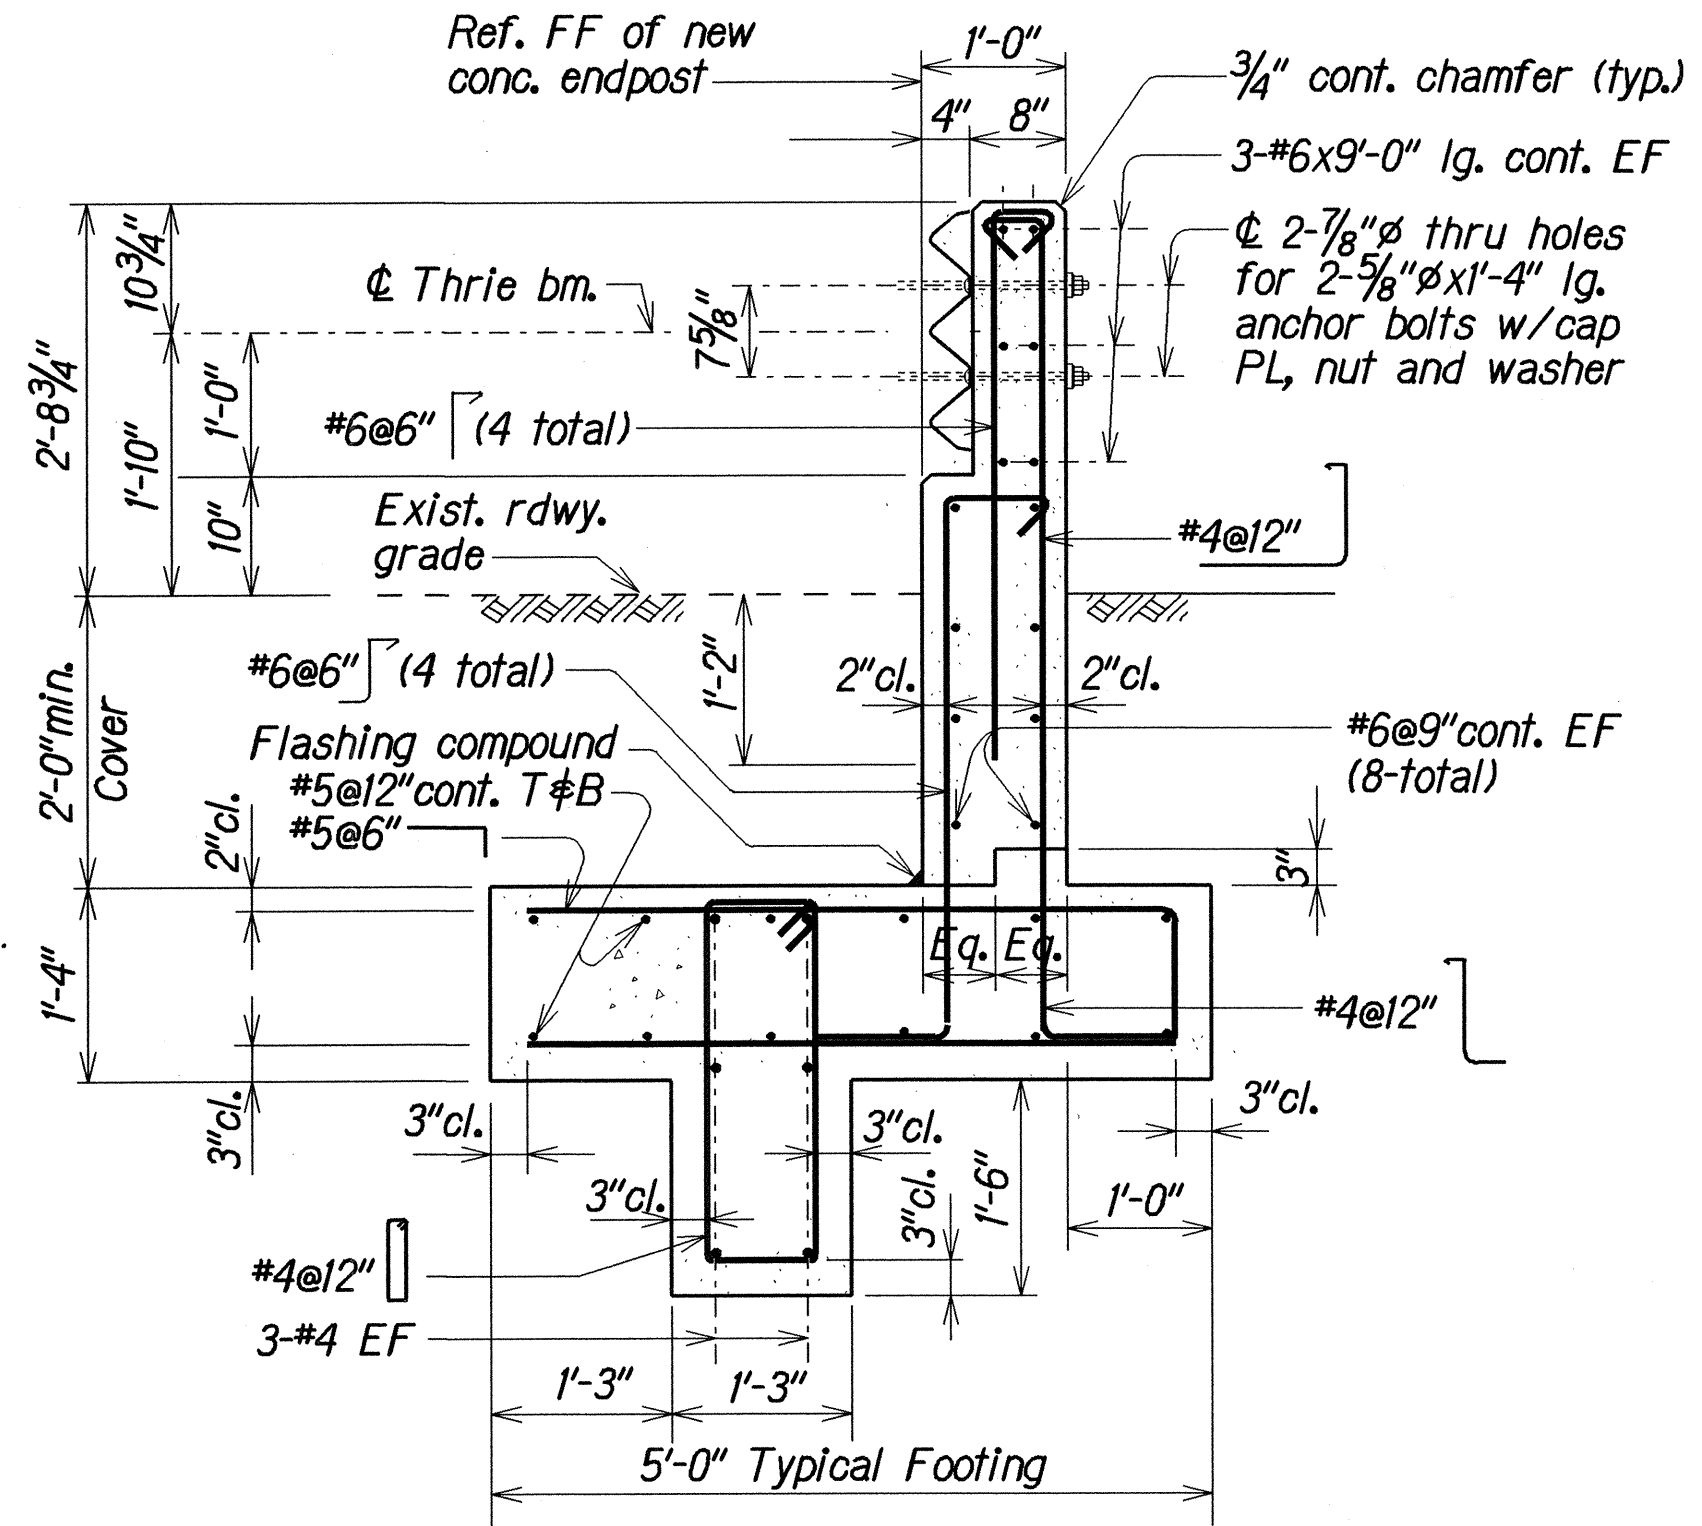


FED. ROAD DIST. NO.	STATE	FED. AID PROJ. NO.	FISCAL YEAR	SHEET NO.	TOTAL SHEETS
HAWAII	HAW.	STP-050-1(27)	2005	26	27

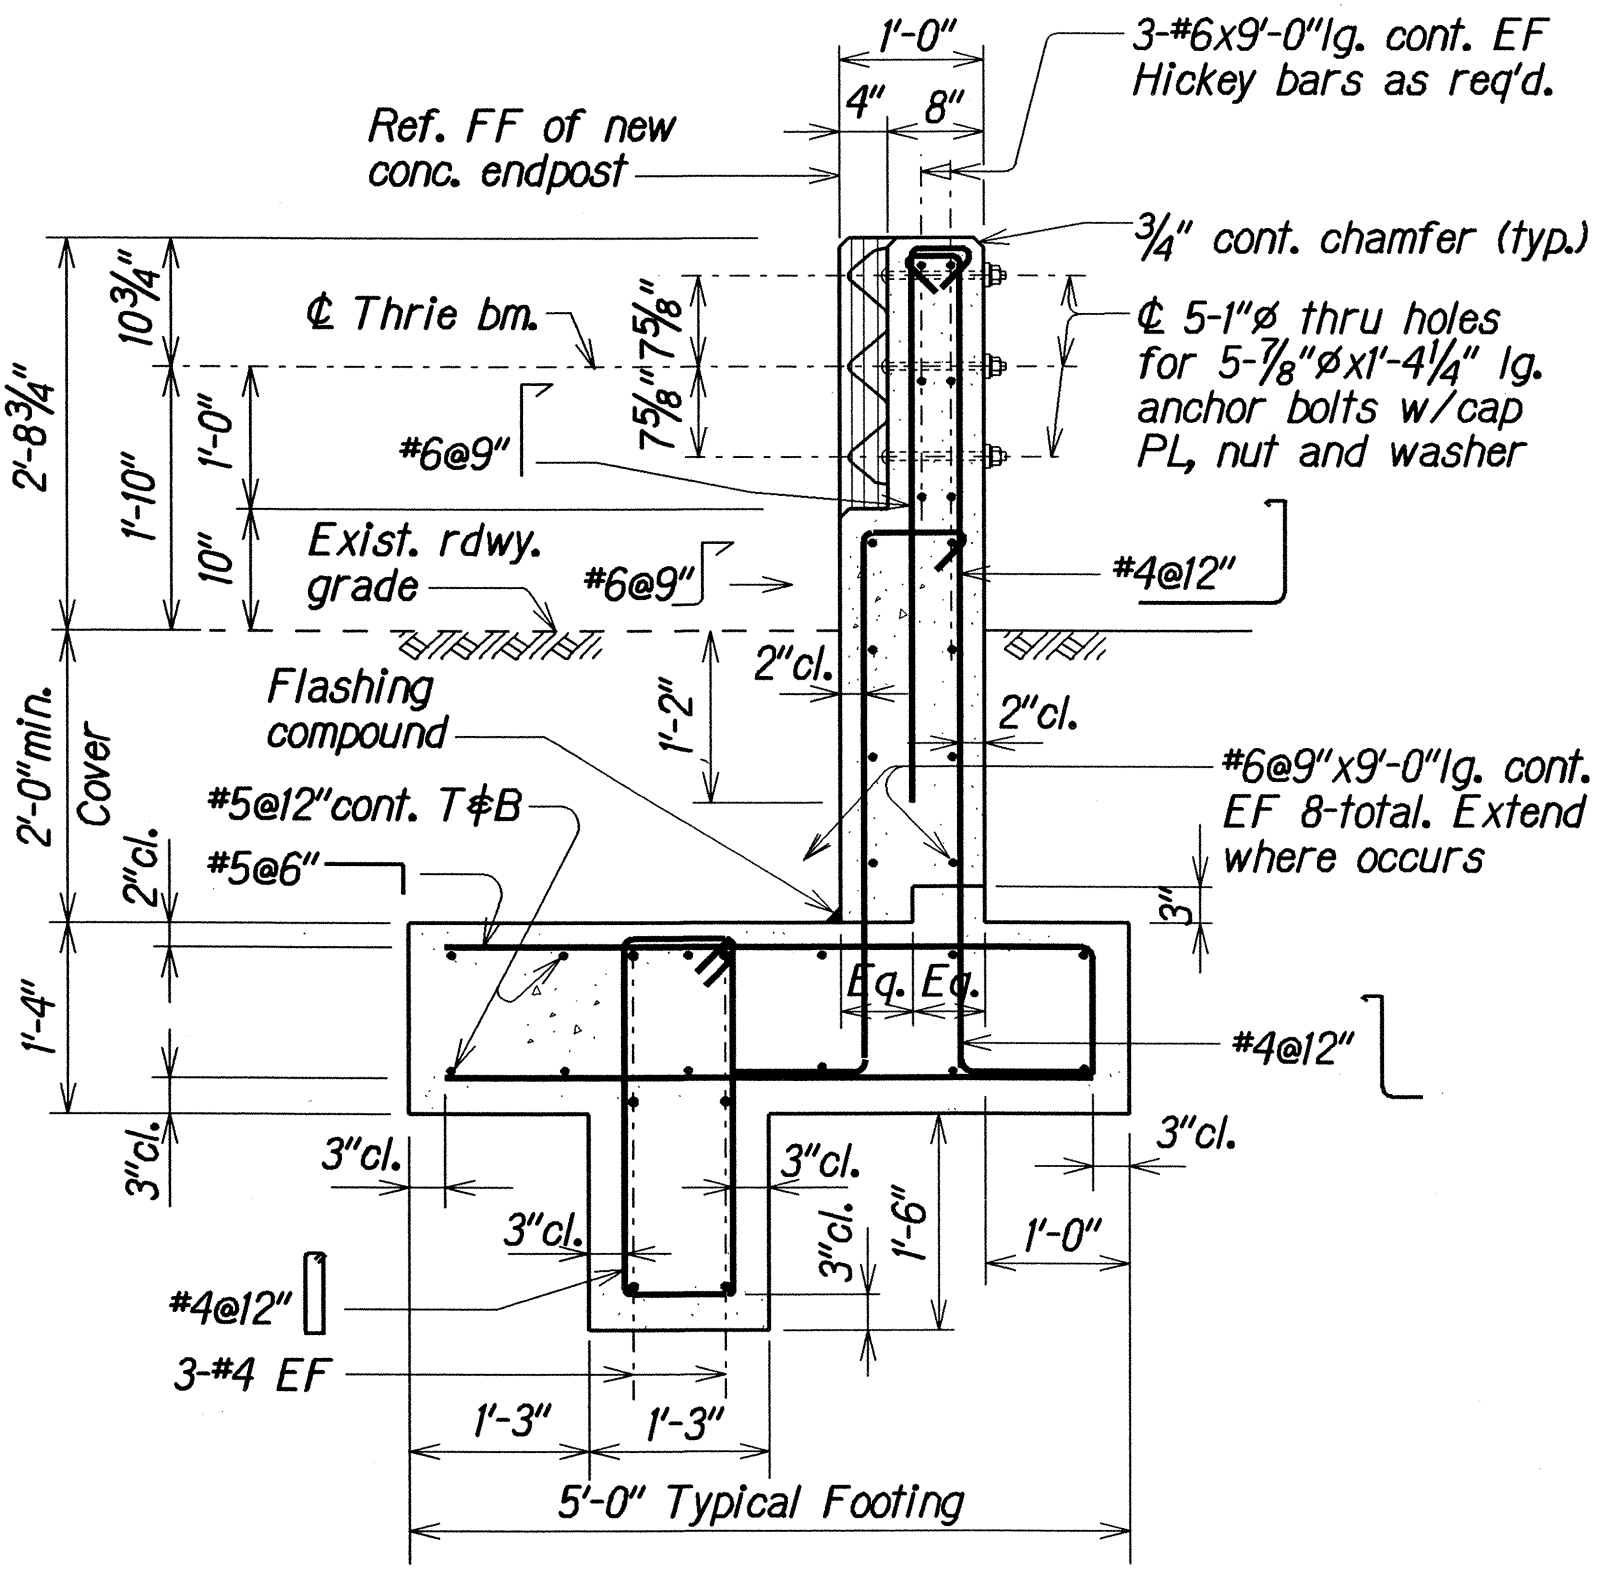

PARTIAL ISOMETRIC VIEW
TYPE "HP-TL2" ENDPOST

Not to Scale

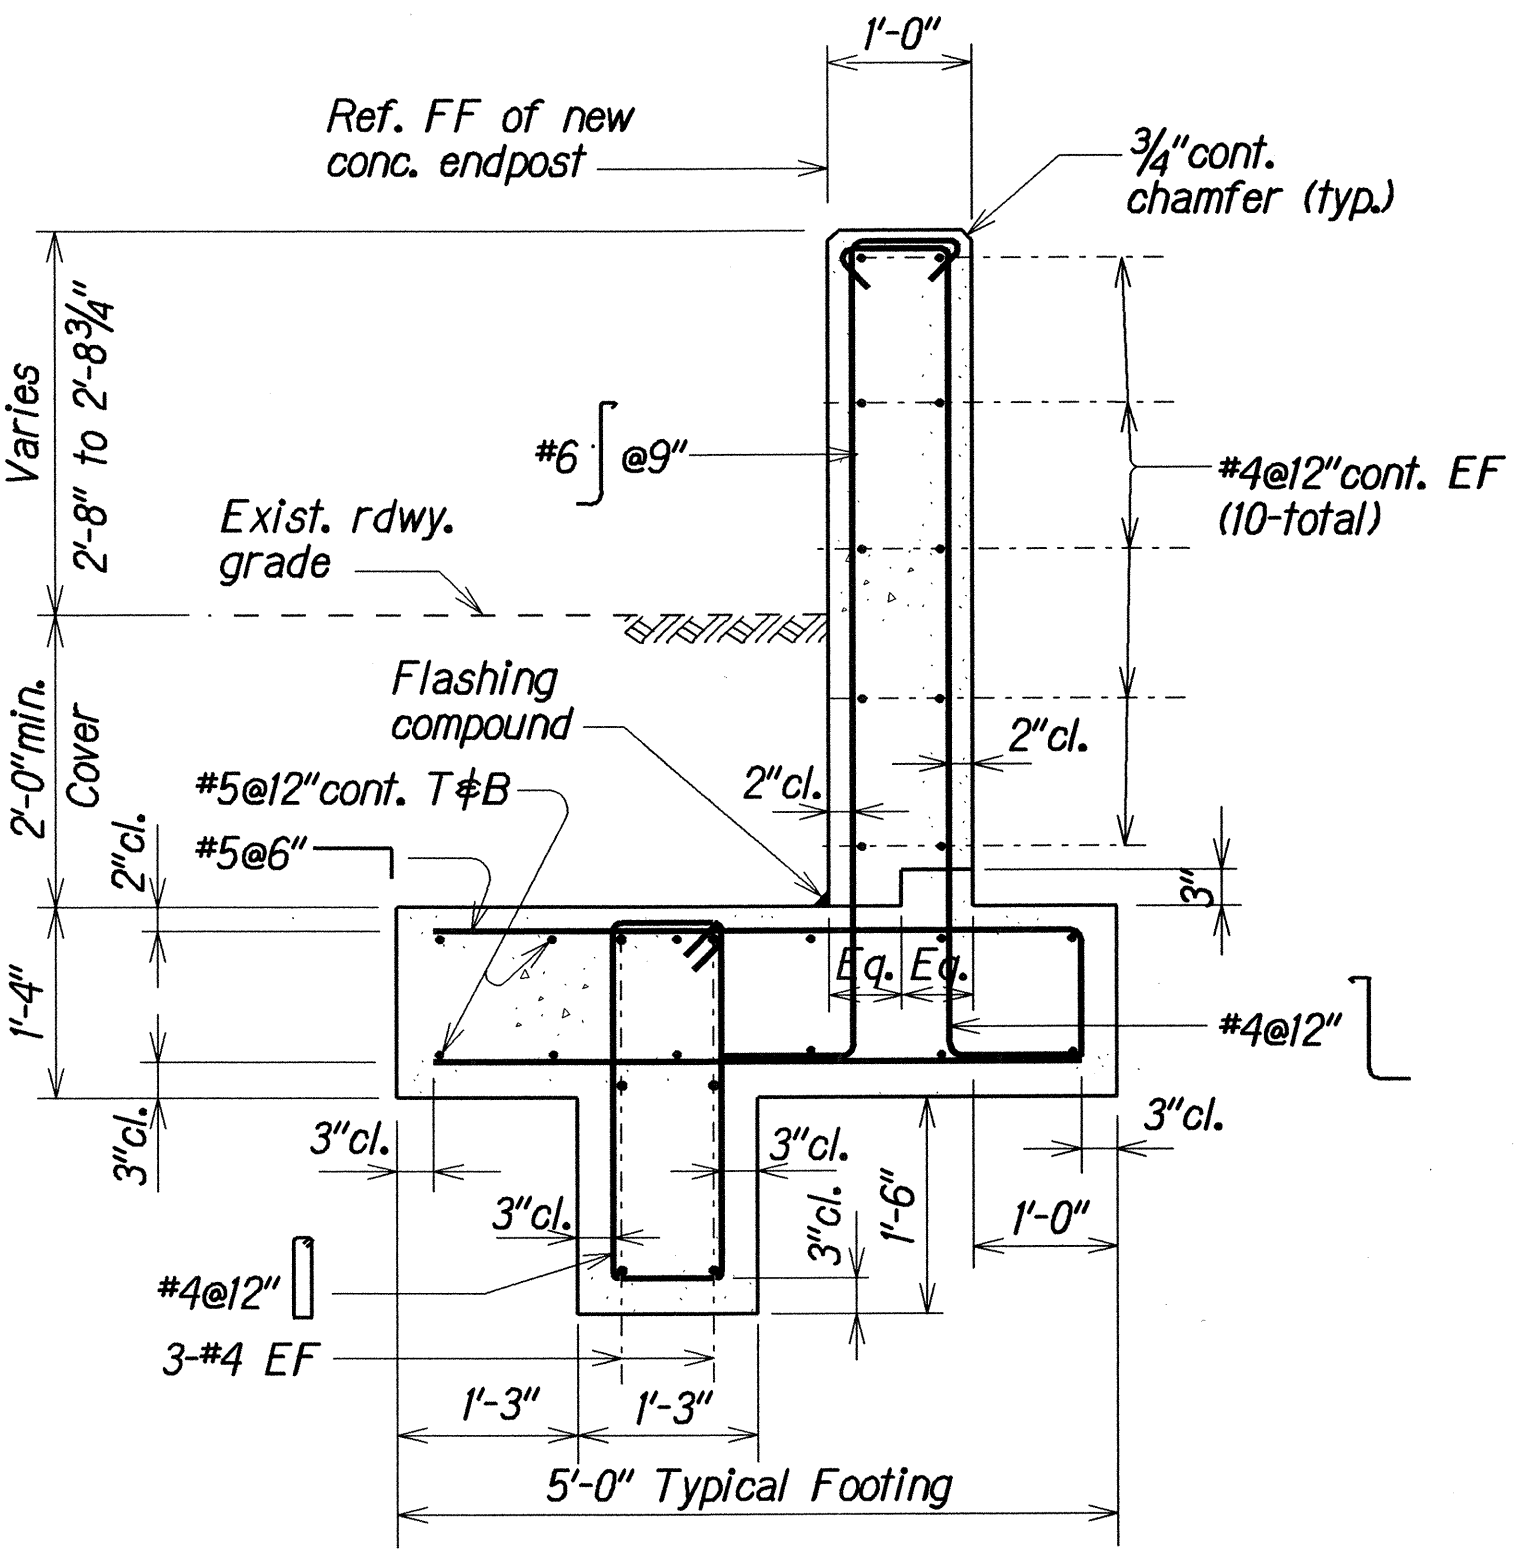

TYPICAL SECTIONS - ENDPOST DETAILS

ORIGINAL PLAN	DATE	DESIGNED BY	CHECKED BY
NOTED	MAY 2004	KML/LMA	DKT
QUANTITIES	MAY 2004	DKT	PJS
BY			

STATE OF HAWAII
DEPARTMENT OF TRANSPORTATION
HIGHWAYS DIVISION

TYPE "H-TL2" ENDPOST DETAILS
PARTIAL ISOMETRIC VIEW & TYPICAL SECTIONS
KAUMUALII HIGHWAY
Guardrail and Shoulder Improvements at Hanalei Bridge
and Mana Bridge Structure Nos. 1, 2, 3 & 4
Federal Aid Project No. STP-050-1(27)
Scale: As Noted
Date: Nov. 2003