

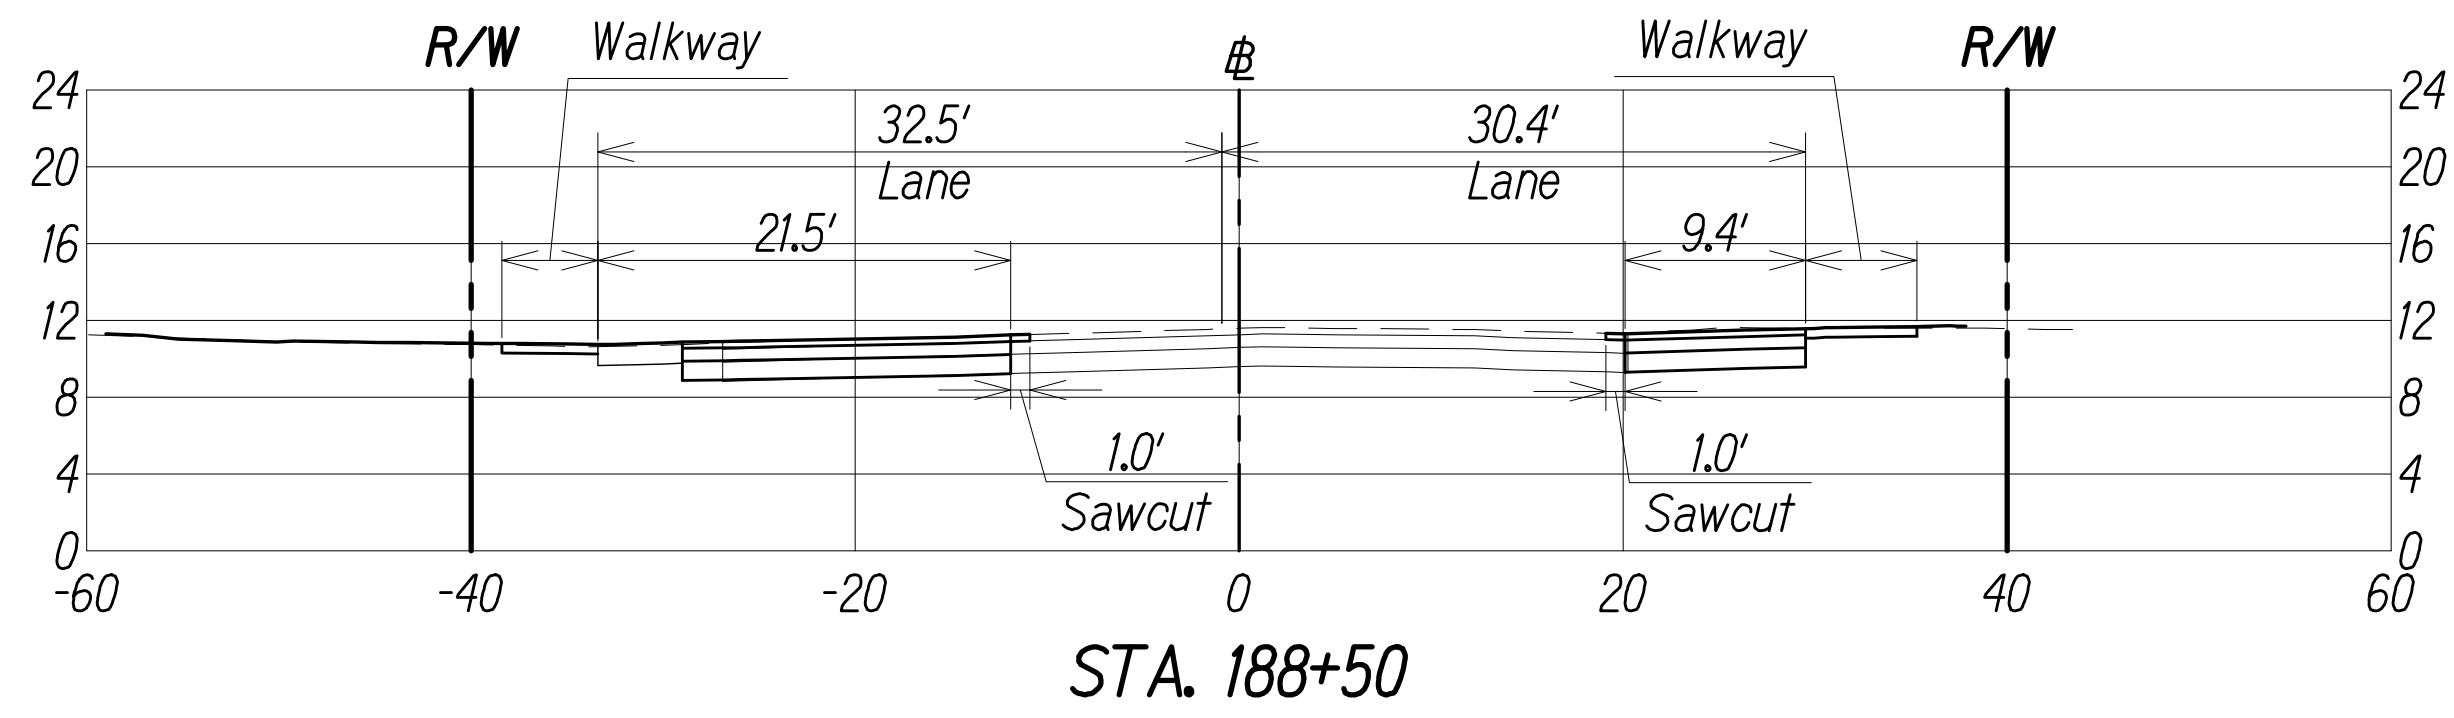
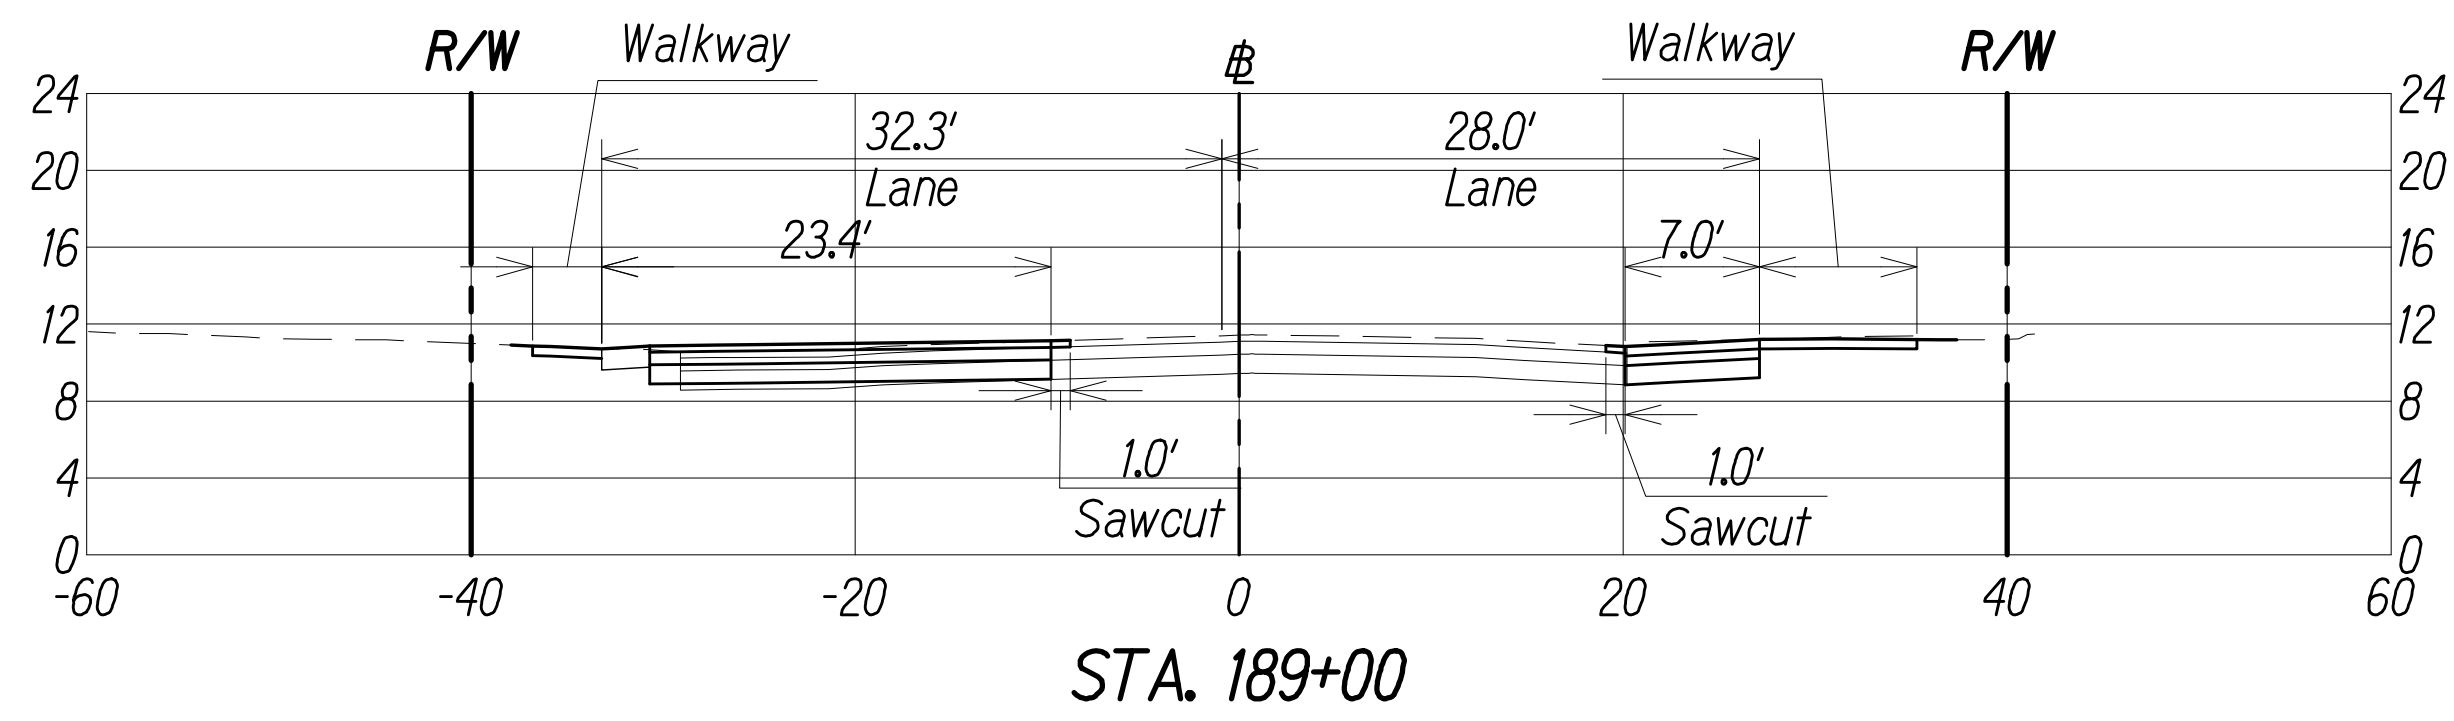


DIST. NO.	STATE	PROJ. NO.	FISCAL YEAR	SHEET NO.	TOTAL SHEETS
KAUAI	HAW.	50B-01-14R	2021	33	44

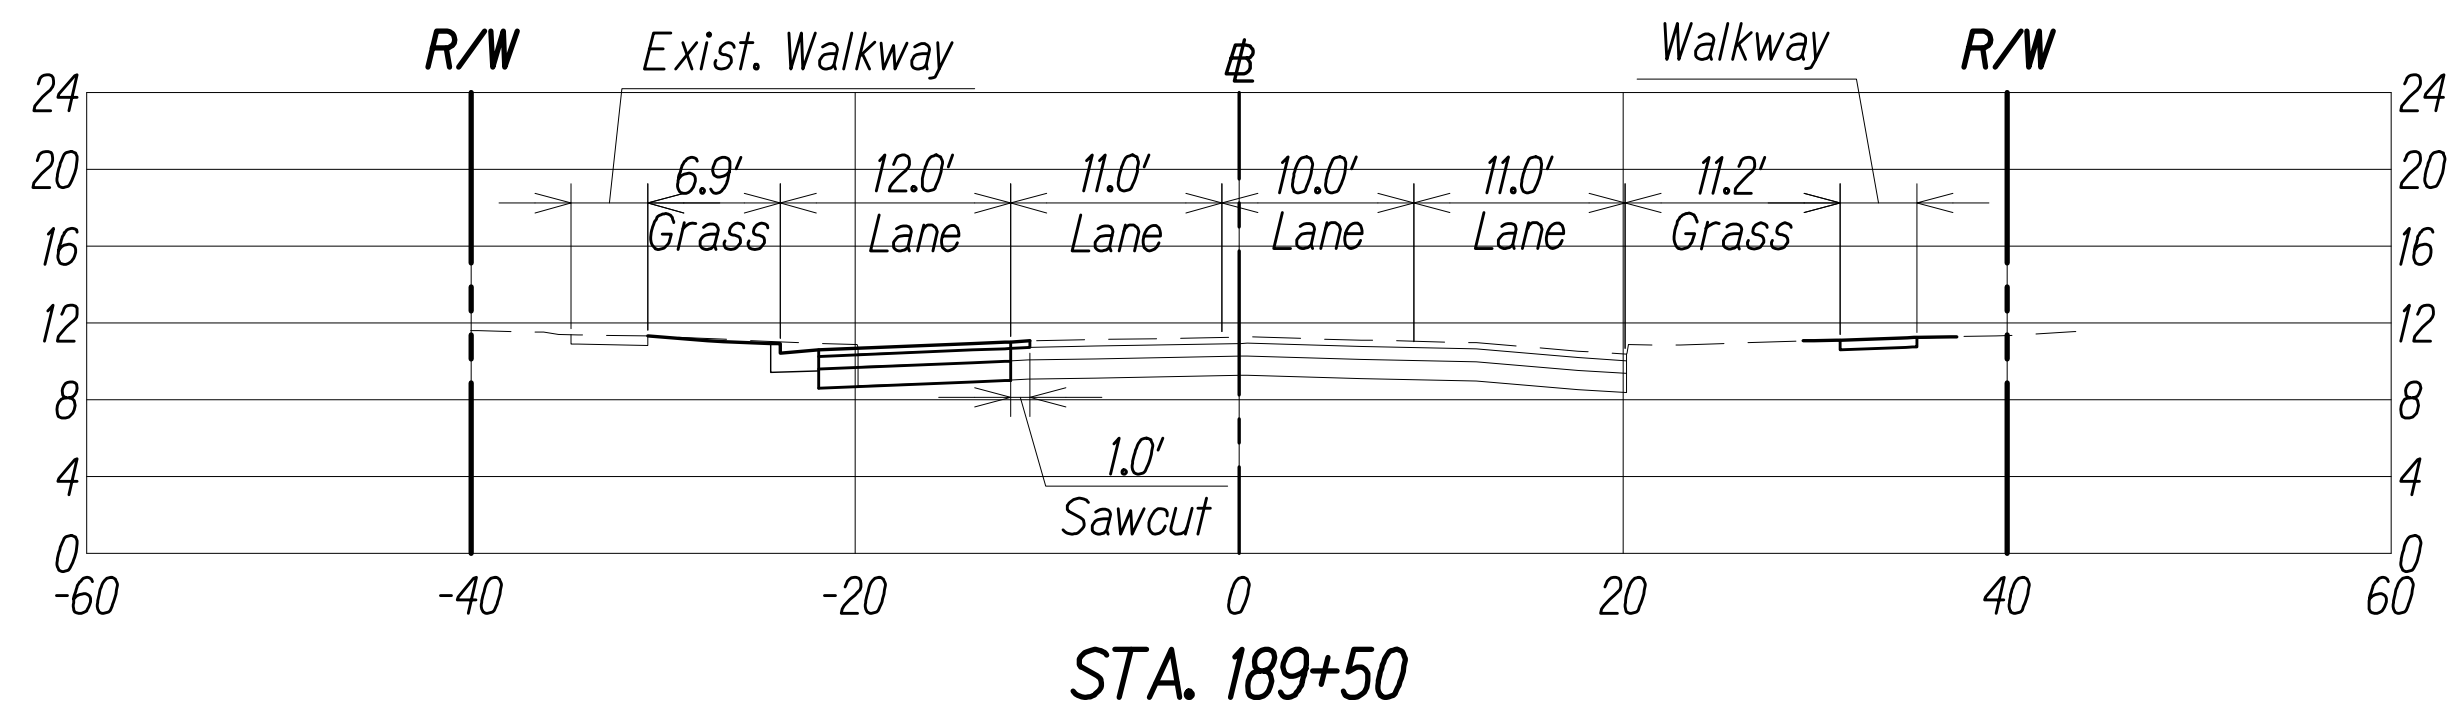

ORIGINAL PLAN	SURVEY PLOTTED BY	DATE
NOTE BOOK	DESIGNED BY	
	QUANTITIES BY	
	CHECKED BY	

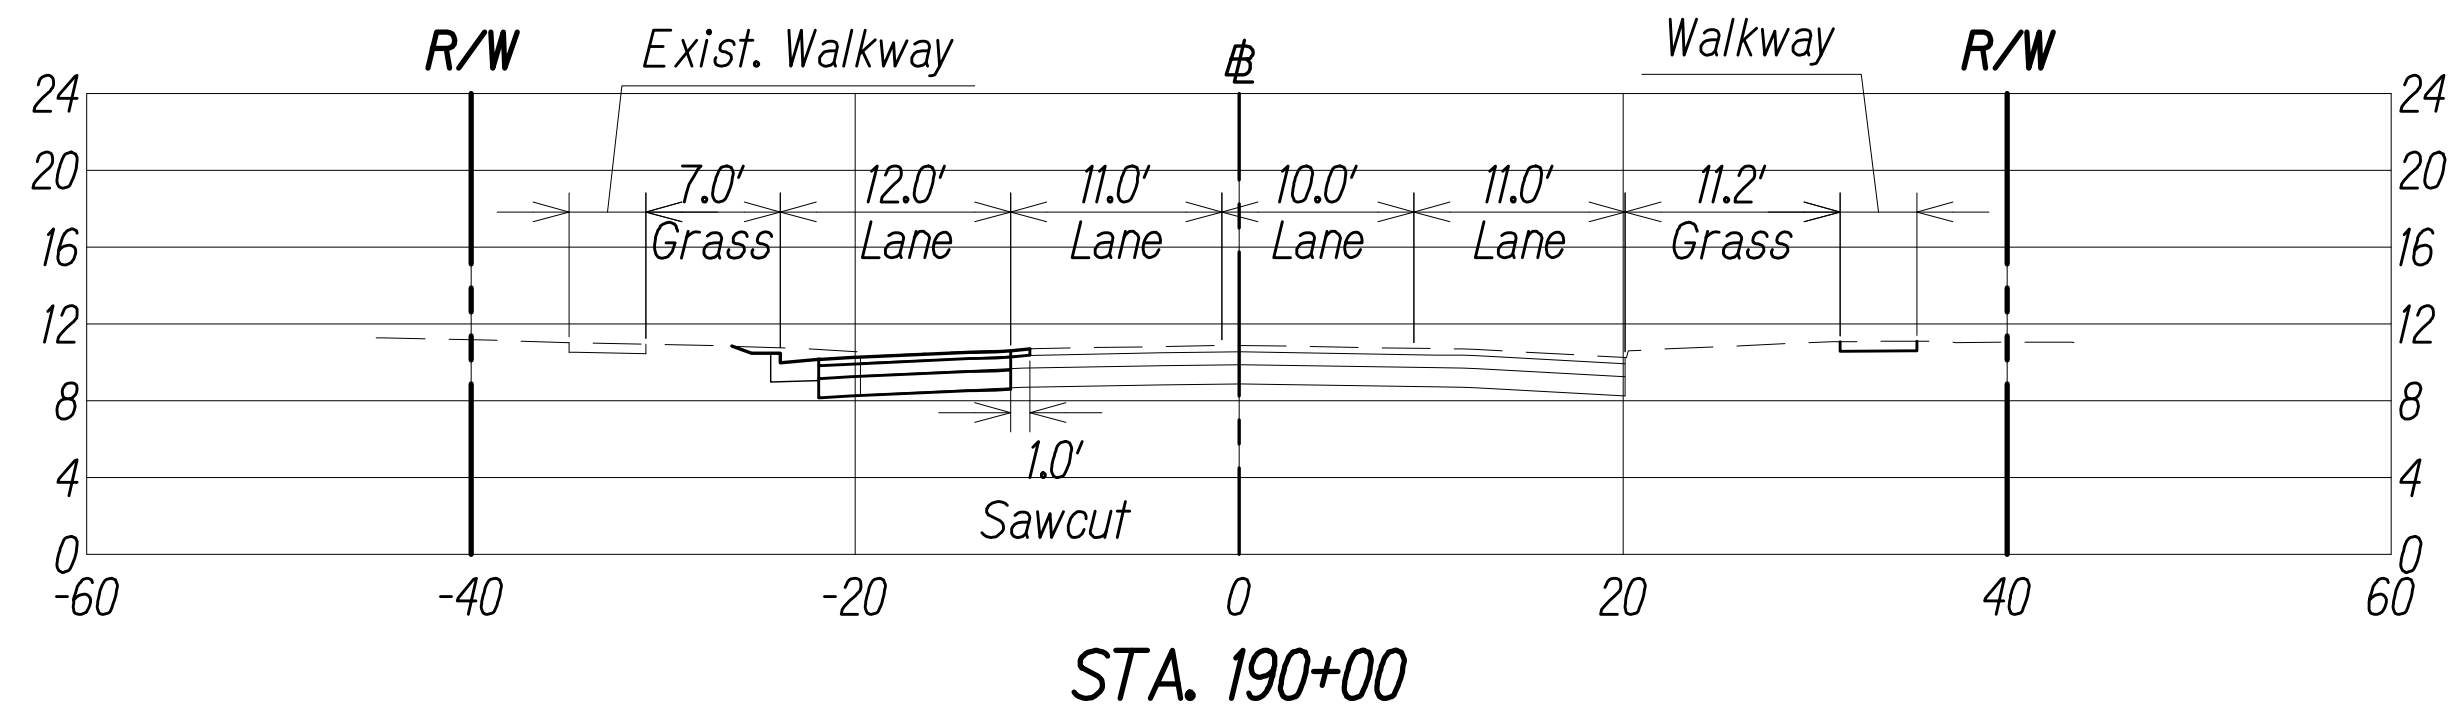

THIS WORK WAS PREPARED BY  
ME OR UNDER MY SUPERVISION.  
*Kyle Shinyama*  
APRIL 30, 2022  
LIC. EXP. DATE

STATE OF HAWAII  
DEPARTMENT OF TRANSPORTATION  
HIGHWAYS DIVISION

**CROSS SECTIONS**

*Kaunualii Highway Intersection  
Improvements at Waimea Canyon Drive  
Project No. 50B-01-14R*

Scale: As Shown      Date: Feb 2021

SHEET No. *CS-1* OF *1* SHEETS