

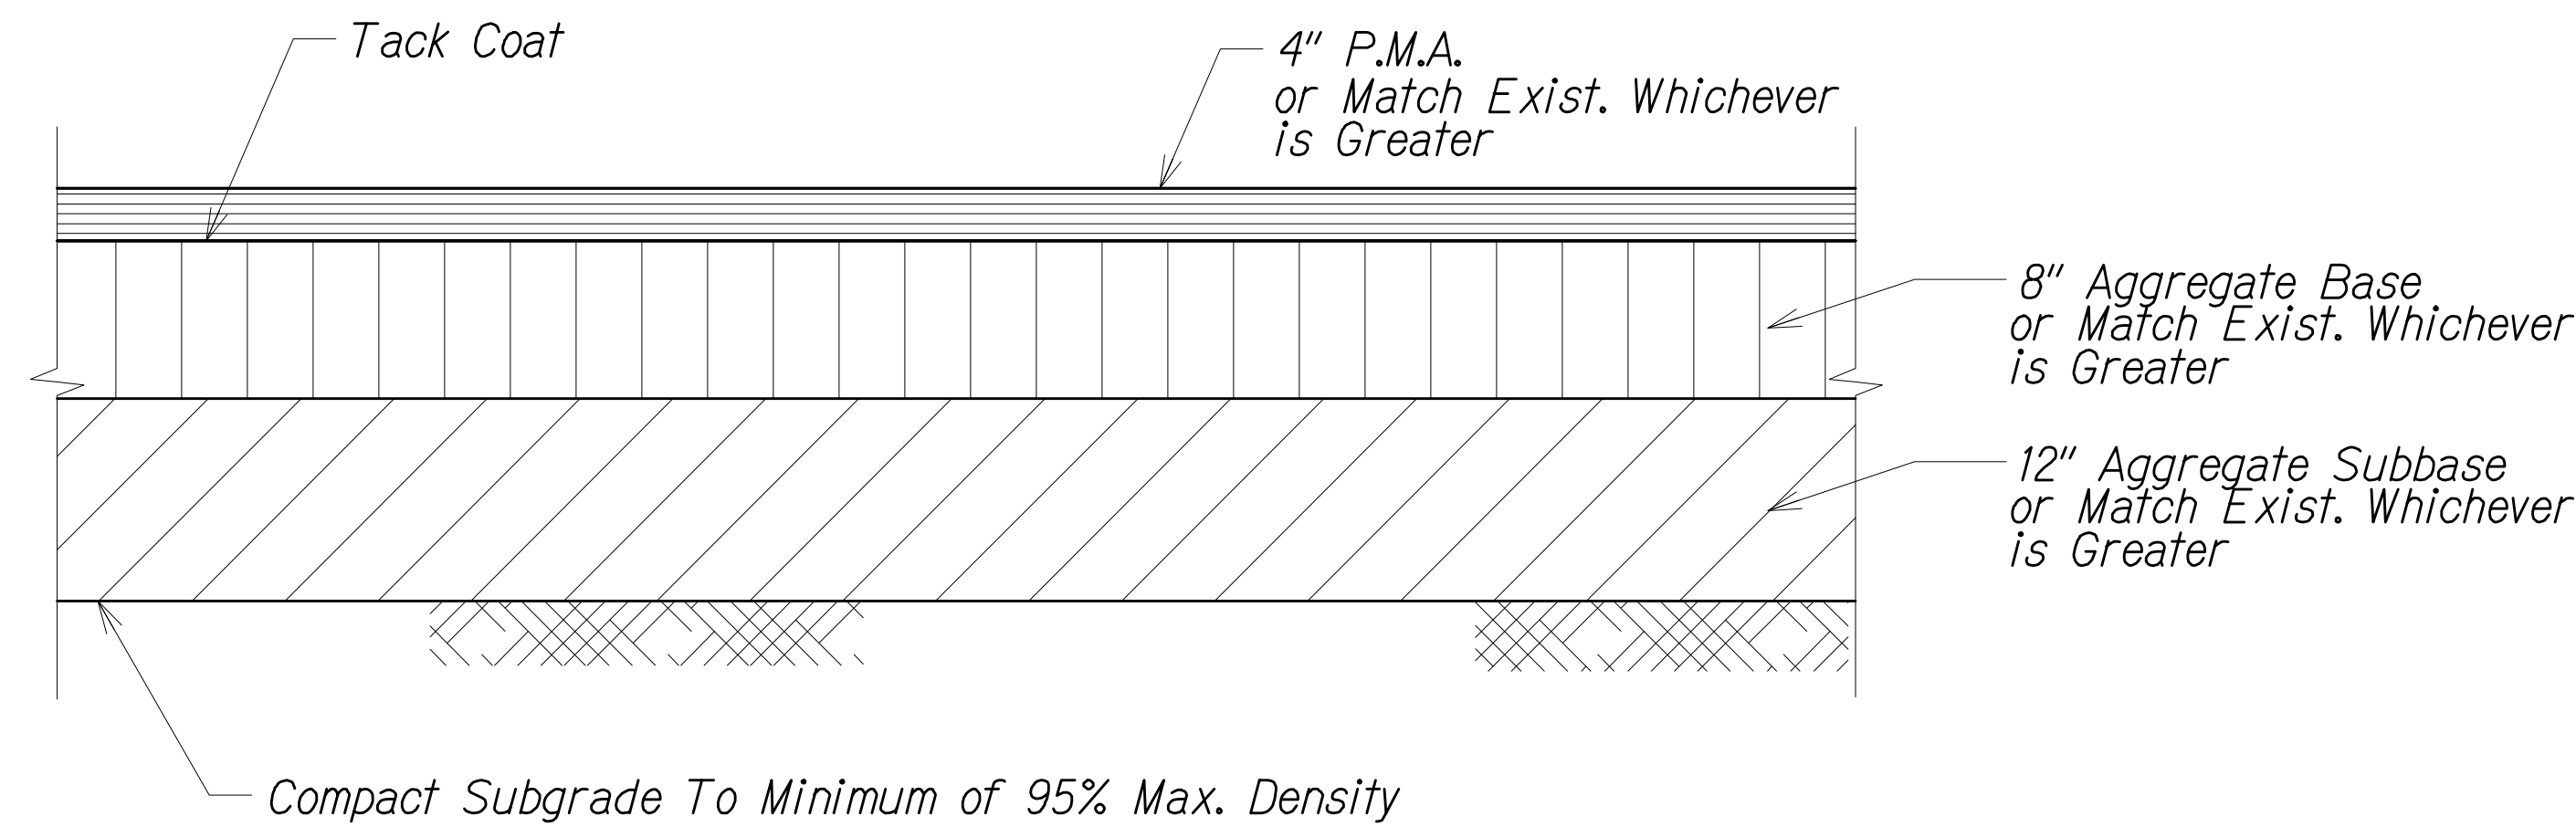


DIST. NO.	STATE	PROJ. NO.	FISCAL YEAR	SHEET NO.	TOTAL SHEETS
KAUAI	HAW.	50B-01-14R	2021	10	44

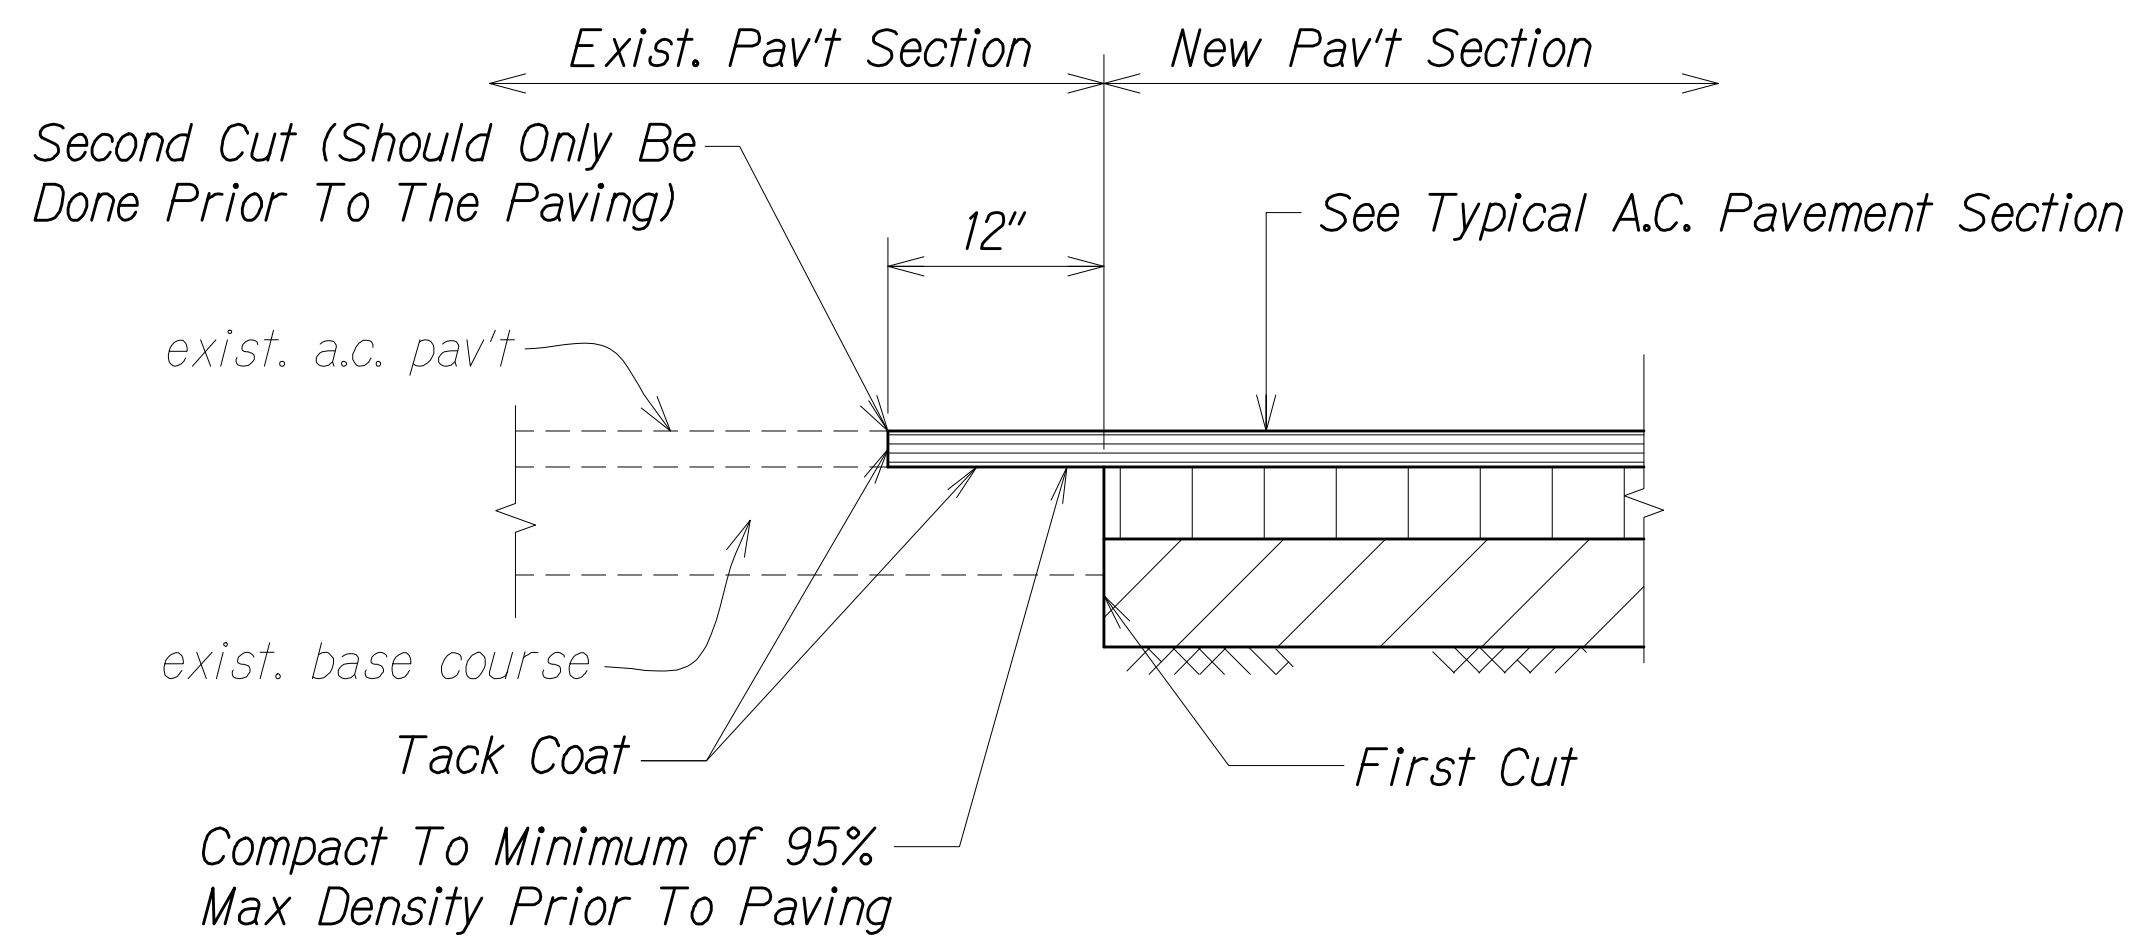

Note: Polymer Modified Asphalt (P.M.A.) Is Defined As Mix IV That Uses PG 64E-22 As A Binder.

SURVEY PLOTTED BY	DATE
DESIGNED BY	
TRACED BY	
DESIGNED BY	
QUANTITIES BY	
CHECKED BY	

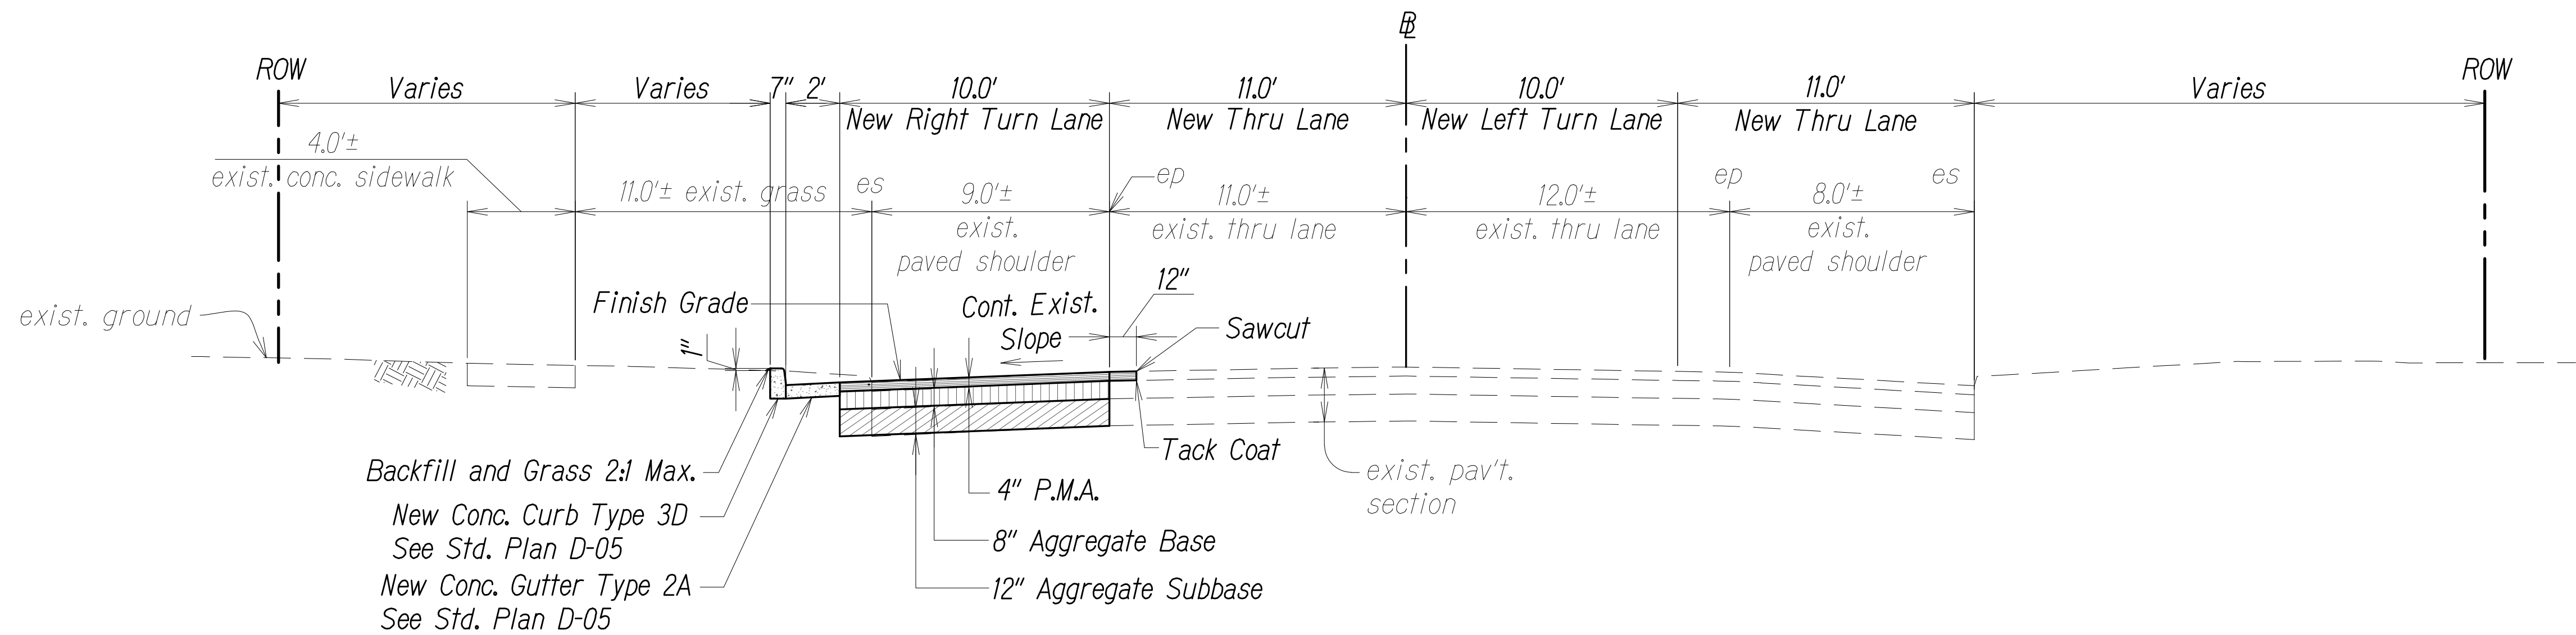

THIS WORK WAS PREPARED BY ME OR UNDER MY SUPERVISION.  
*Kyle Shinyama*  
APRIL 30, 2022  
LIC. EXP. DATE

STATE OF HAWAII  
DEPARTMENT OF TRANSPORTATION  
HIGHWAYS DIVISION

**TYPICAL ROADWAY SECTIONS**

*Kaumualii Highway Intersection  
Improvements at Waimea Canyon Drive  
Project No. 50B-01-14R*

Scale: As Shown      Date: Feb 2021

SHEET No. RS-1 OF 1 SHEETS