




**TYPICAL SECTION
STABILIZED SHOULDERS**
STA. 83+30 TO STA. 84+50
Scale: 1/4" = 1'-0"

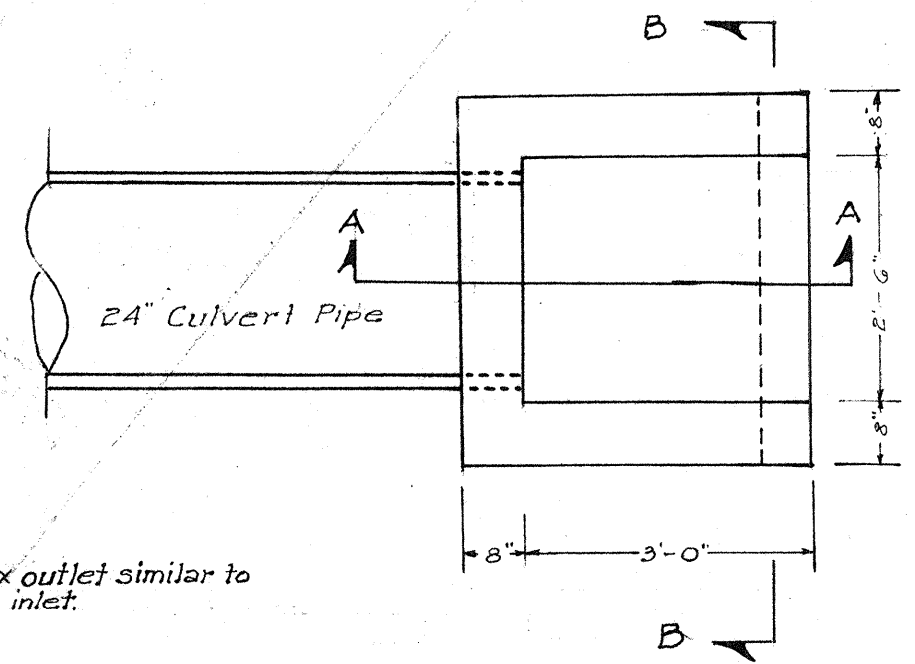

NOTE: Concrete box outlet similar to concrete box inlet.

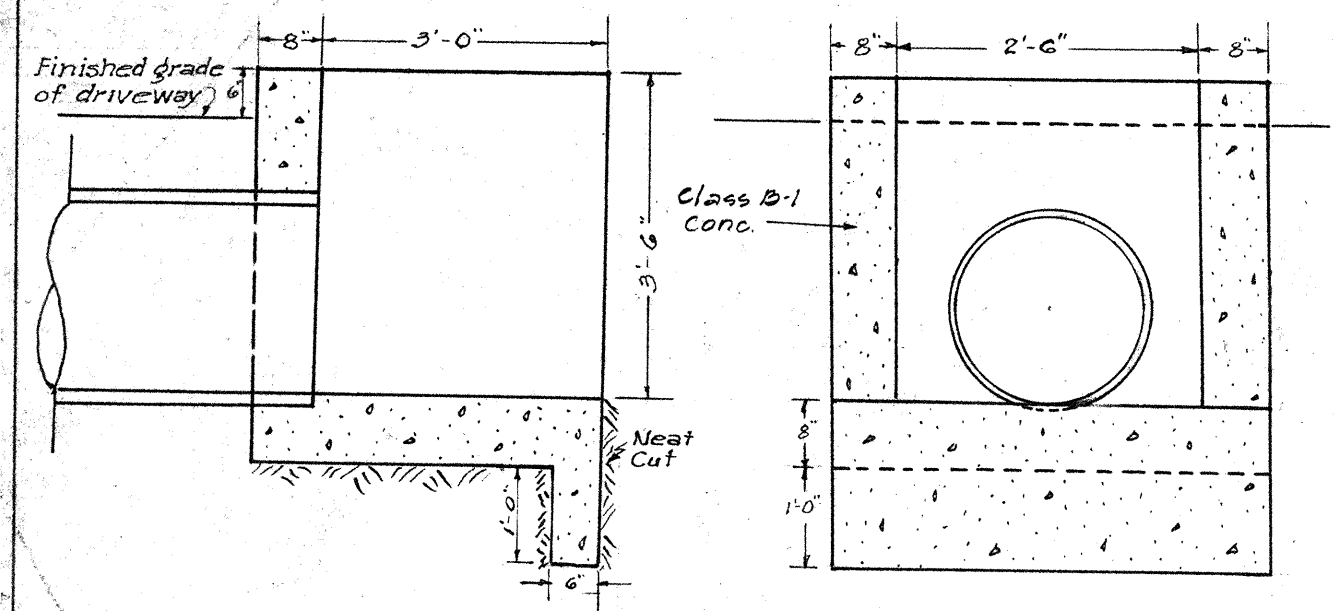

SECTION A-A
SECTION B-B
DETAILS OF CONCRETE BOX INLET
Scale: 1/2" = 1'-0"

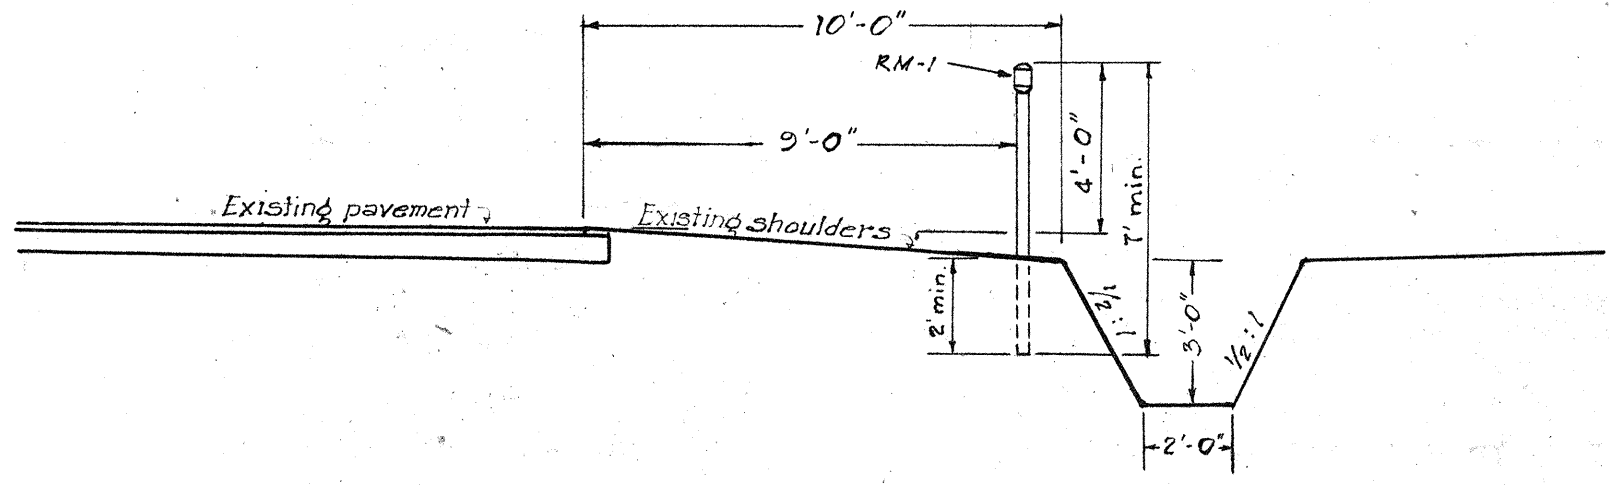

**TYPICAL SECTION
EARTH DRAINAGE DITCH**
Scale: 1/4" = 1'-0"

DEPARTMENT OF TRANSPORTATION
HIGHWAYS DIVISION
STATE OF HAWAII
DETAILS OF
CONCRETE BOX INLET
AND
TYPICAL SECTIONS OF
DRAIN DITCH AND STABILIZED SHOULDERS
IMPROVEMENT OF DRAINAGE SYSTEM
AT OMAO, KAUAI
SCALE: As Shown