



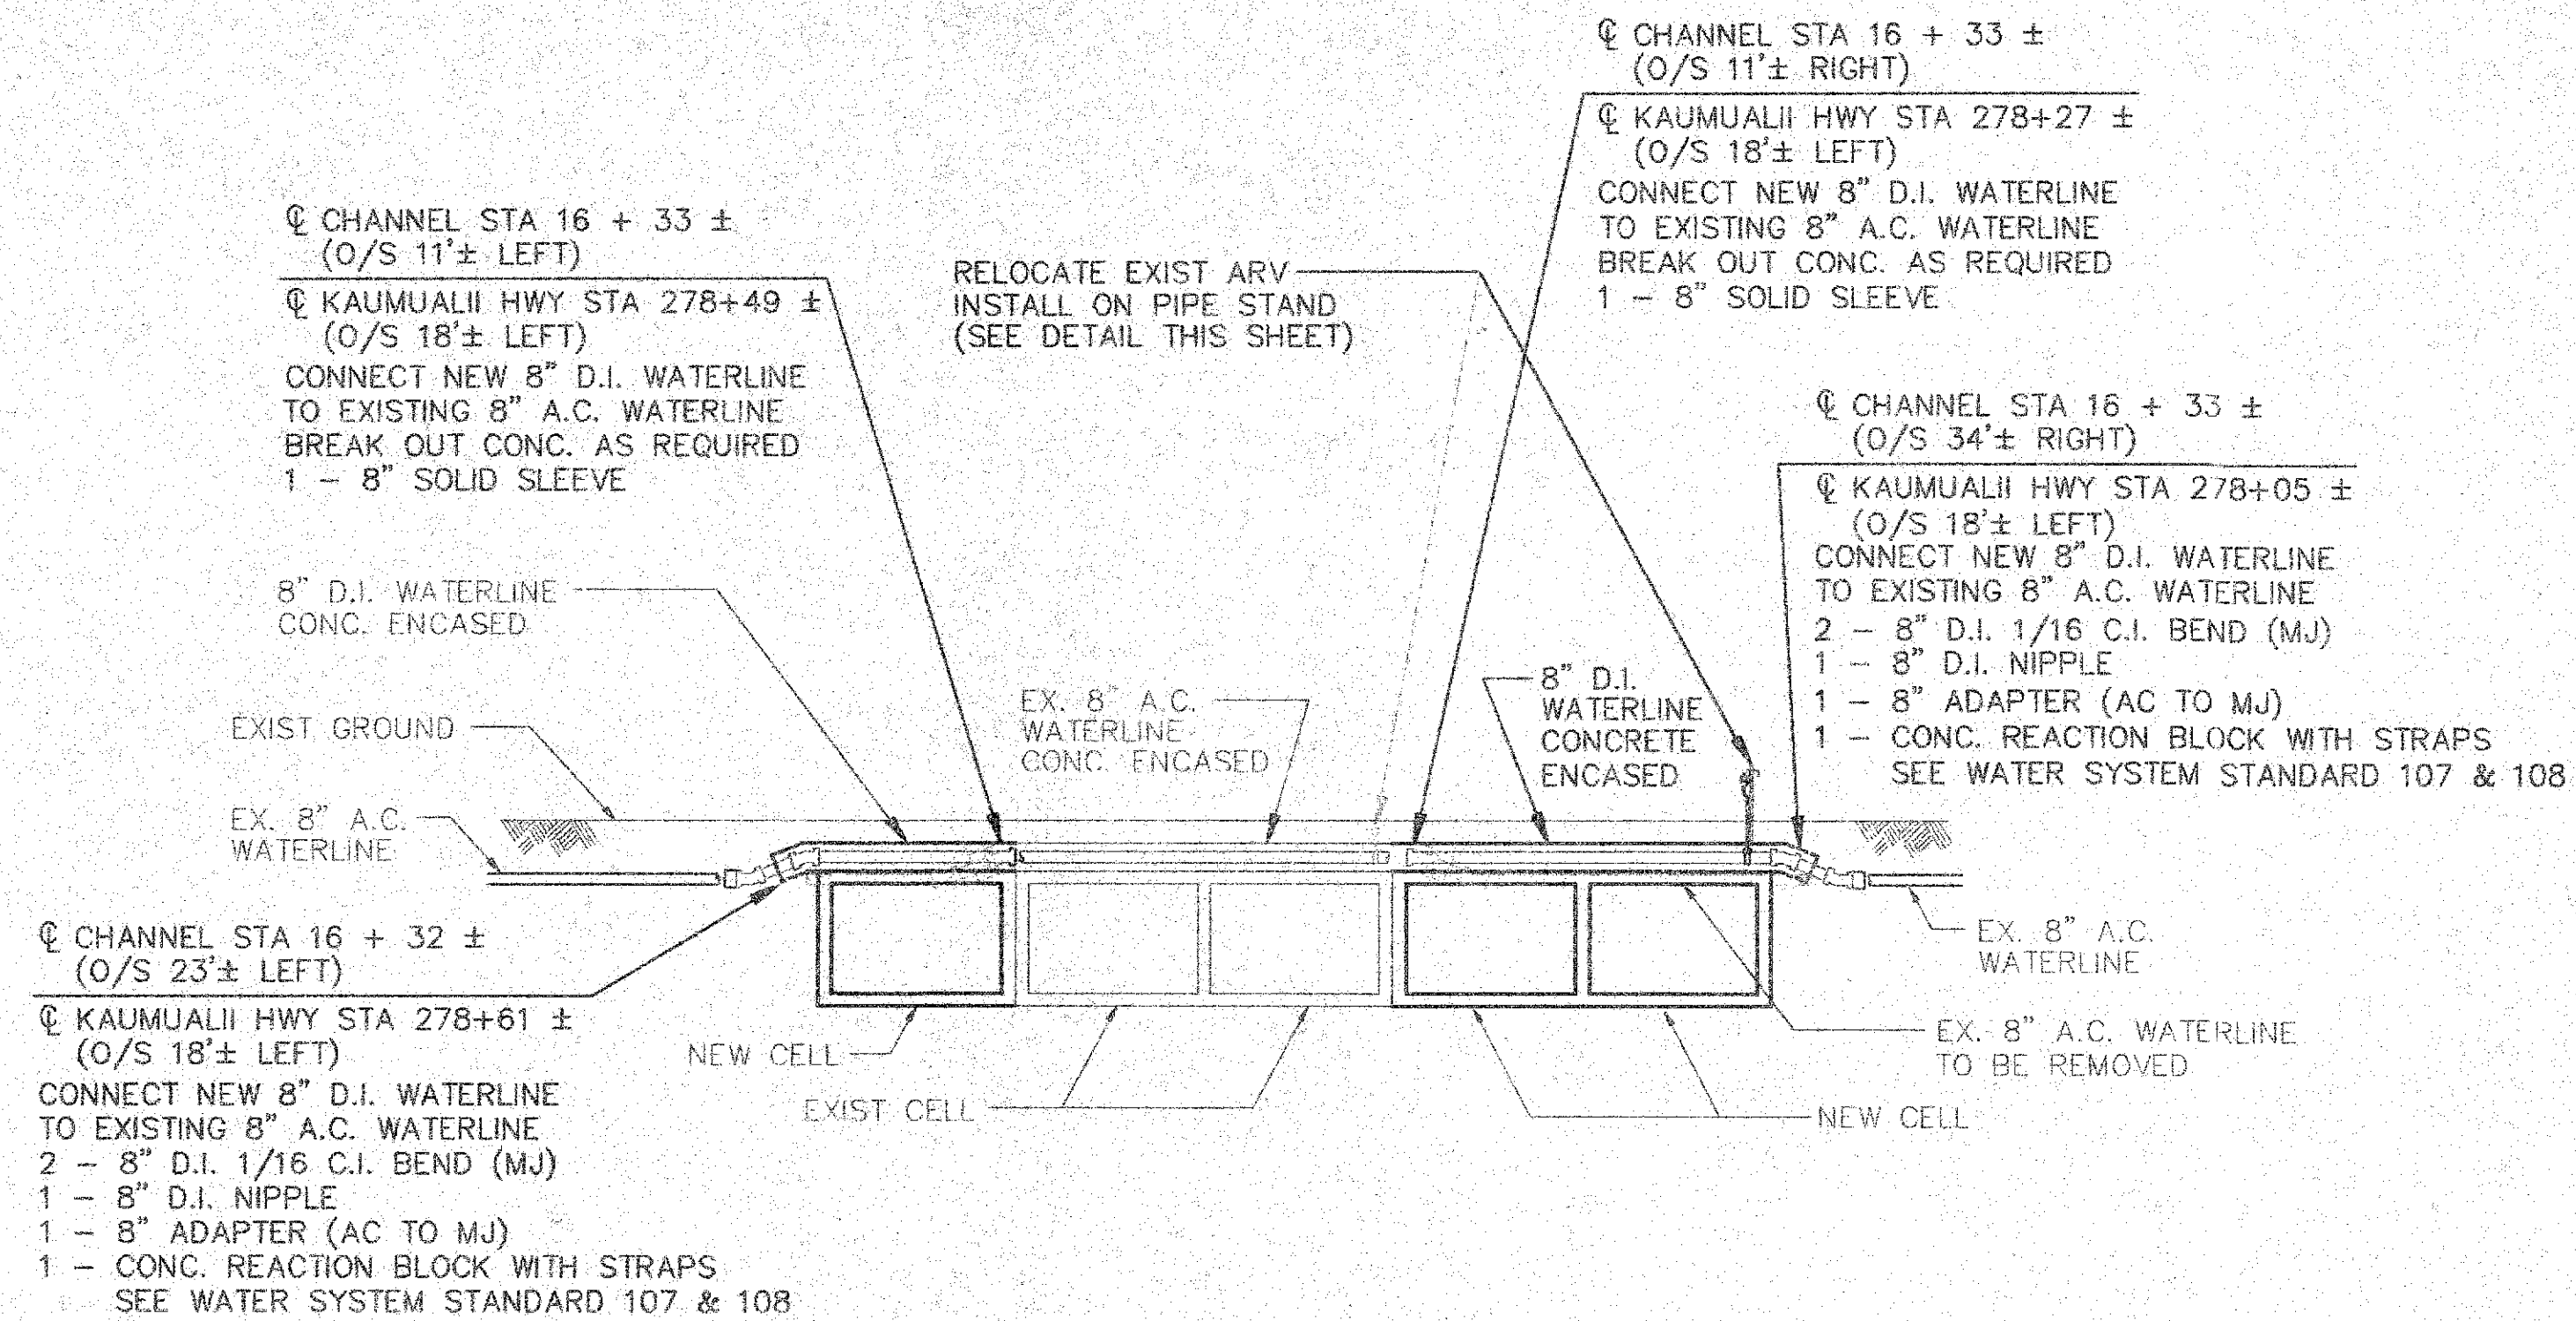

8" D.I. WATERLINE RELOCATION ELEVATION AT CENTERLINE OF WATERLINE


SCALE: 1" = 10'

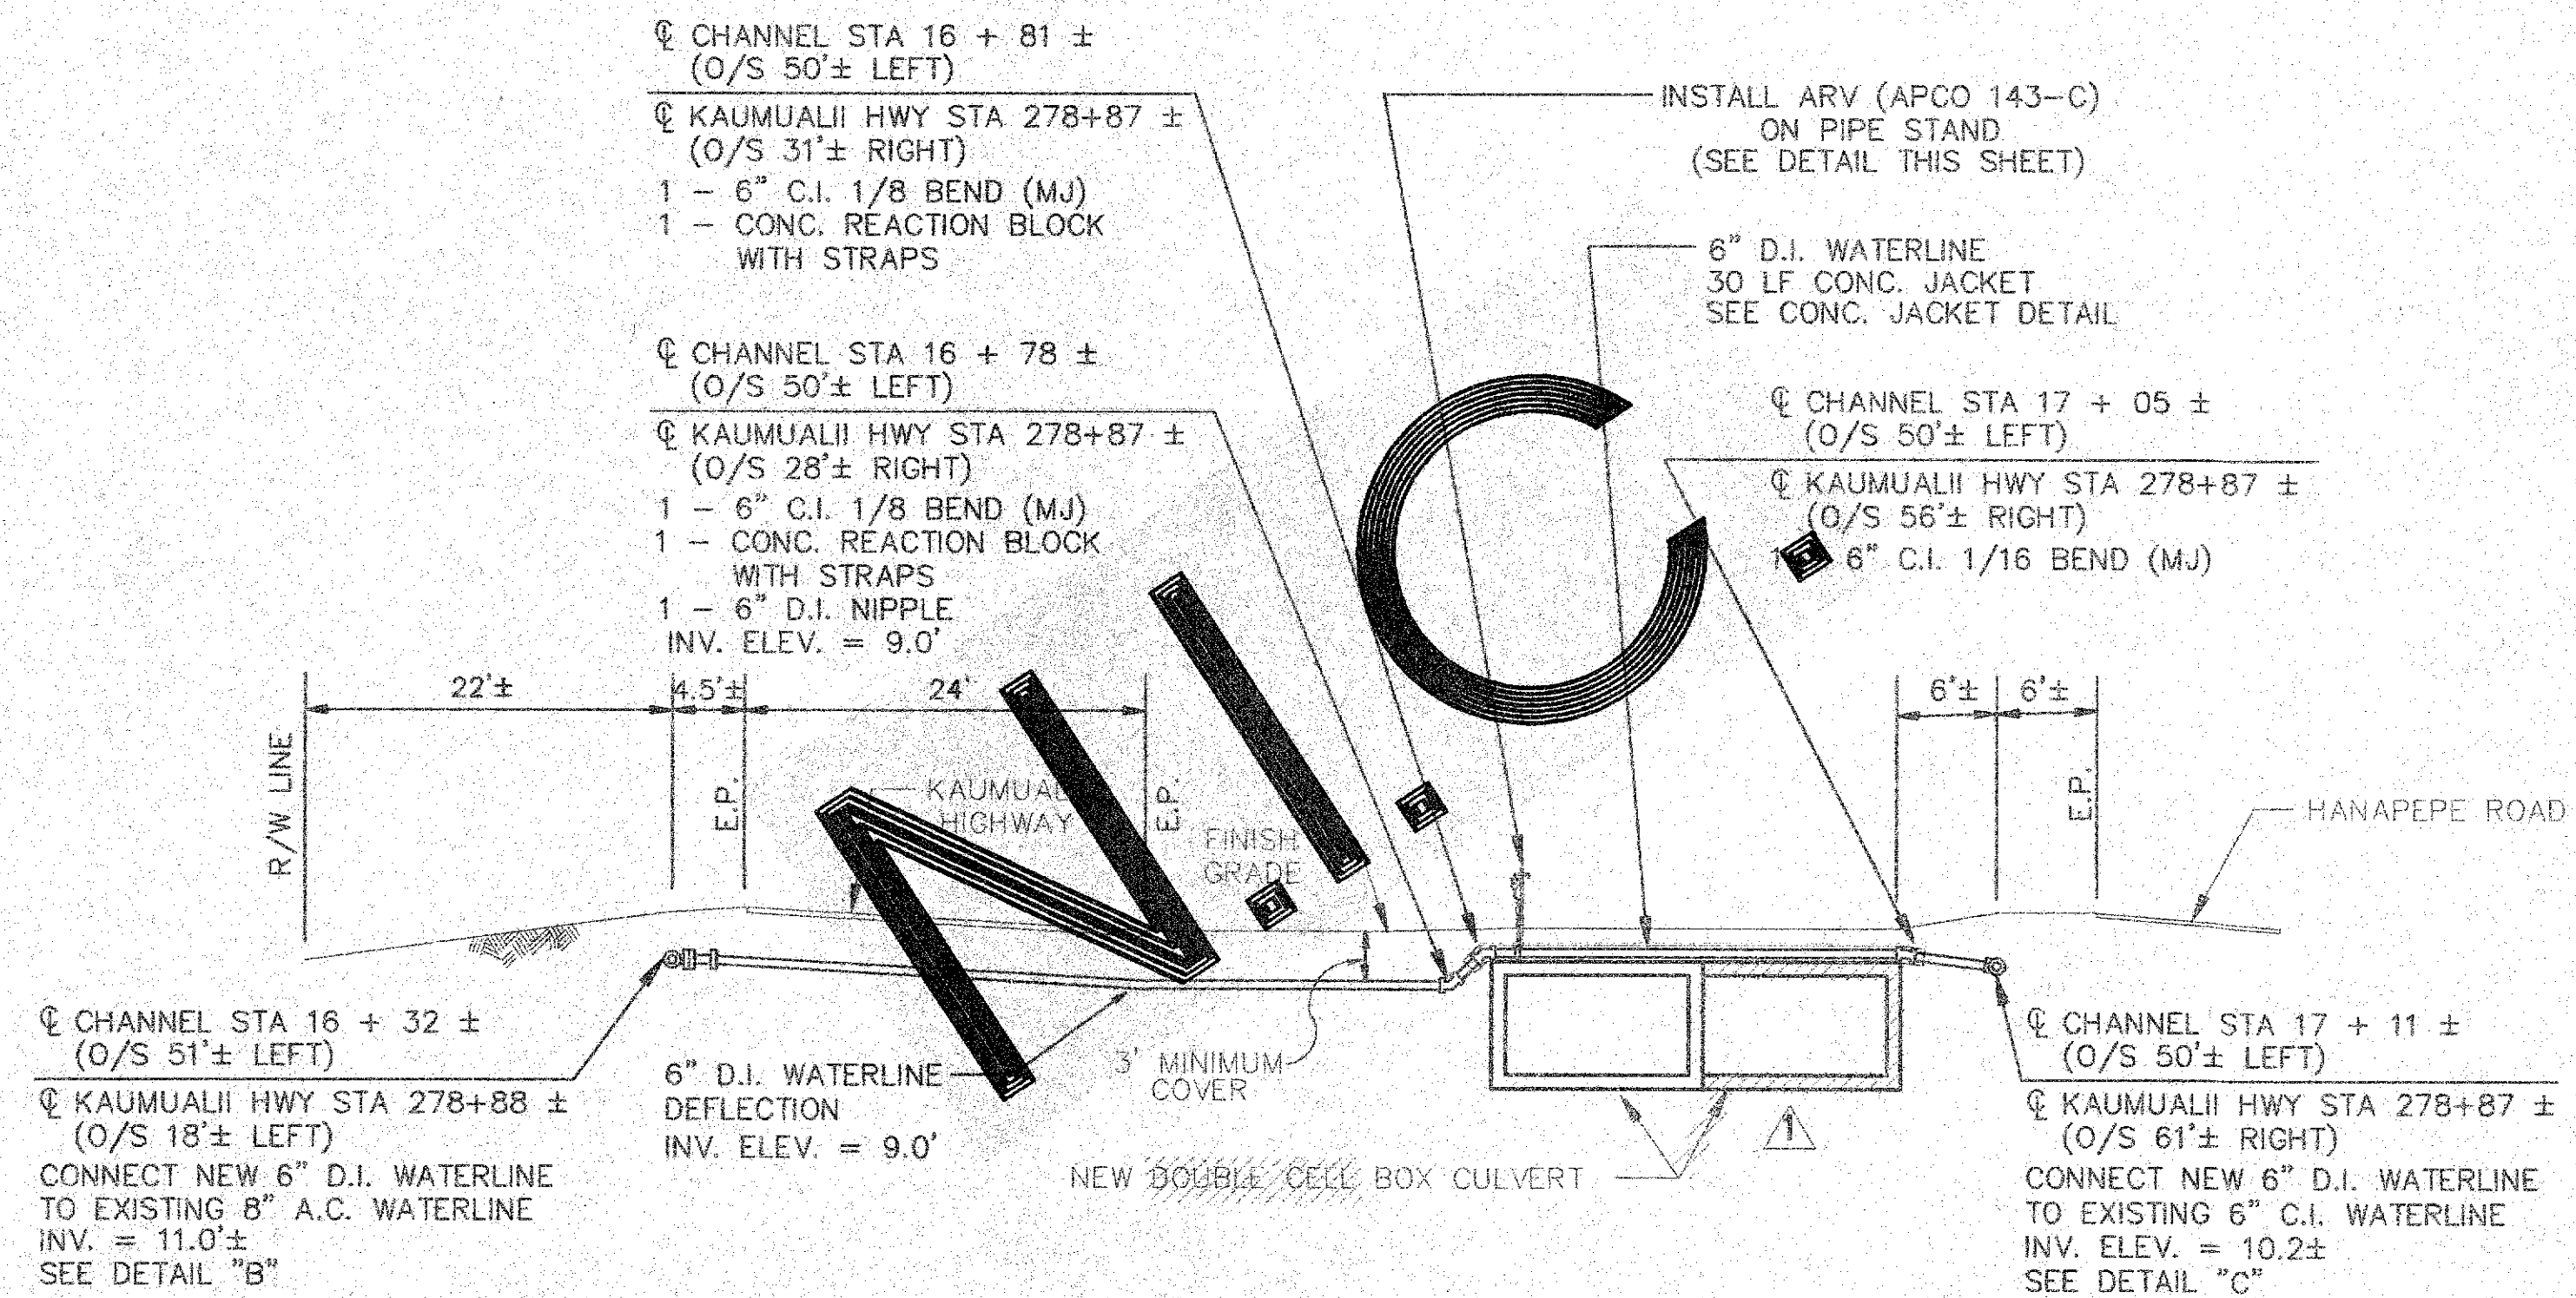


6" D.I. WATERLINE RELOCATION ELEVATION AT CENTERLINE OF WATERLINE

SCALE: 1" = 10'


** NOTE: ALL FITTINGS SHALL HAVE RETAINER GLANDS.

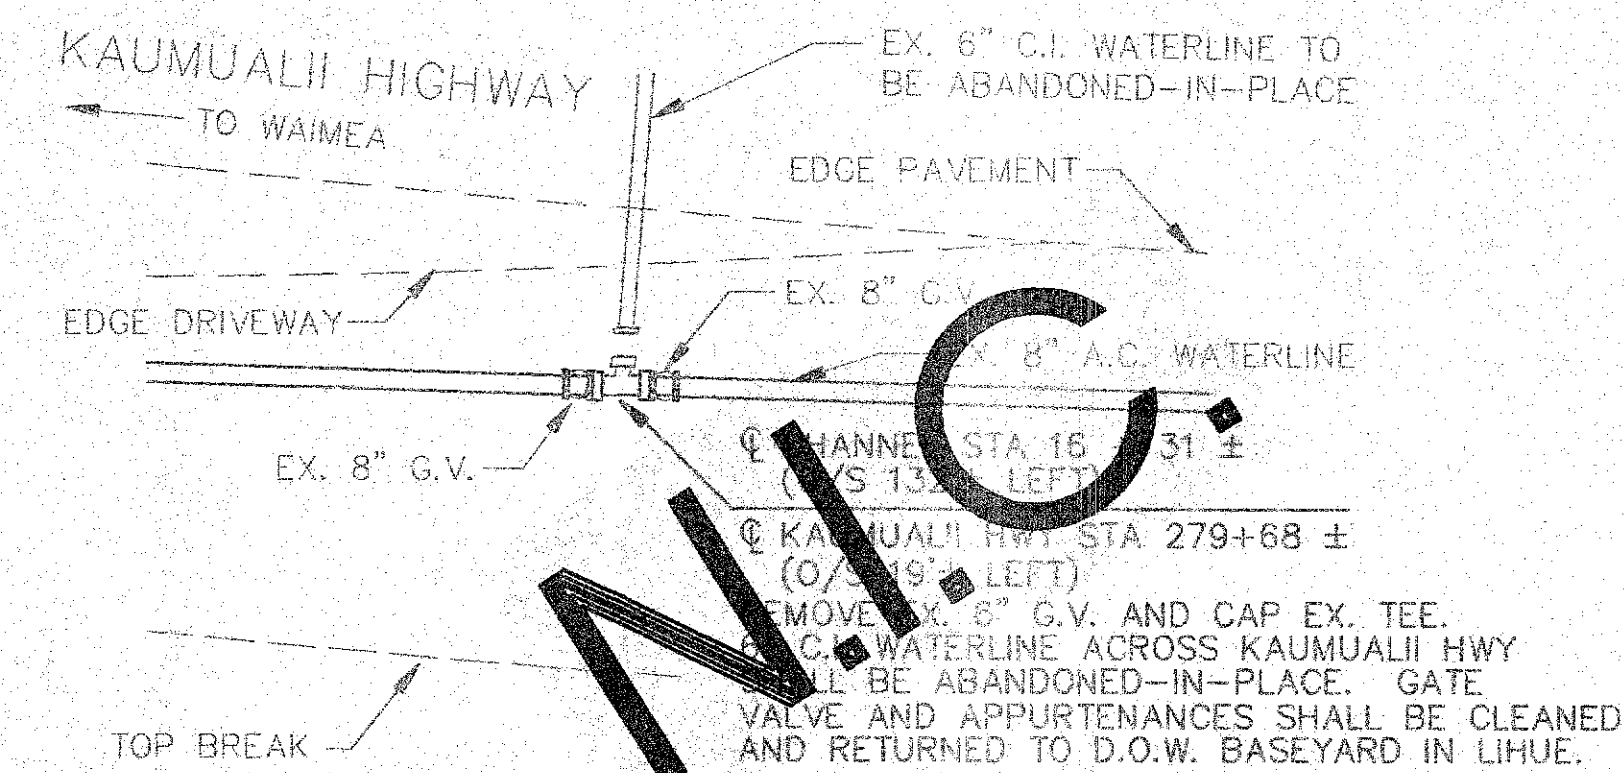

DETAIL "A"
N.T.S.

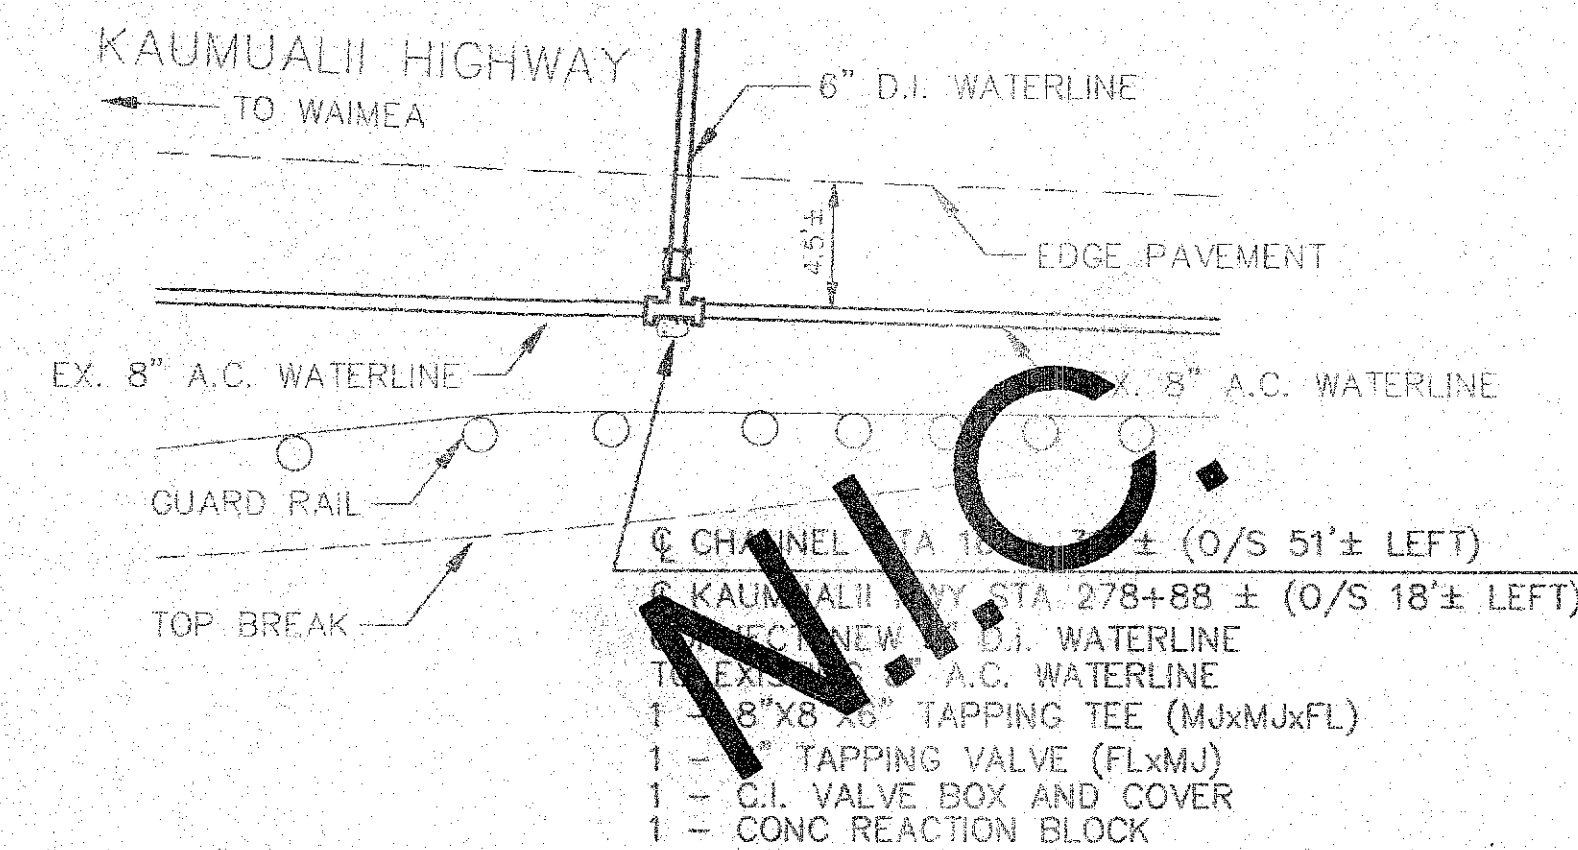


DETAIL "B"
N.T.S.

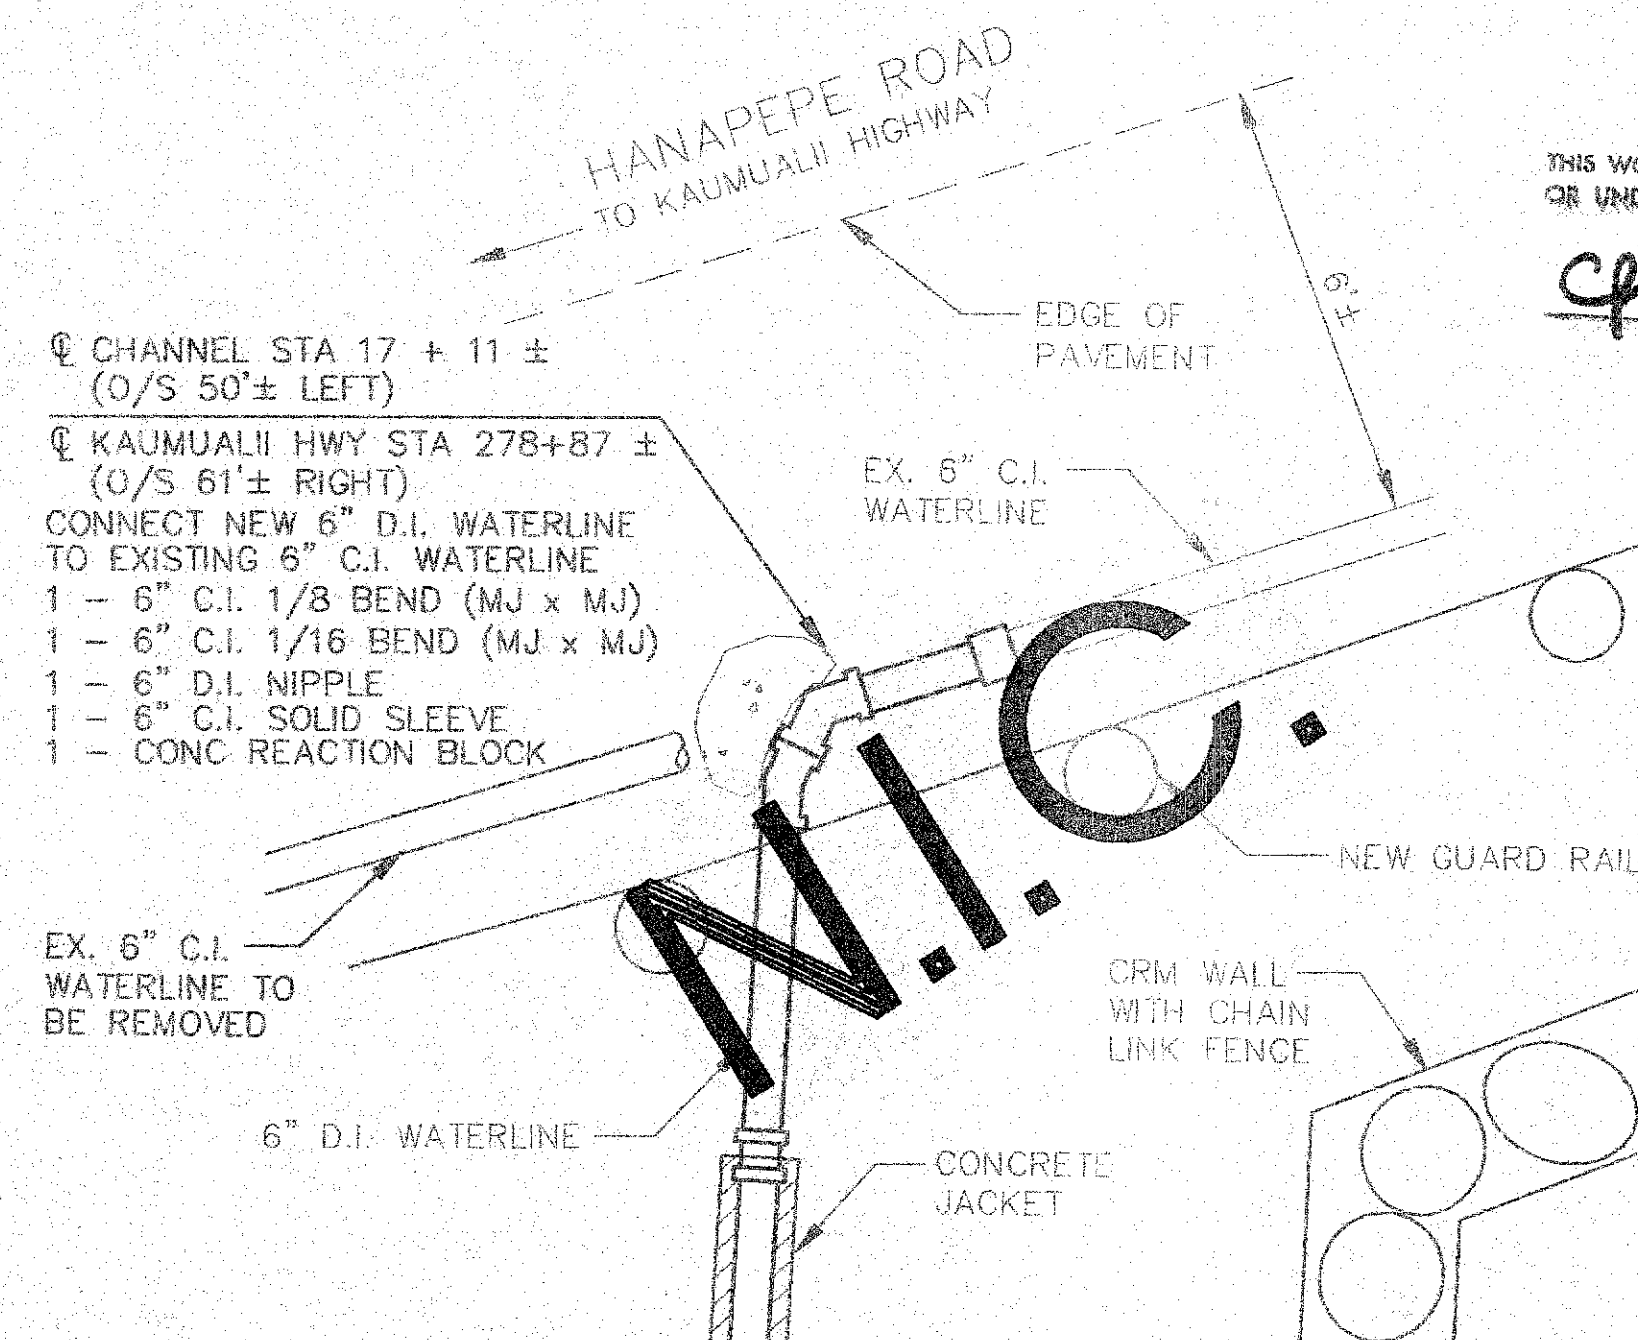


DETAIL "C"
N.T.S.


NOTE: ALL METALS TO BE PAINTED WITH TWO COATS OF ZRC AND ONE FINISHED COAT OF REFLECTIVE YELLOW COLORED PAINT.

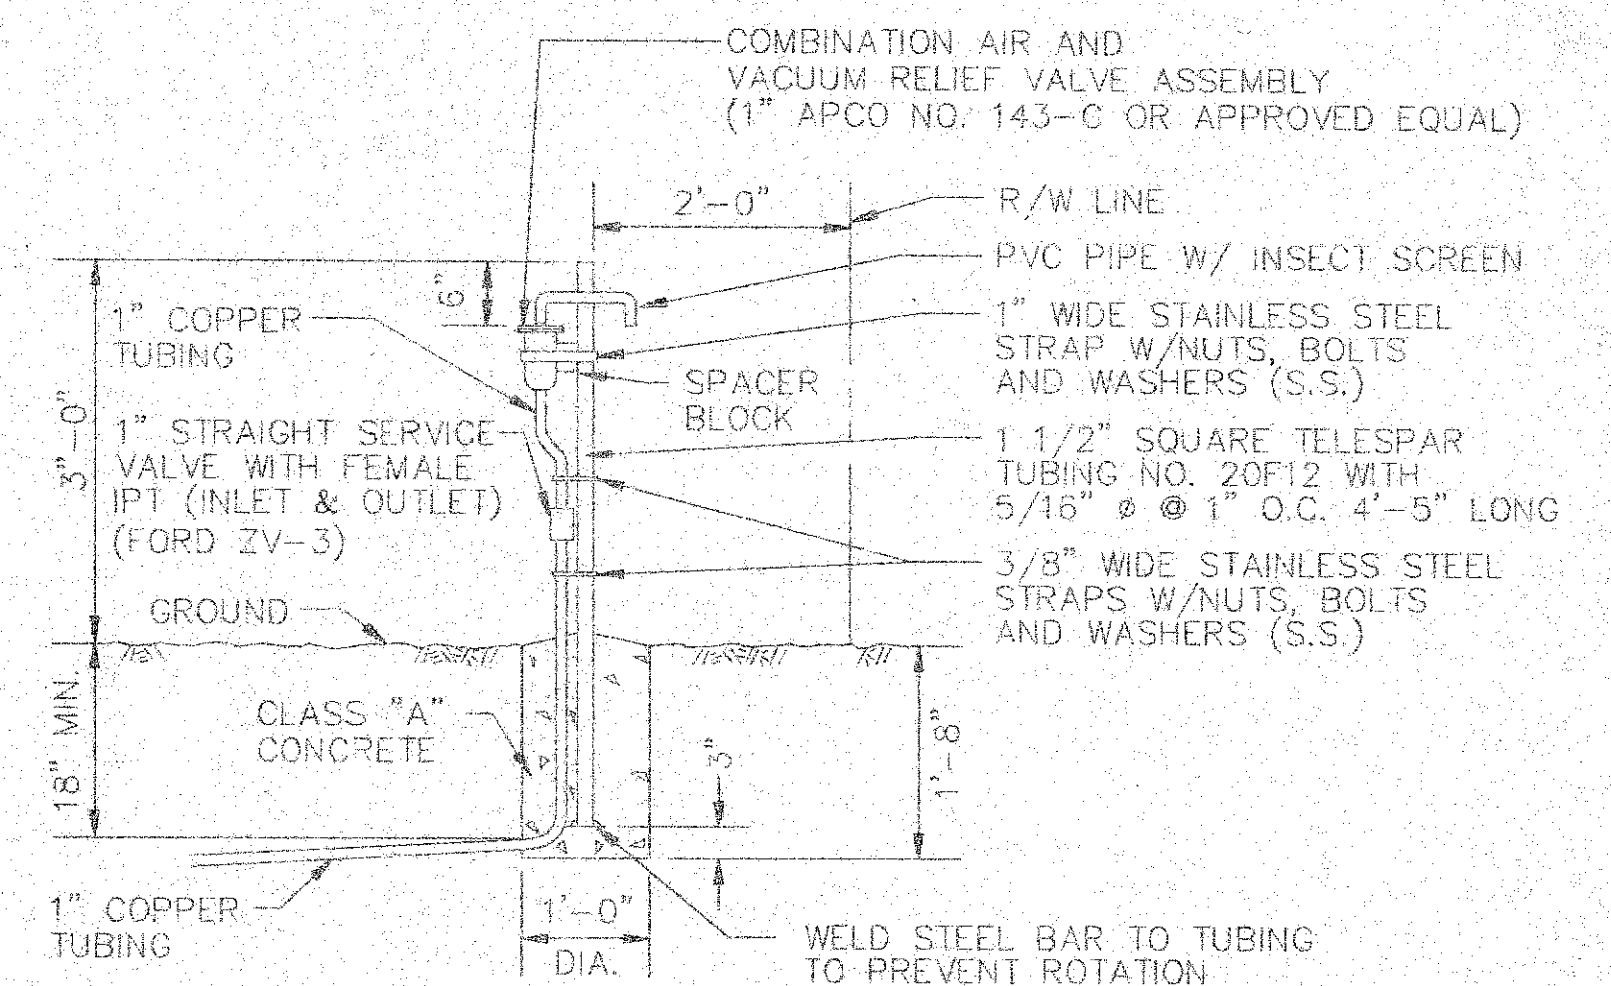

PIPE STAND DETAIL
N.T.S.

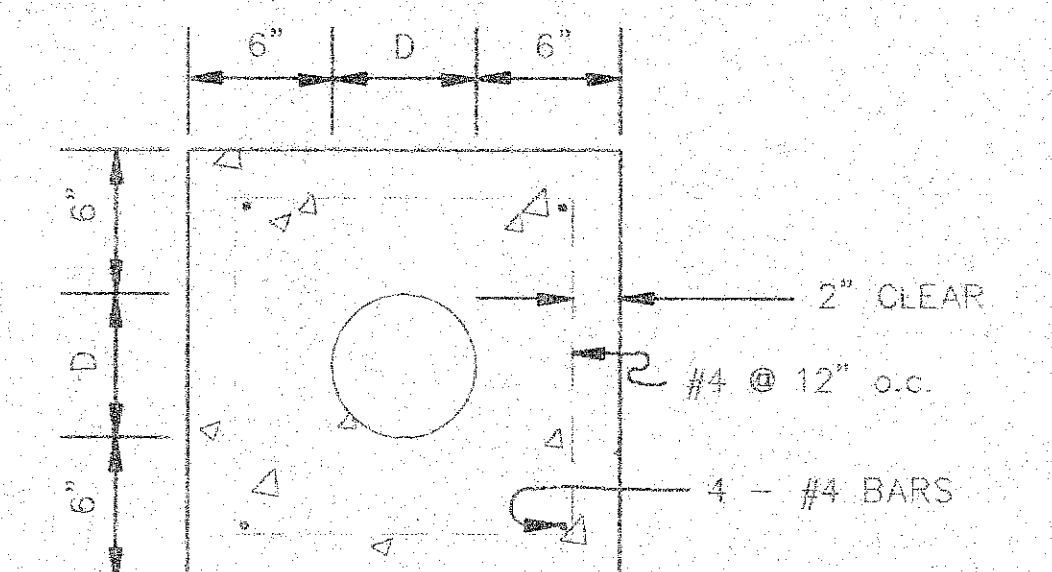

CONCRETE JACKET DETAIL
N.T.S.

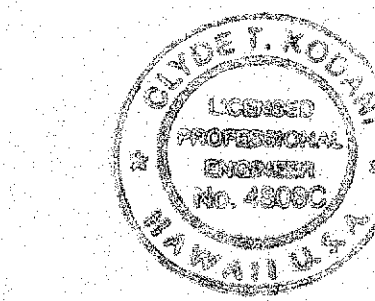

THIS WORK WAS PREPARED BY ME OR UNDER MY SUPERVISION
 Signature
 Date

APPROVALS

Signature
 MANAGER AND CHIEF ENGINEER, DEPT. OF WATER
 COUNTY OF KAUAI
 8/17/94
 DATE

REVISION	DATE	DESCRIPTION	BY	APPROVED
STATE OF HAWAII HOUSING FINANCE AND DEVELOPMENT CORPORATION HANAPEPE DRAINAGE IMPROVEMENT PROJECT WATERLINE ELEVATIONS AND DETAILS KODANI AND ASSOCIATES, INC. LIHUE, KAUAI, HAWAII 96766				
DESIGNED BY:	DRAWN BY:	CHECKED BY:	SHEET 10 OF 10 SHEETS	