



AS-BUILT DRAWINGS



Note: Work was constructed as designed unless otherwise noted.

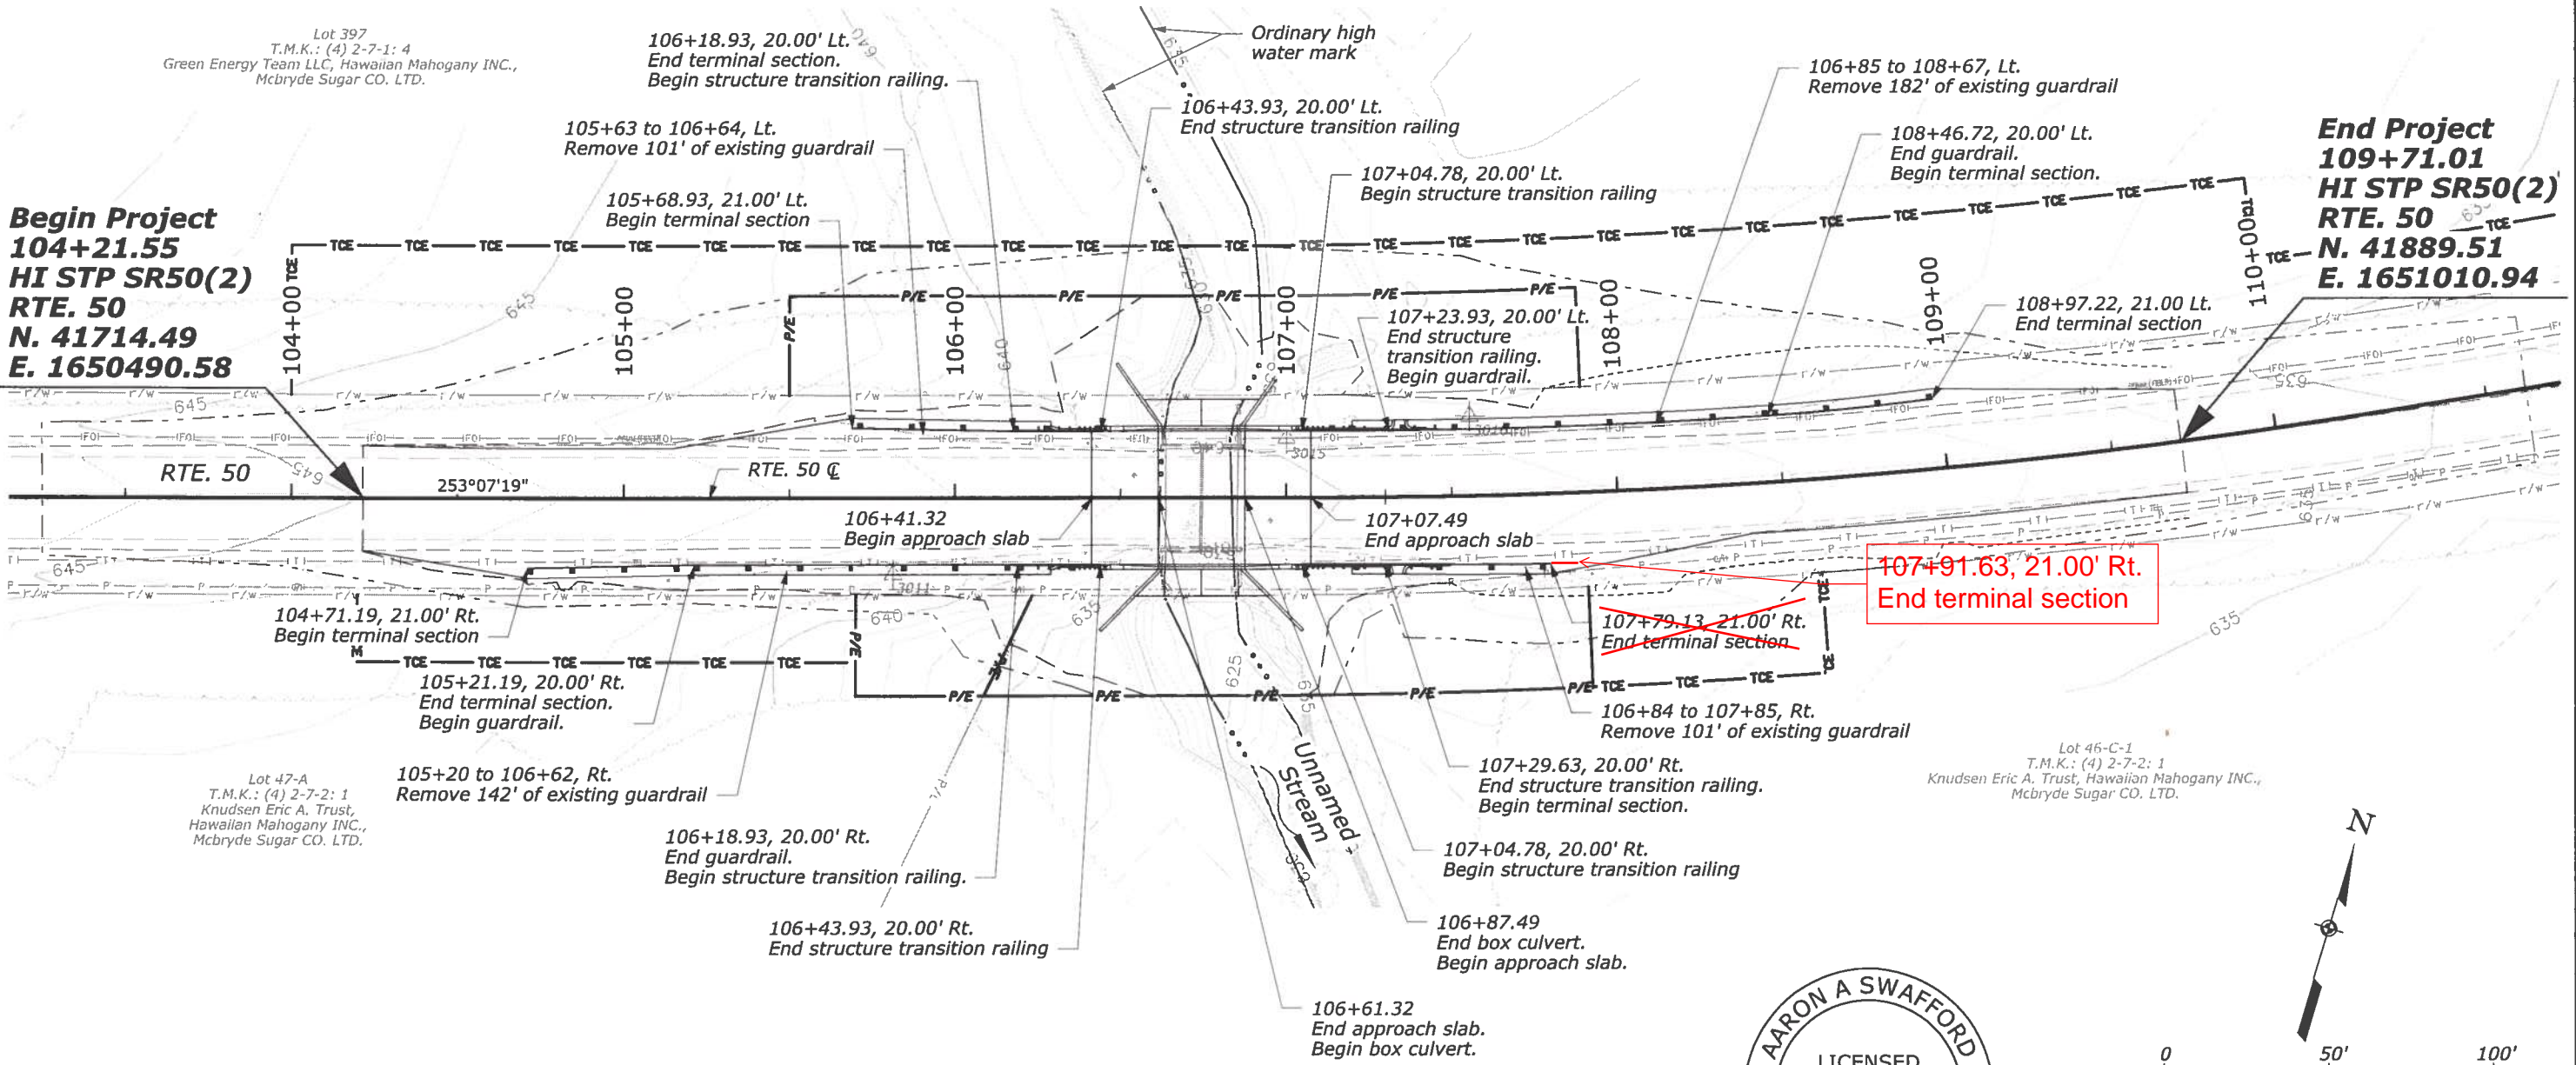

THIS WORK WAS PREPARED BY ME OR UNDER MY SUPERVISION.
Signature: [Signature] Expiration Date of the License: 4/30/18

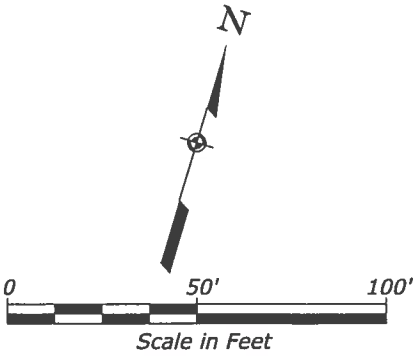

U.S. DEPARTMENT OF TRANSPORTATION
FEDERAL HIGHWAY ADMINISTRATION
CENTRAL FEDERAL LANDS HIGHWAY DIVISION

U.S. CUSTOMARY

GUARDRAIL PLAN