


| STATE | PROJECT        | SHEET NO. |
|-------|----------------|-----------|
| HI    | HI STP SR50(2) | D1        |


# AS-BUILT DRAWINGS

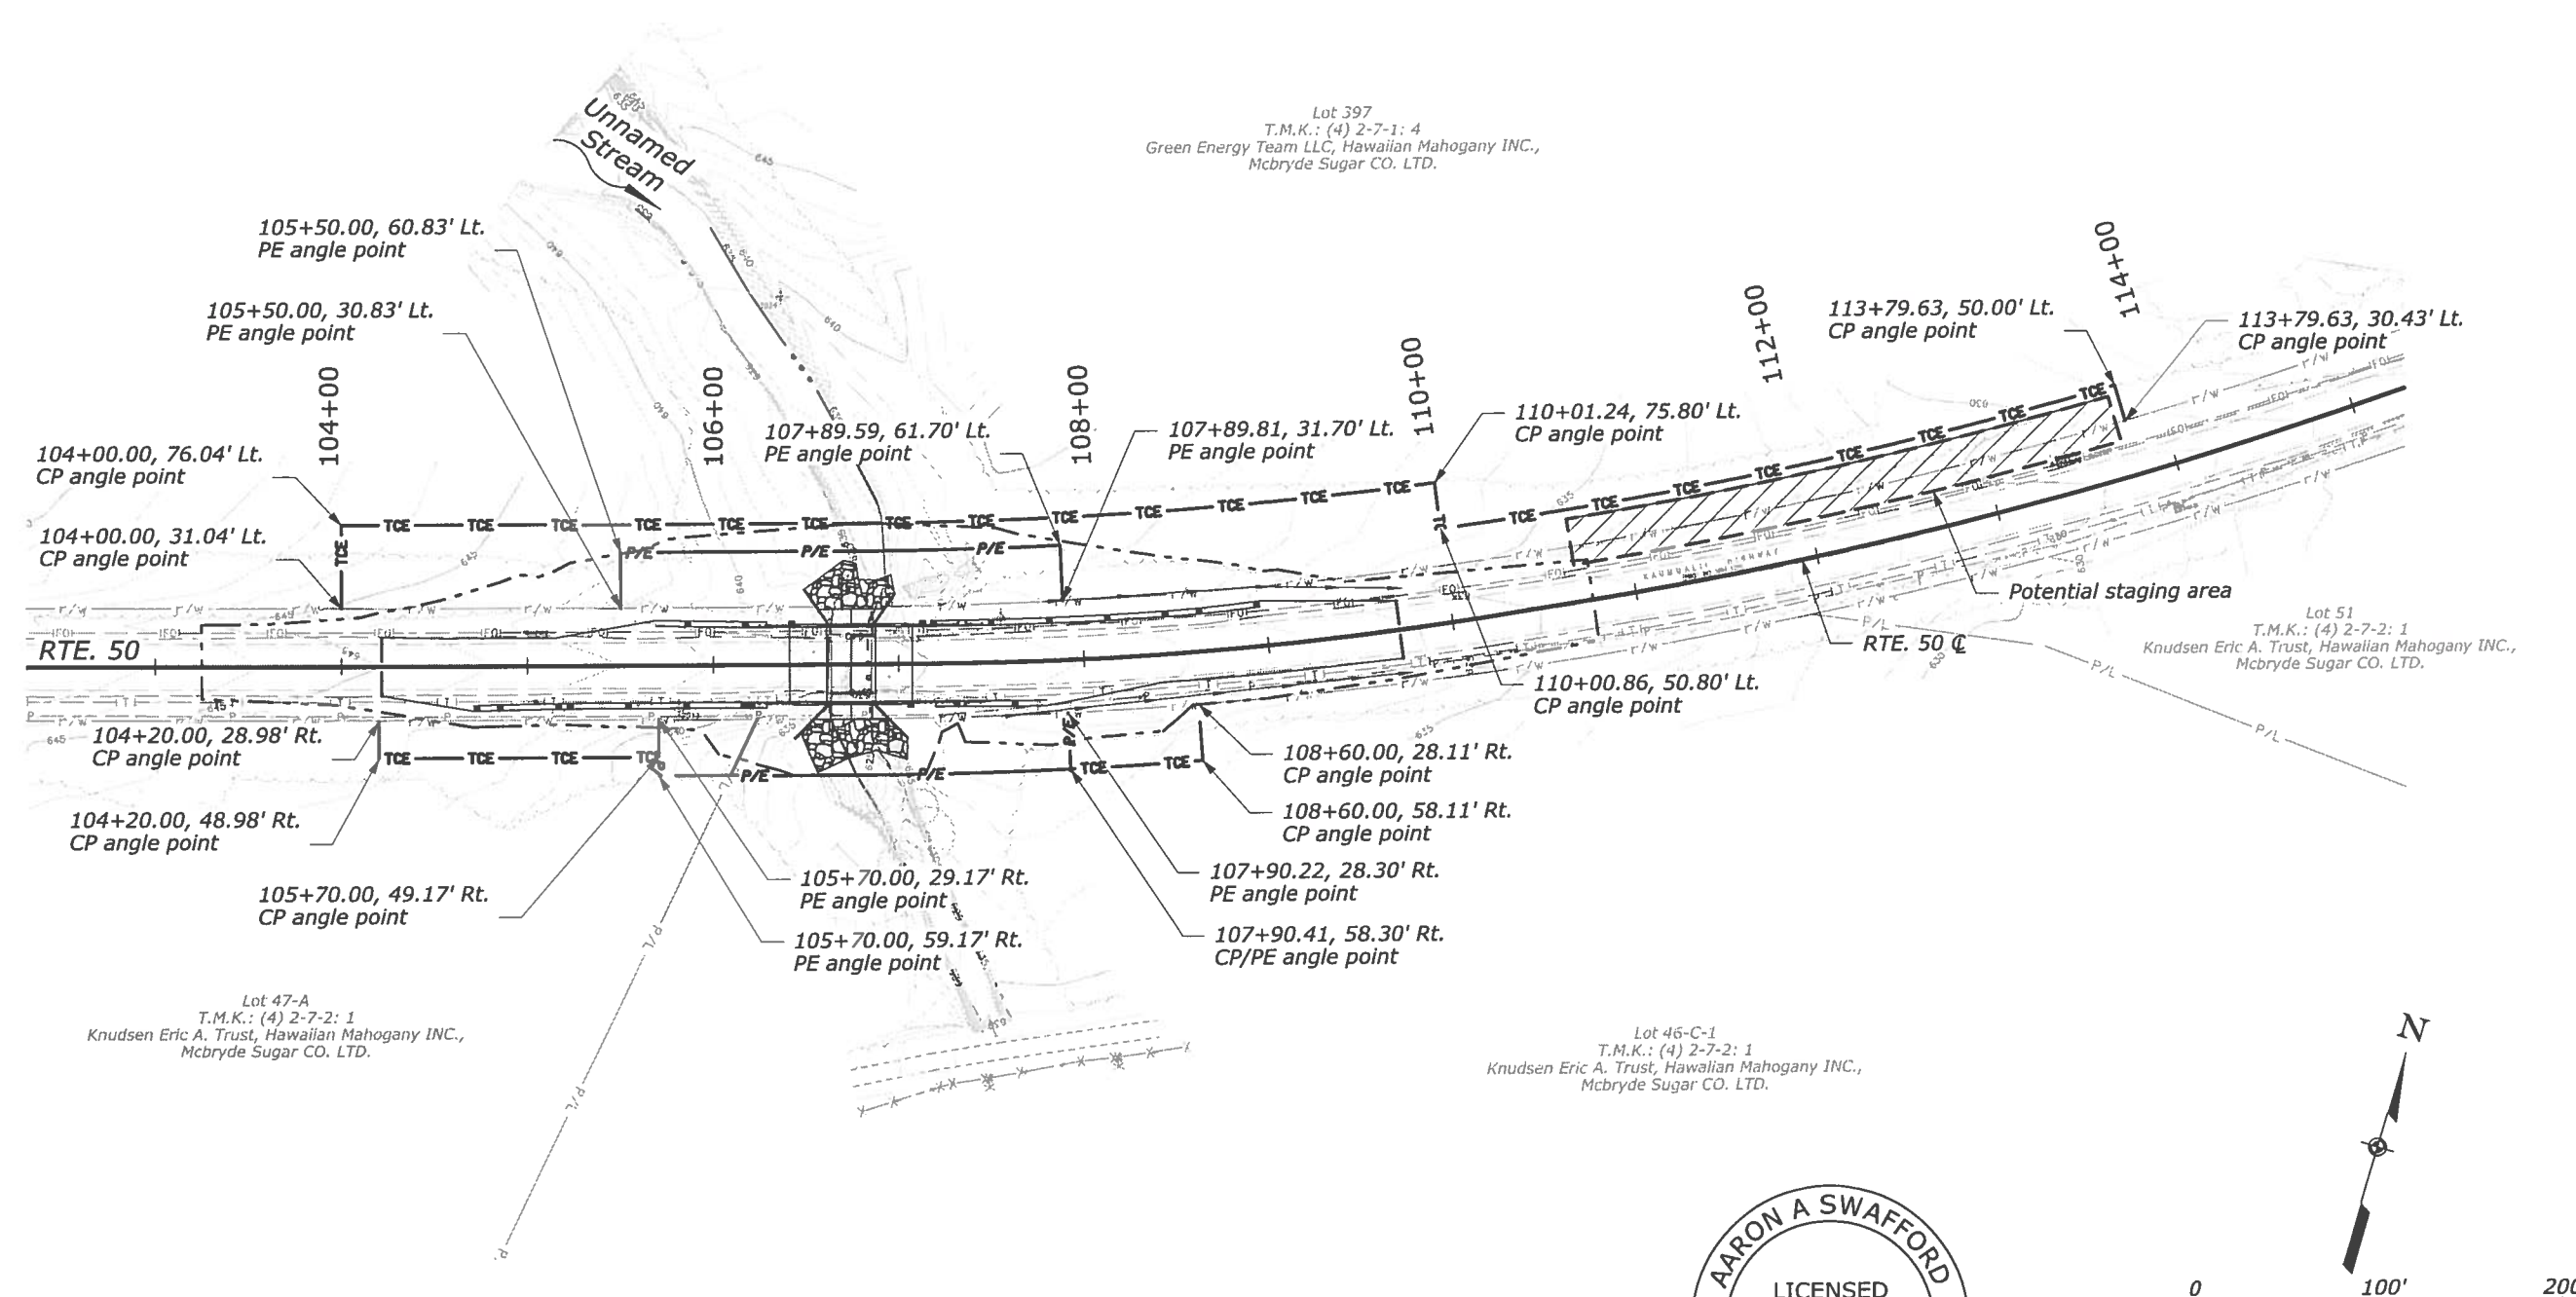

Note: Work was constructed as designed unless otherwise noted.



THIS WORK WAS PREPARED BY ME OR UNDER MY SUPERVISION.  
*[Signature]* 4/30/18  
Signature Expiration Date of the License

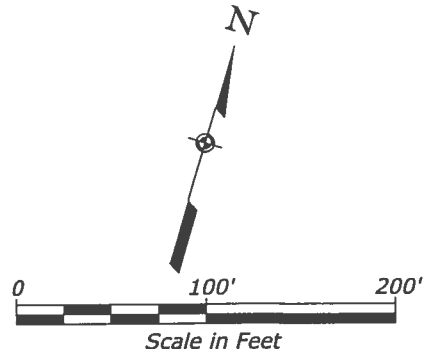

U.S. DEPARTMENT OF TRANSPORTATION  
FEDERAL HIGHWAY ADMINISTRATION  
CENTRAL FEDERAL LANDS HIGHWAY DIVISION

U.S. CUSTOMARY

**RIGHT-OF-WAY AND STAGING AREA PLAN**

6/15/2016 10:35:57 AM \\denrwp01\pwwcsjobs596\197927\205307\_1\DO1\_pln7E-01.dgn \_User: DENRWP01\$