


| STATE | PROJECT        | SHEET NO. |
|-------|----------------|-----------|
| HI    | HI STP SR50(2) | A5        |

# AS-BUILT DRAWINGS

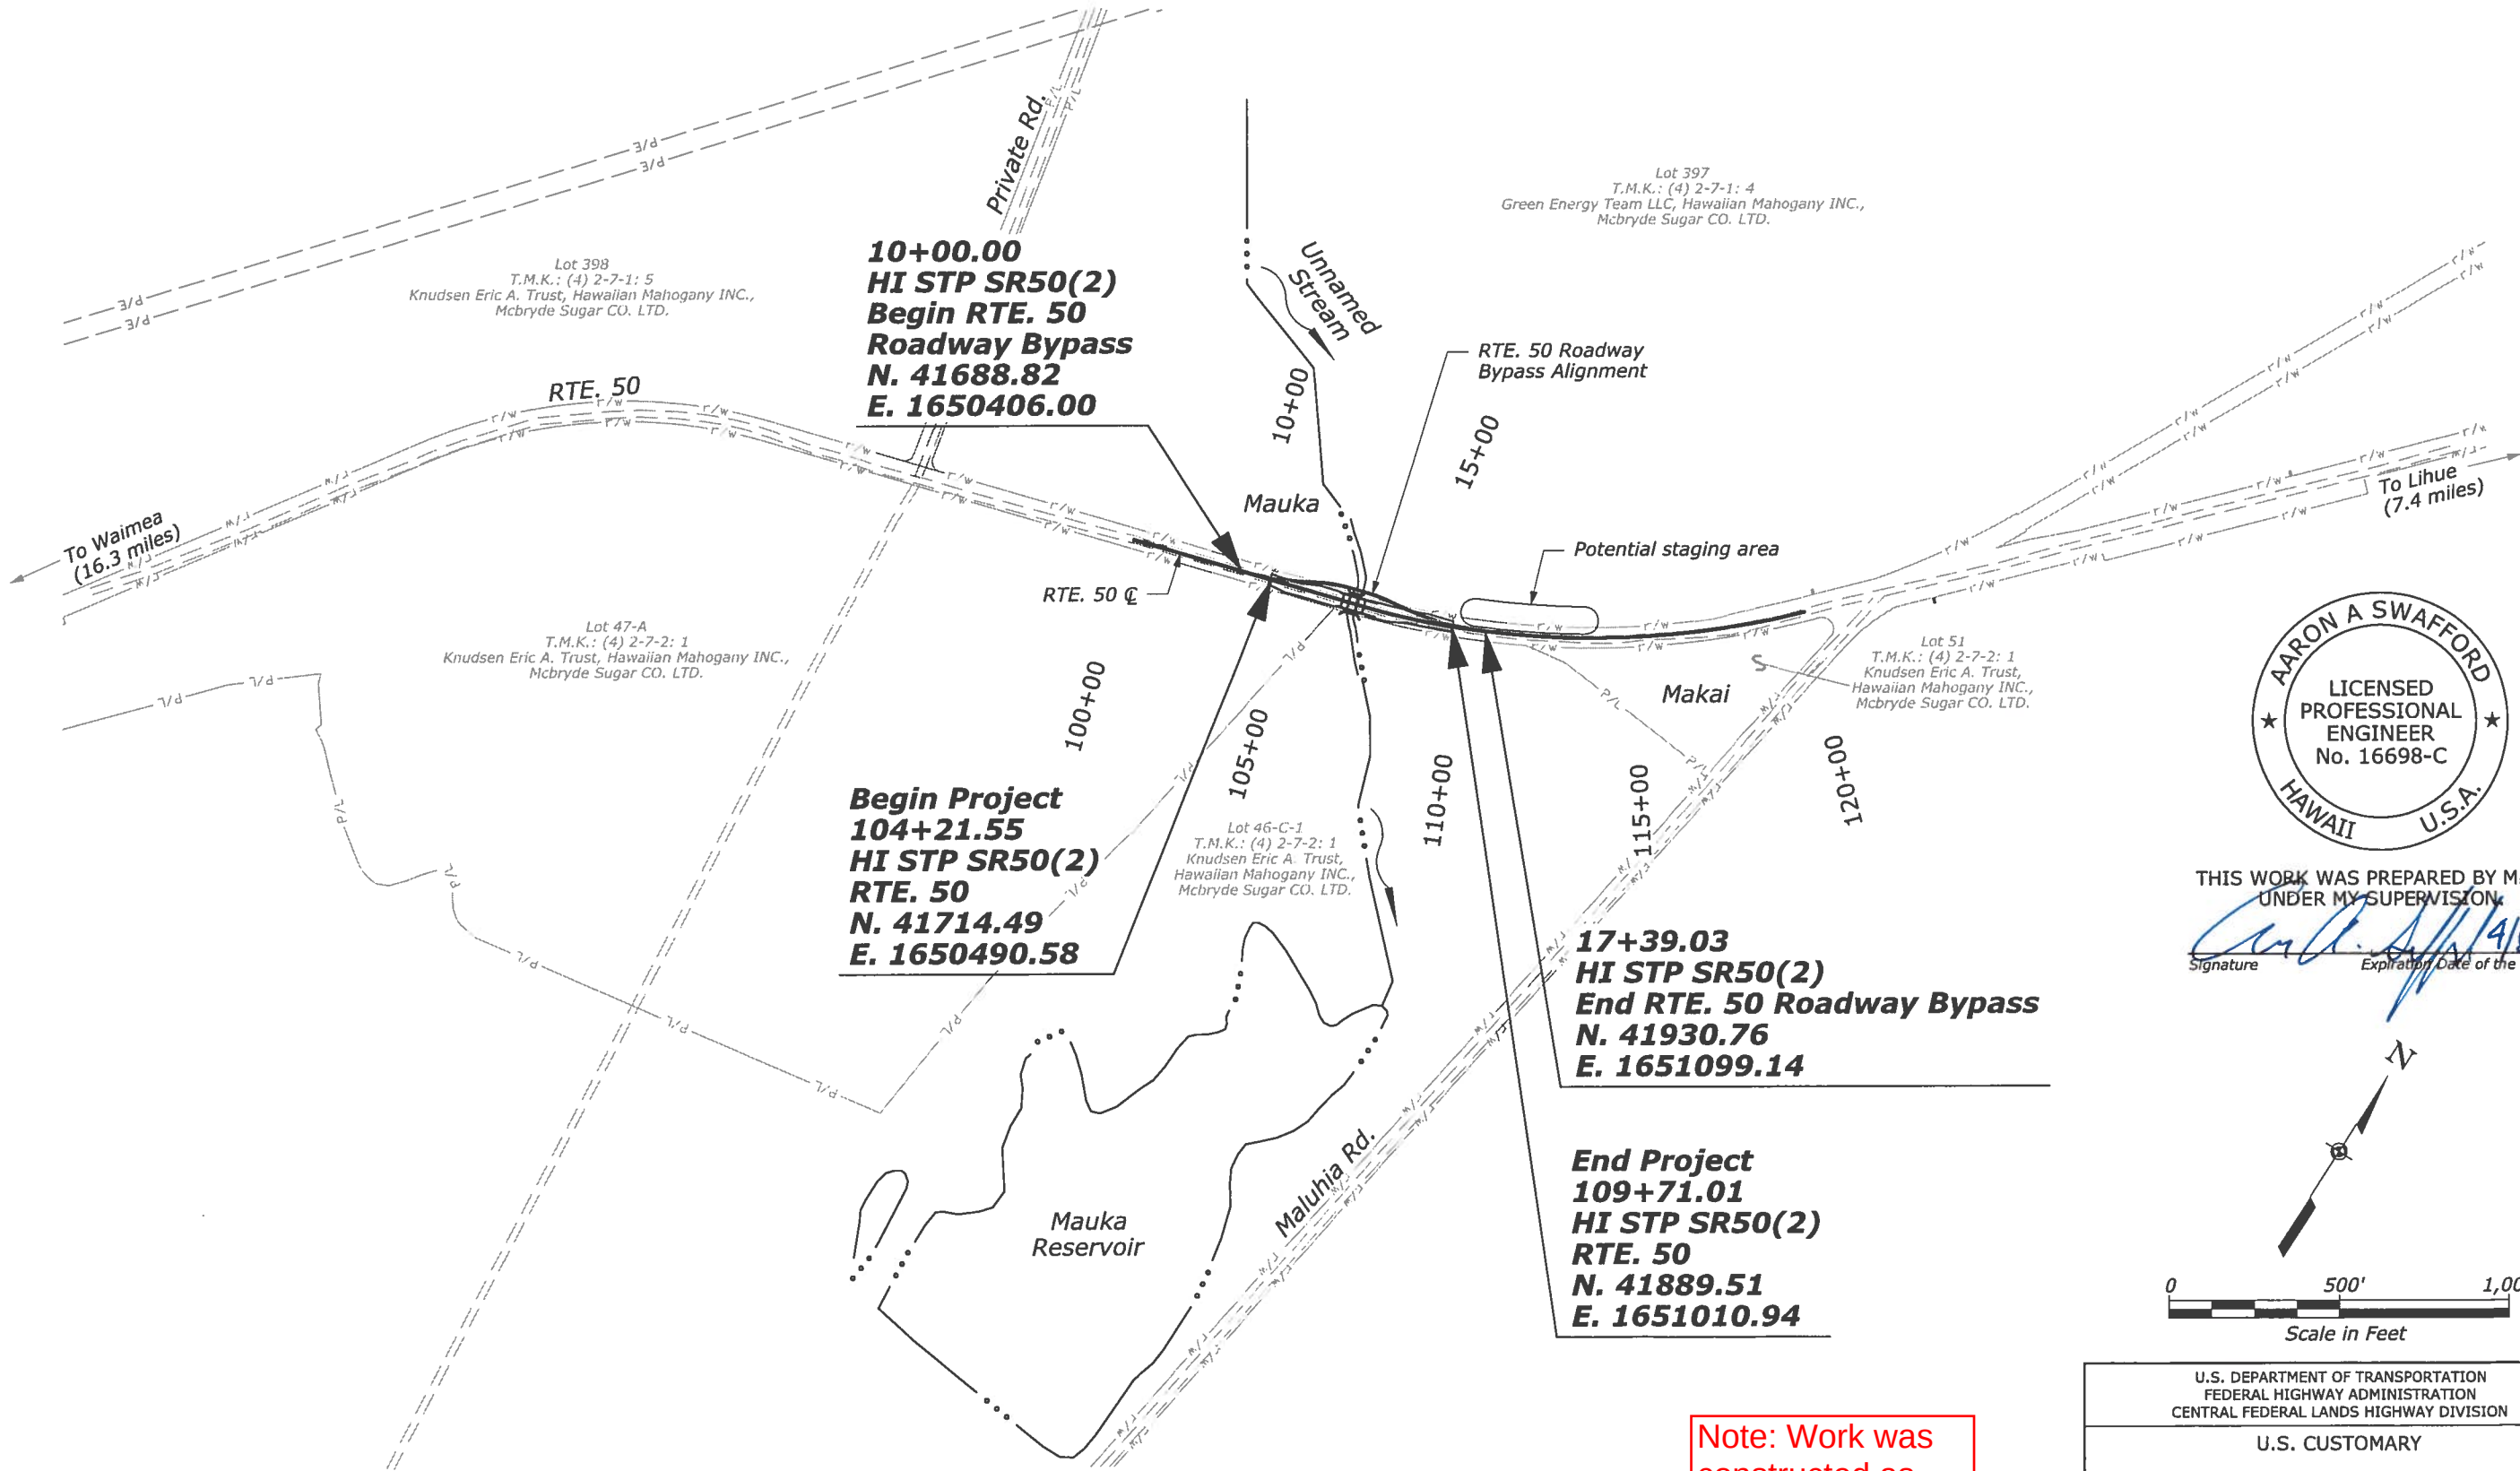

Note: Work was constructed as designed unless otherwise noted.