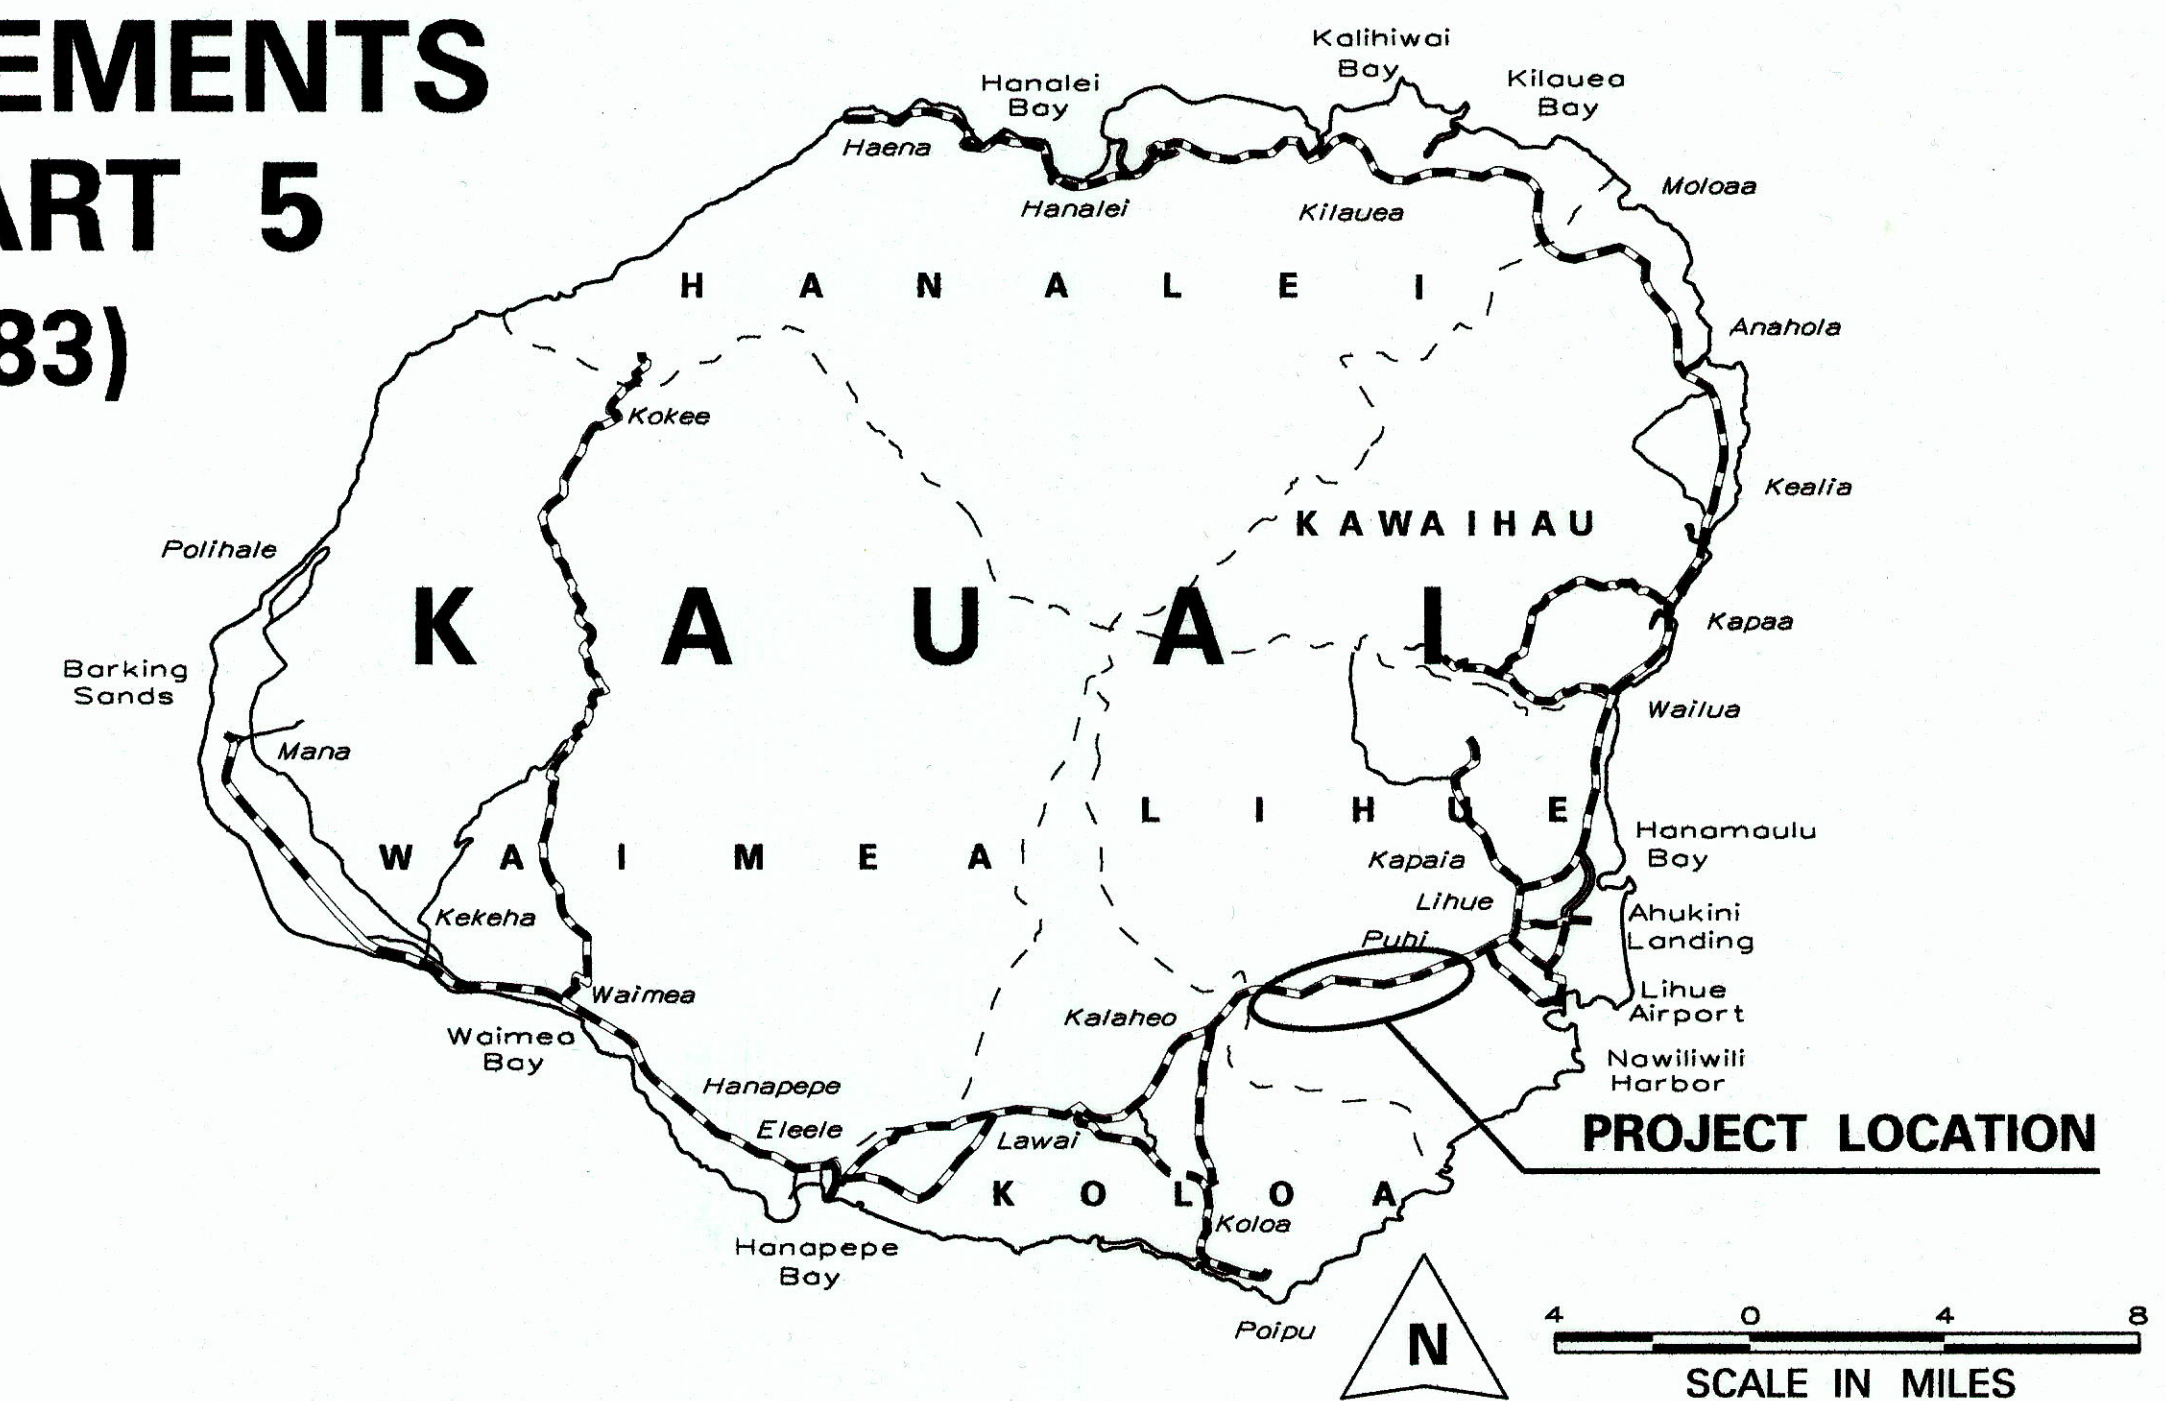
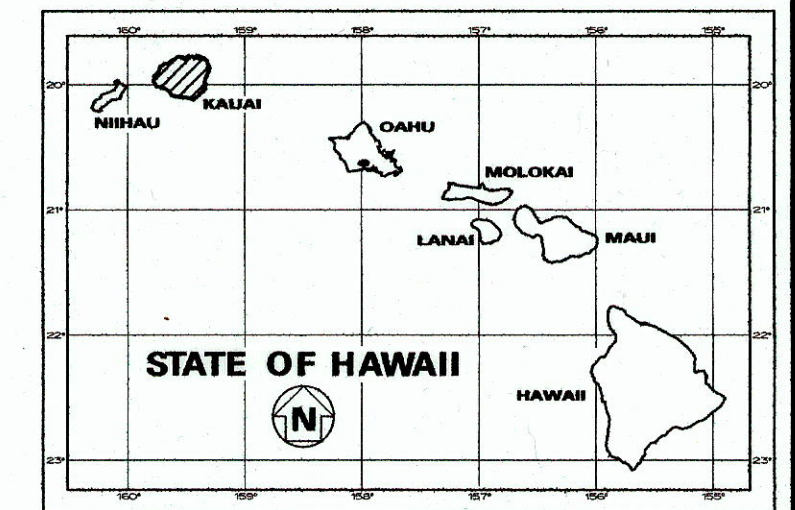


INDEX TO DRAWINGS	
SHEET NO.	DESCRIPTION
1	TITLE SHEET
2	STANDARD PLANS SUMMARY
3	GENERAL NOTES & LEGEND
4 – 6	WATER POLLUTION AND EROSION CONTROL NOTES
7 – 8	GUARDRAIL WORK ITEMS
9	GUARDRAIL DETAILS & NOTES
10	MIDWEST GUARDRAIL SYSTEM WITH NO BLOCKOUTS
11	STRONG POST THRIE-BEAM GUARDRAIL, NESTED
12	MGS TRANSITION TO STRONG POST GUARDRAIL
13	GUARDRAIL DETAILS AT OBSTRUCTION
14	TRAFFIC CONTROL PLAN


STATE OF HAWAII
DEPARTMENT OF TRANSPORTATION
HIGHWAYS DIVISION
HONOLULU, HAWAII
"AS-BUILT"
PLANS FOR
**GUARDRAIL AND SHOULDER IMPROVEMENTS
AT VARIOUS LOCATIONS, KAUAI, PART 5
FEDERAL-AID PROJECT NO. STP-0700(083)**
DISTRICT OF LIHUE
ISLAND OF KAUAI

FED. ROAD DIST. NO.	STATE	FED. AID PROJ. NO.	FISCAL YEAR	SHEET NO.	TOTAL SHEETS
HAWAII	HAW.	STP-0700(083)	2019	1	14

FEDERAL AID PROJECTS PREVIOUSLY CONSTRUCTED
OR UNDER CONSTRUCTION


MILE POST 2.11 TO MILE POST 3.94 (RTE. 50)

DESIGN	DESIGNATION
2018	28,000
2028	32,300
2028	2,750
Design K	8.5
Design D	60/40
Design T	4.5
T24	5.0

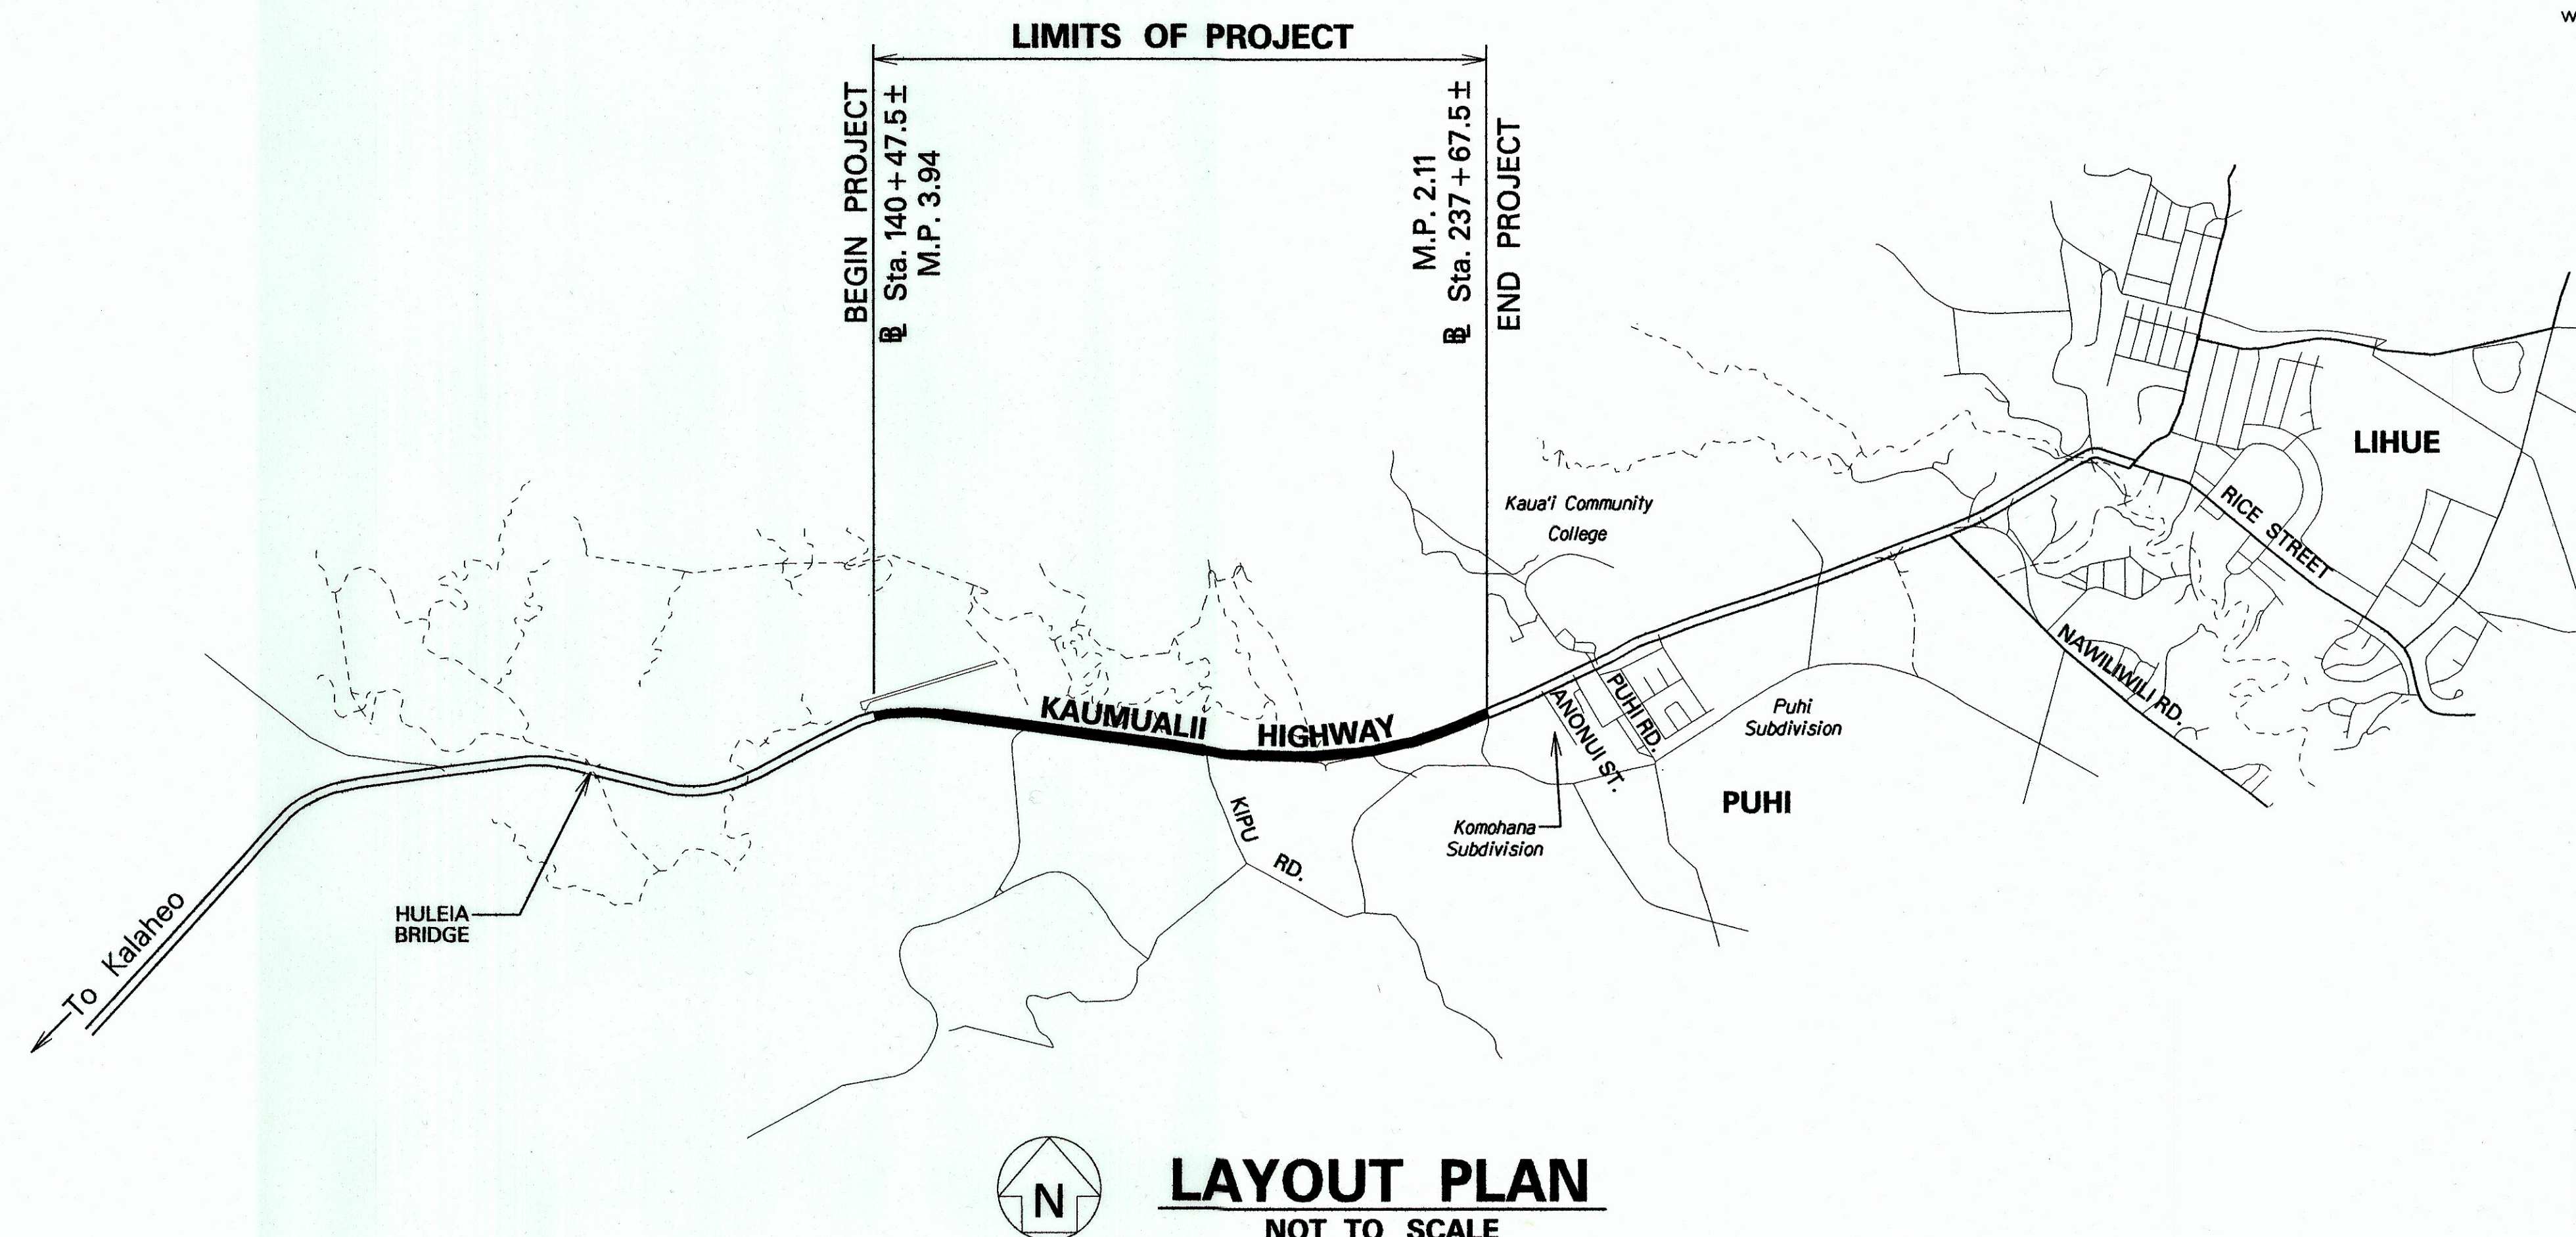

CHANGES MADE DURING CONSTRUCTION HAVE BEEN
INCORPORATED ON THESE PLANS EXCEPT CHANGES
IN THE ORIGINAL THEORETICAL QUANTITIES. FOR
ACTUAL QUANTITIES, REFER TO PROJECT LEDGER
AND/OR COMPUTATION BOOK.

[Signature] 2/8/22
RESIDENT ENGINEER DATE

DEPARTMENT OF TRANSPORTATION STATE OF HAWAII	
APPROVED:	
	
For DIR. OF TRANSPORTATION	Ce/14/19 DATE