



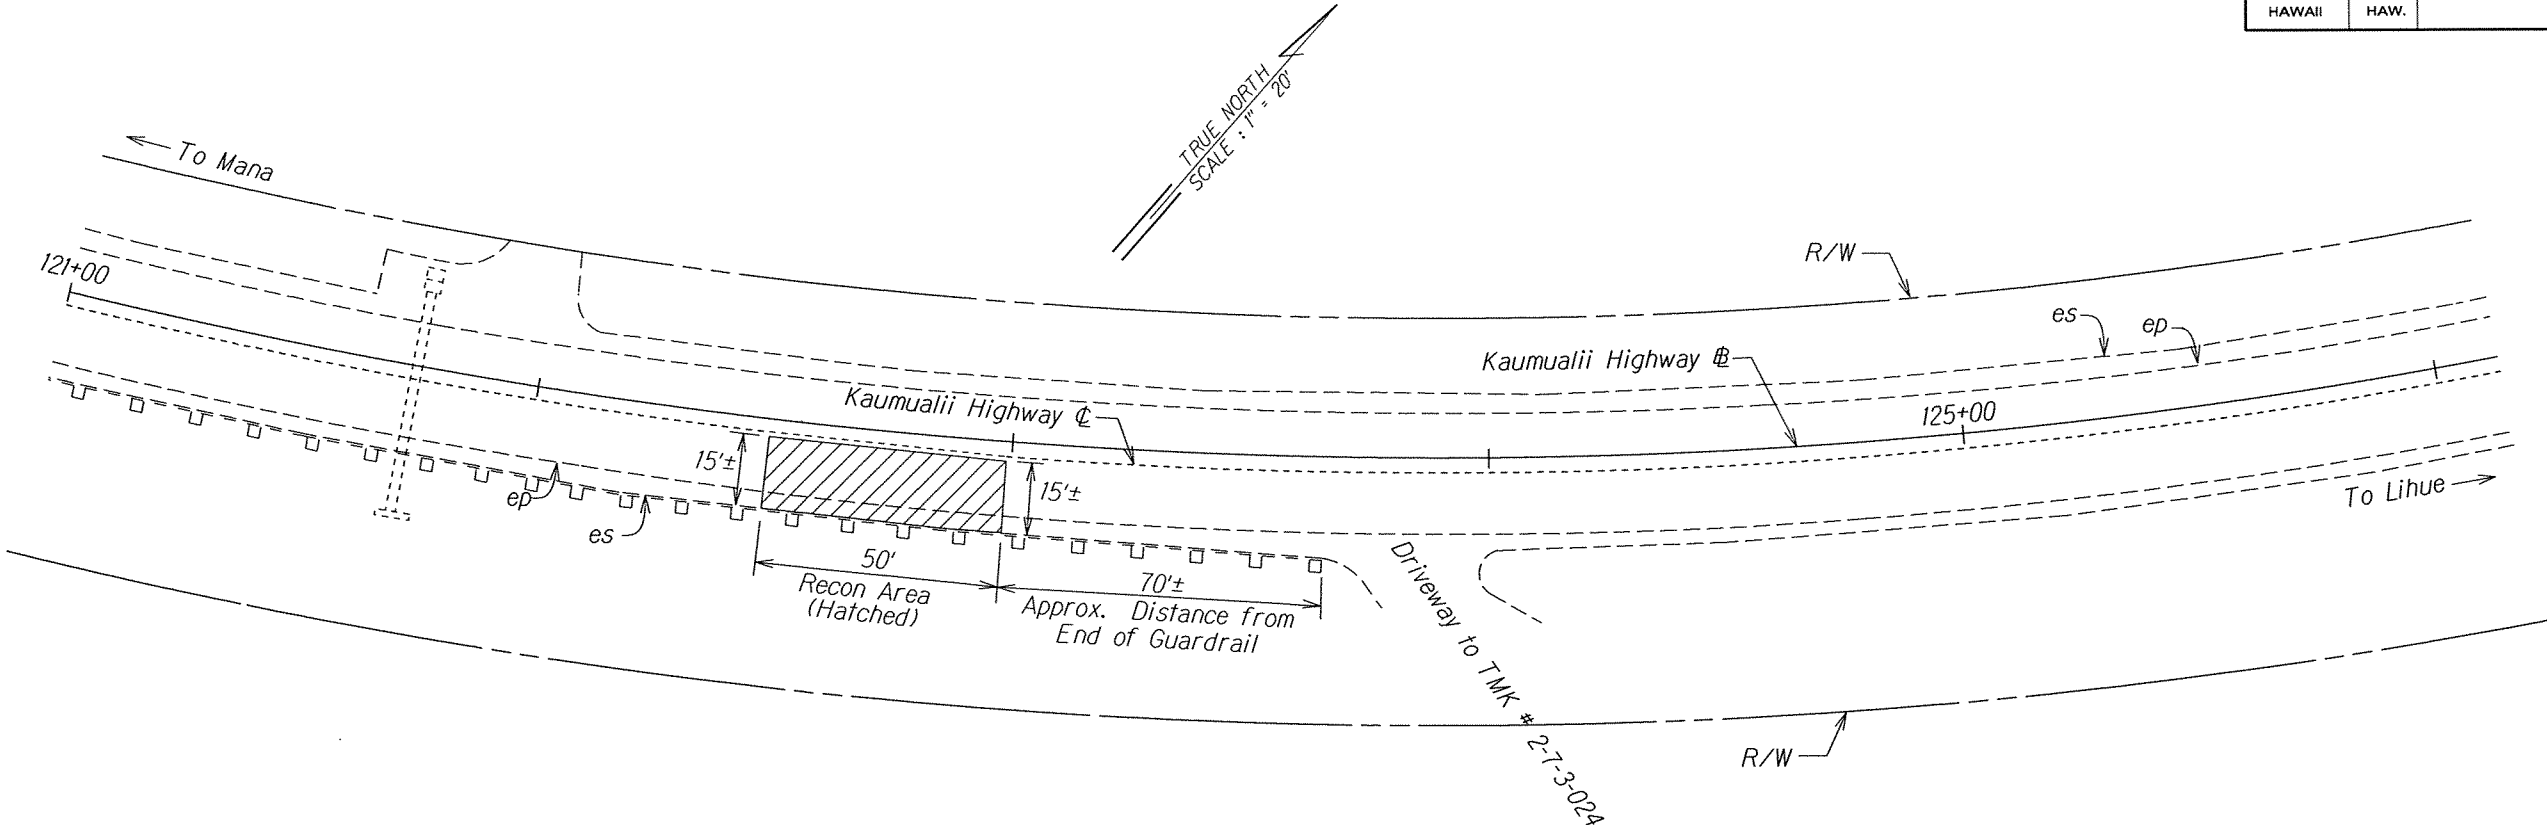


ROADWAY PLAN
Scale : 1" = 20'

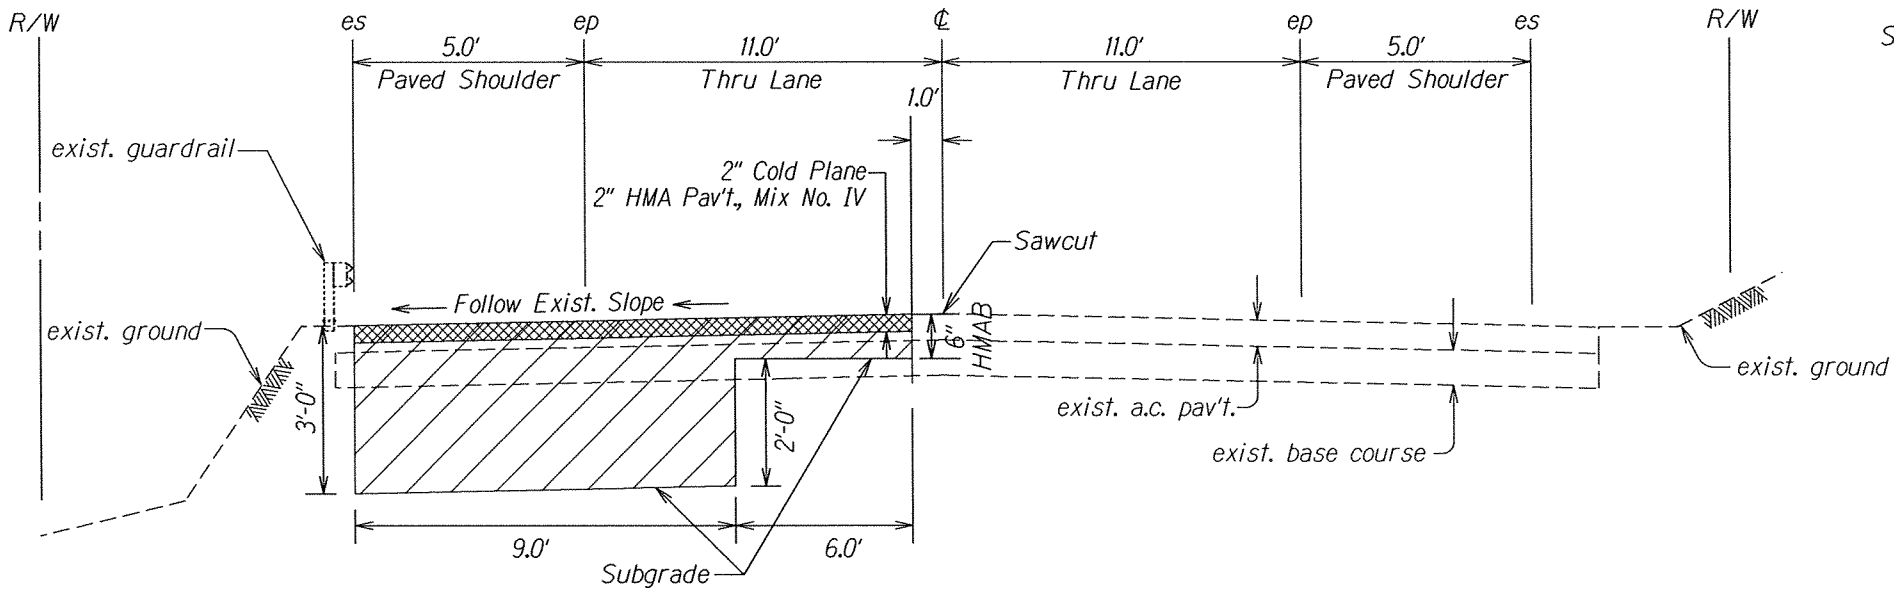

SECTION
Not to Scale

- LEGEND:
- Cold Plane/Resurface
 - Reconstruction Area

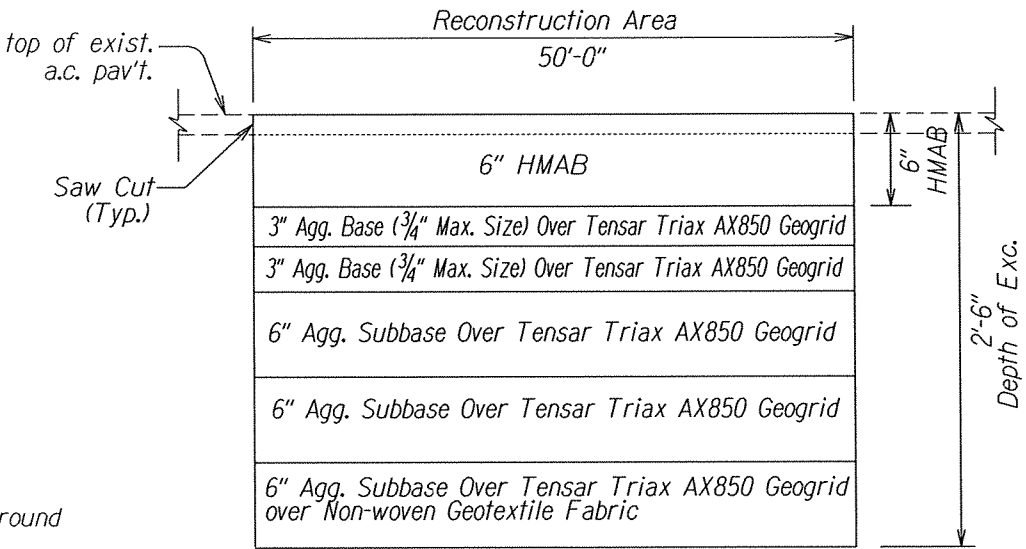

PROFILE
Not to Scale

7/15/21	△ — Revise Profile and Section
DATE	REVISION
STATE OF HAWAII DEPARTMENT OF TRANSPORTATION HIGHWAYS DIVISION	
ROADWAY PLAN	
KAUMUALII HIGHWAY PAVEMENT REPAIR	
Vicinity of Upa Road	
Scale as Shown	Date: July 2021
SHEET No. 2 OF 3 SHEETS	