
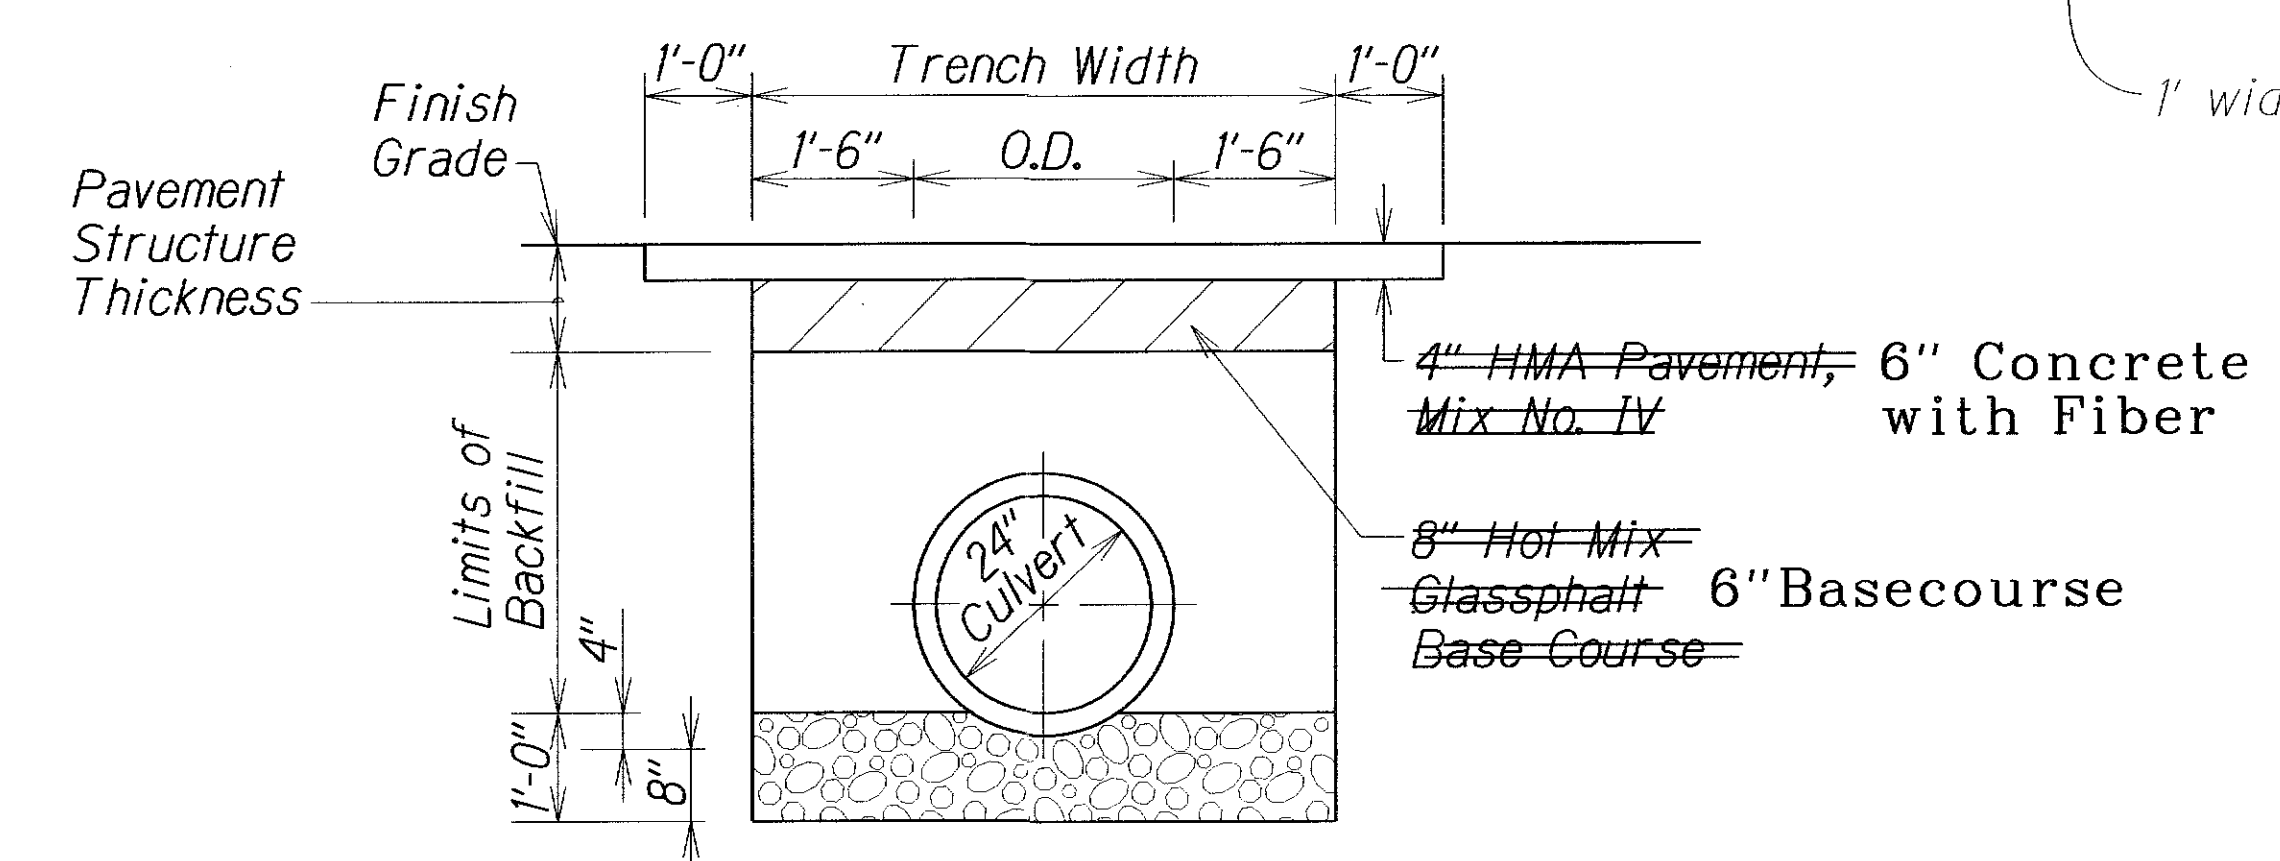


FED. ROAD DIST. NO.	STATE	PROJ. NO.	FISCAL YEAR	SHEET NO.	TOTAL SHEETS
HAWAII	HAW.	50C-03-06	2009	6	7

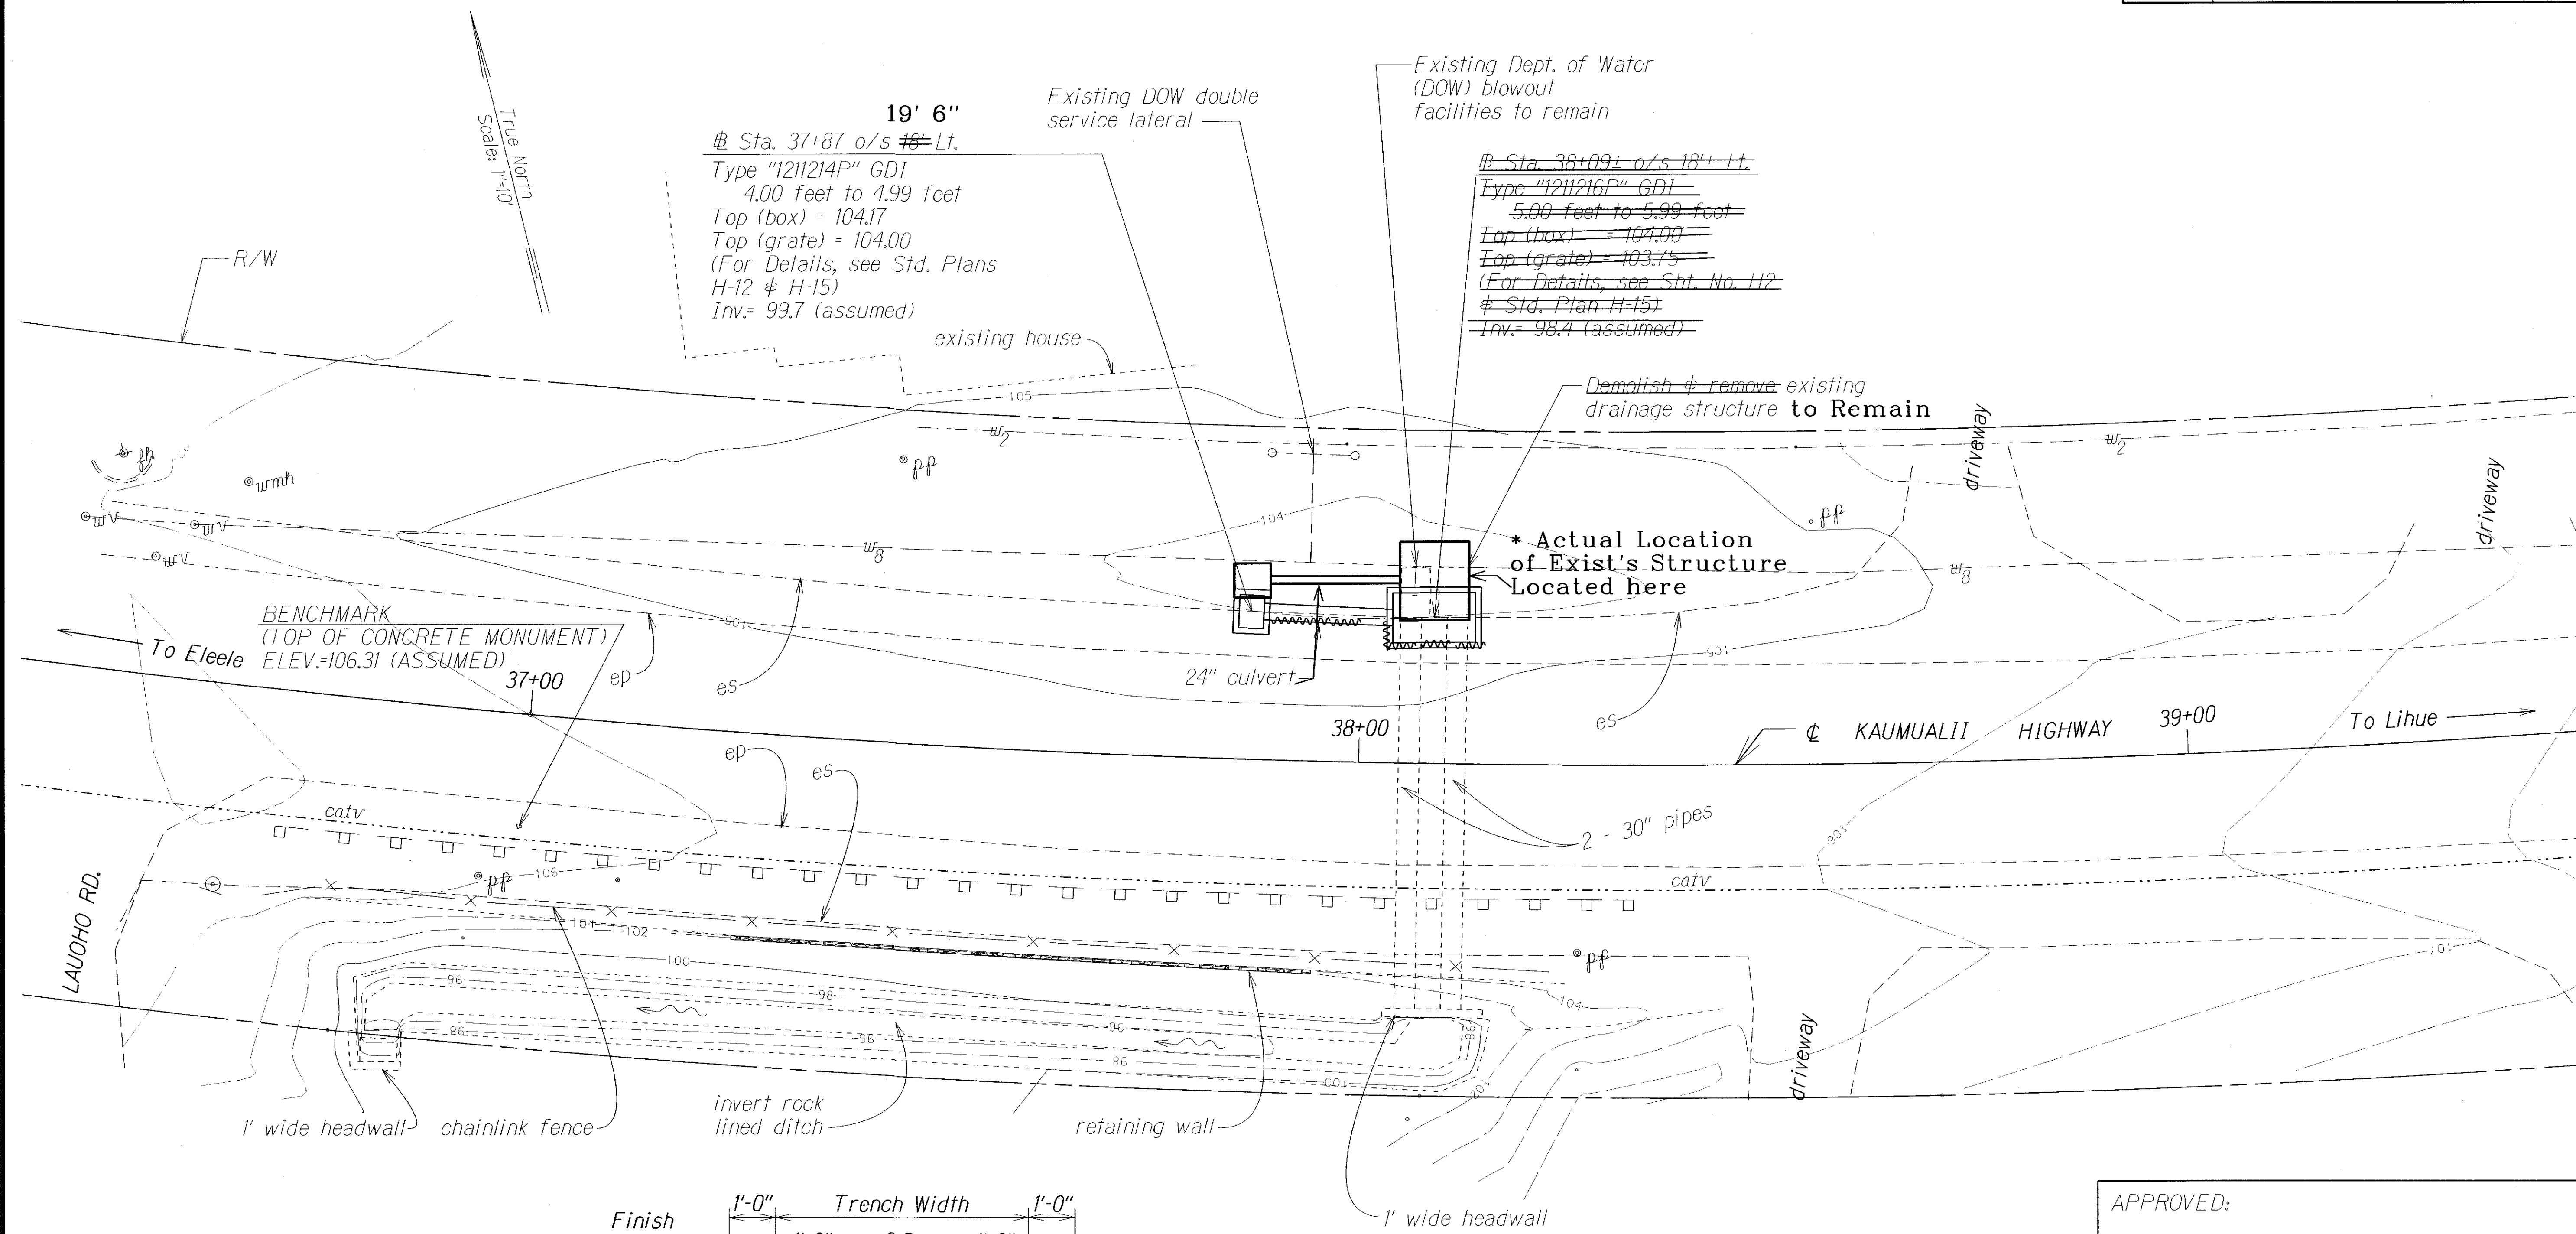

LEGEND FOR AS-BUILT POSTINGS	
	Squiggly line for as-built deletion
	Double line for as-built deletion
Roadway	Text for as-built posting

APPROVED: _____ Date _____
 Manager & Chief Engineer
 Dept. of Water, County of Kauai

STATE OF HAWAII
DEPARTMENT OF TRANSPORTATION
HIGHWAYS DIVISION

DRAINAGE PLAN

KAUMUALII HIGHWAY DRAINAGE IMPROVEMENTS

Vicinity of Milepost 10.9

Project No. 50C-03-06



Scale: 1"=10' Date: August, 2008

SURVEY PLOTTED BY	DATE
DESIGNED BY	8/5/08
CHECKED BY	
ORIGINAL PLAN	
NOTE BOOK	
QUANTITIES BY	
CHECKED BY	

DETAIL OF CULVERT TRENCH AND BACKFILL RESTORATION
 Not To Scale

"AS-BUILT"

FED. ROAD DIST. NO.	STATE	PROJ. NO.	FISCAL YEAR	SHEET NO.	TOTAL SHEETS
HAWAII	HAW.	50C-03-06	2009	6	7

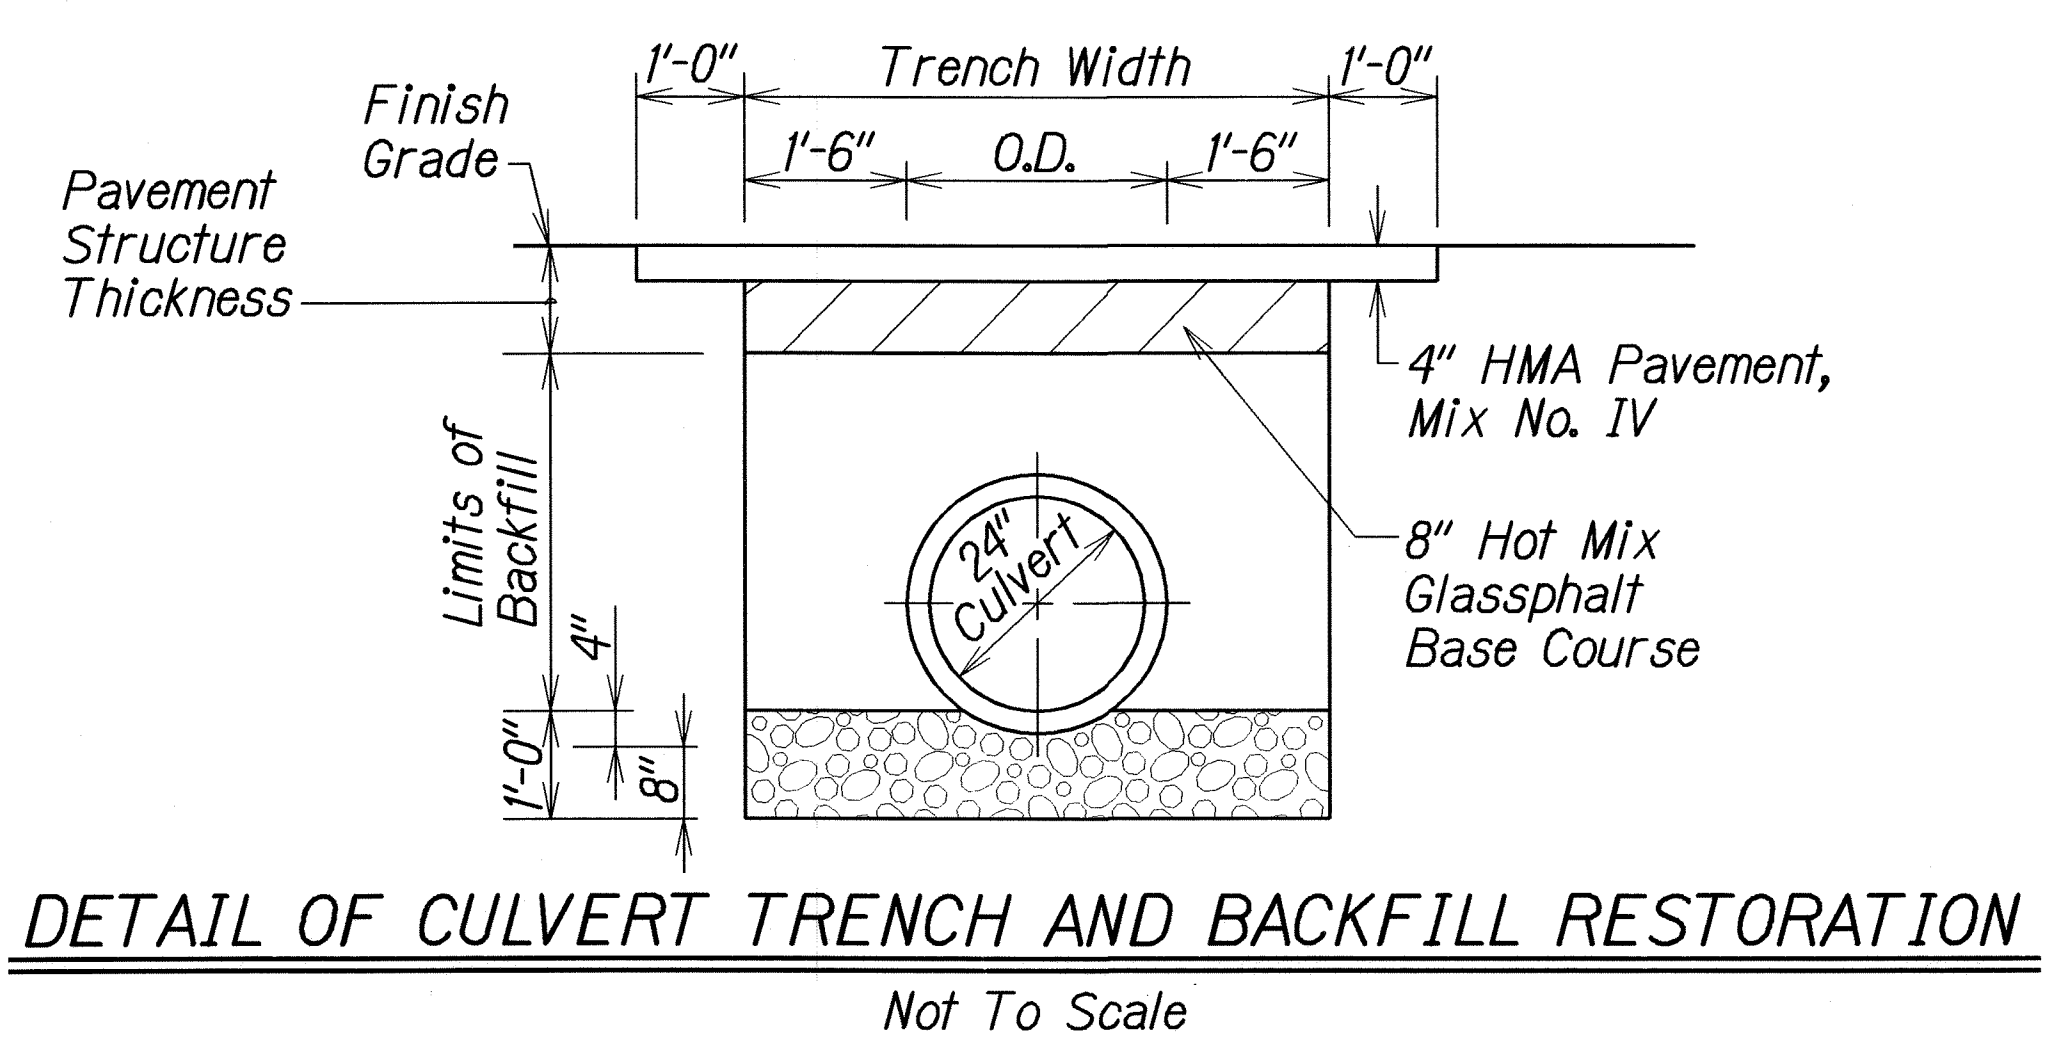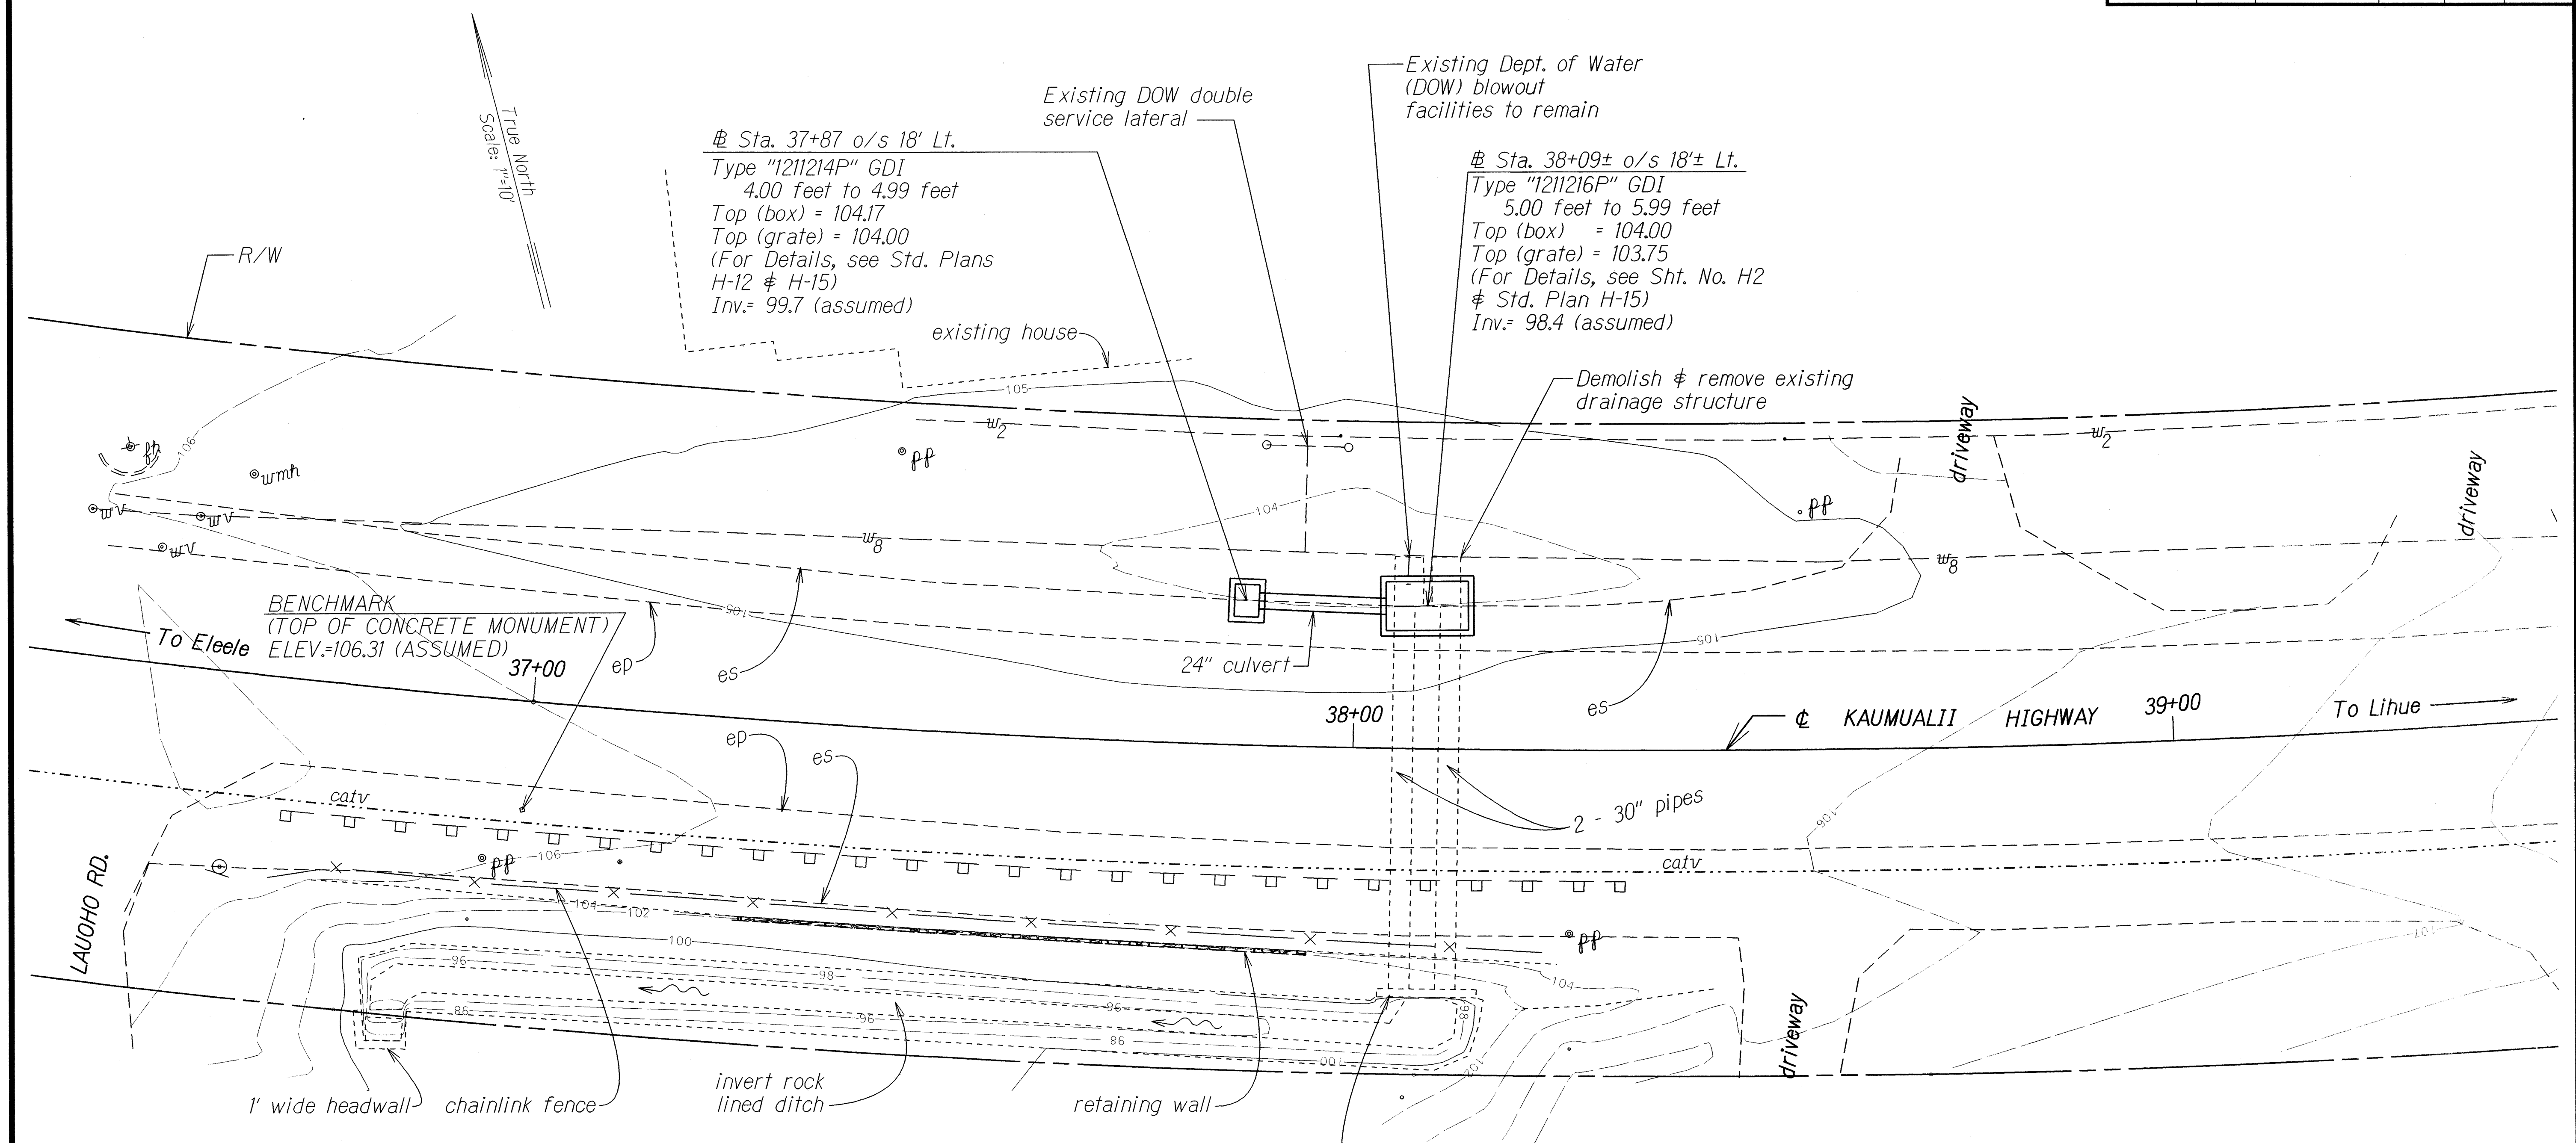

APPROVED: Chris Inoué 8/30/08
 For Manager & Chief Engineer Date
 Dept. of Water, County of Kauai

STATE OF HAWAII
 DEPARTMENT OF TRANSPORTATION
 HIGHWAYS DIVISION

DRAINAGE PLAN

KAUMUALII HIGHWAY DRAINAGE IMPROVEMENTS
Vicinity of Milepost 10.9
Project No. 50C-03-06

Scale: 1"=10' Date: August, 2008

SHEET No. **HI** OF 2 SHEETS

DESIGNED BY	DATE
TRACED BY	8/5/08
QUANTITIES BY	
CHECKED BY	
ORIGINAL PLAN	
NOTE BOOK	
DATE	
BY	