
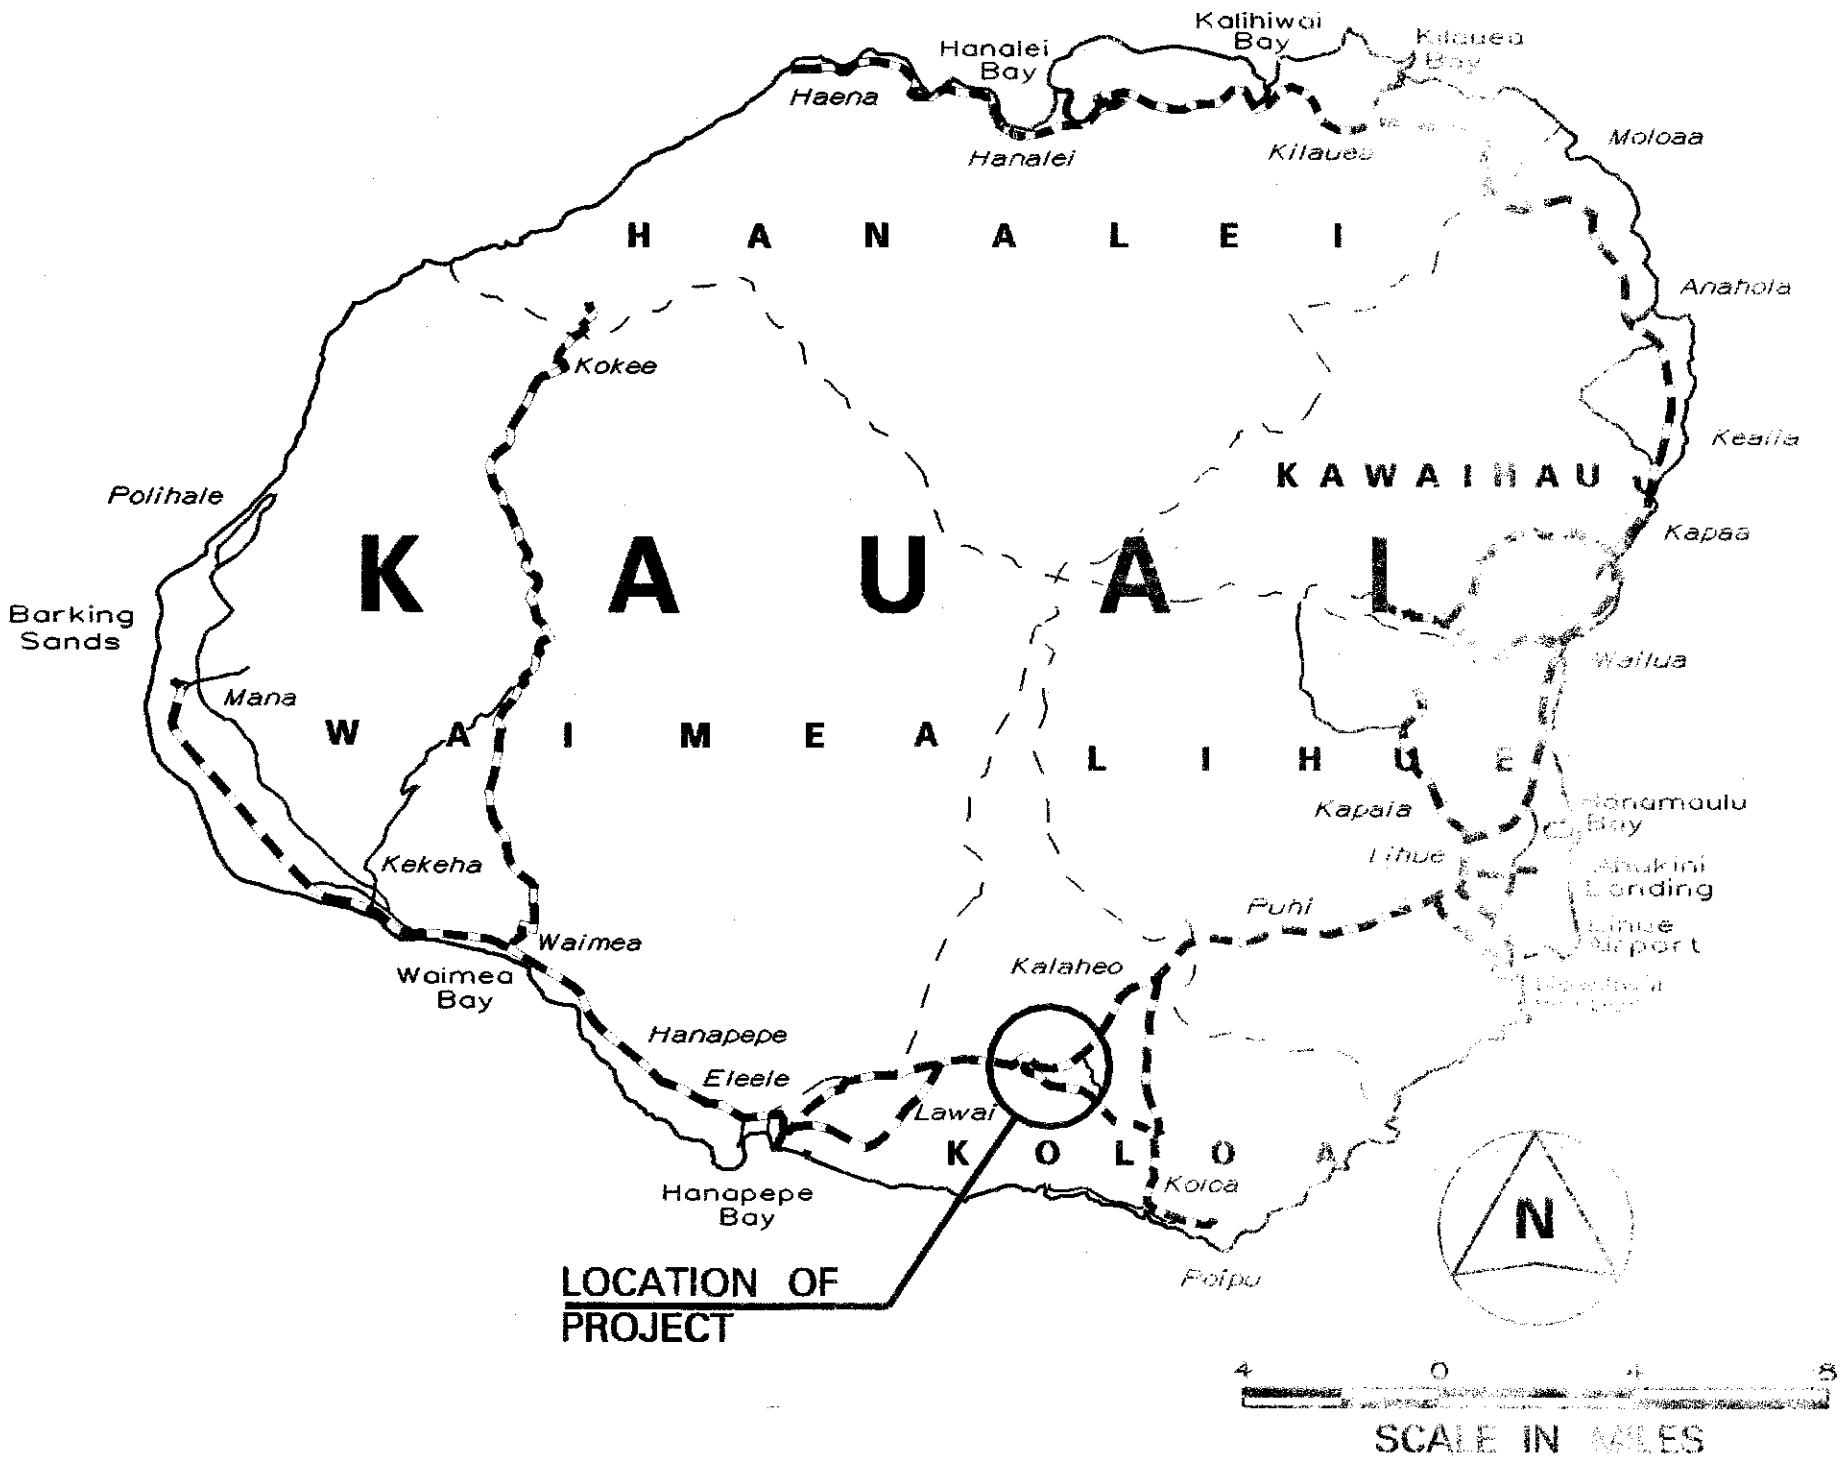




INDEX TO DRAWINGS	
SHEET NO.	DESCRIPTION
1	TITLE SHEET
2	STANDARD PLANS SUMMARY
3	NOTES SHEET
4 - 5	WATER POLLUTION & EROSION CONTROL NOTES
6	DRAINAGE PLAN
7	DRAINAGE DETAILS

STATE OF HAWAII
DEPARTMENT OF TRANSPORTATION
HIGHWAYS DIVISION
HONOLULU, HAWAII
"AS-BUILT"
PLANS FOR
KAUMUALII HIGHWAY
DRAINAGE IMPROVEMENTS
VICINITY OF MILEPOST 10.9
PROJECT NO. 50C-03-06
DISTRICT OF KOLOA
ISLAND OF KAUAI

FED. ROAD DIST. NO.	STATE	PROJ. NO.	FISCAL YEAR	SHEET NO.	TOTAL SHEETS
HAWAII	HAW.	50C-03-06	2009	1	7

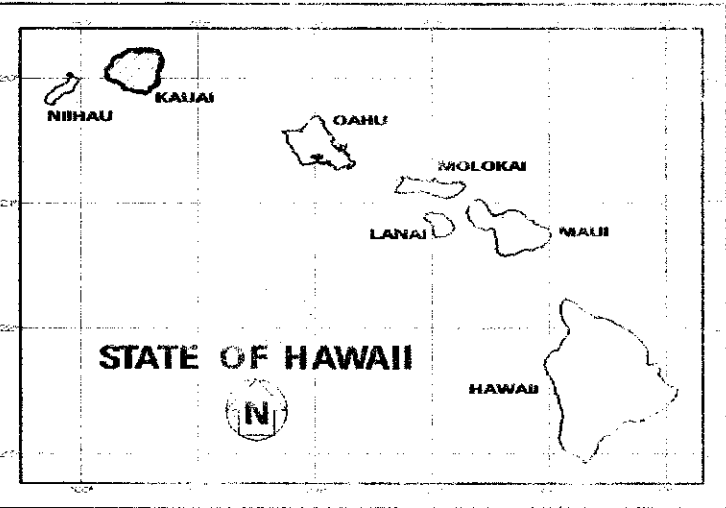

MILE POST 10.9 TO MILE POST 10.9

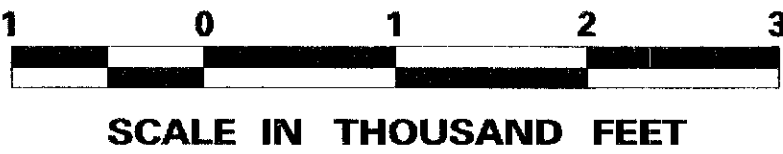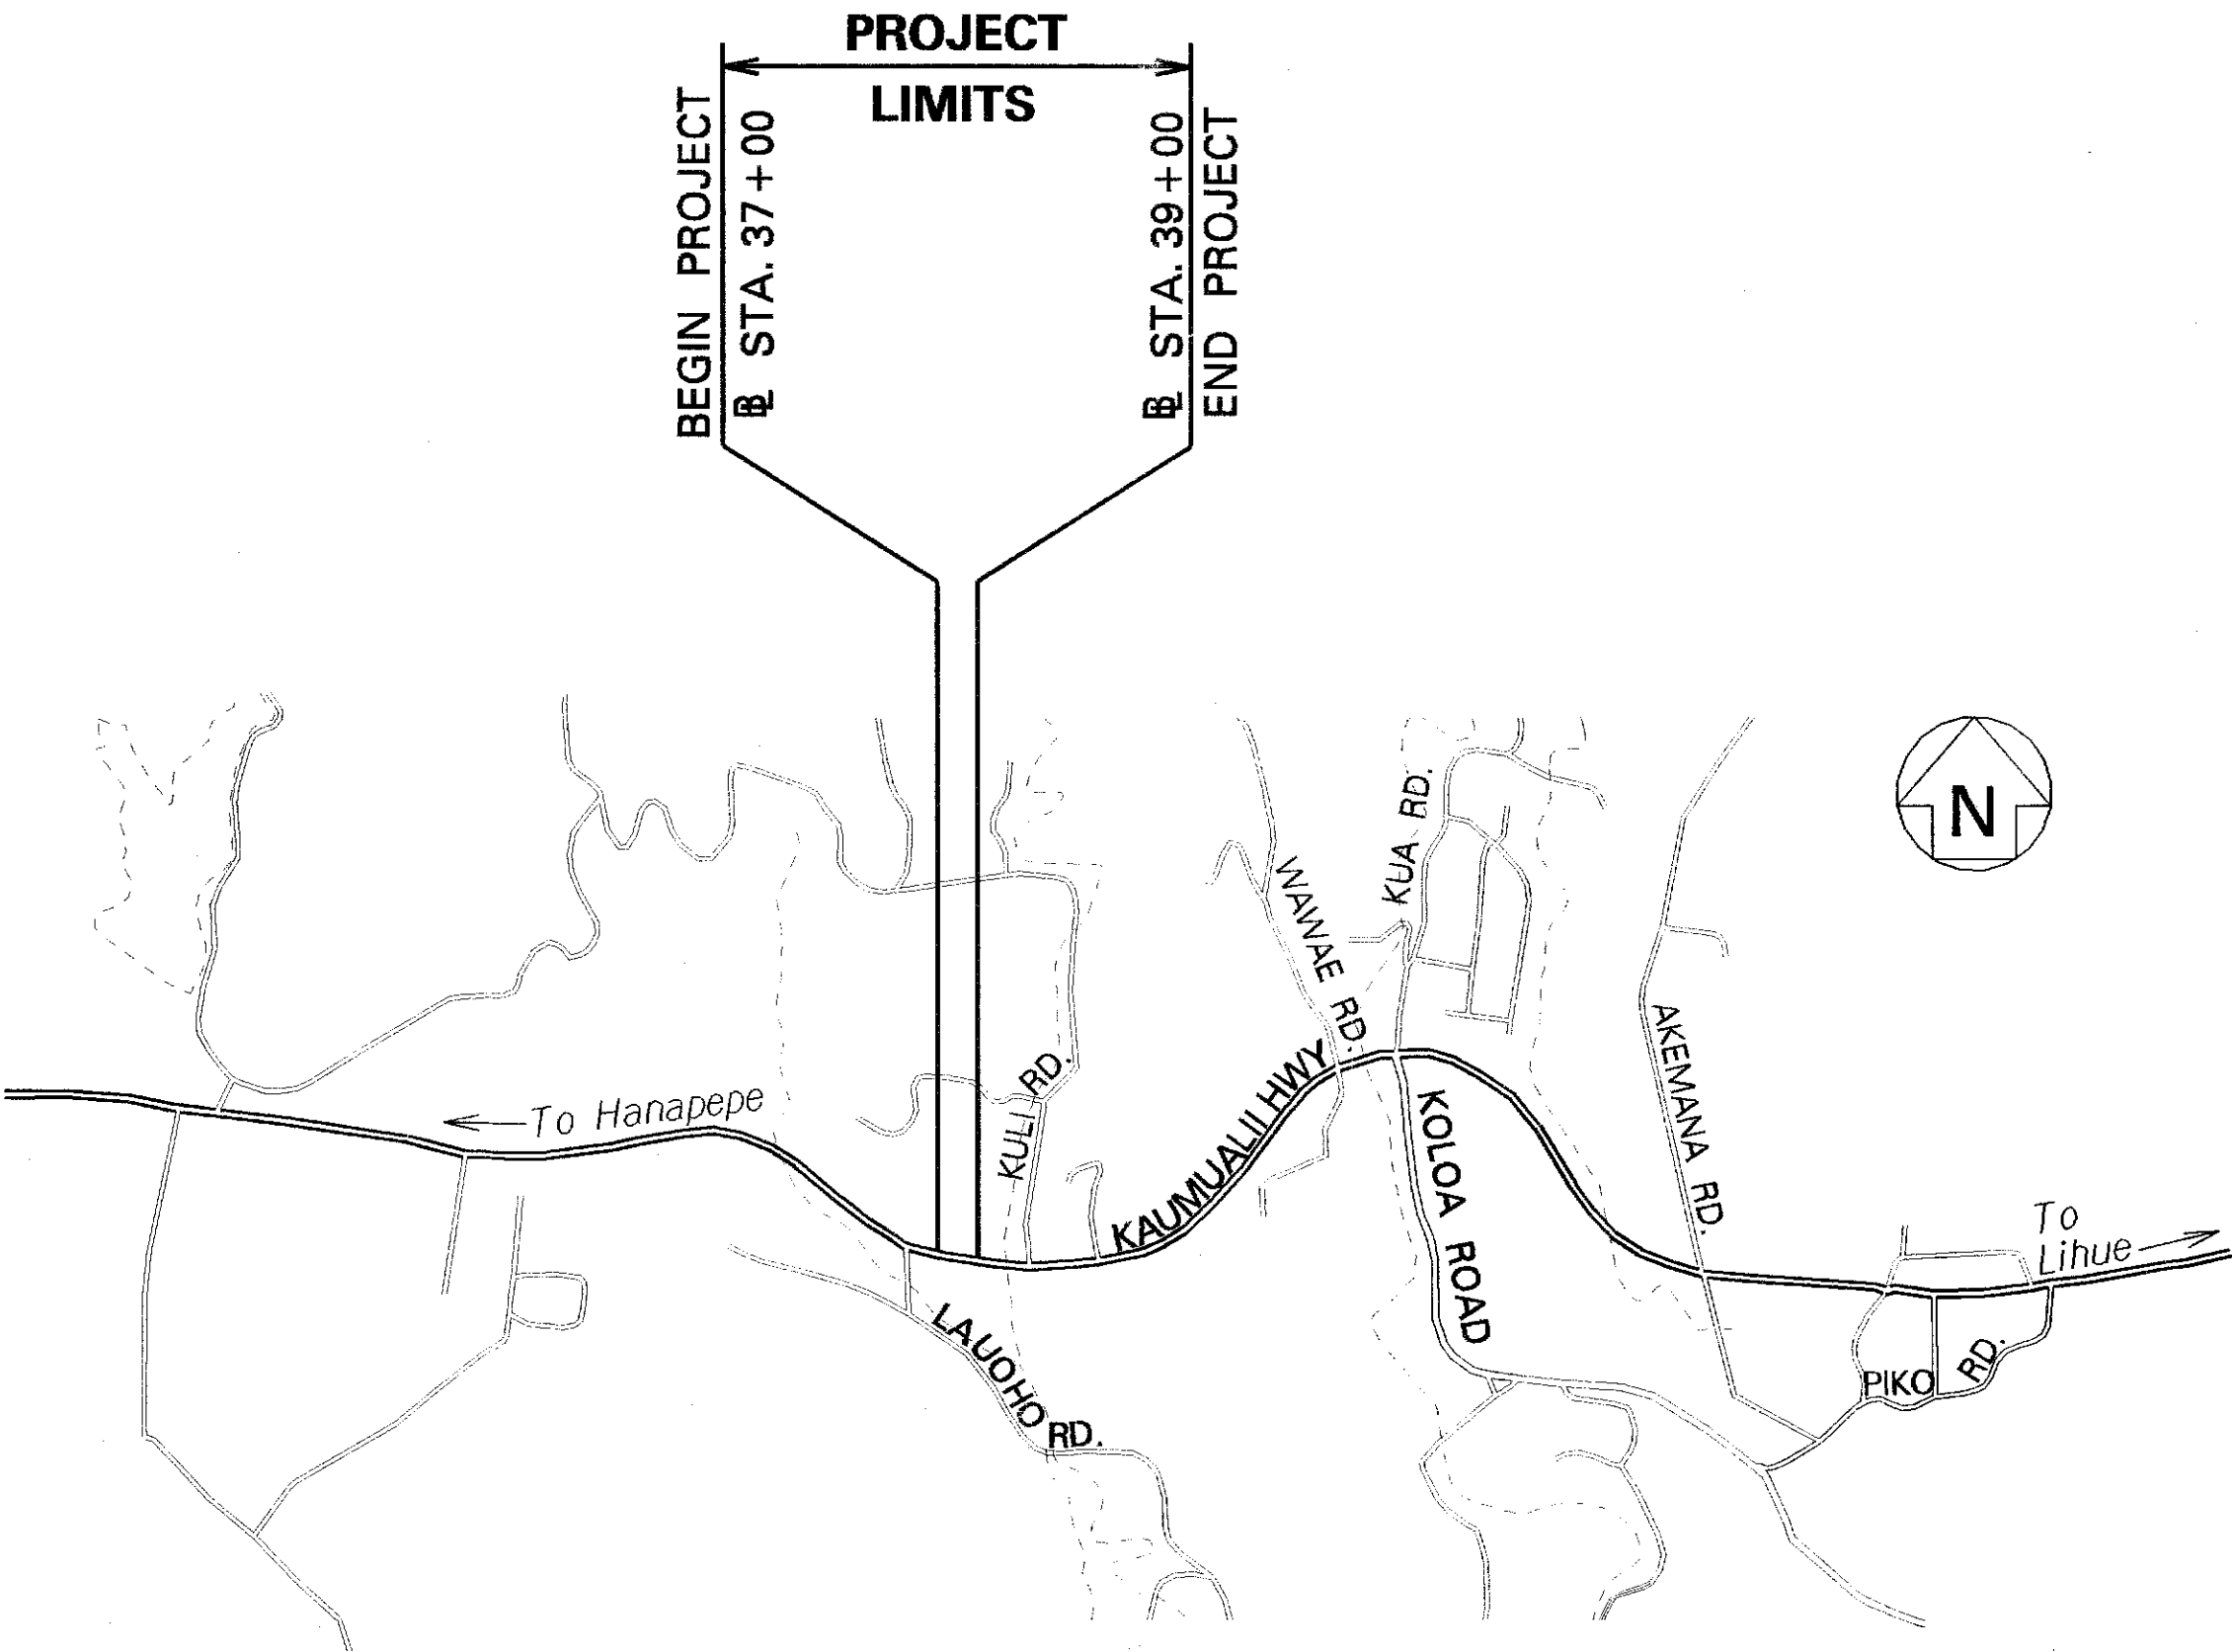

HWY-D
DESIGNED BY

HWY-DH
P.S. & E. BY

692-7561
PHONE

AUG. 2008
DATE

CHANGES MADE DURING CONSTRUCTION HAVE BEEN INCORPORATED ON THESE PLANS EXCEPT CHANGES IN THE ORIGINAL THEORETICAL QUANTITIES. FOR ACTUAL QUANTITIES, REFER TO PROJECT LEDGER AND/OR COMPUTATION BOOK.
RESIDENT ENGINEER
1-10-17
DATE

DEPARTMENT OF TRANSPORTATION
STATE OF HAWAII
APPROVED:
8-8-08
DIR. OF TRANSPORTATION
DATE