

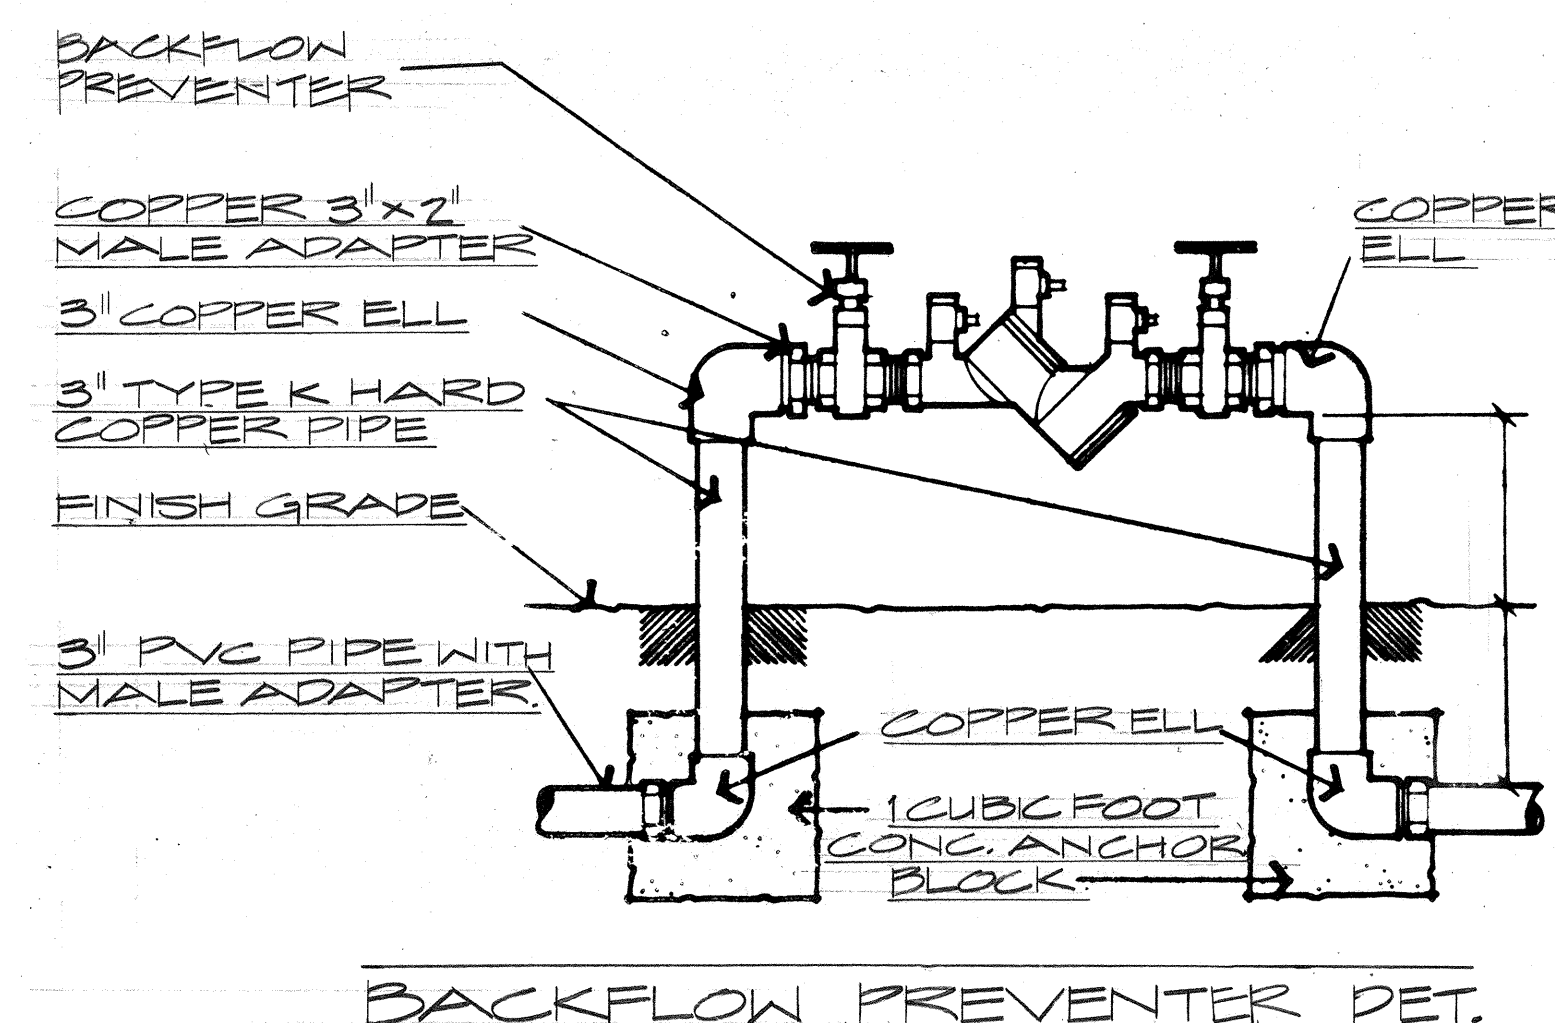
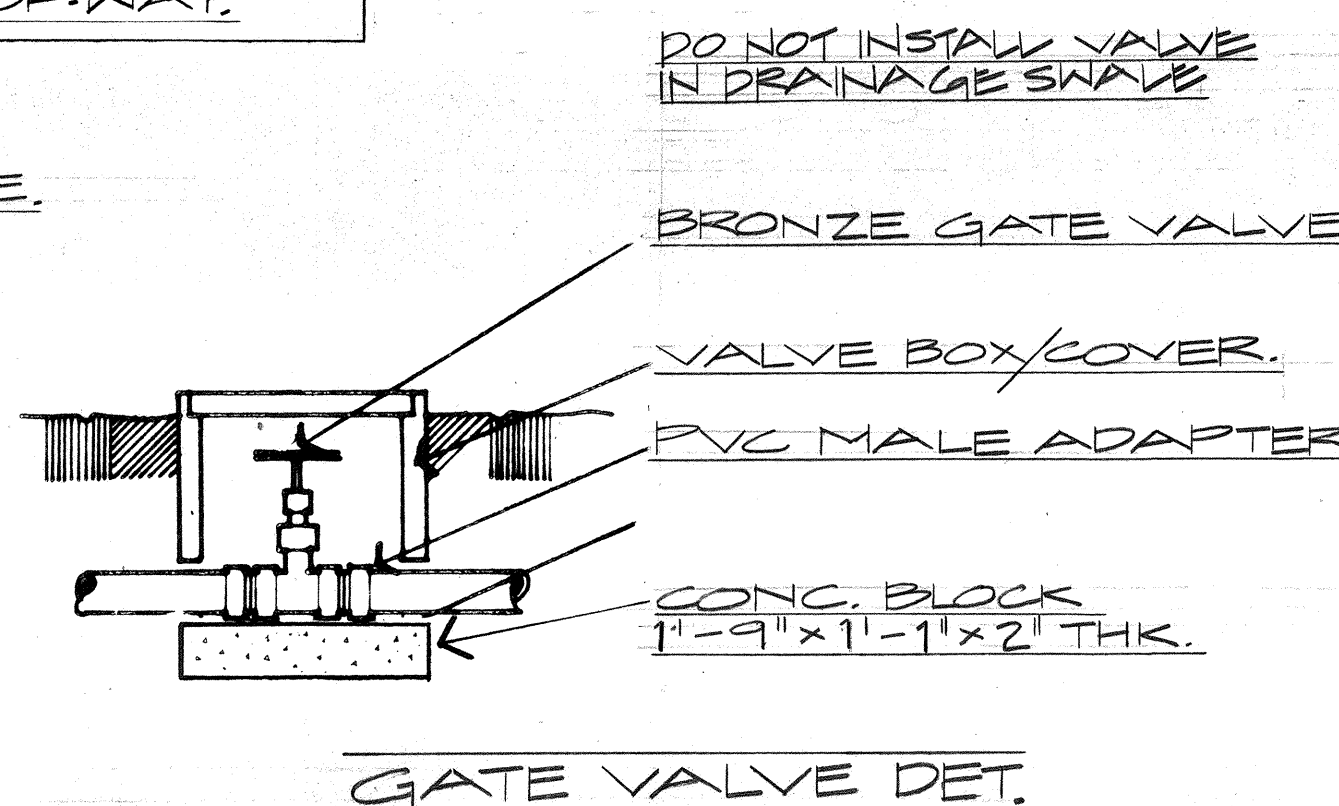
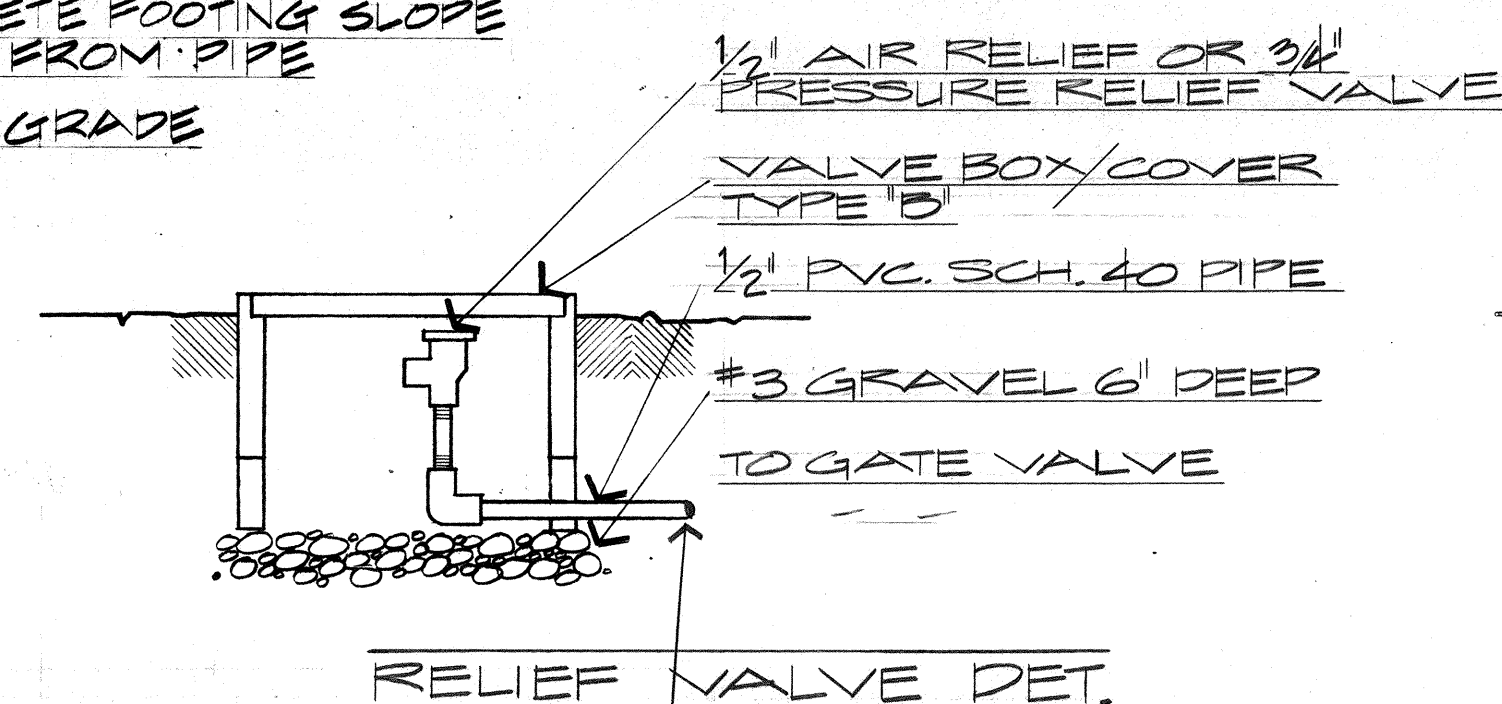
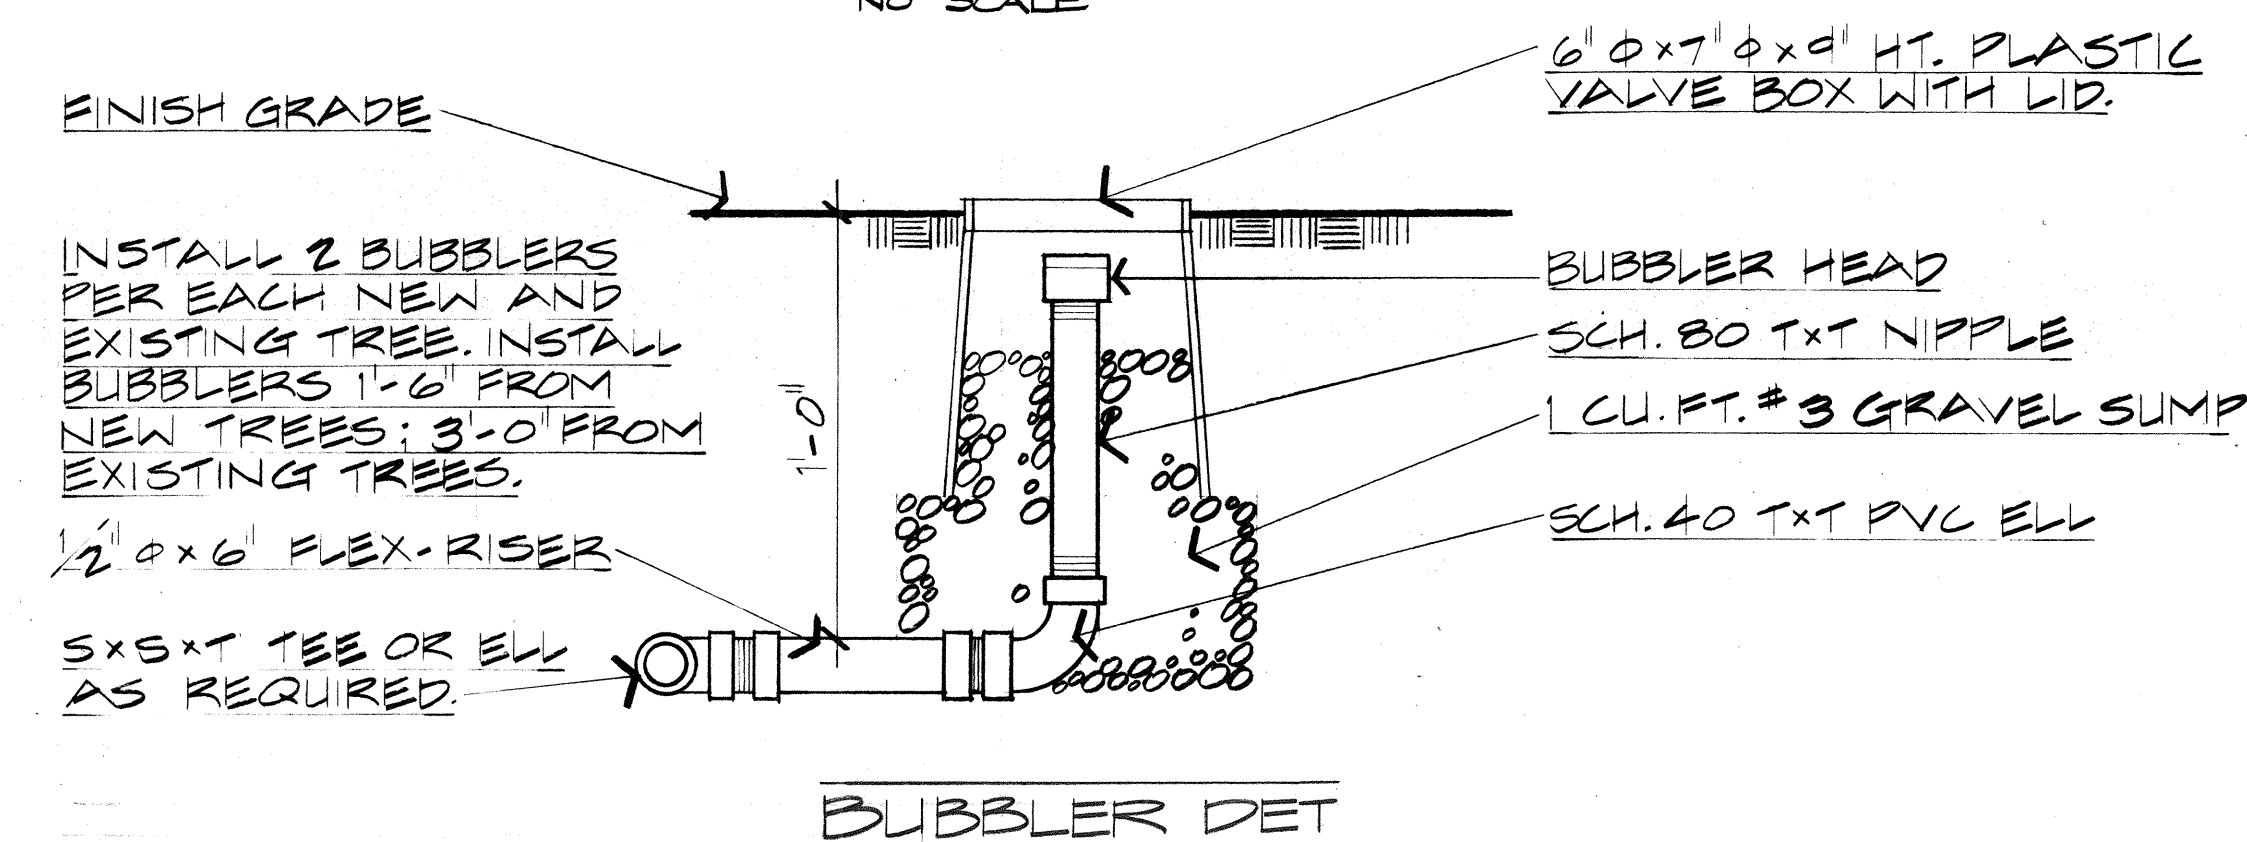
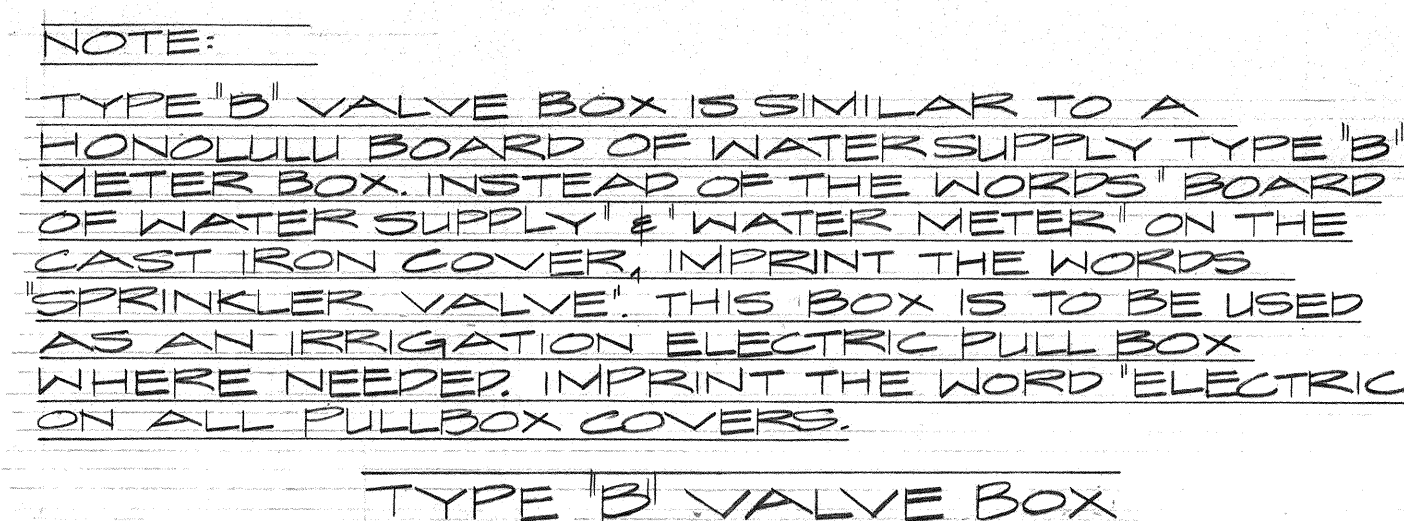
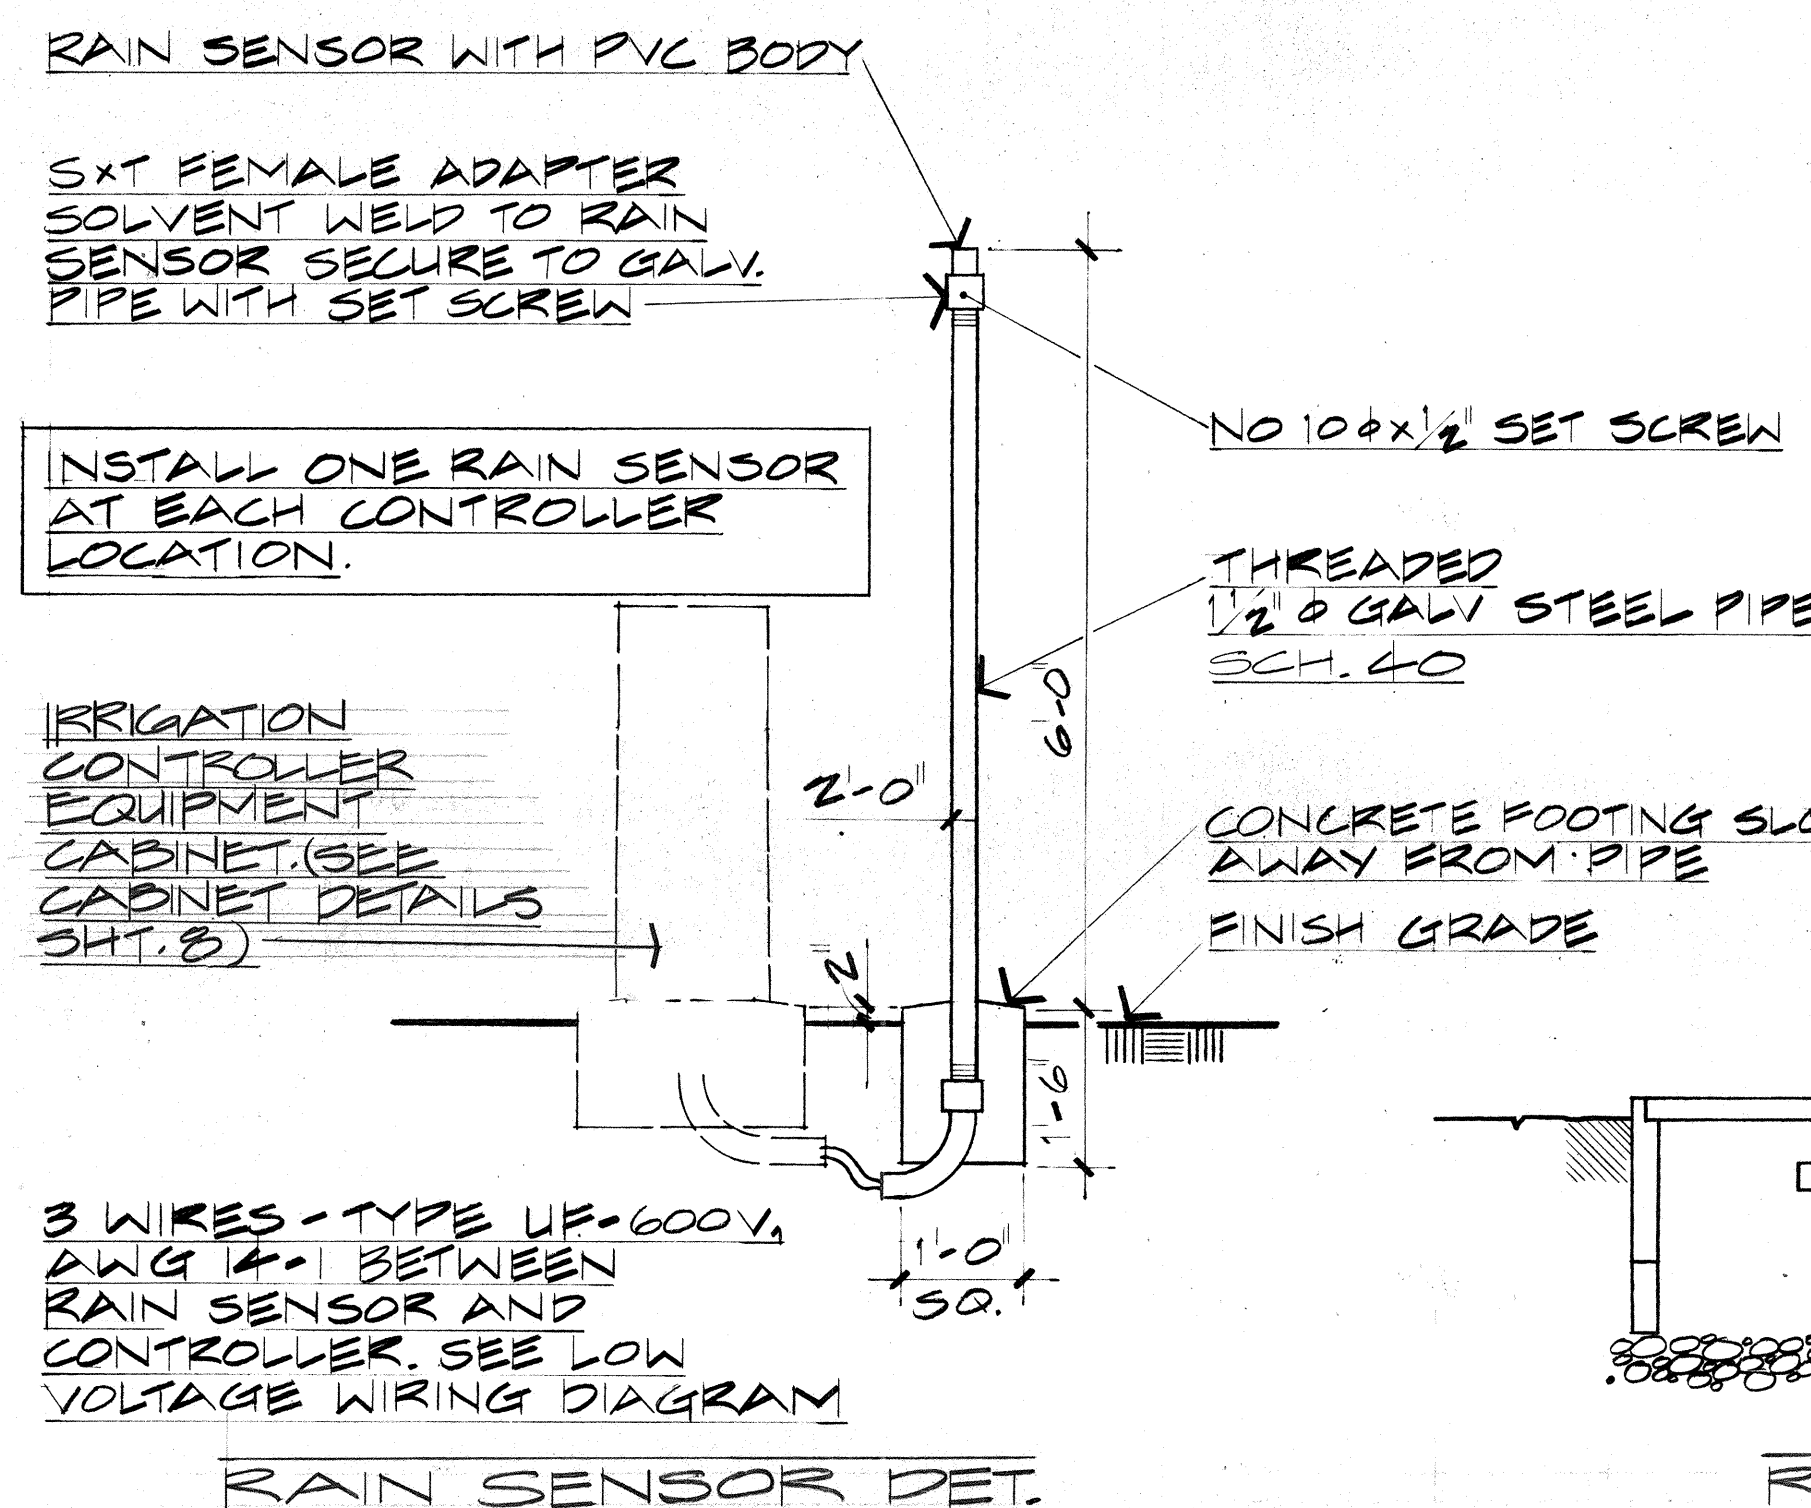
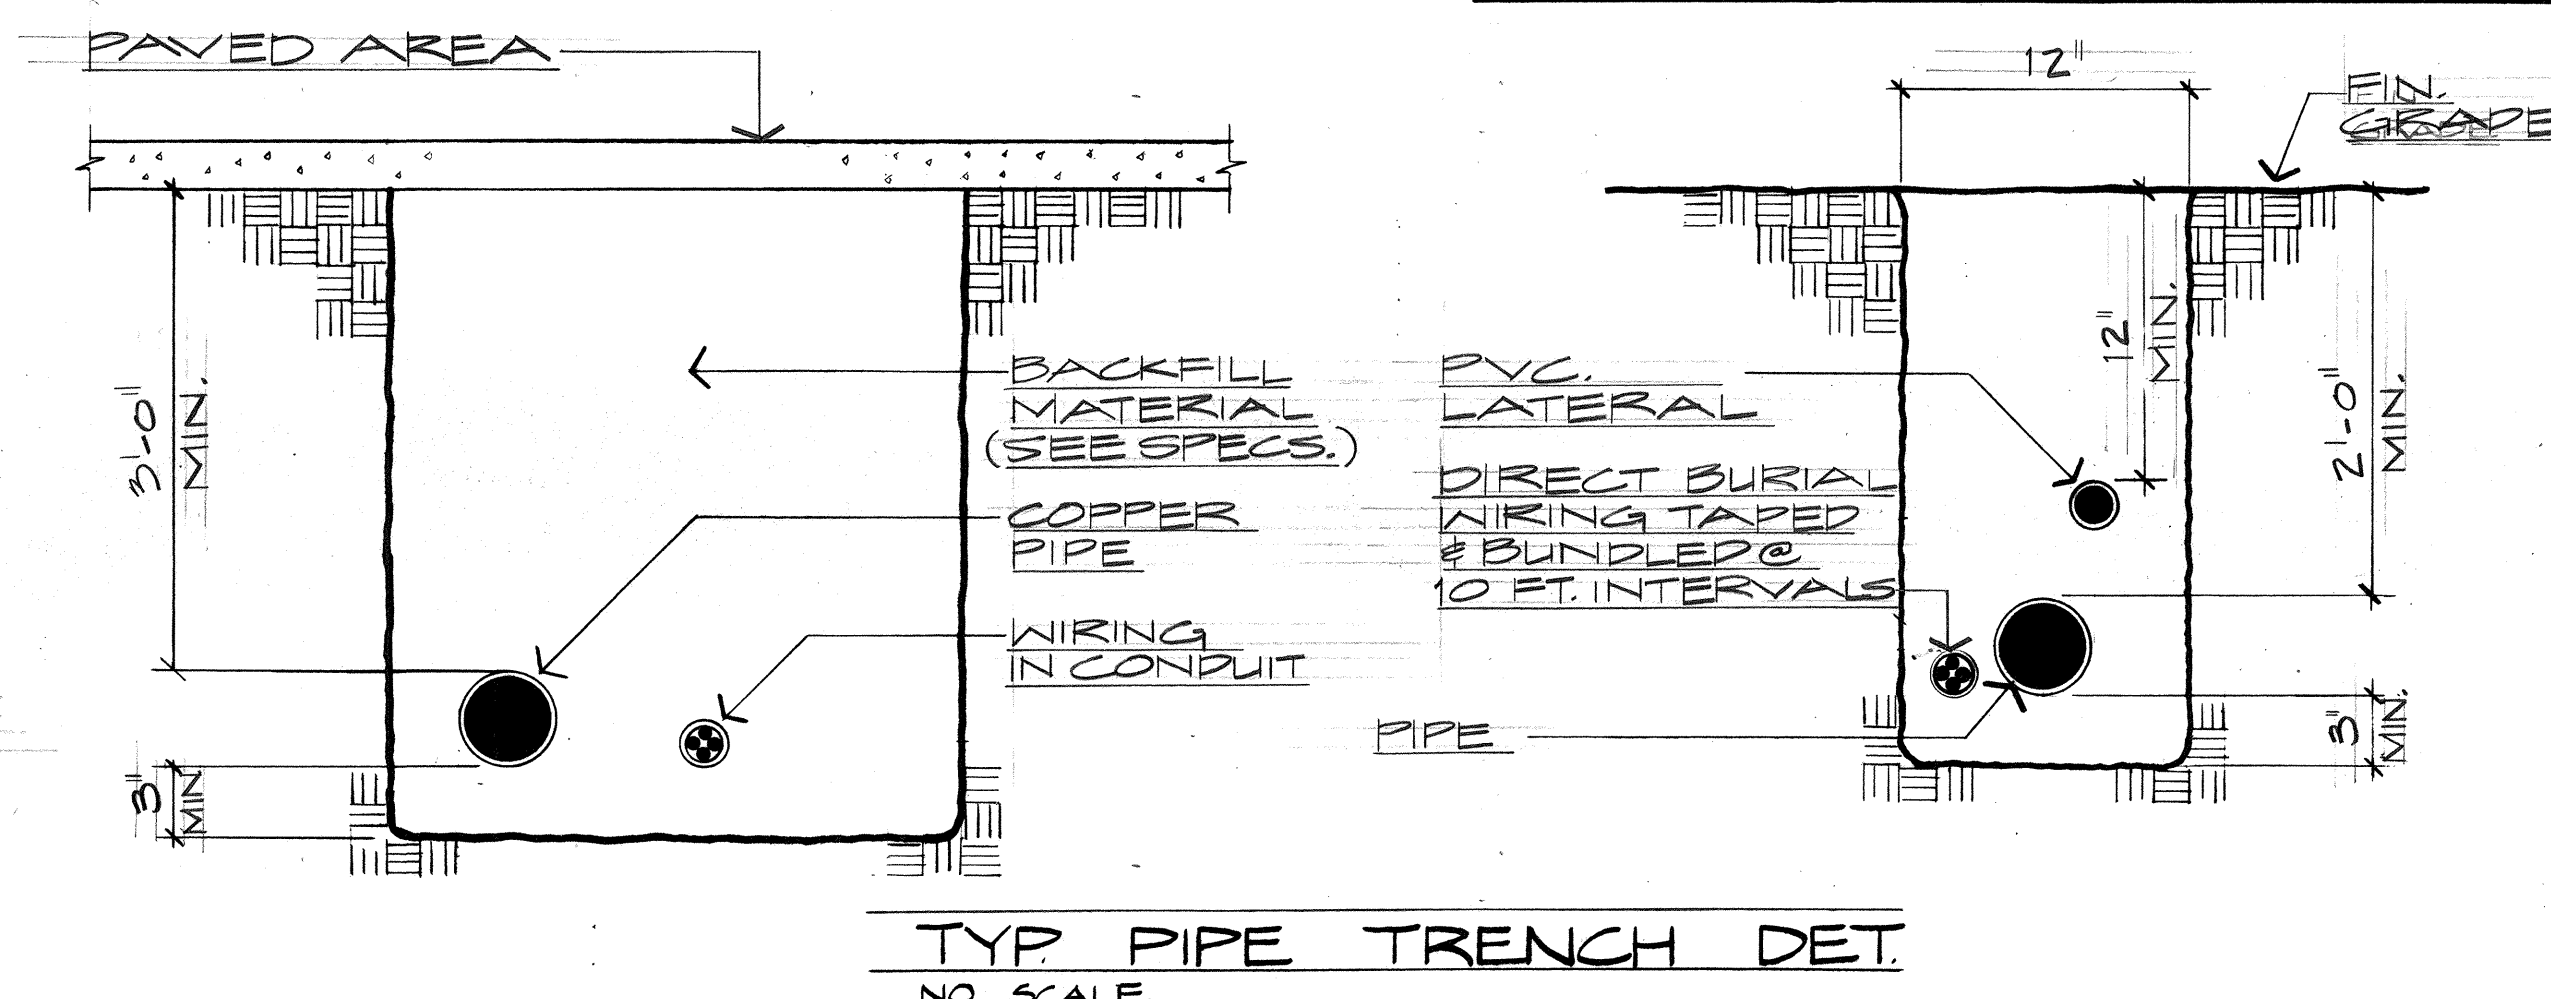
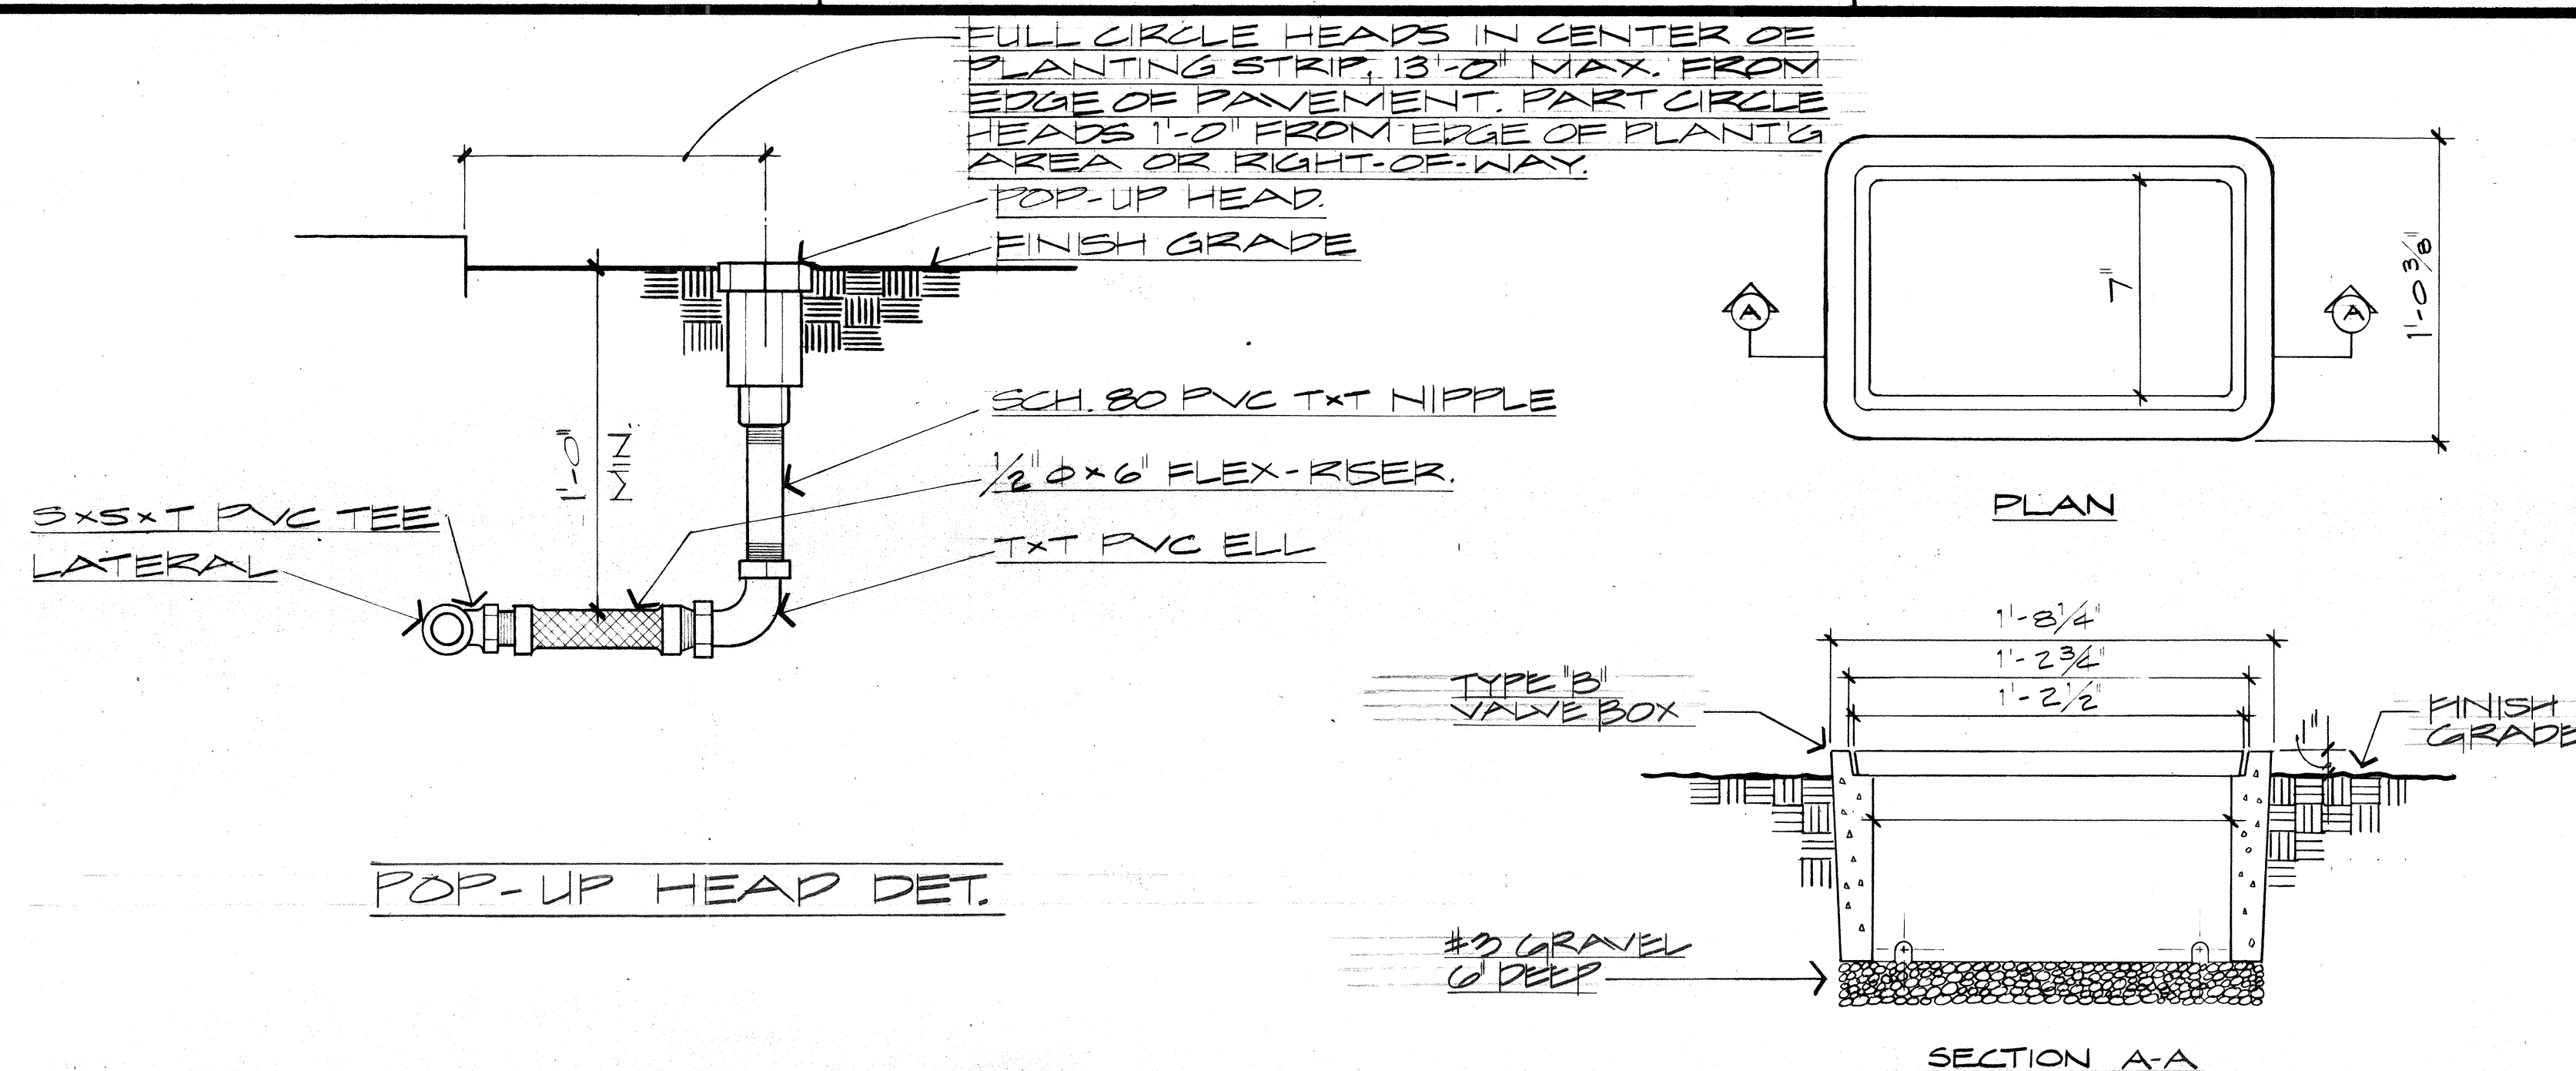


FED. ROAD DIST. NO.	STATE	PROJ. NO.	FISCAL YEAR	SHEET NO.	TOTAL SHEETS
HAWAII	HAW.	LT-K-05-78	1984	L-9	12

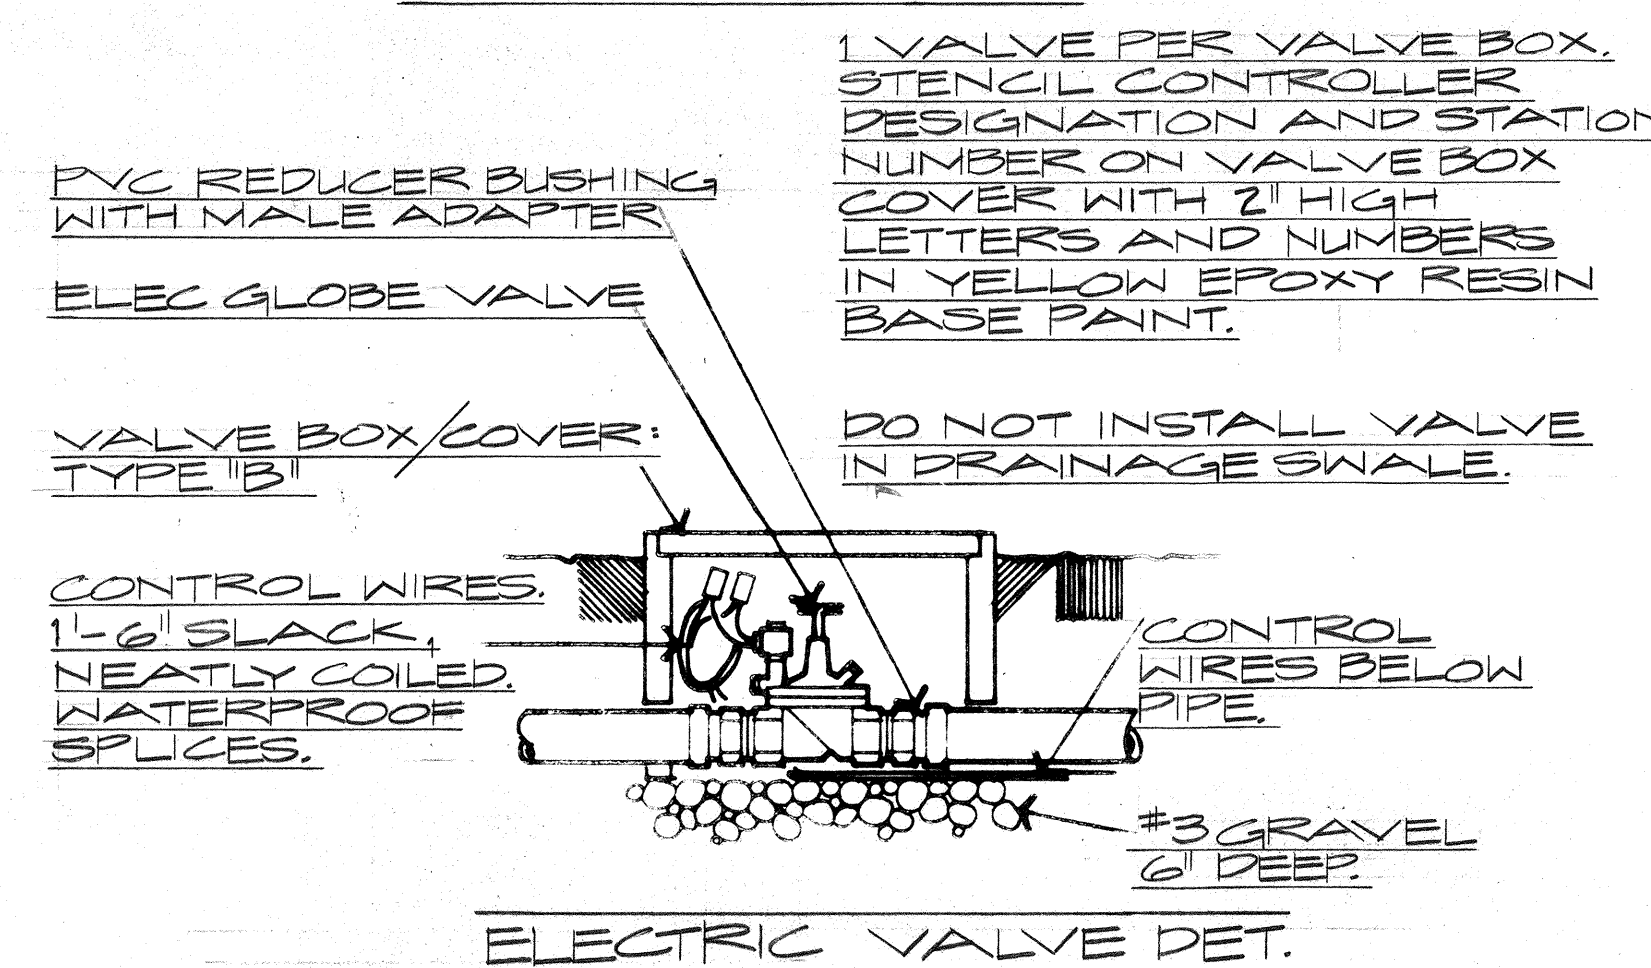

CONNECTION OF REVER VALVES TO MAIN:

1. INSTALL PRESSURE REVER VALVE AT END OF IRRIGATION MAIN.
2. TAP INTO TOP OF MAIN FOR AIR REVER VALVE.

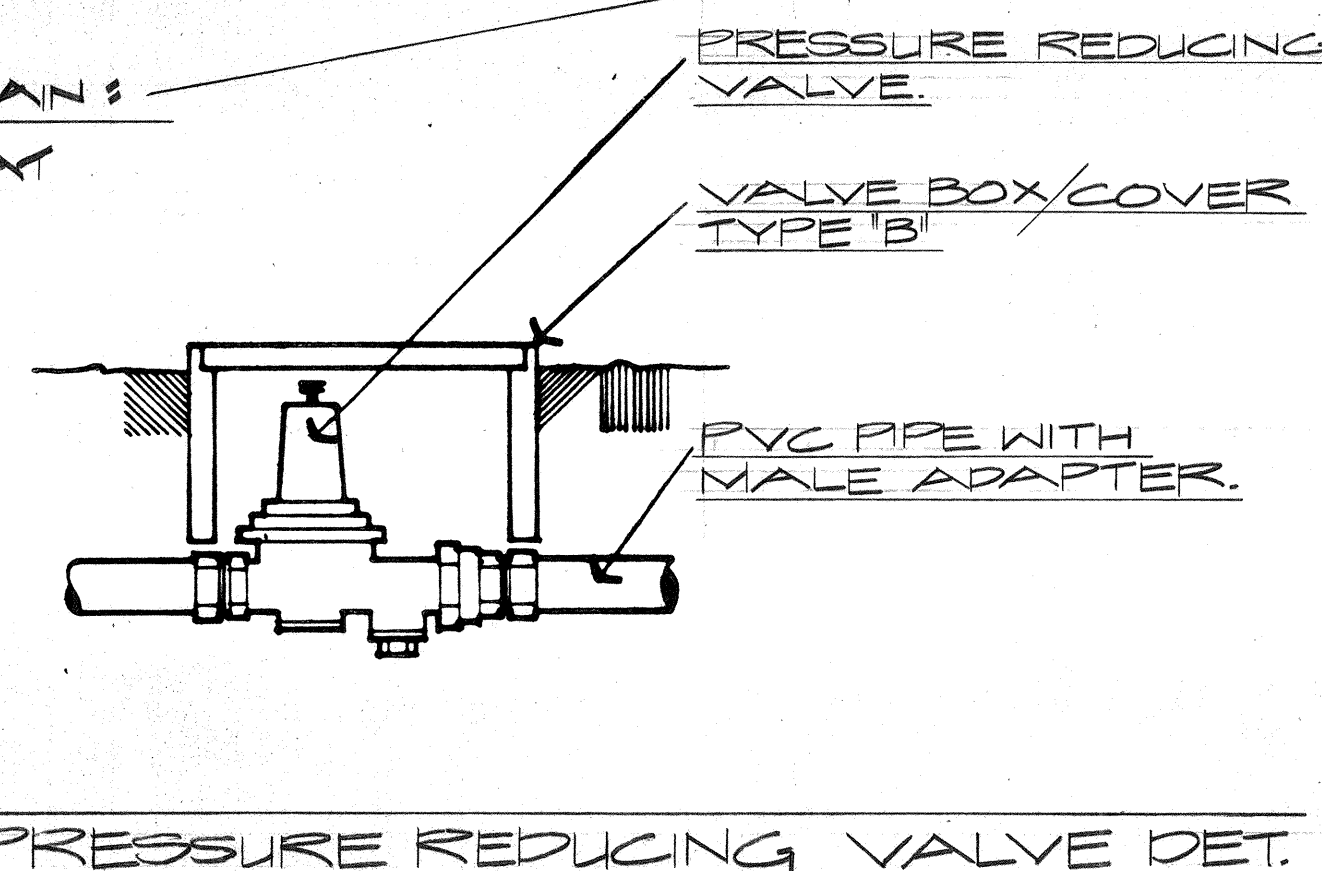

STATE OF HAWAII
DEPARTMENT OF TRANSPORTATION
HIGHWAYS DIVISION

LIHUE AIRPORT
GATEWAY BEAUTIFICATION

PROJECT NO. LT-K-05-78
SCALE: NO SCALE DATE: 1 FEB. 1984

SHEET NO. L-9 OF 12 SHEETS

IRRIGATION DETAILS