

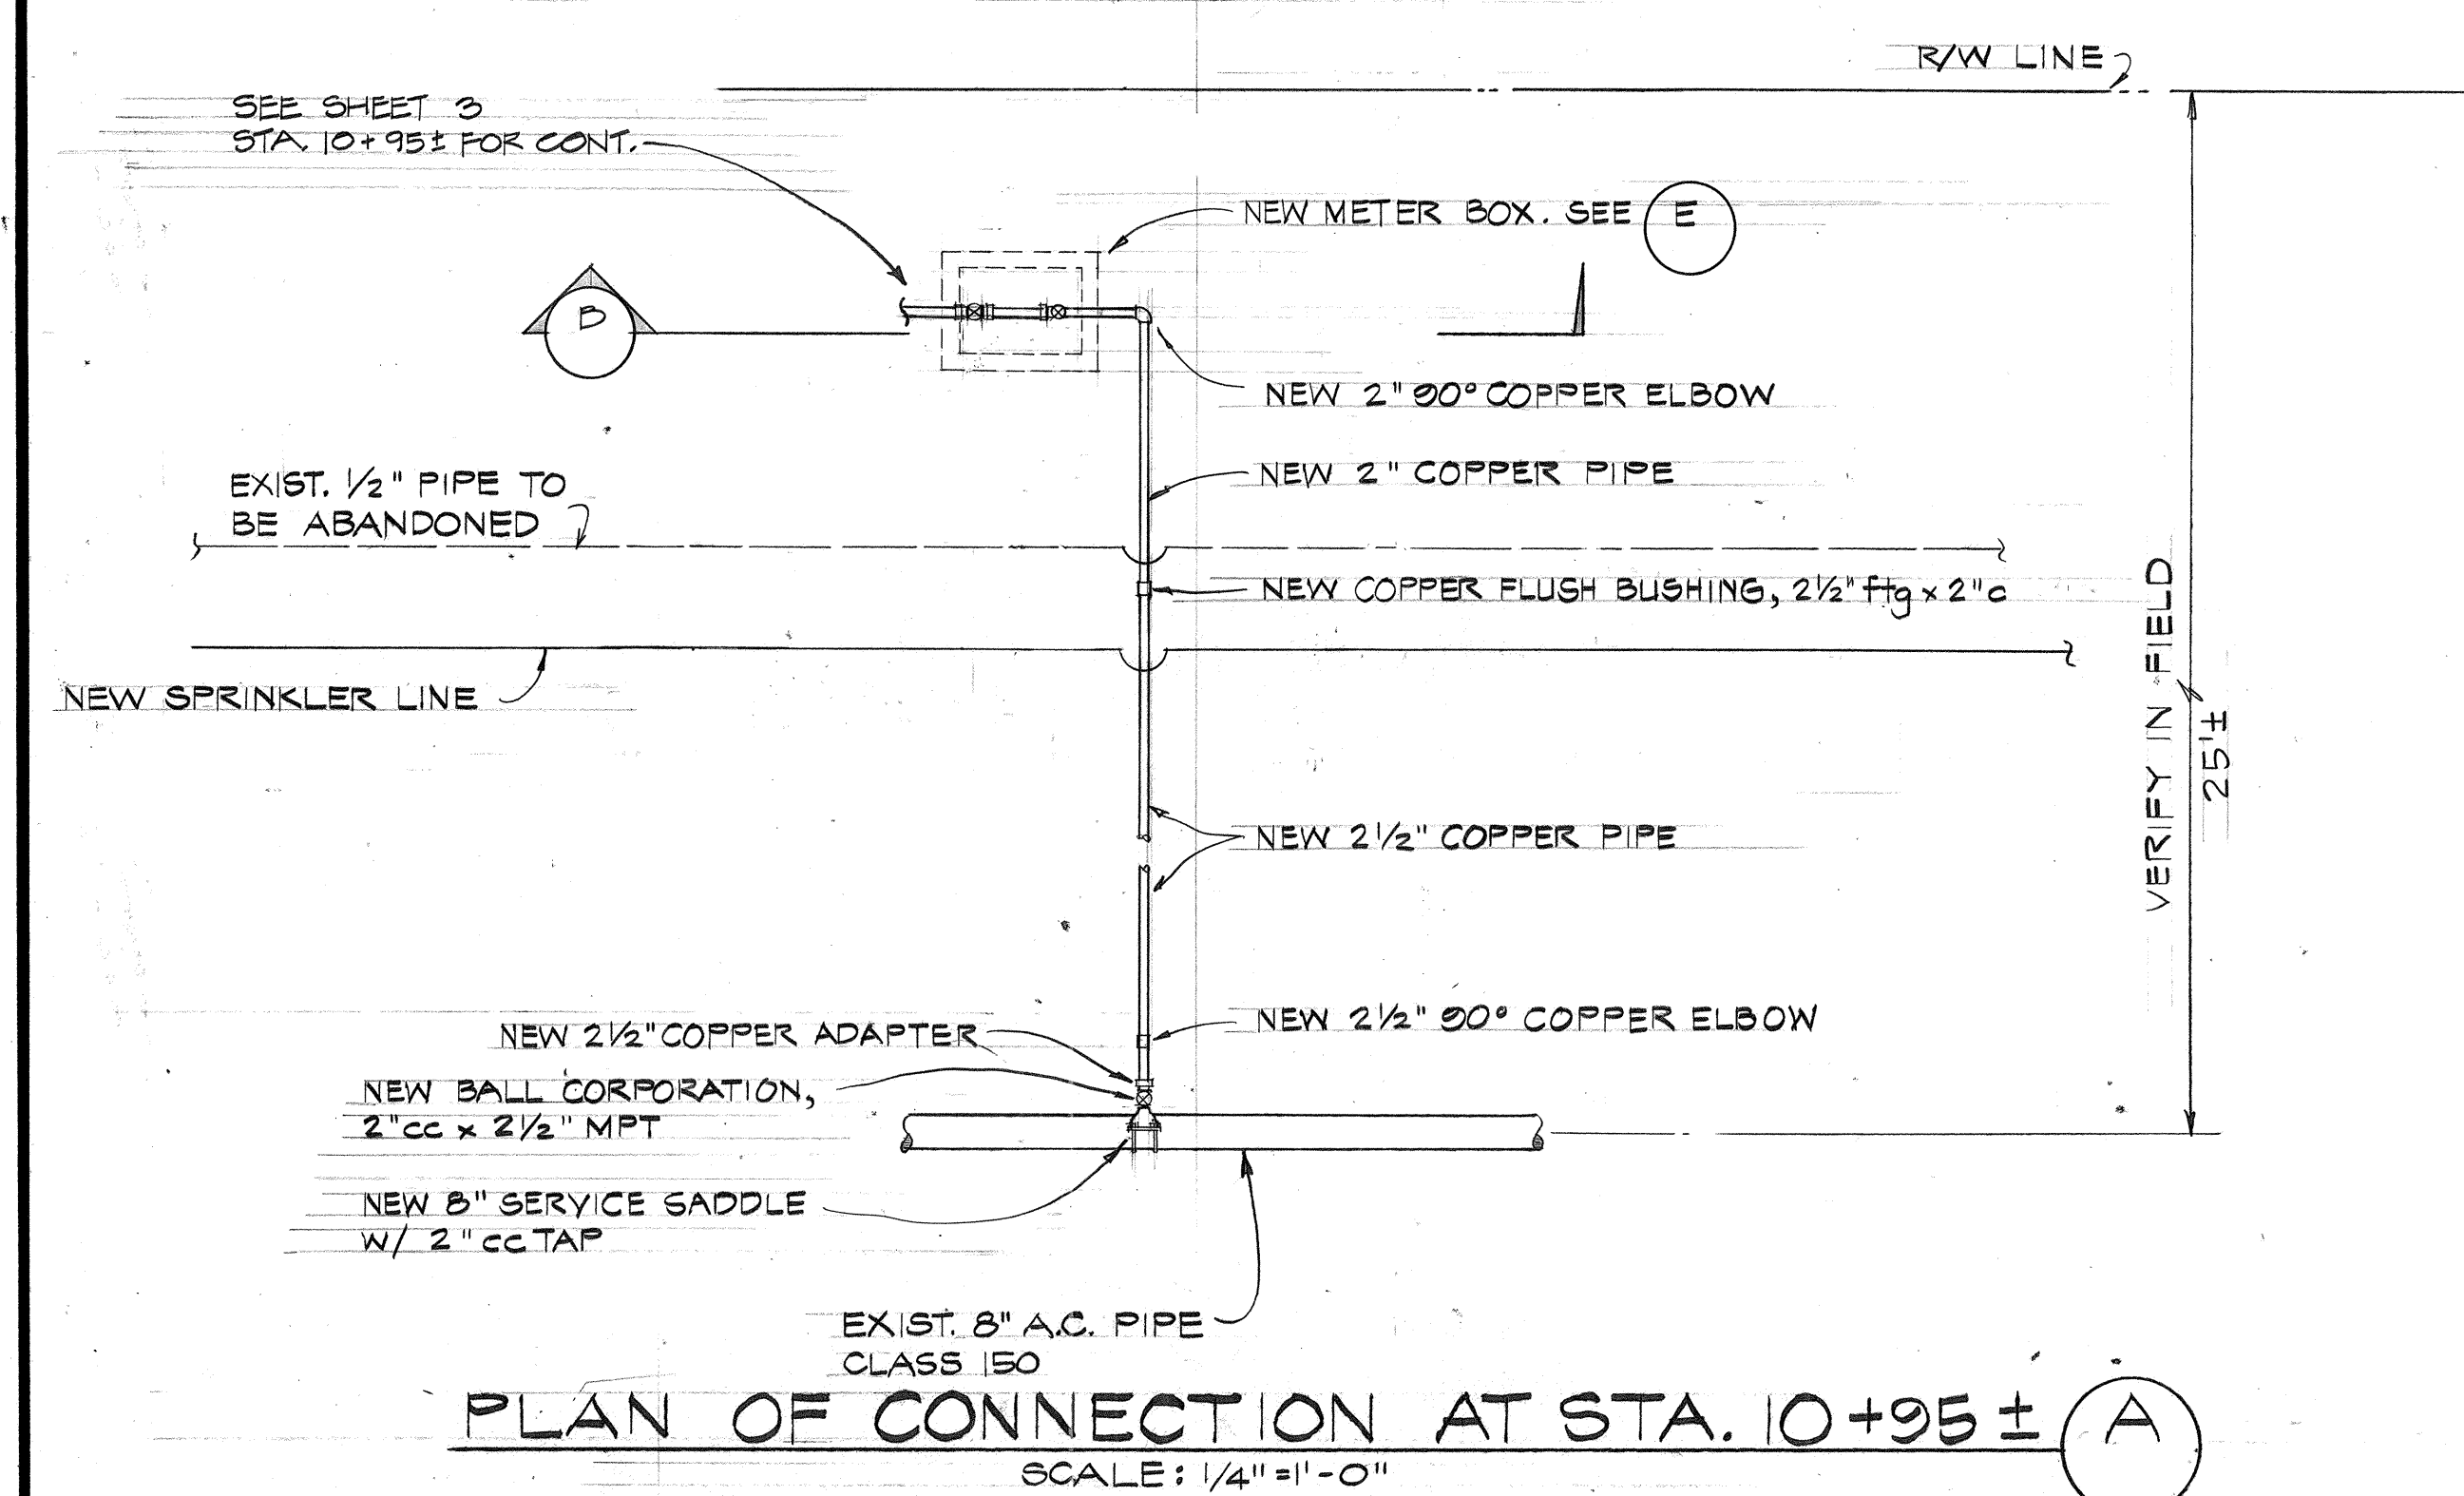
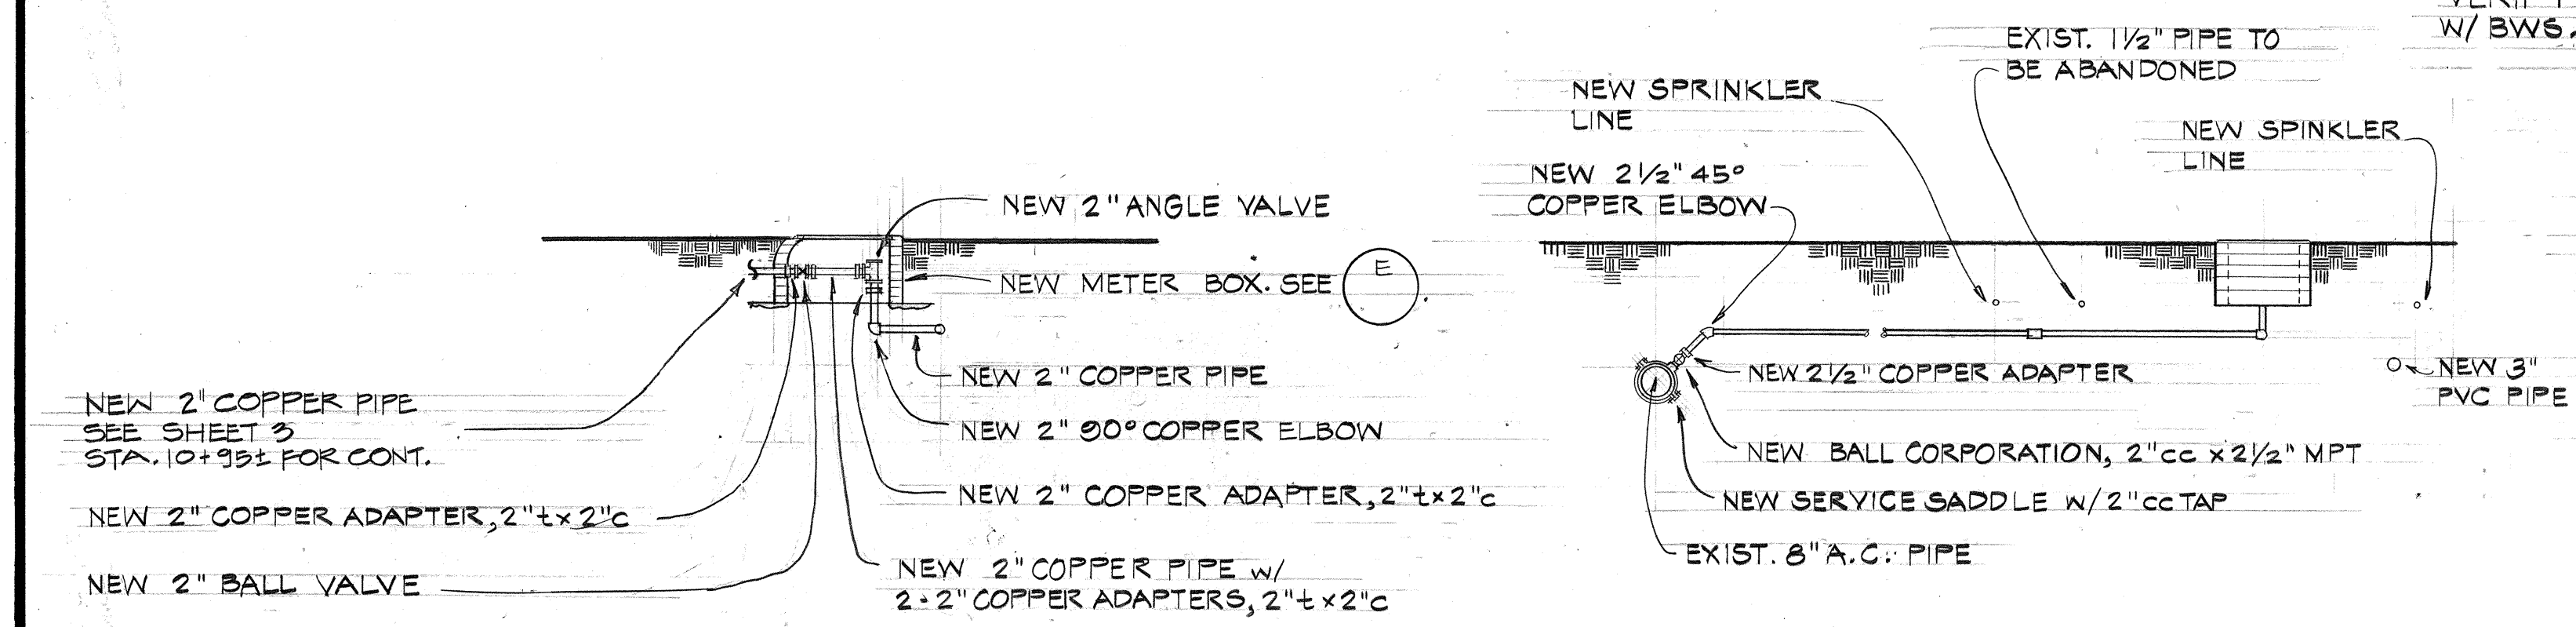


FED. ROAD DIST. NO.	STATE	PROJ. NO.	FISCAL YEAR	SHEET NO.	TOTAL SHEETS
HAWAII	HAW.	LT-K-05-78	1984	C-2	12

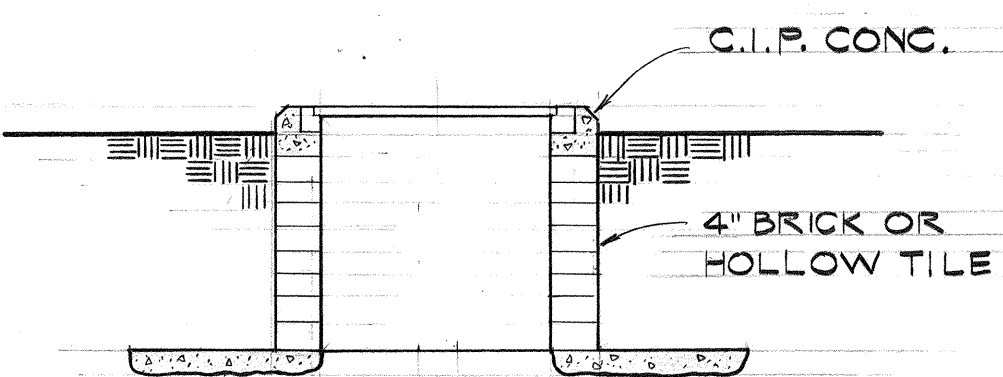

PLAN OF CONNECTION AT STA. 10+95± (A)
SCALE: 1/4" = 1'-0"

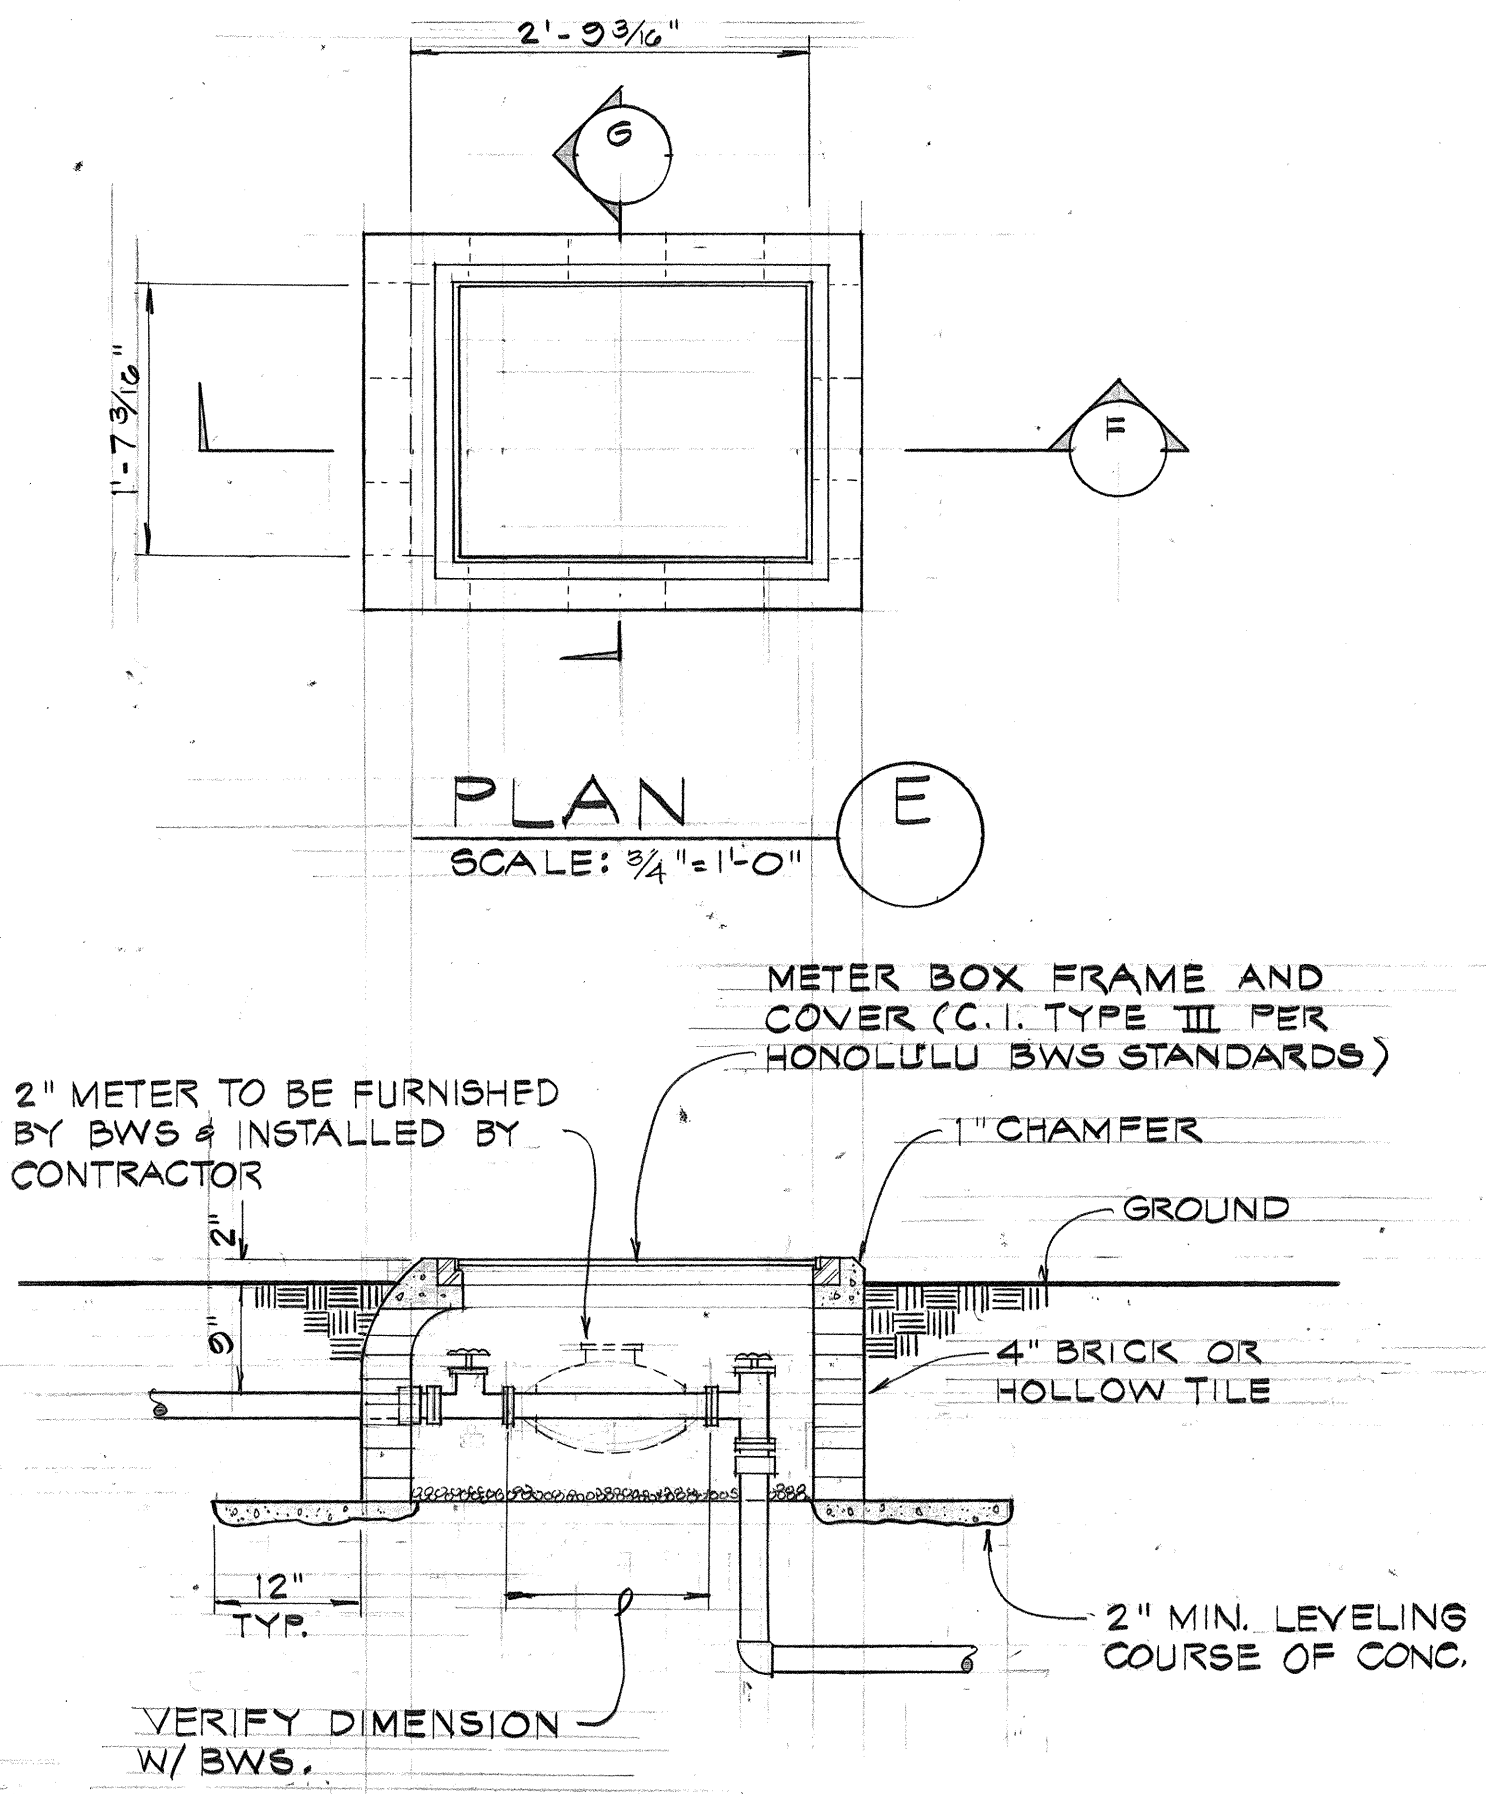

SECTION B
SCALE: 1/4" = 1'-0"

SECTION C
SCALE: 1/4" = 1'-0"

SECTION F
SCALE: 3/4" = 1'-0"

SECTION G
SCALE: 3/4" = 1'-0"

- GENERAL NOTES**
1. BACKFLOW PREVENTER SHALL BE THE REDUCED PRESSURE TYPE CONFORMING AWWA C506.
 2. COPPER PIPE SHALL BE SOFT TEMPER TYPE K AND SHALL CONFORM TO ASTM B-88.
 3. GALVANIZED STEEL PIPE SHALL BE "STANDARD WEIGHT" (SCHEDULE 40) CONFORMING TO ASTM A 120.

ORIGINAL PLAN	SURVEY PLOTTED BY	DATE
NOTE BOOK	DRAWN BY	
	DESIGNED BY	
	CHECKED BY	

STATE OF HAWAII
DEPARTMENT OF TRANSPORTATION
HIGHWAYS DIVISION

WATER SERVICE

**LIHUE AIRPORT
GATEWAY BEAUTIFICATION**

PROJECT NO. LT-K-05-78

SCALE: AS SHOWN DATE: 1 FEB 1984

SHEET No. C-2 OF 12 SHEETS

MANAGER & CHIEF ENGINEER, DEPT. OF WATER
COUNTY OF KAUAI

DATE