




FED. ROAD DIST. NO.	STATE	FED. AID PROJ. NO.	FISCAL YEAR	SHEET NO.	TOTAL SHEETS
HAWAII	HAW.	F-051-1(4)	1984	3	65

PLAN	DATE	BY
SURVEYED		
NOTE BOOK		
NO.		

PROFILE	DATE	BY
SURVEYED		
NOTE BOOK		
NO.		

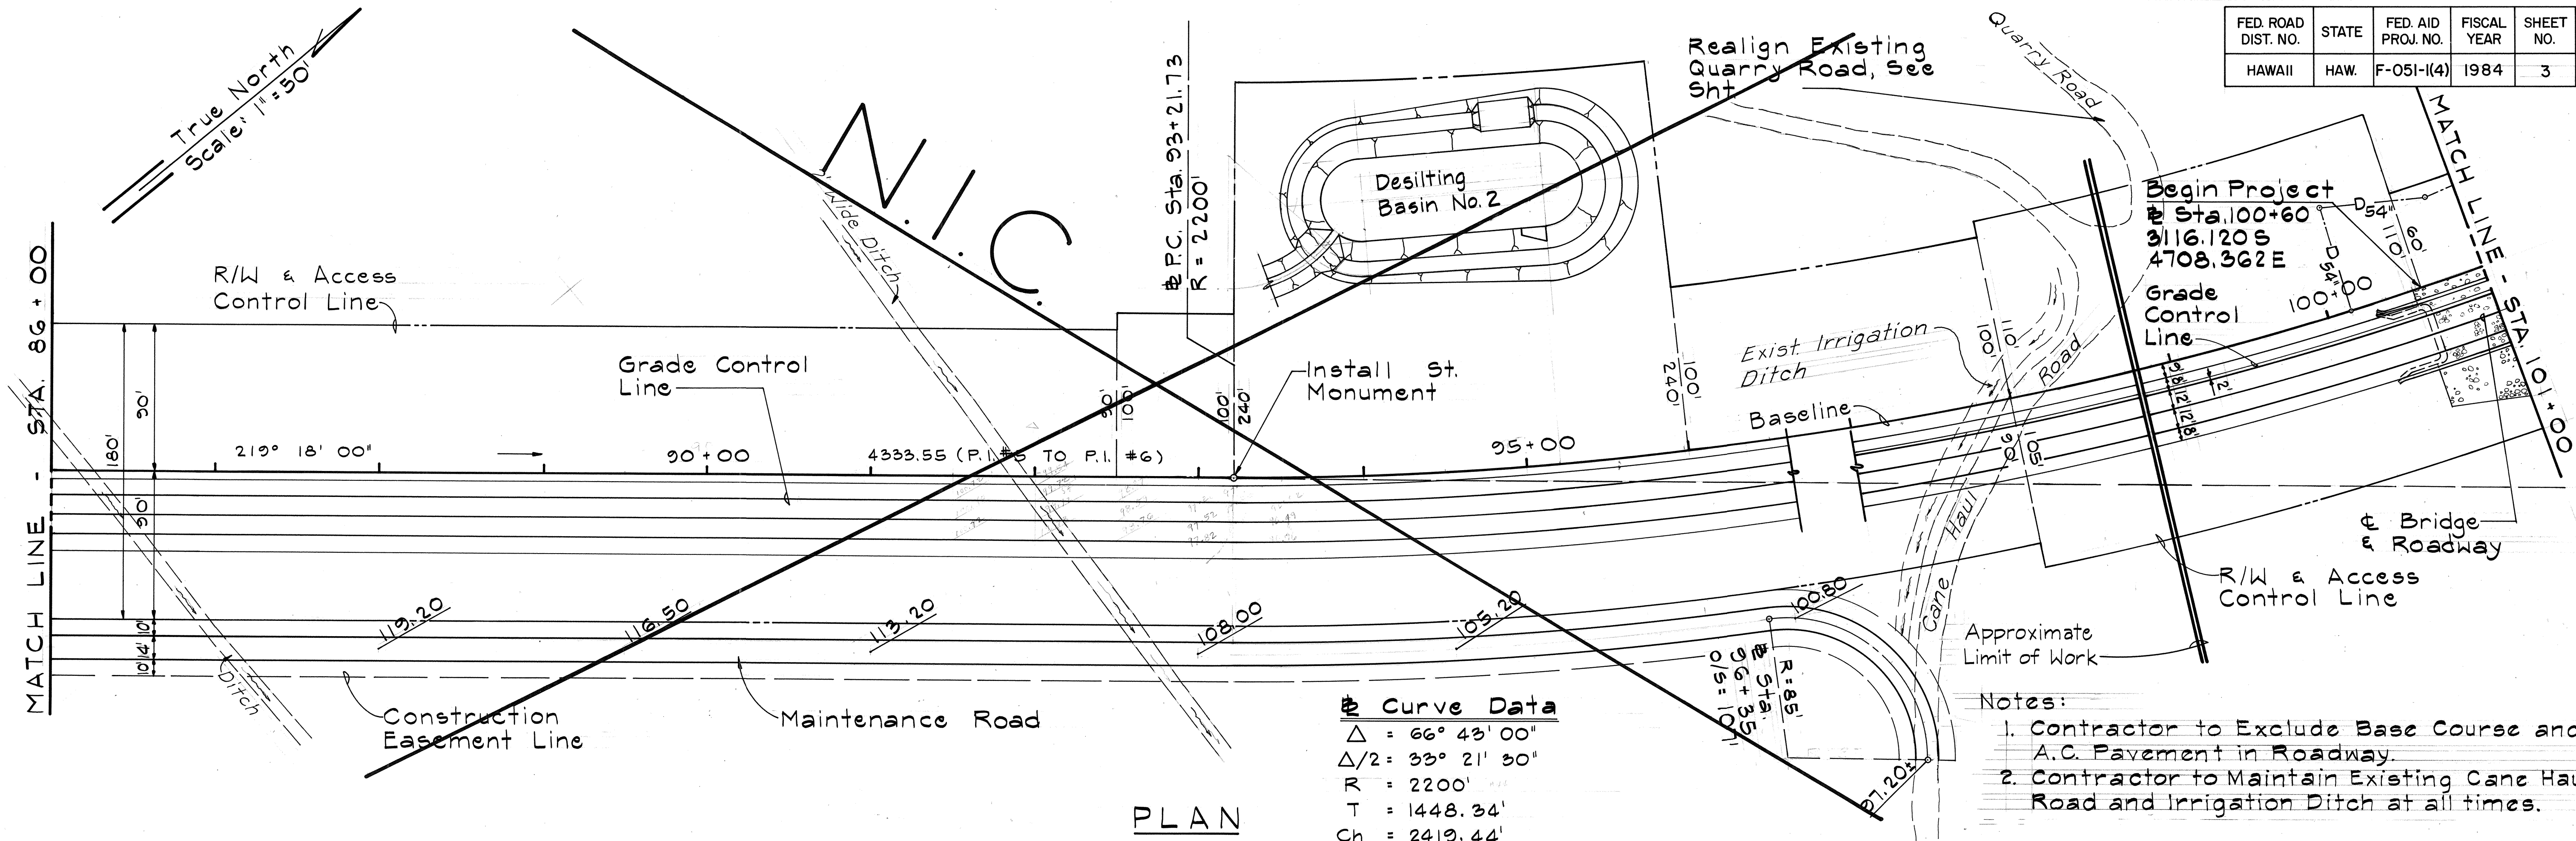

- Notes:
1. Contractor to Exclude Base Course and A.C. Pavement in Roadway.
 2. Contractor to Maintain Existing Cane Haul Road and Irrigation Ditch at all times.

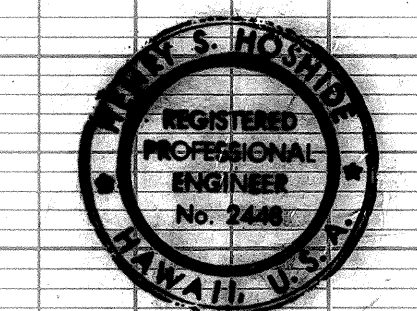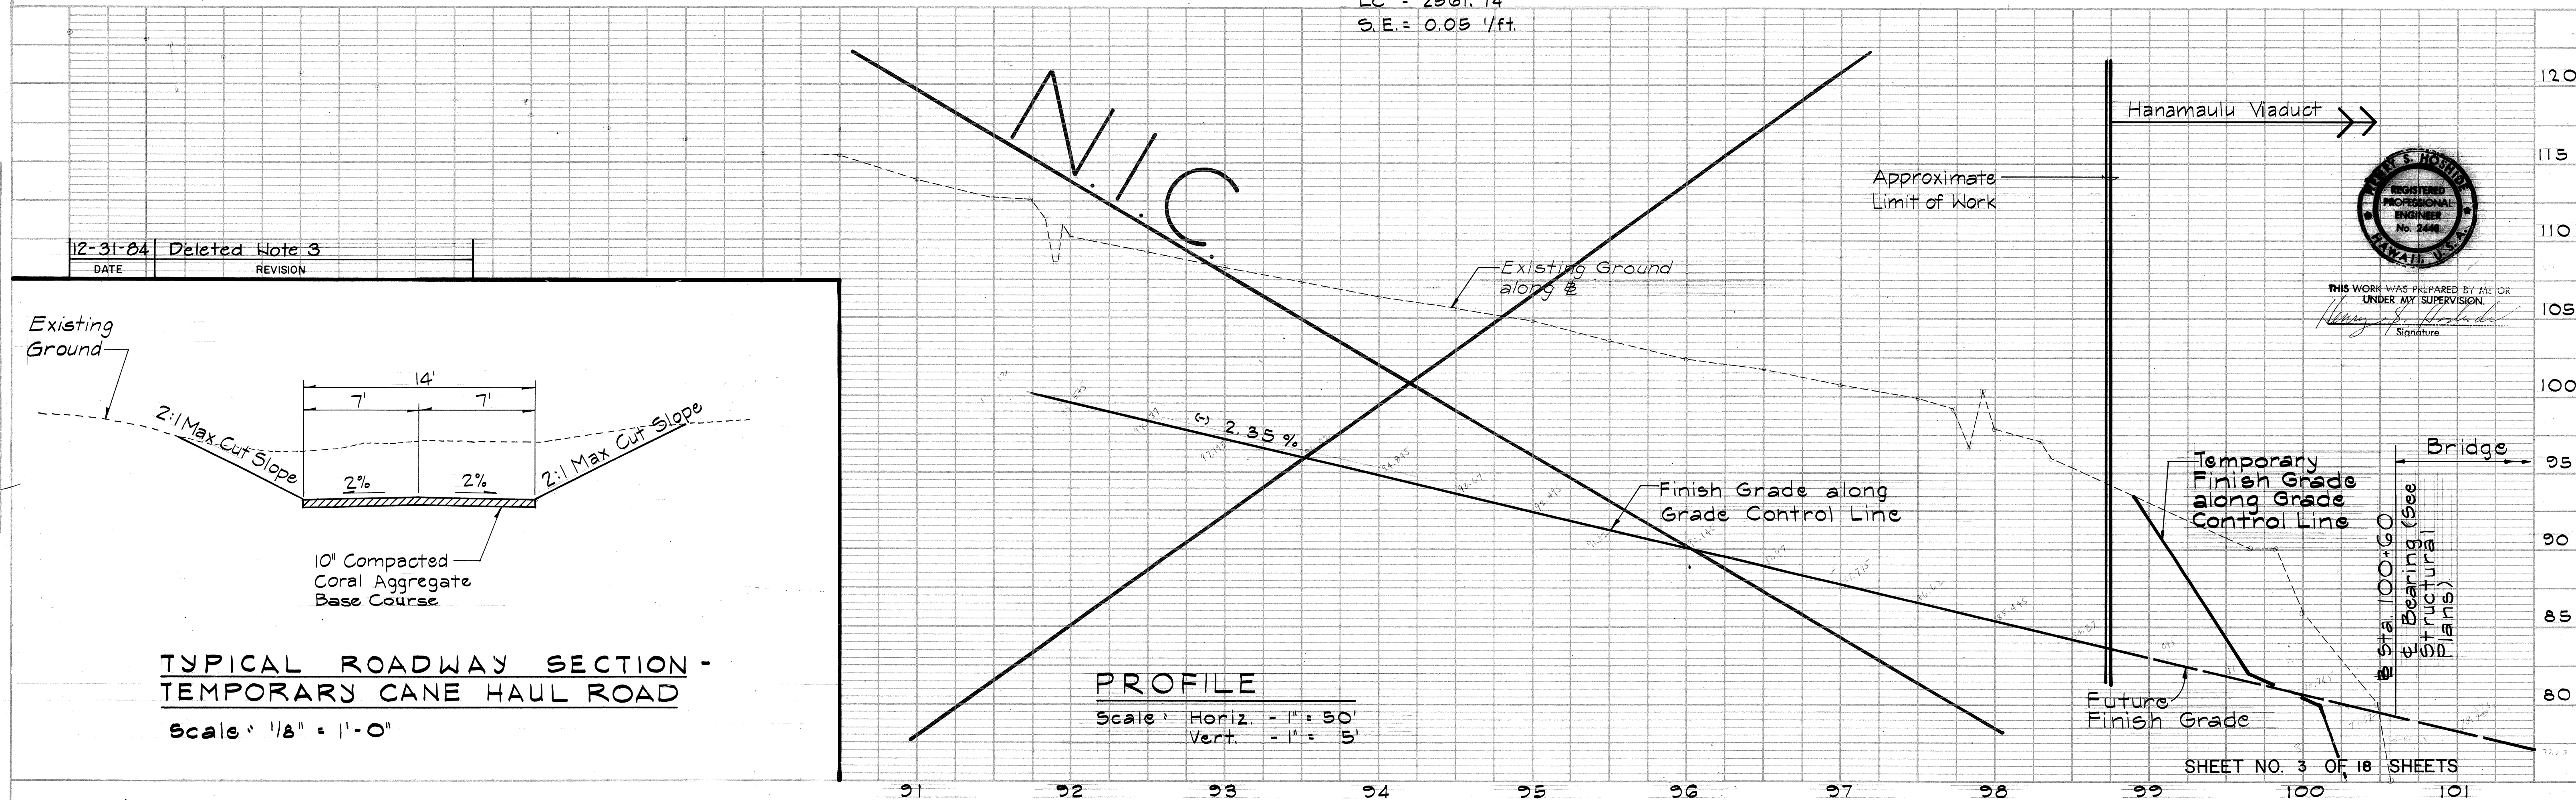

THIS WORK WAS PREPARED BY ME OR UNDER MY SUPERVISION.

Signature

SHEET NO. 3 OF 18 SHEETS

ADD. 3

