



FED. ROAD DIST. NO.	STATE	FED. AID PROJ. NO.	FISCAL YEAR	SHEET NO.	TOTAL SHEETS
HAWAII	HAW.	F-051-1(4)	1984	5	65

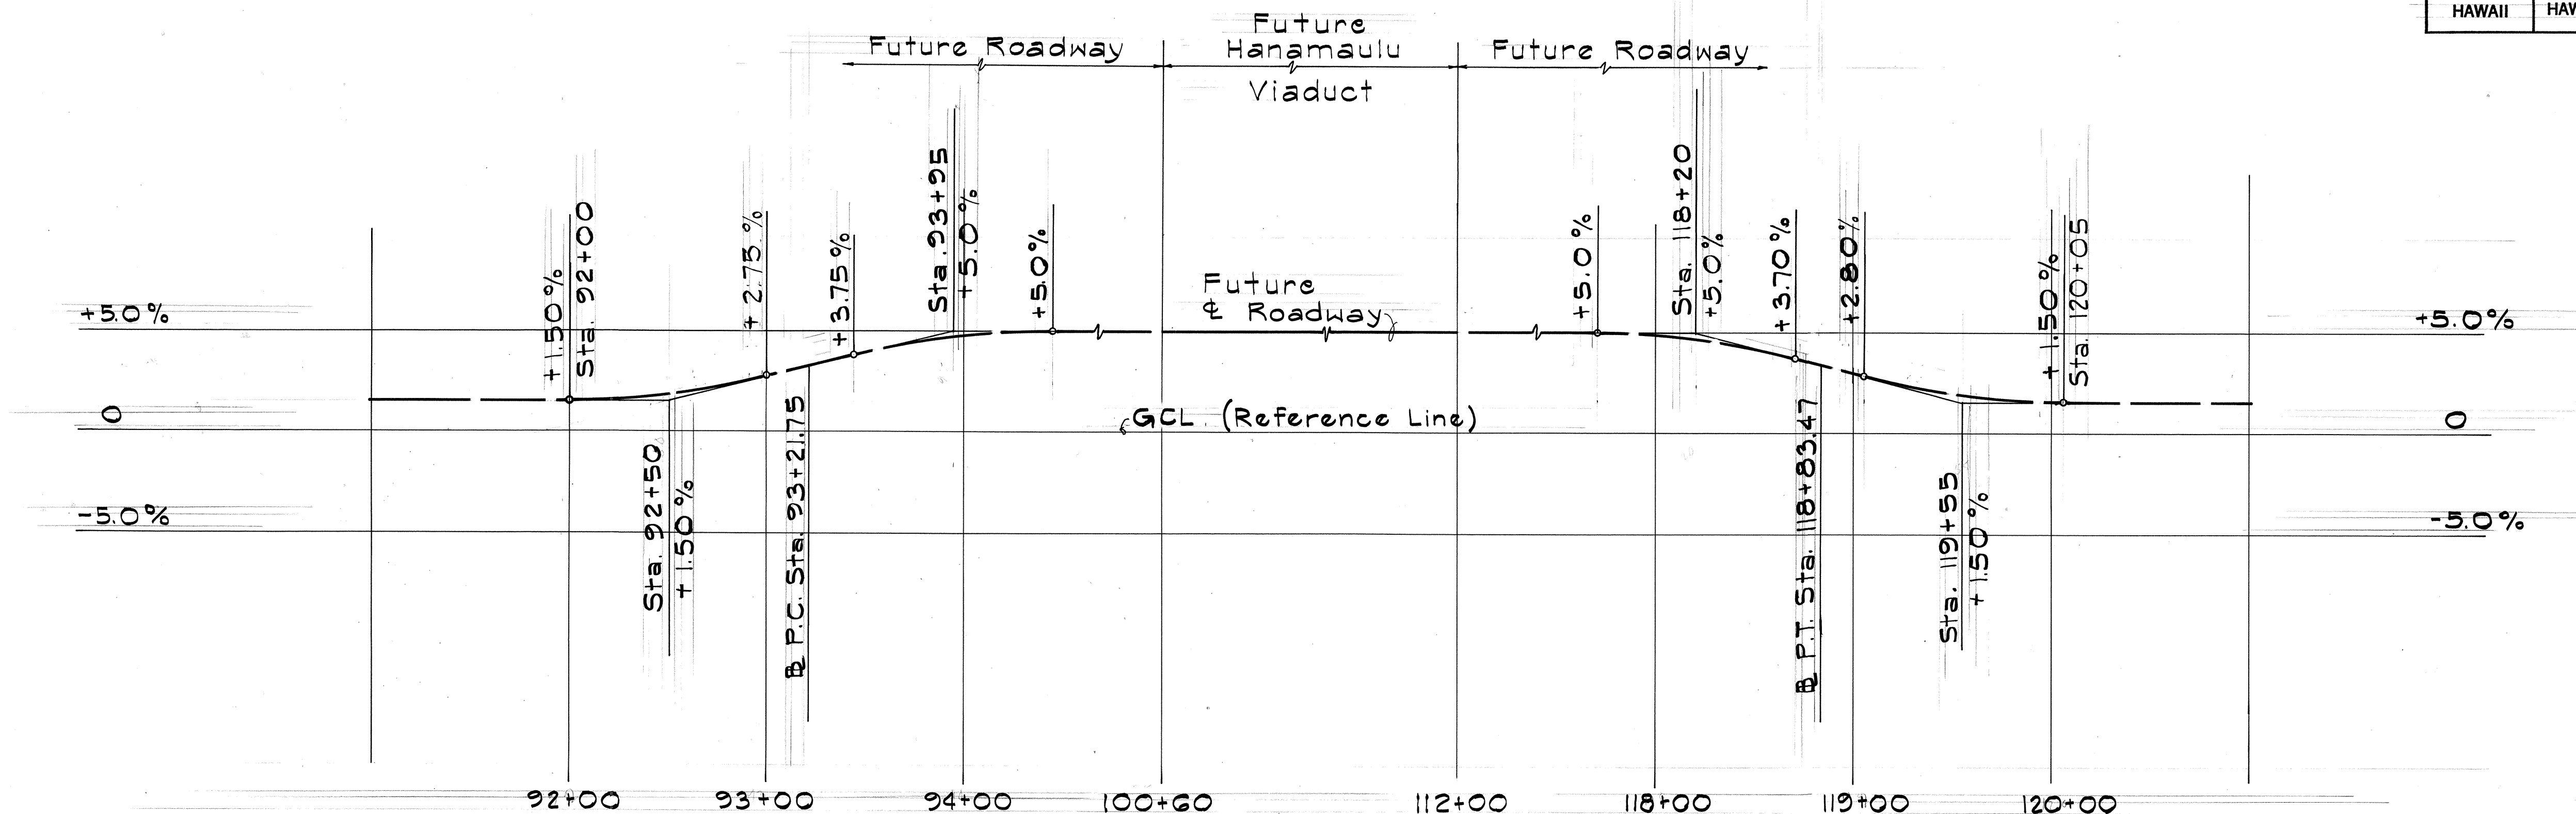

Superelevation Diagram B Sta. 92+00 to 120+05

Scale: Horiz. 1" = 50'
Vert. 1" = 5.0%


Note:
All Rounding = 100' V.C.

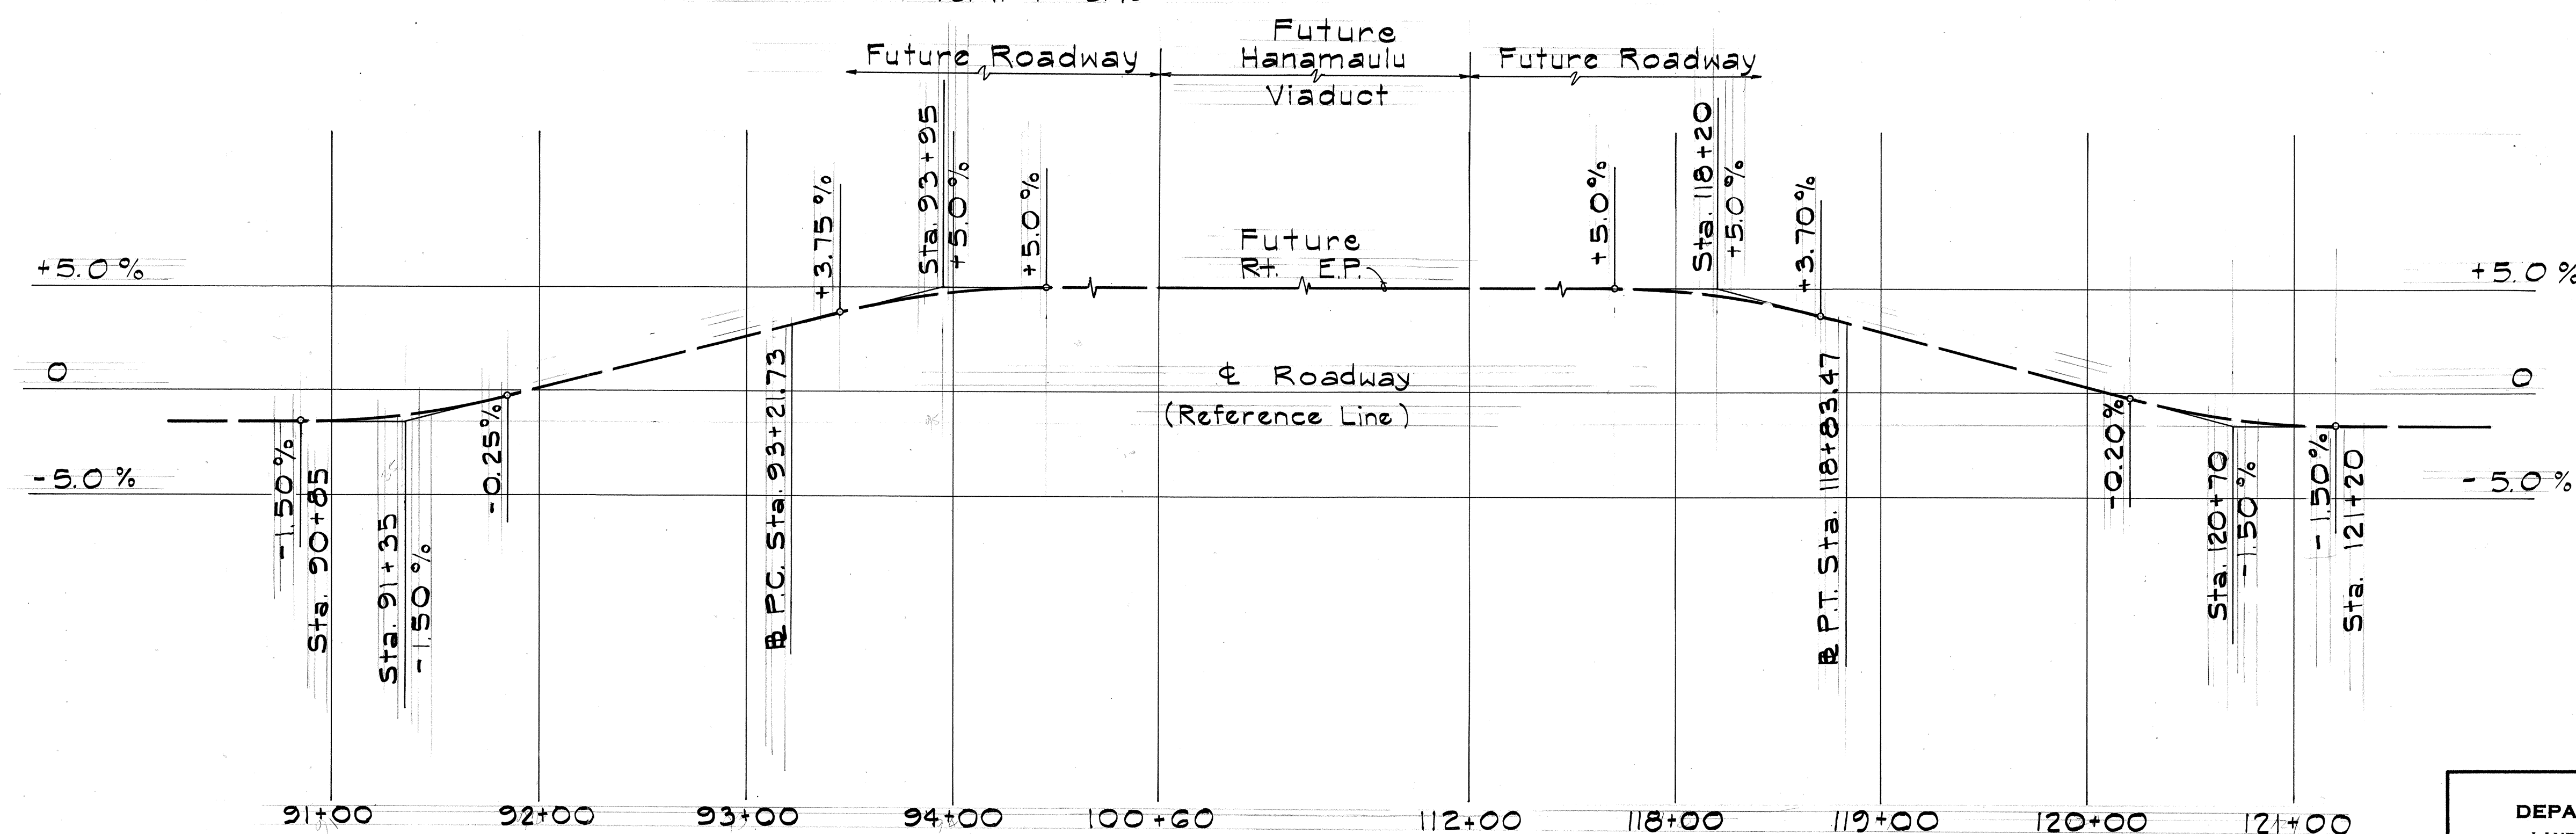

Superelevation Diagram B Sta. 90+85 to 121+20

Scale: Horiz. 1" = 50'
Vert. 1" = 5.0%

Note:
All Rounding = 100' V.C.

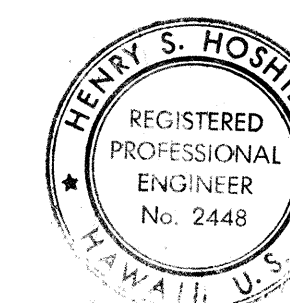

THIS WORK WAS PREPARED BY ME OR
UNDER MY SUPERVISION
Henry S. Hoshide
Signature

STATE OF HAWAII
DEPARTMENT OF TRANSPORTATION
LAND TRANSPORTATION FACILITIES DIVISION

SUPERELEVATION DIAGRAM
HANAMAULU VIADUCT
HANAMAULU-AHUKINI CUTOFF RD
(Ahukini Road to Kauai Hardwoods)
Federal Aid Proj. No. F-051-1(4)
Scale: As shown Date: May, 1983
SHEET NO. 5 OF 18 SHEETS

ORIGINAL PLAN	SURVEY PLOTTED BY	DATE
NOTE BOOK	DRAWN BY	"
No.	DESIGNED BY	"
	QUANTITIES BY	"
	CHECKED BY	"