



FED. ROAD DIST. NO.	STATE	FED. AID PROJ. NO.	FISCAL YEAR	SHEET NO.	TOTAL SHEETS
HAWAII	HAW.	F051-1(8)	1986	29	62

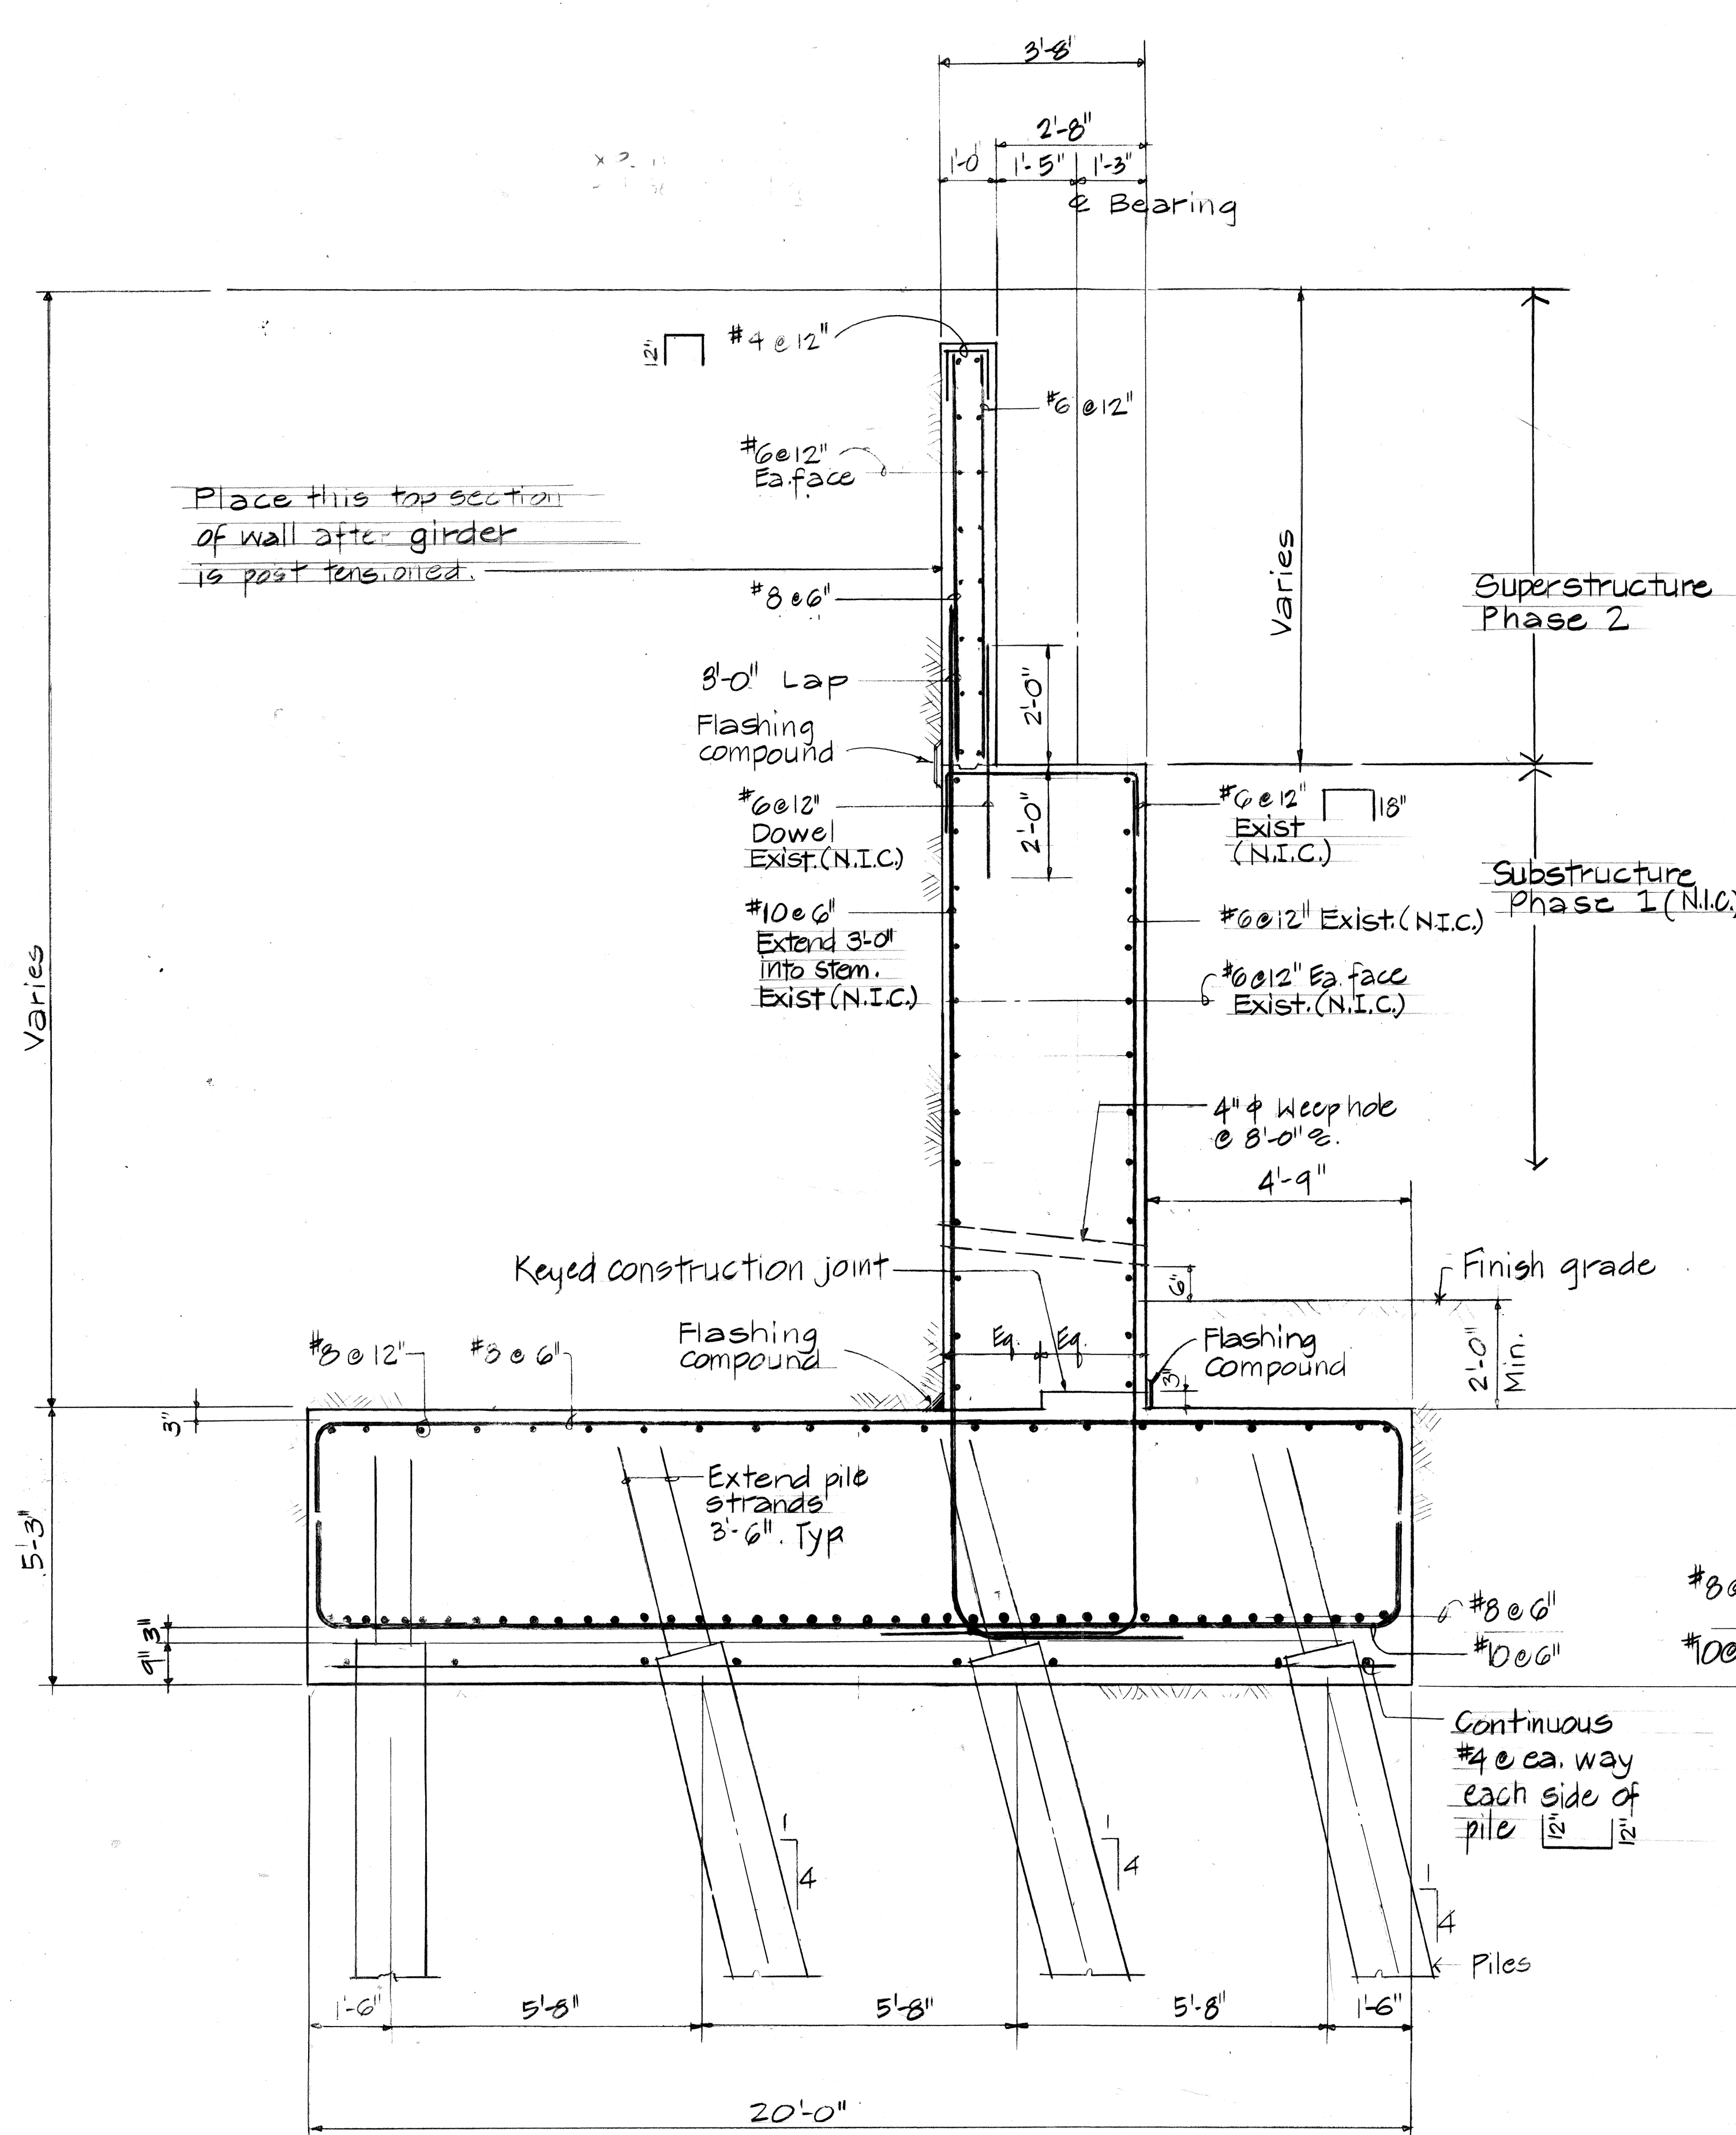


SECTION A-8
Scale: 1/2" = 1'-0"

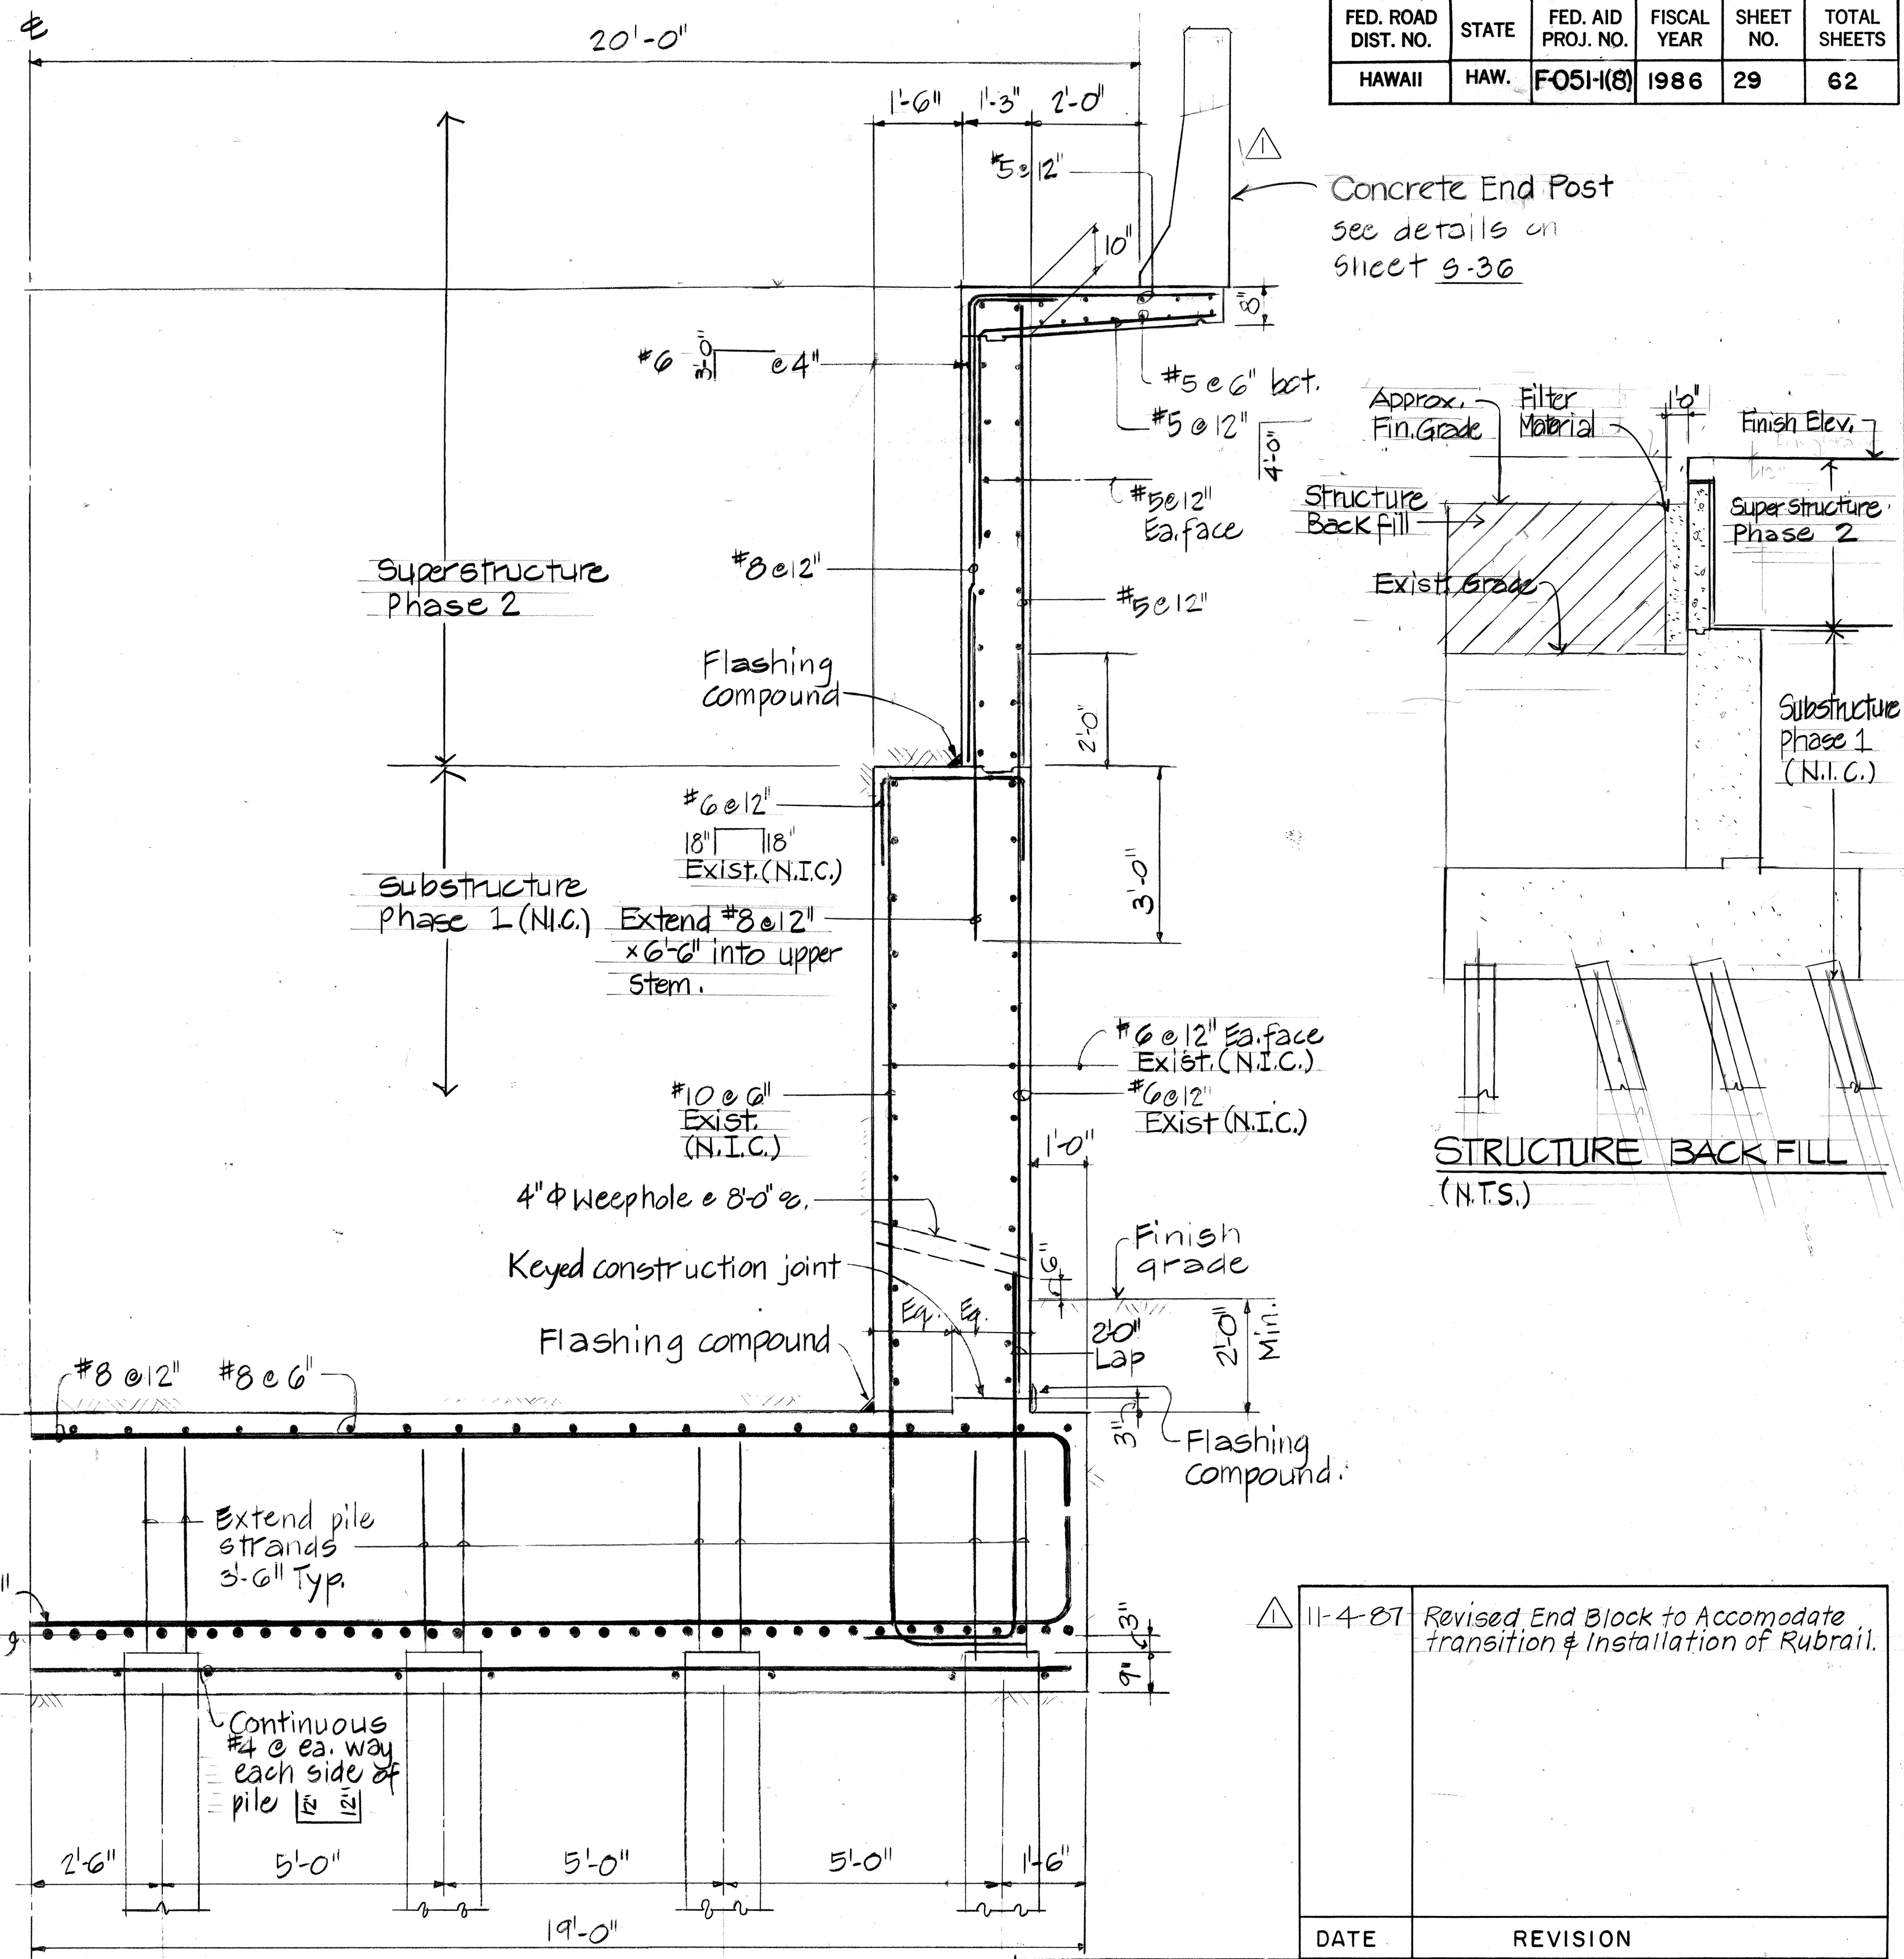

SECTION B-8
Scale: 1/2" = 1'-0"

11-4-87 Revised End Block to Accommodate transition & Installation of Rubrail.

DATE	REVISION
------	----------

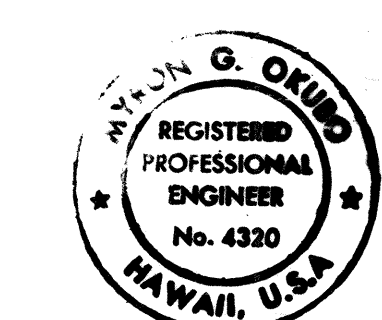

THIS WORK WAS PREPARED BY ME OR UNDER MY SUPERVISION.
Myron G. Orino
Signature

STATE OF HAWAII
DEPARTMENT OF TRANSPORTATION
LAND TRANSPORTATION FACILITIES DIVISION
ABUTMENT SECTIONS

HANAMAULU VIADUCT
HANAMAULU-AHUKINI CUTOFF ROAD
Ahukini Road to Kauai Hardwoods
PROJECT NO. F-051-1(8)
SCALE: 1/2" = 1'-0" DATE: JULY 1985
SHEET No. 8 OF 39 SHEETS

ORIGINAL PLAN	DATE
SURVEY PLOTTED BY	
DRAWN BY	
DESIGNED BY	
QUANTITIES BY	
CHECKED BY	