



Notes:

1. Transverse reinforcement to be placed radially to Φ Bridge.
2. Longitudinal reinforcement to be placed parallel to Φ girder.
3. 4" Fillet not subject to value engineering.

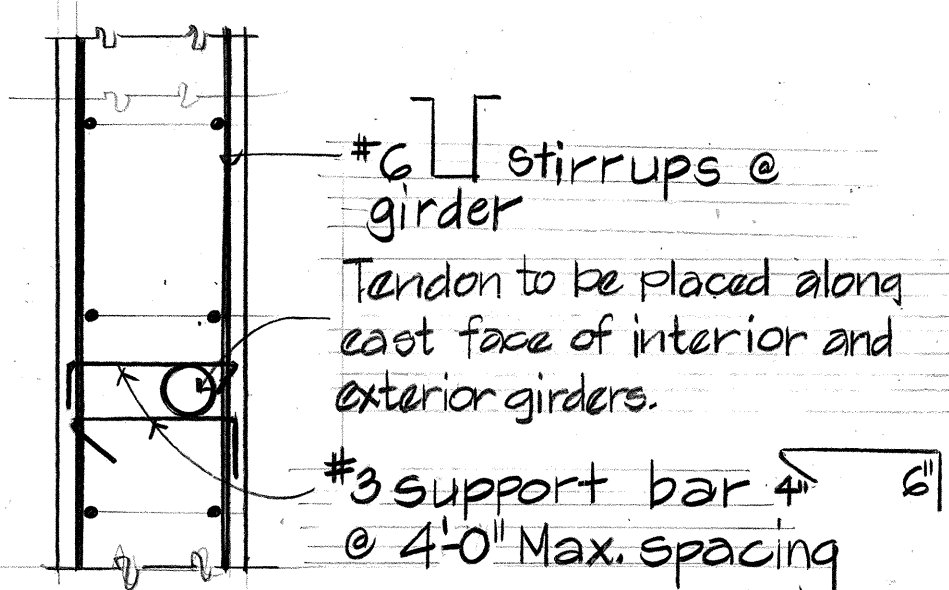

BRIDGE DECK - PARTIAL PLAN
TOP BAR PLACEMENT DIAGRAM
Scale: $\frac{3}{8}'' = 1'-0''$

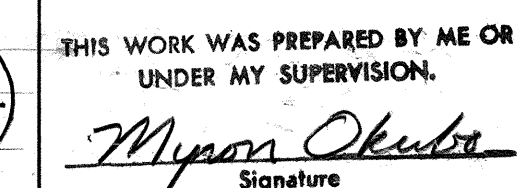

36