
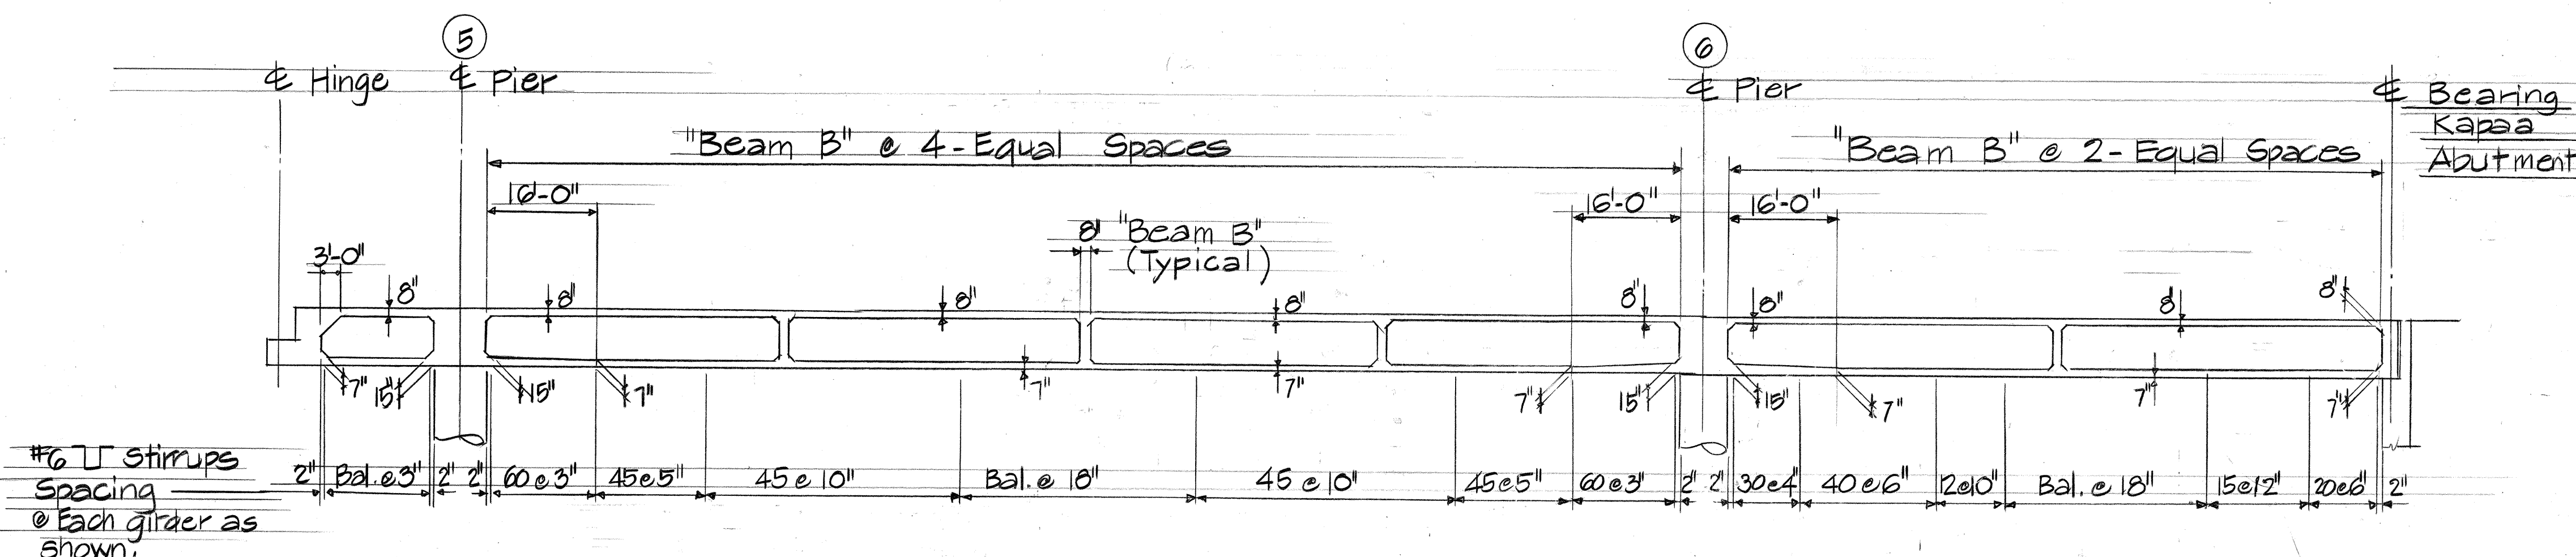
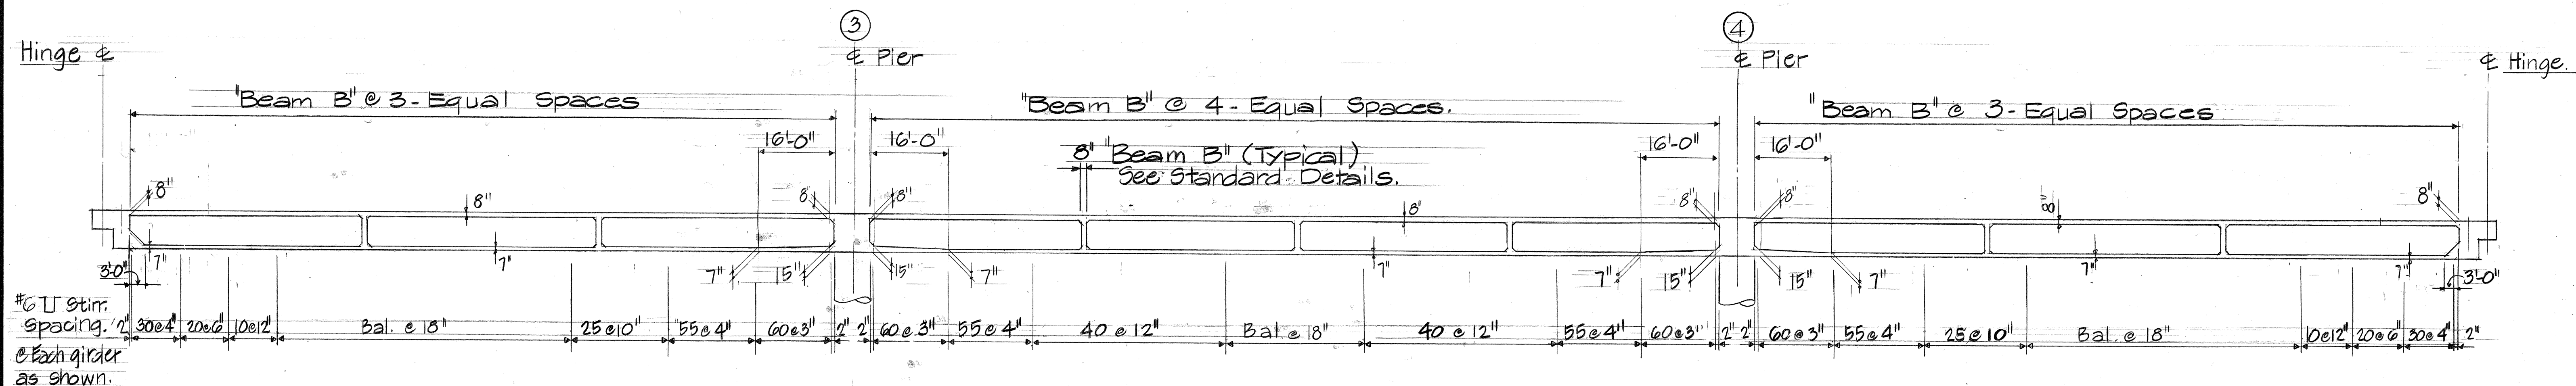


FED. ROAD DIST. NO.	STATE	FED. AID PROJ. NO.	FISCAL YEAR	SHEET NO.	TOTAL SHEETS
HAWAII	HAW.	F-051-1(8)	1986	37	62

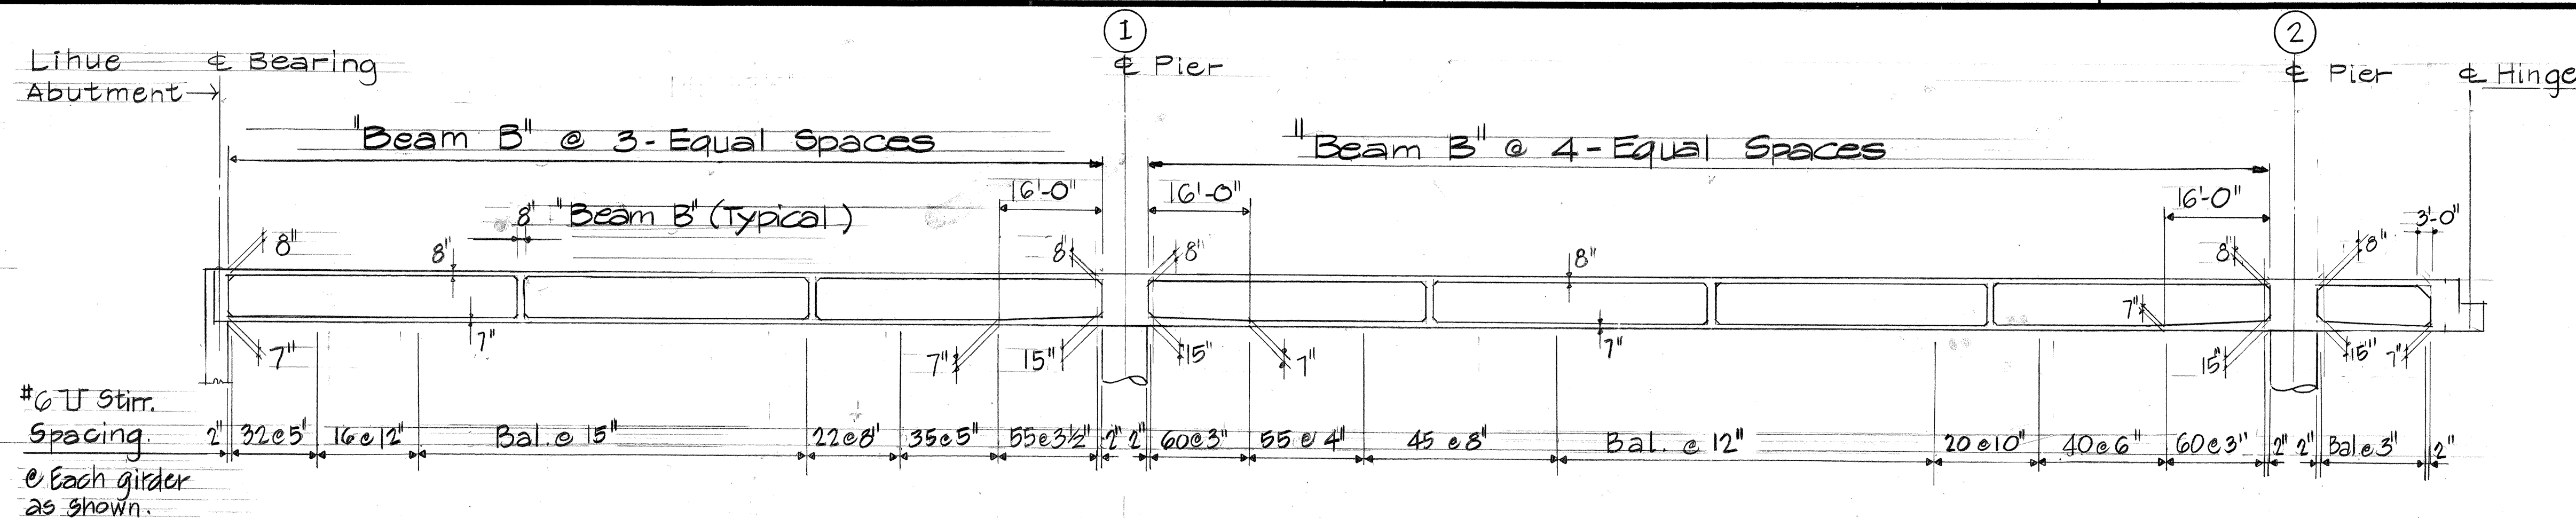


BRIDGE LONGITUDINAL SECTION W/ GIRDER STIRRUP SPACING

Scale: 1/16" = 1'-0"

Note: Section taken along E of Bridge.

A
S-20

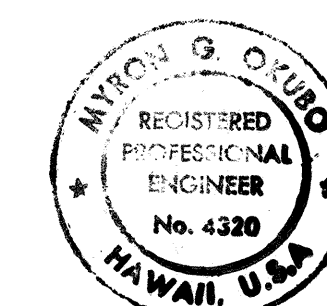

THIS WORK WAS PREPARED BY ME OR UNDER MY SUPERVISION.
Myron Ojima
Signature

DATE REVISION

STATE OF HAWAII
DEPARTMENT OF TRANSPORTATION
LAND TRANSPORTATION FACILITIES DIVISION
**BRIDGE LONGITUDINAL SECTION
WITH GIRDER STIRRUP SPACING**
HANAMAULU VIADUCT
HANAMAULU-AHUKINI CUTOFF ROAD
Ahukini Road to Kauai Hardwoods
PROJECT NO. F-051-1(8)
SCALE: 1/16" = 1'-0" DATE: JULY 1985
SHEET NO. S-20 OF S-39 SHEETS