


FED. ROAD DIST. NO.	STATE	FED. AID PROJ. NO.	FISCAL YEAR	SHEET NO.	TOTAL SHEETS
HAWAII	HAW.	F-051-1(8)	1986	24	62

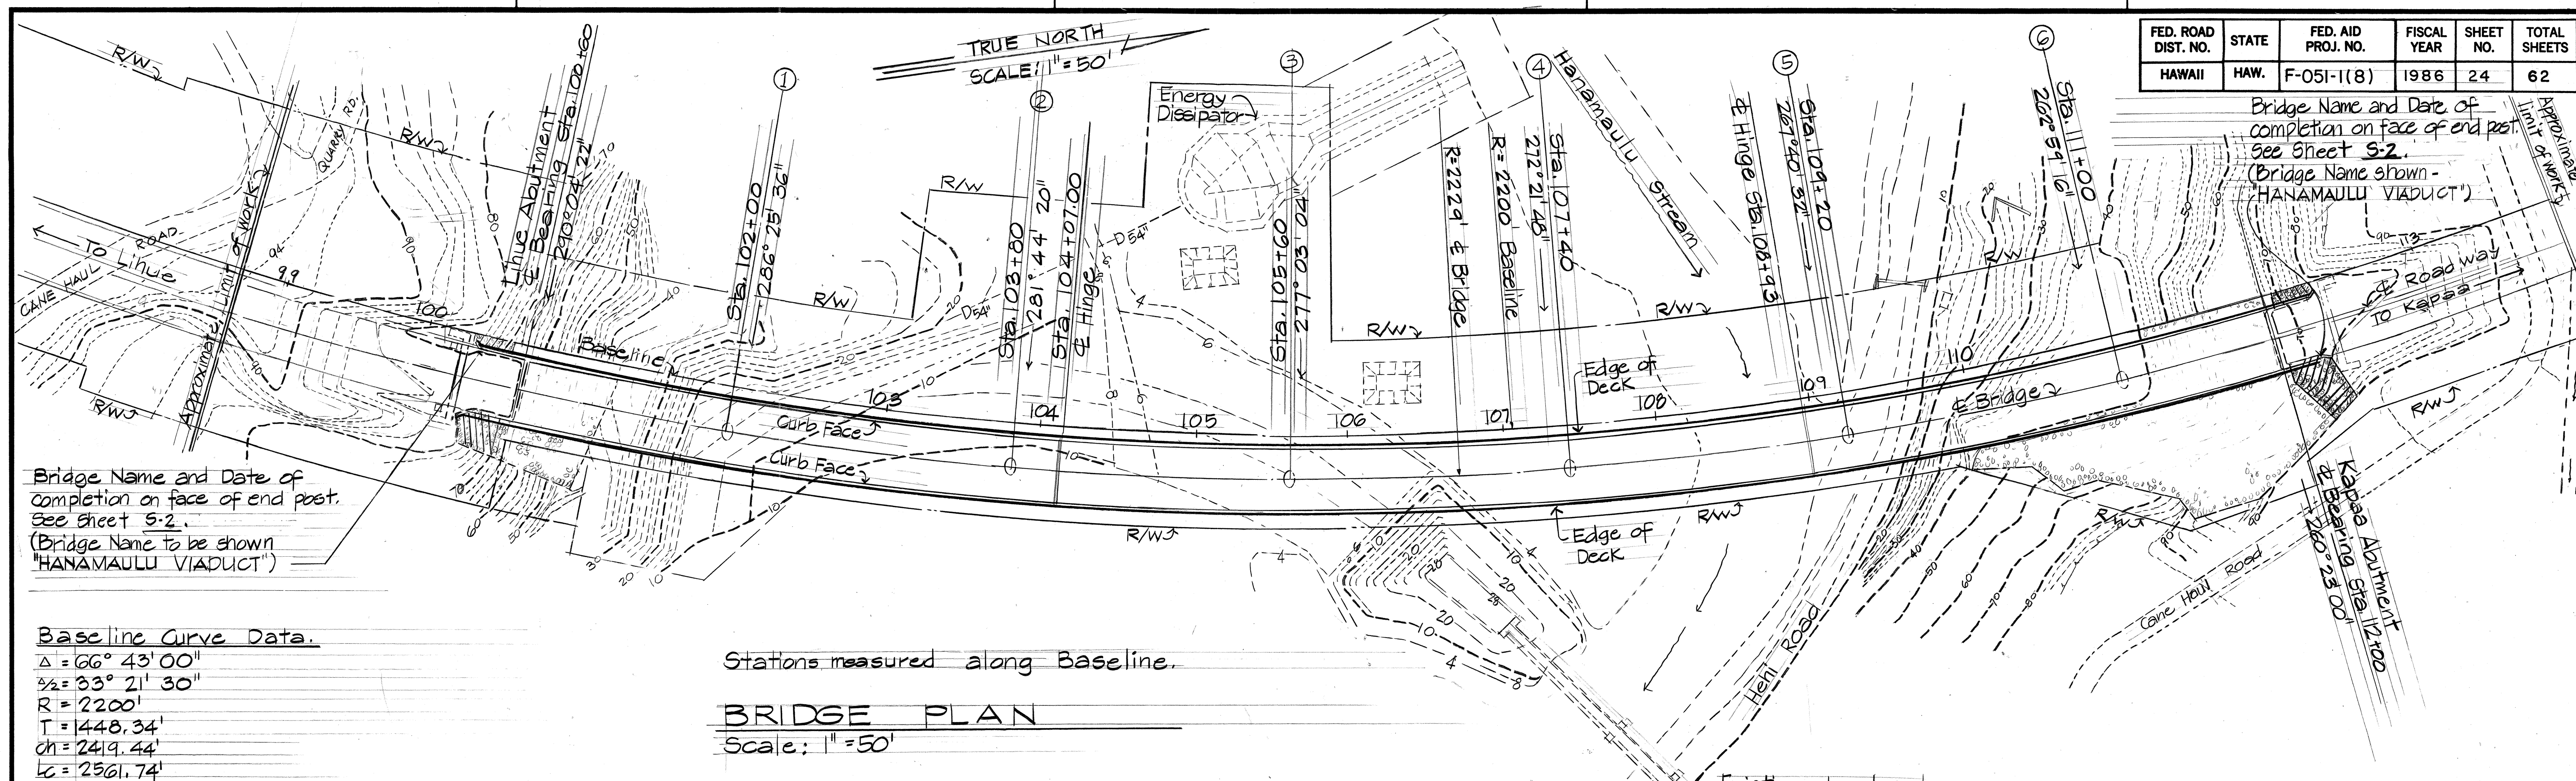


Baseline Curve Data.
 $\Delta = 66^\circ 43' 00''$
 $\frac{1}{2}\Delta = 33^\circ 21' 30''$
 $R = 2200'$
 $T = 1448.34'$
 $Ch = 2419.44'$
 $Lc = 2561.74'$

Stations measured along Baseline.

BRIDGE PLAN

Scale: 1" = 50'

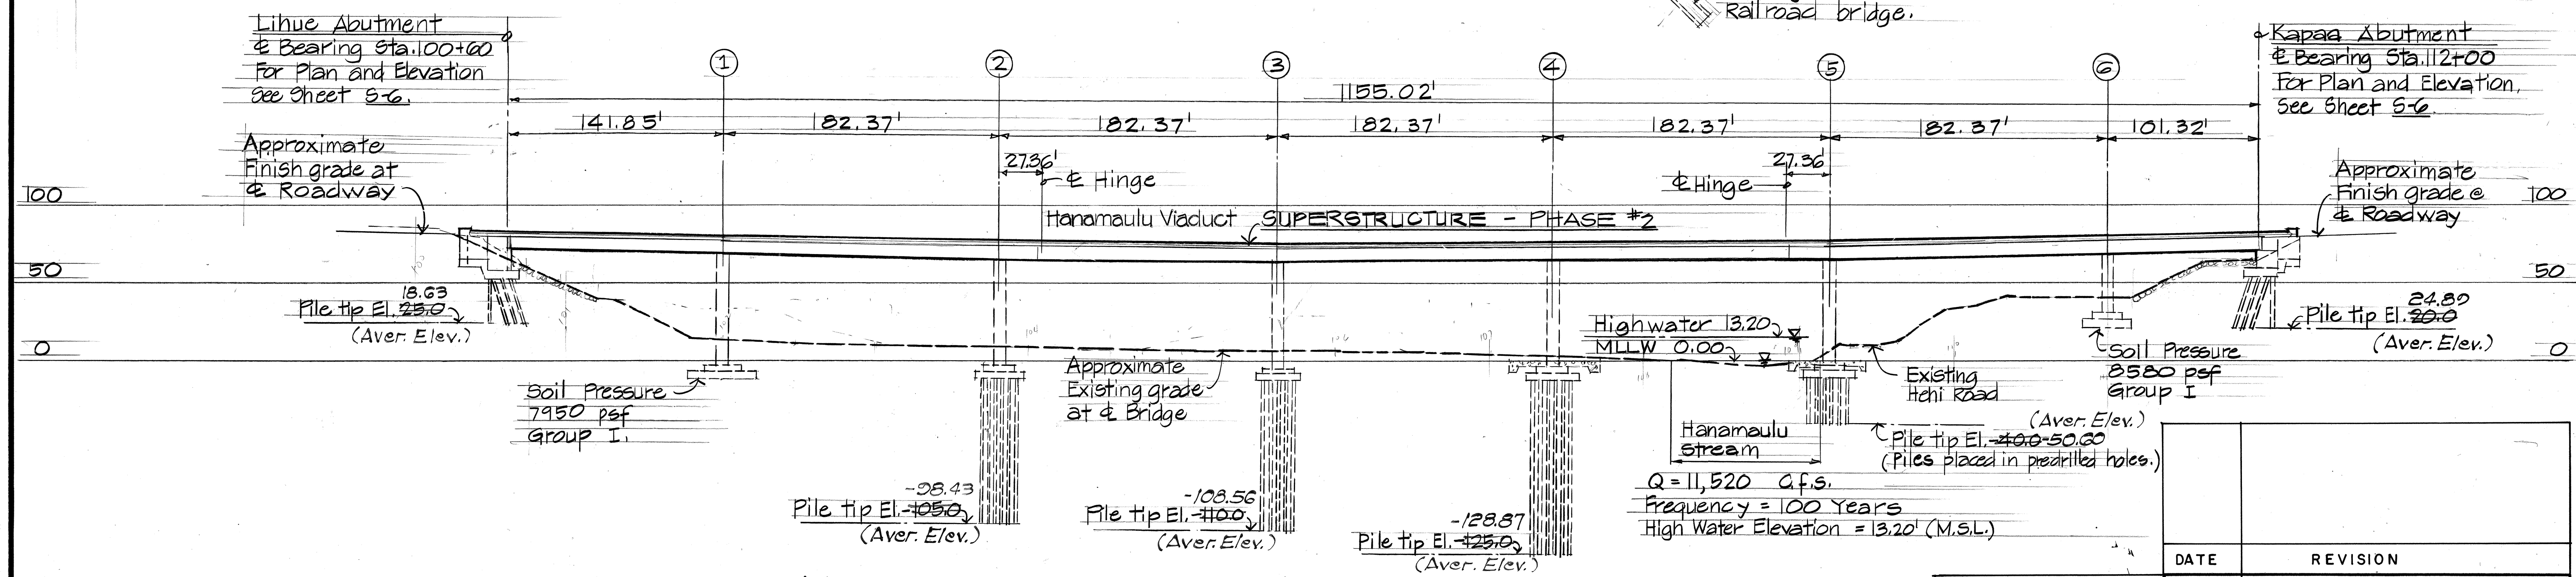

Bridge Substructure (Piles, Footings, Piers, portions of Abutments) has been constructed and is Not-In-Contract.
 Bridge Substructure is shown for information purposes only.

Lengths shown are measured along center line of bridge

BRIDGE ELEVATION

Scale: 1" = 50'

DATE	_____
SURVEY PLOTTED BY	_____
DRAWN BY	_____
DESIGNED BY	_____
QUANTITIES BY	_____
CHECKED BY	_____

MYRON G. OKUBO
 REGISTERED PROFESSIONAL ENGINEER
 No. 4320-S
 HAWAII, U.S.A.
 THIS WORK WAS PREPARED BY ME OR UNDER MY SUPERVISION.
 Myron Okubo
 Signature

DATE	REVISION
STATE OF HAWAII DEPARTMENT OF TRANSPORTATION HIGHWAYS DIVISION BRIDGE PLAN AND ELEVATION HANAMAULU VIADUCT HANAMAULU-AHUKINI CUTOFF ROAD Ahukini Road to Kauai Hardwoods PROJECT NO. F-051-1(8) SCALE: 1" = 50' DATE: JULY 1986 SHEET NO. S-3 OF S-3 SHEETS	