
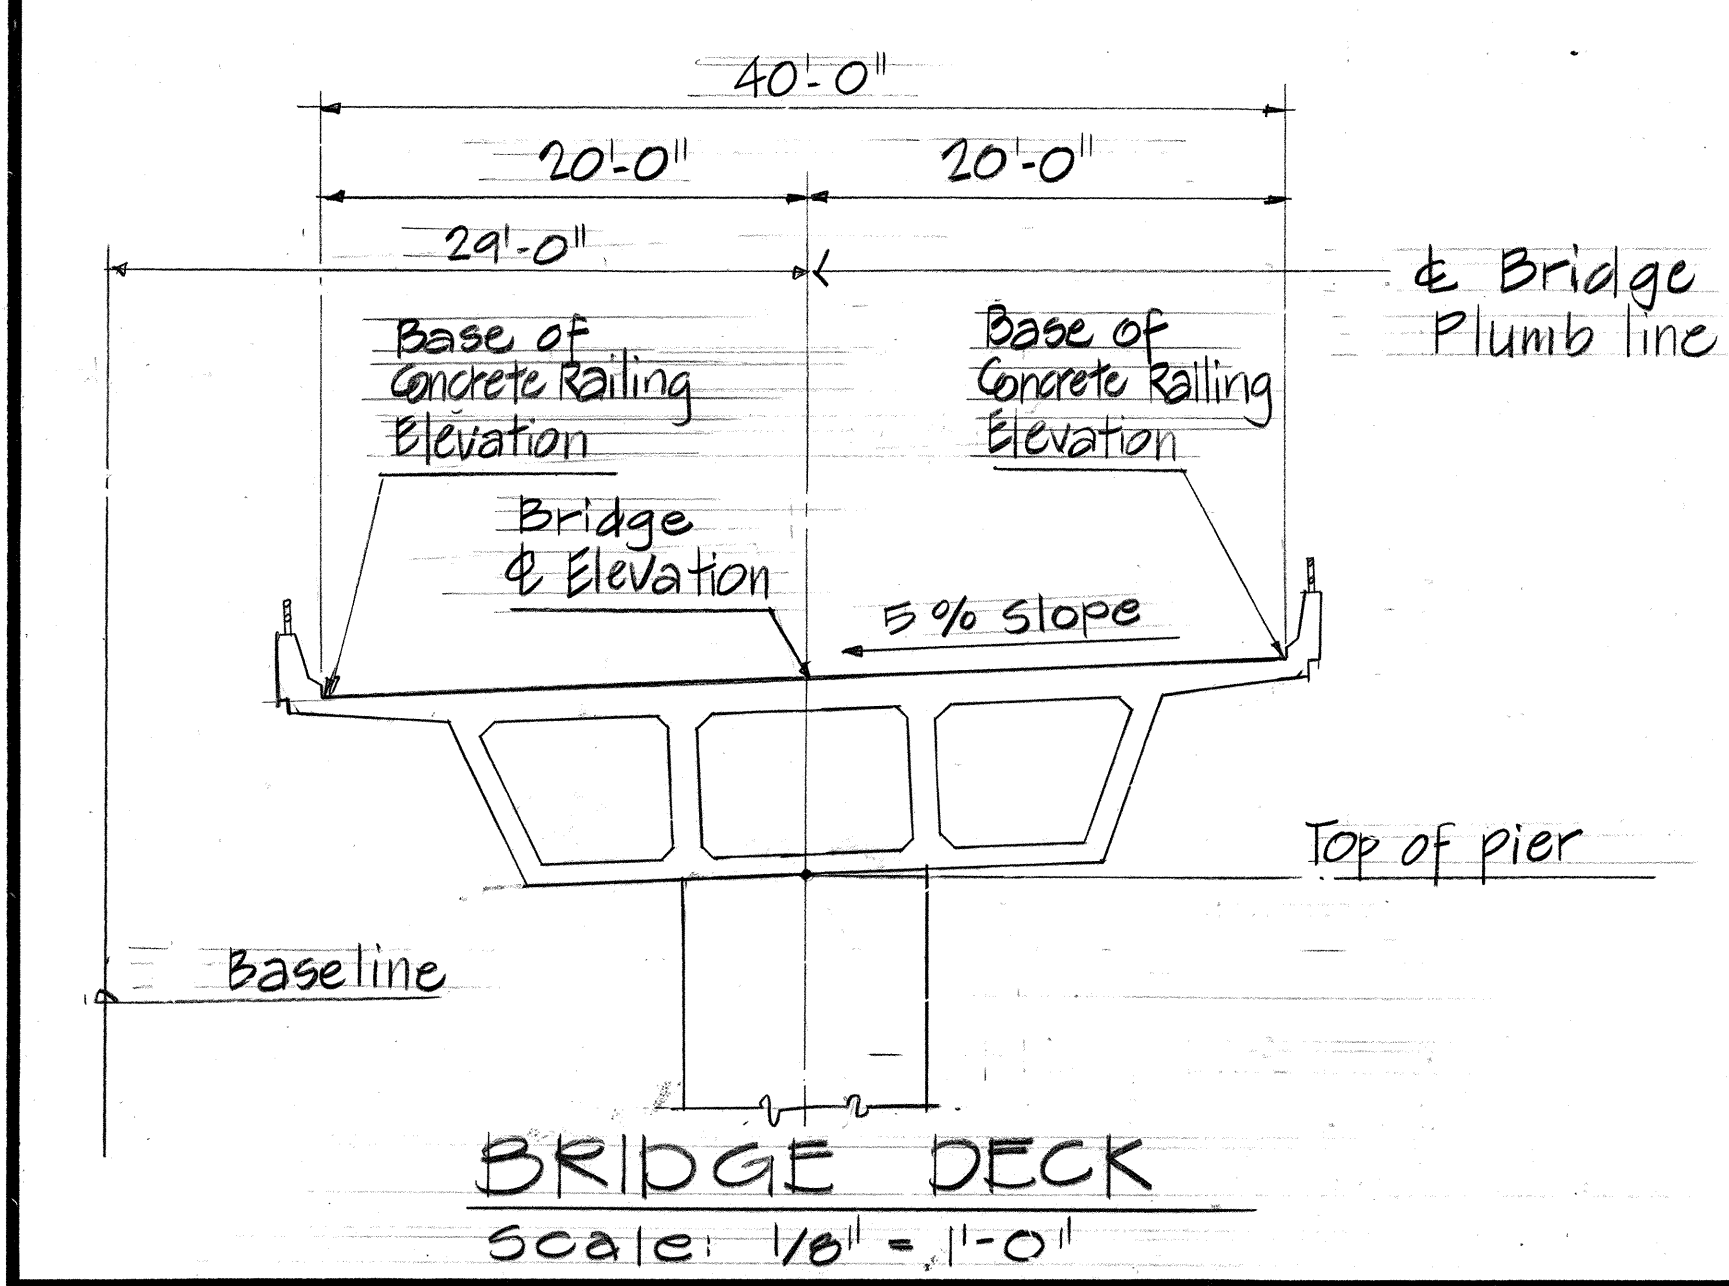


FED. ROAD DIST. NO.	STATE	FED. AID PROJ. NO.	FISCAL YEAR	SHEET NO.	TOTAL SHEETS
HAWAII	HAW.	F-051-1(8)	1986	34	62

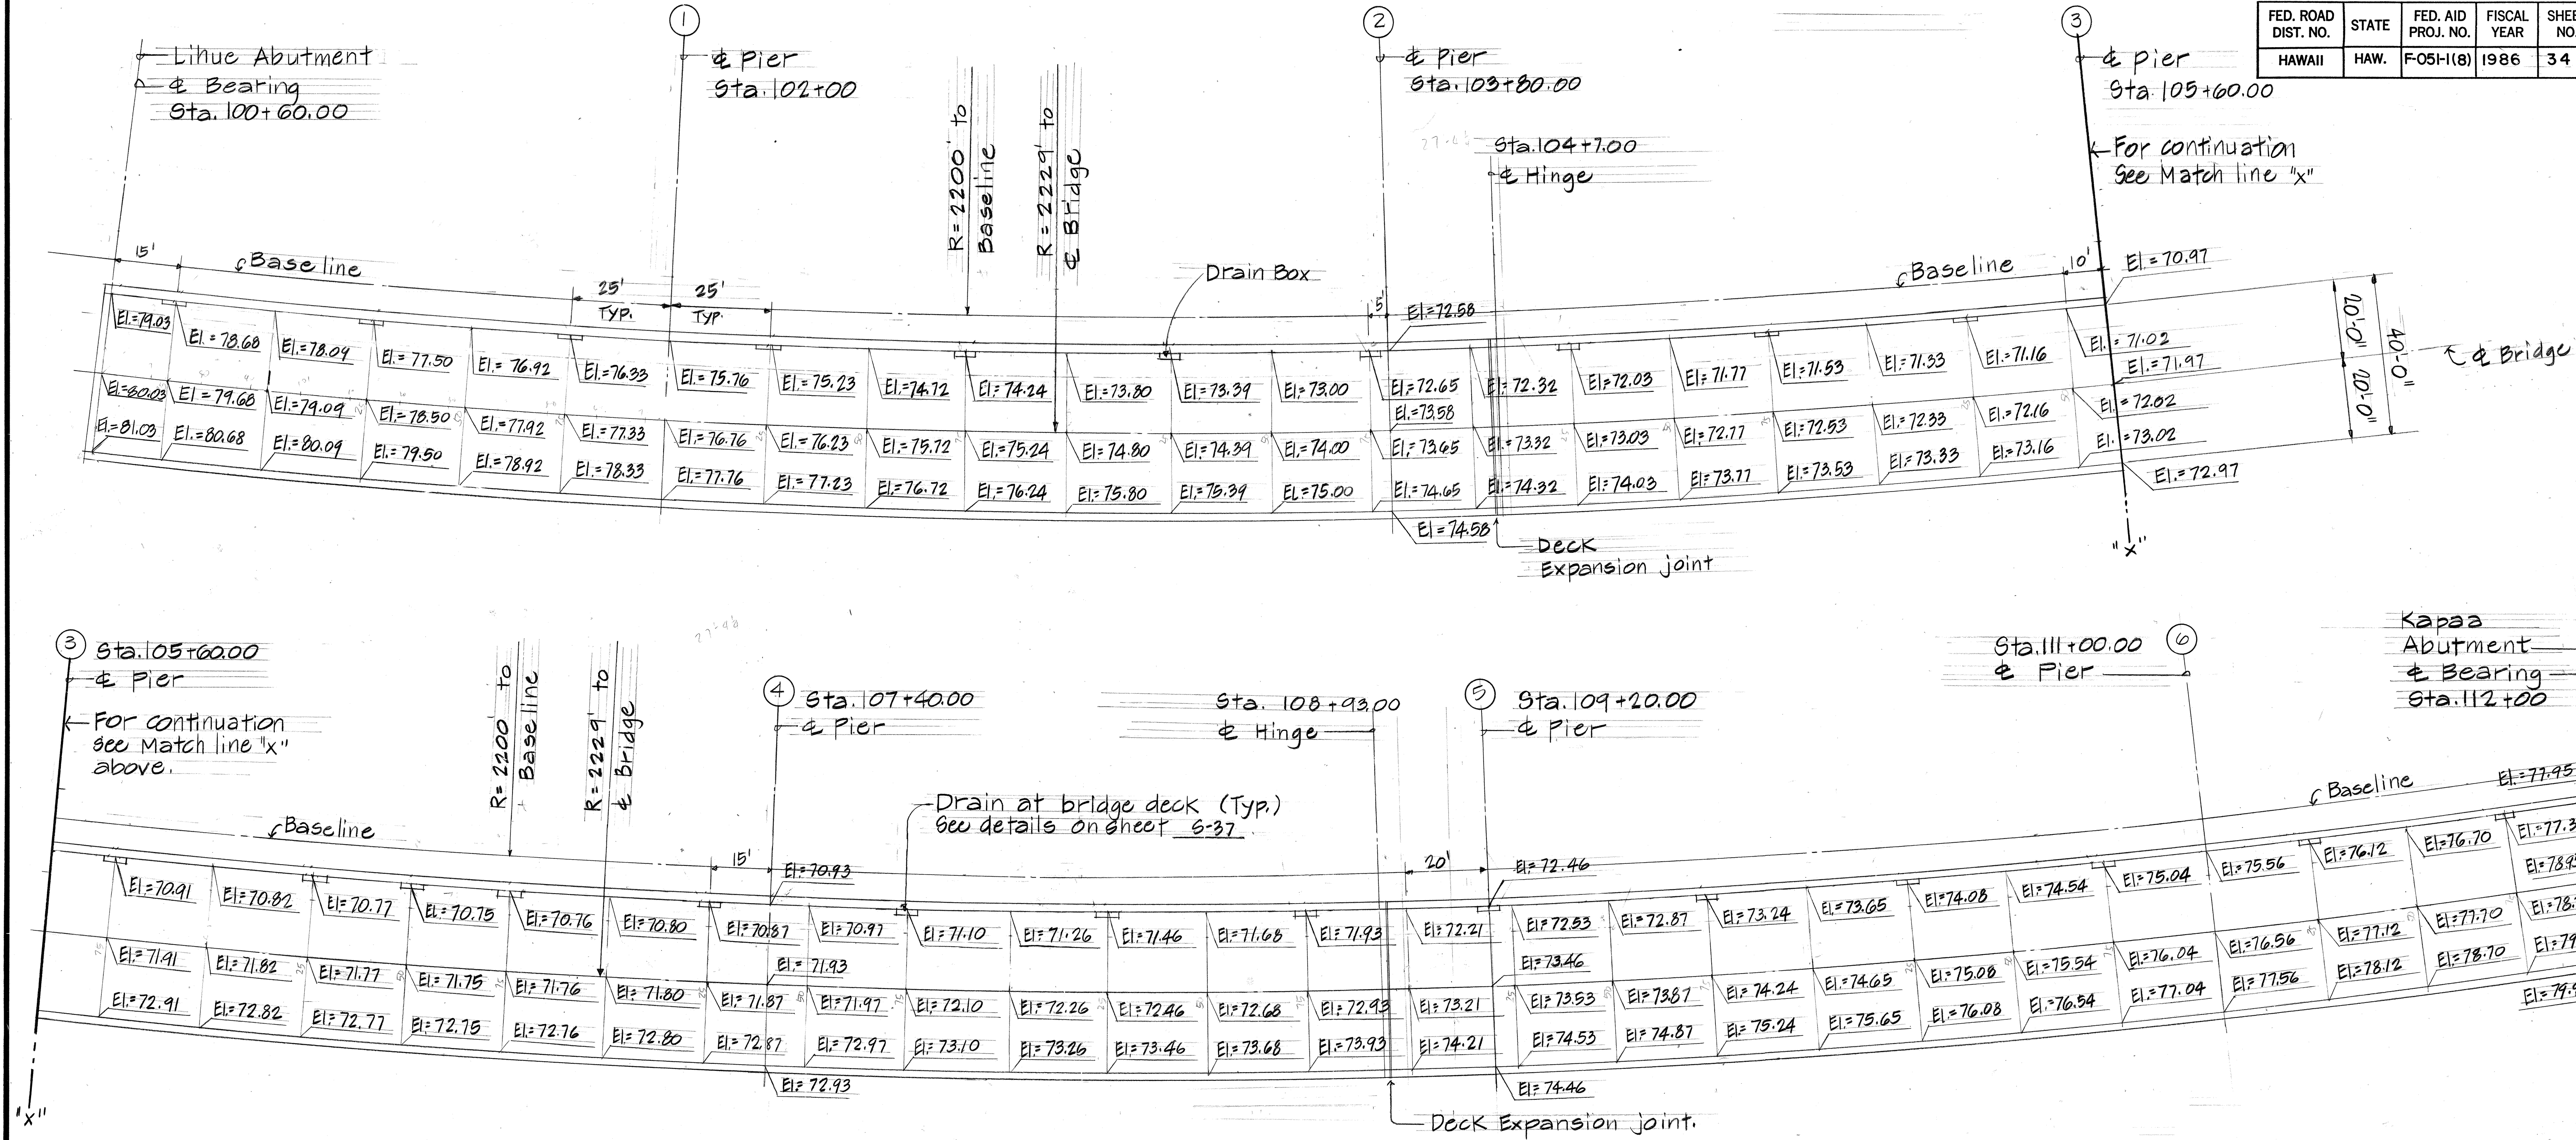

BRIDGE DECK - FINISH GRADE PLAN

Scale: 1" = 20'

Deck elevations given at ϕ Bridge and at base of Concrete Railing at typical 25' intervals along baseline, and at ϕ Piers.

THIS WORK WAS PREPARED BY ME OR UNDER MY SUPERVISION.
Myron G. Okubo
Signature

DATE	REVISION
STATE OF HAWAII DEPARTMENT OF TRANSPORTATION LAND TRANSPORTATION FACILITIES DIVISION FINISHED DECK ELEVATIONS HANAMAULU VIADUCT HANAMAULU-AHUKINI CUTOFF ROAD Ahukini Road to Kauai Hardwoods PROJECT NO. F-051-1(8) SCALE: AS SHOWN DATE: JULY 1985 SHEET NO. 34 OF 39 SHEETS	

DATE	
SURVEY PLOTTED BY	
DRAWN BY	
TRACED BY	
DESIGNED BY	
CHECKED BY	
ORIGINAL PLAN	
NOTE BOOK	
No.	