
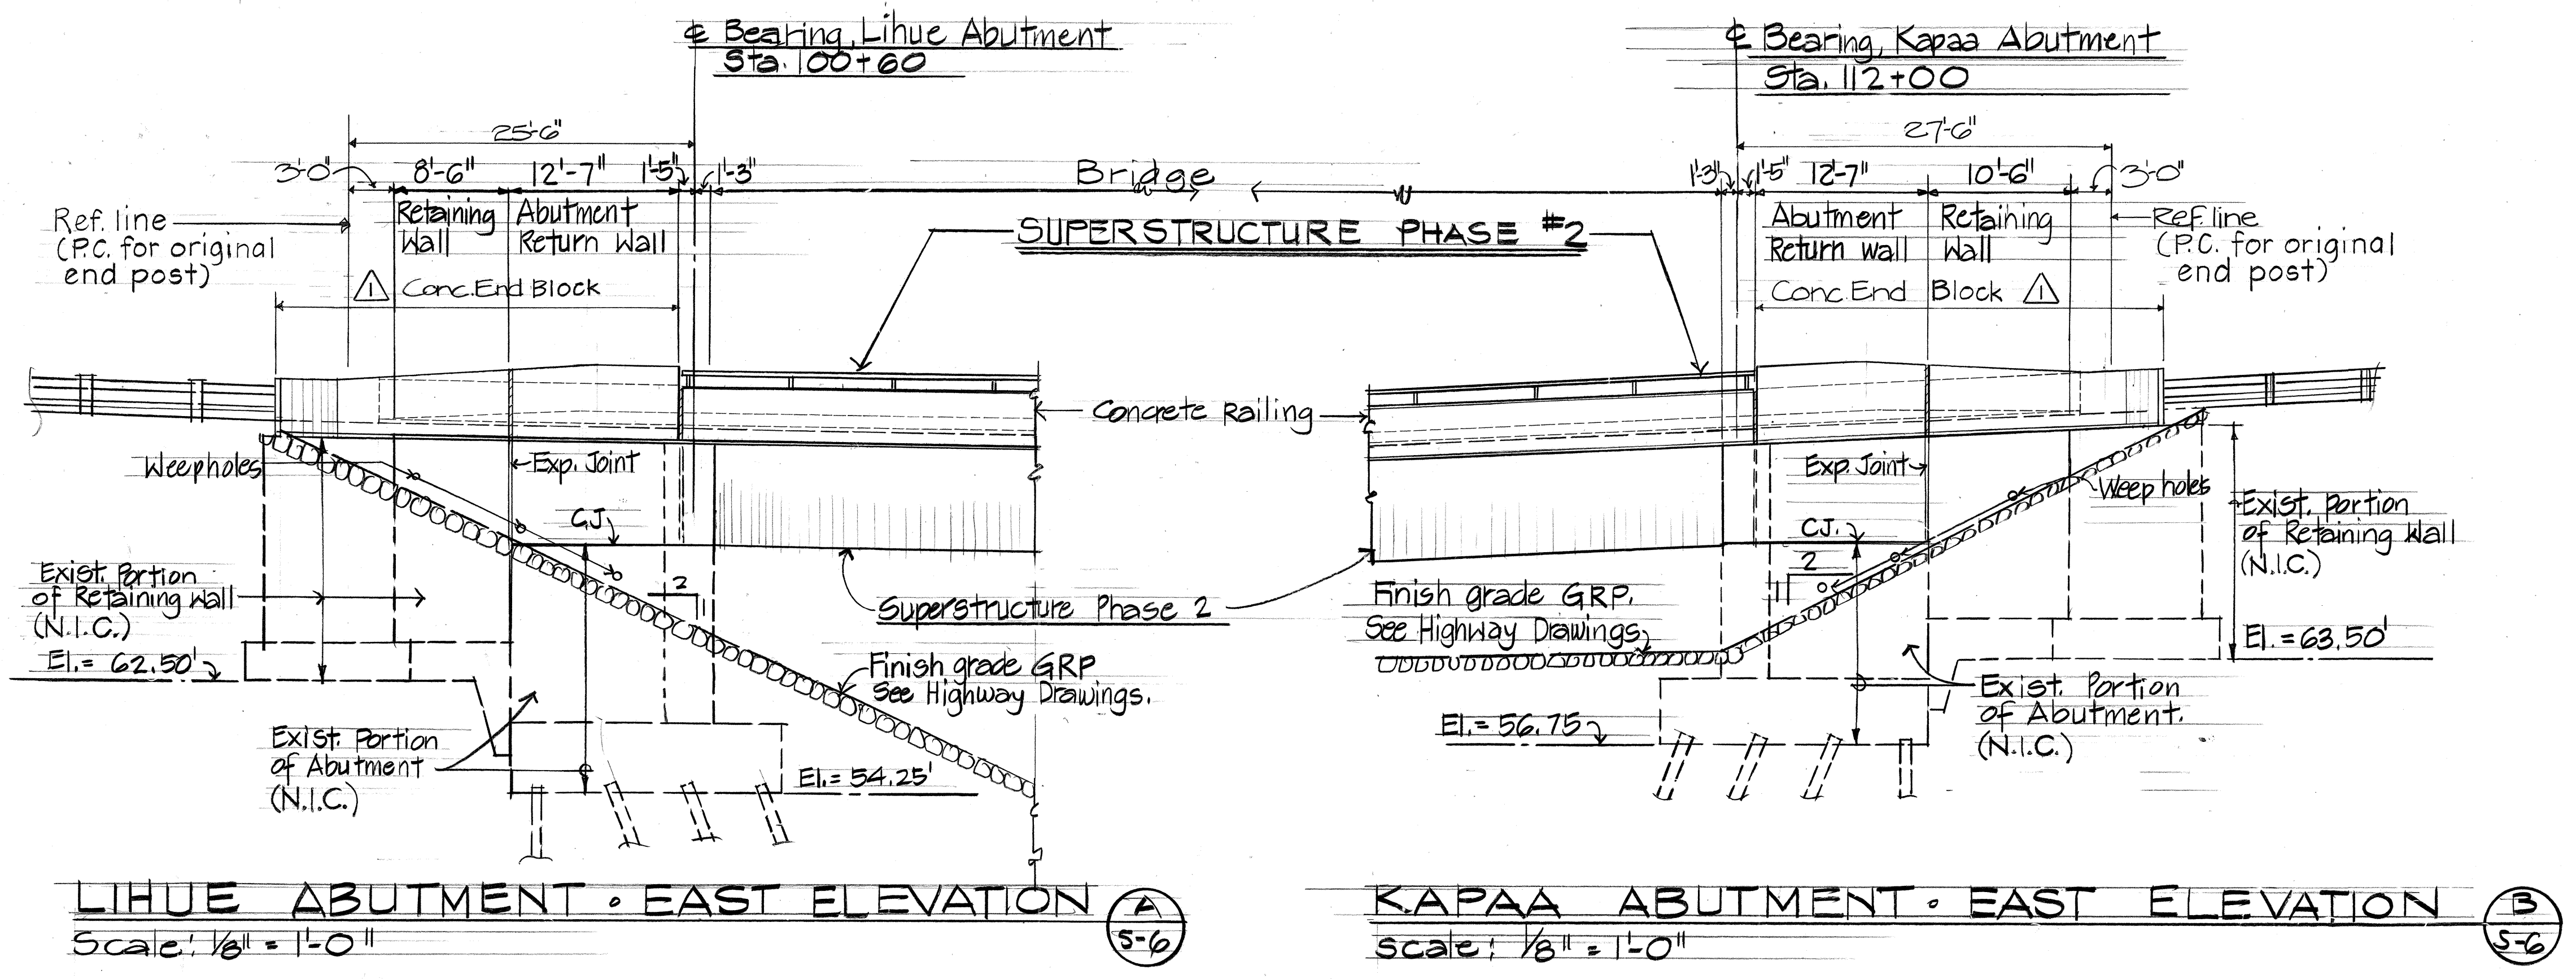


FED. ROAD DIST. NO.	STATE	FED. AID PROJ. NO.	FISCAL YEAR	SHEET NO.	TOTAL SHEETS
HAWAII	HAW.	F-051-1 (8)	1986	27	62

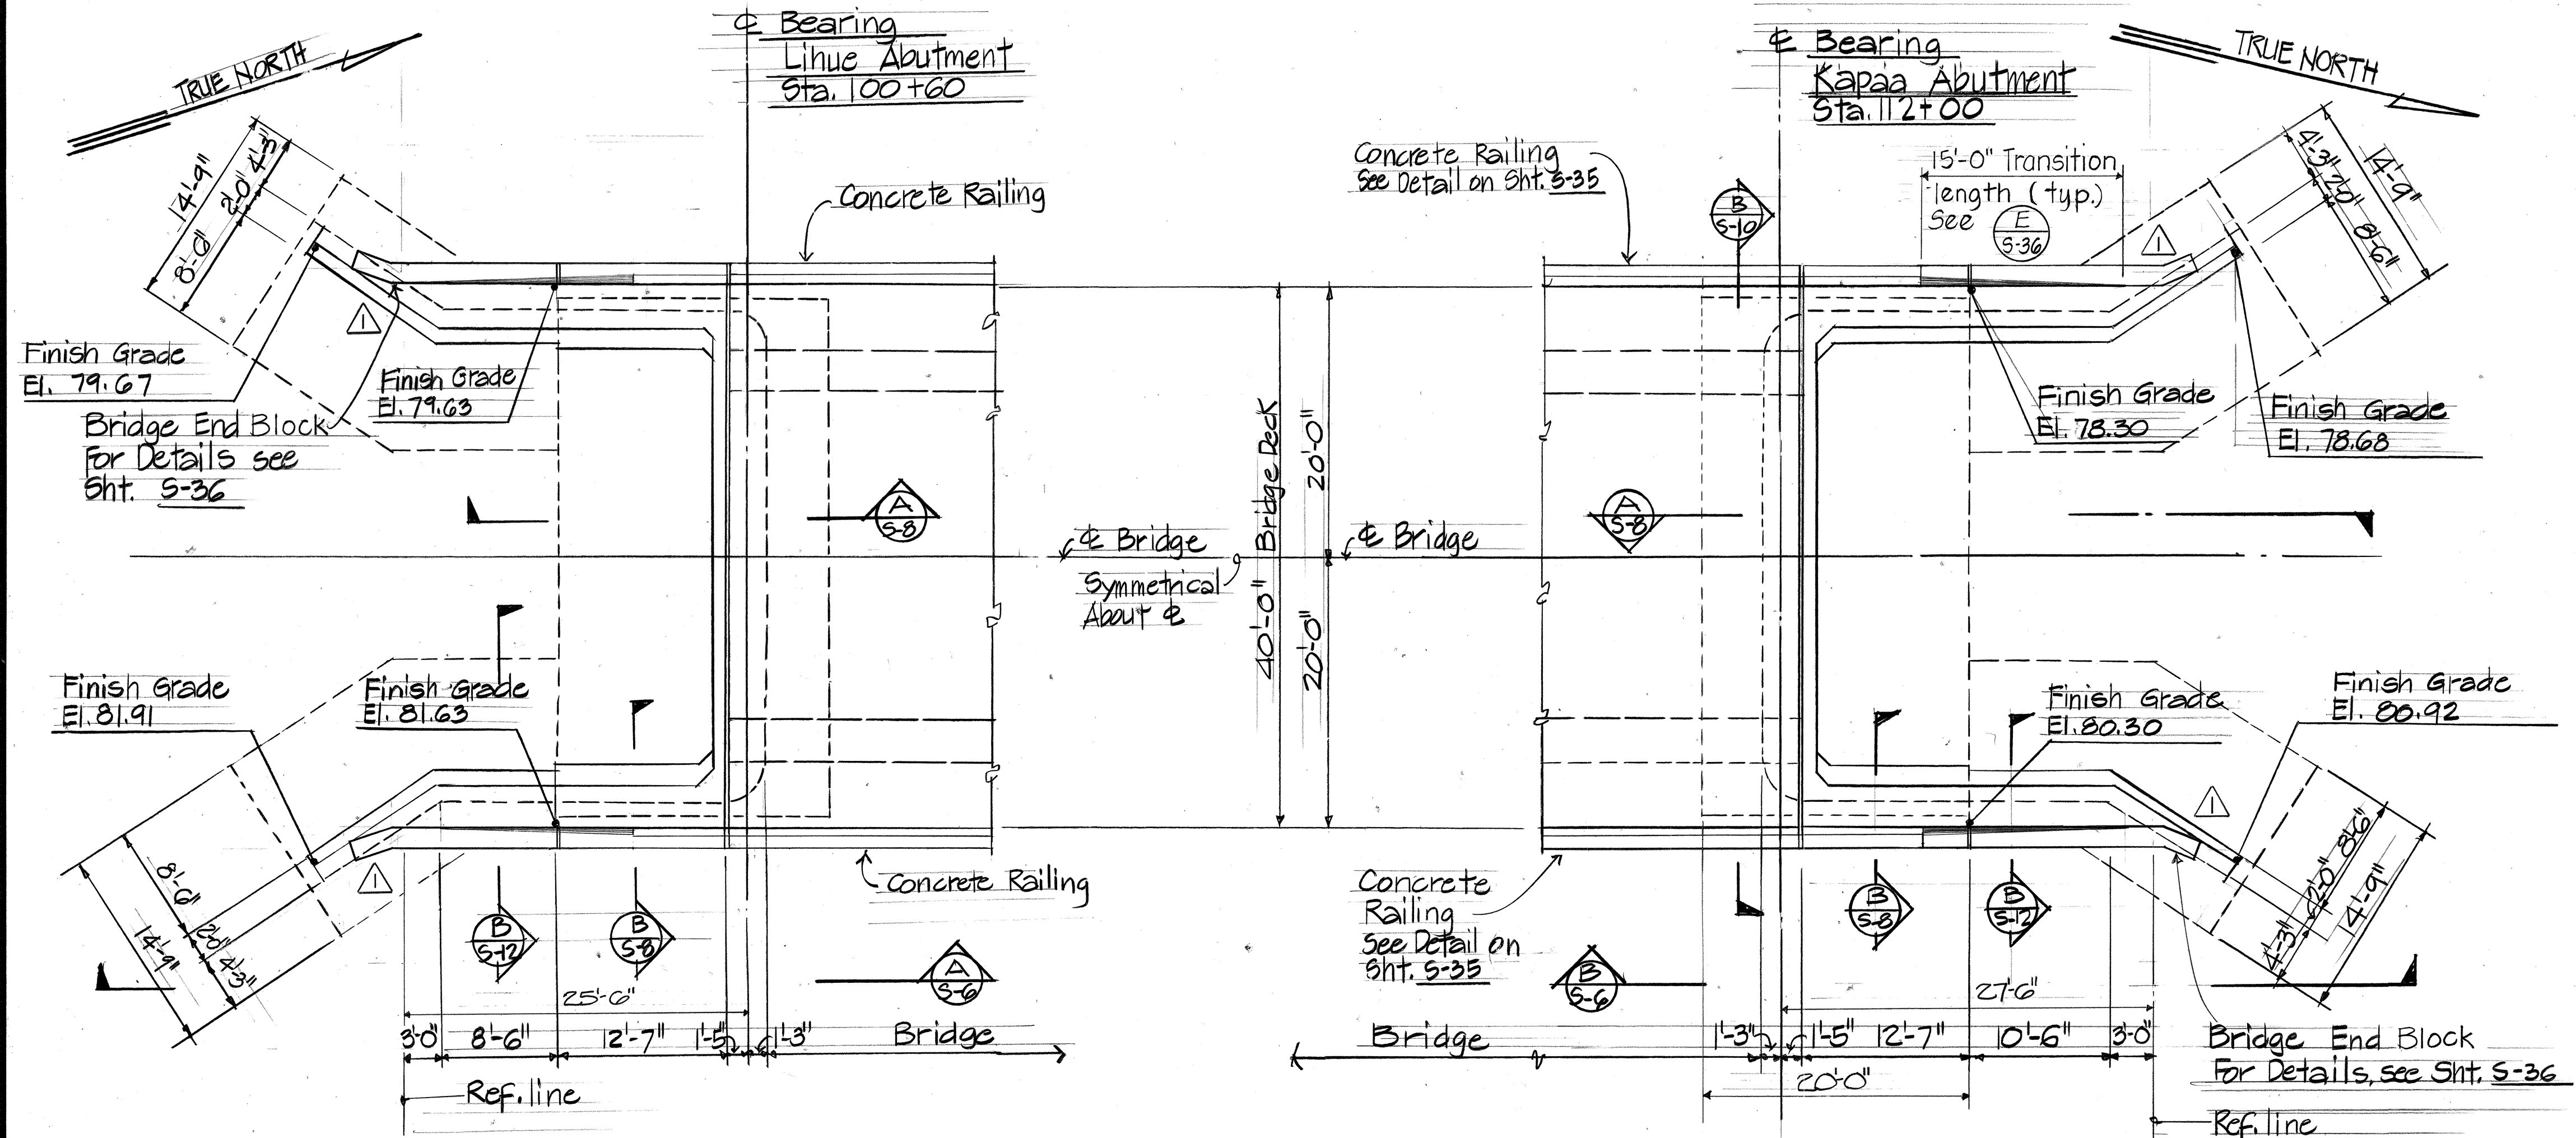

11-4-81 Revised End Block to Accomodate Transition & Installation of Rubrail.

DATE REVISION

MYRON G. OKUBO
REGISTERED PROFESSIONAL ENGINEER
No. 4320-S
HAWAII, U.S.A.

THIS WORK WAS PREPARED BY ME OR UNDER MY SUPERVISION.
Myron Okubo
Signature

STATE OF HAWAII
DEPARTMENT OF TRANSPORTATION
HIGHWAYS DIVISION

LIHUE AND KAPAA ABUTMENTS
PLAN AND ELEVATION
HANAMAULU VIADUCT
HANAMAULU-AHUKINI CUTOFF ROAD
Ahukini Road to Kauai Hardwoods
PROJECT NO. F-051-1 (8)

SCALE: 1/8" = 1'-0" DATE: JULY 1985
SHEET NO. S-6 OF S-39 SHEETS