




FED. ROAD DIST. NO.	STATE	FED. AID PROJ. NO.	FISCAL YEAR	SHEET NO.	TOTAL SHEETS
HAWAII	HAW.	F-051-1(8)	1986	38	62

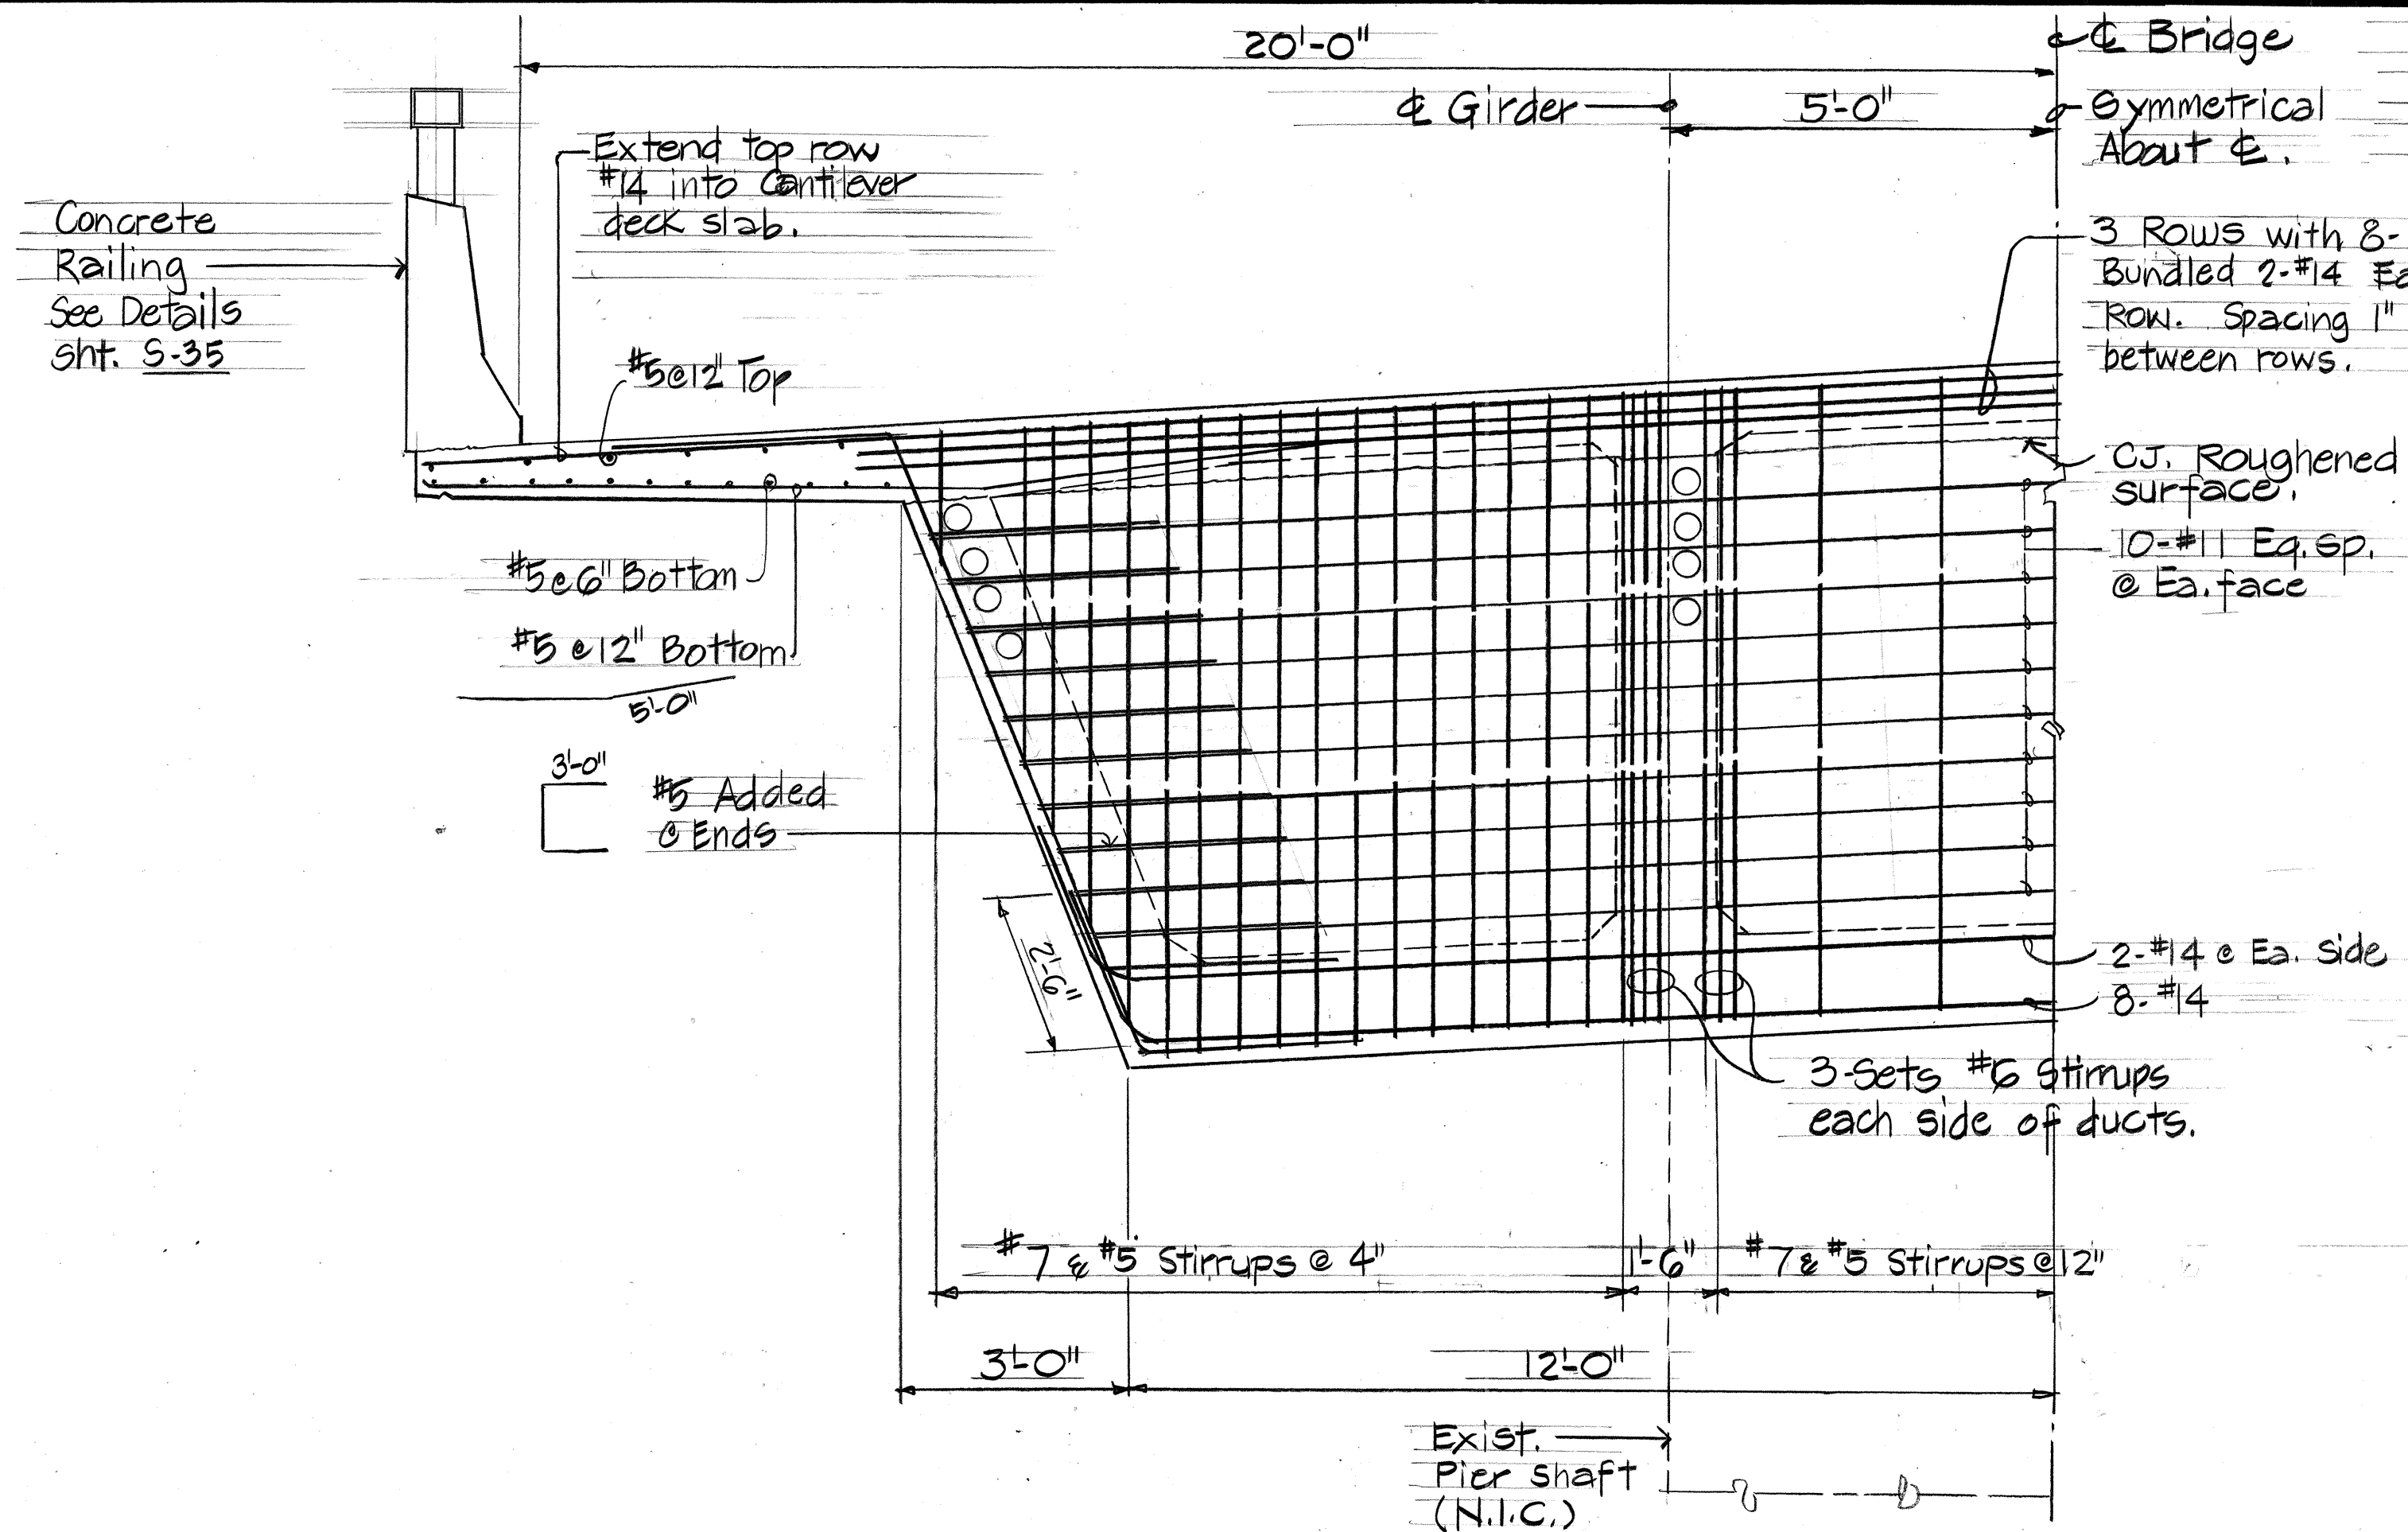


PIER CAP SECTION A
Scale: 1/2" = 1'-0"

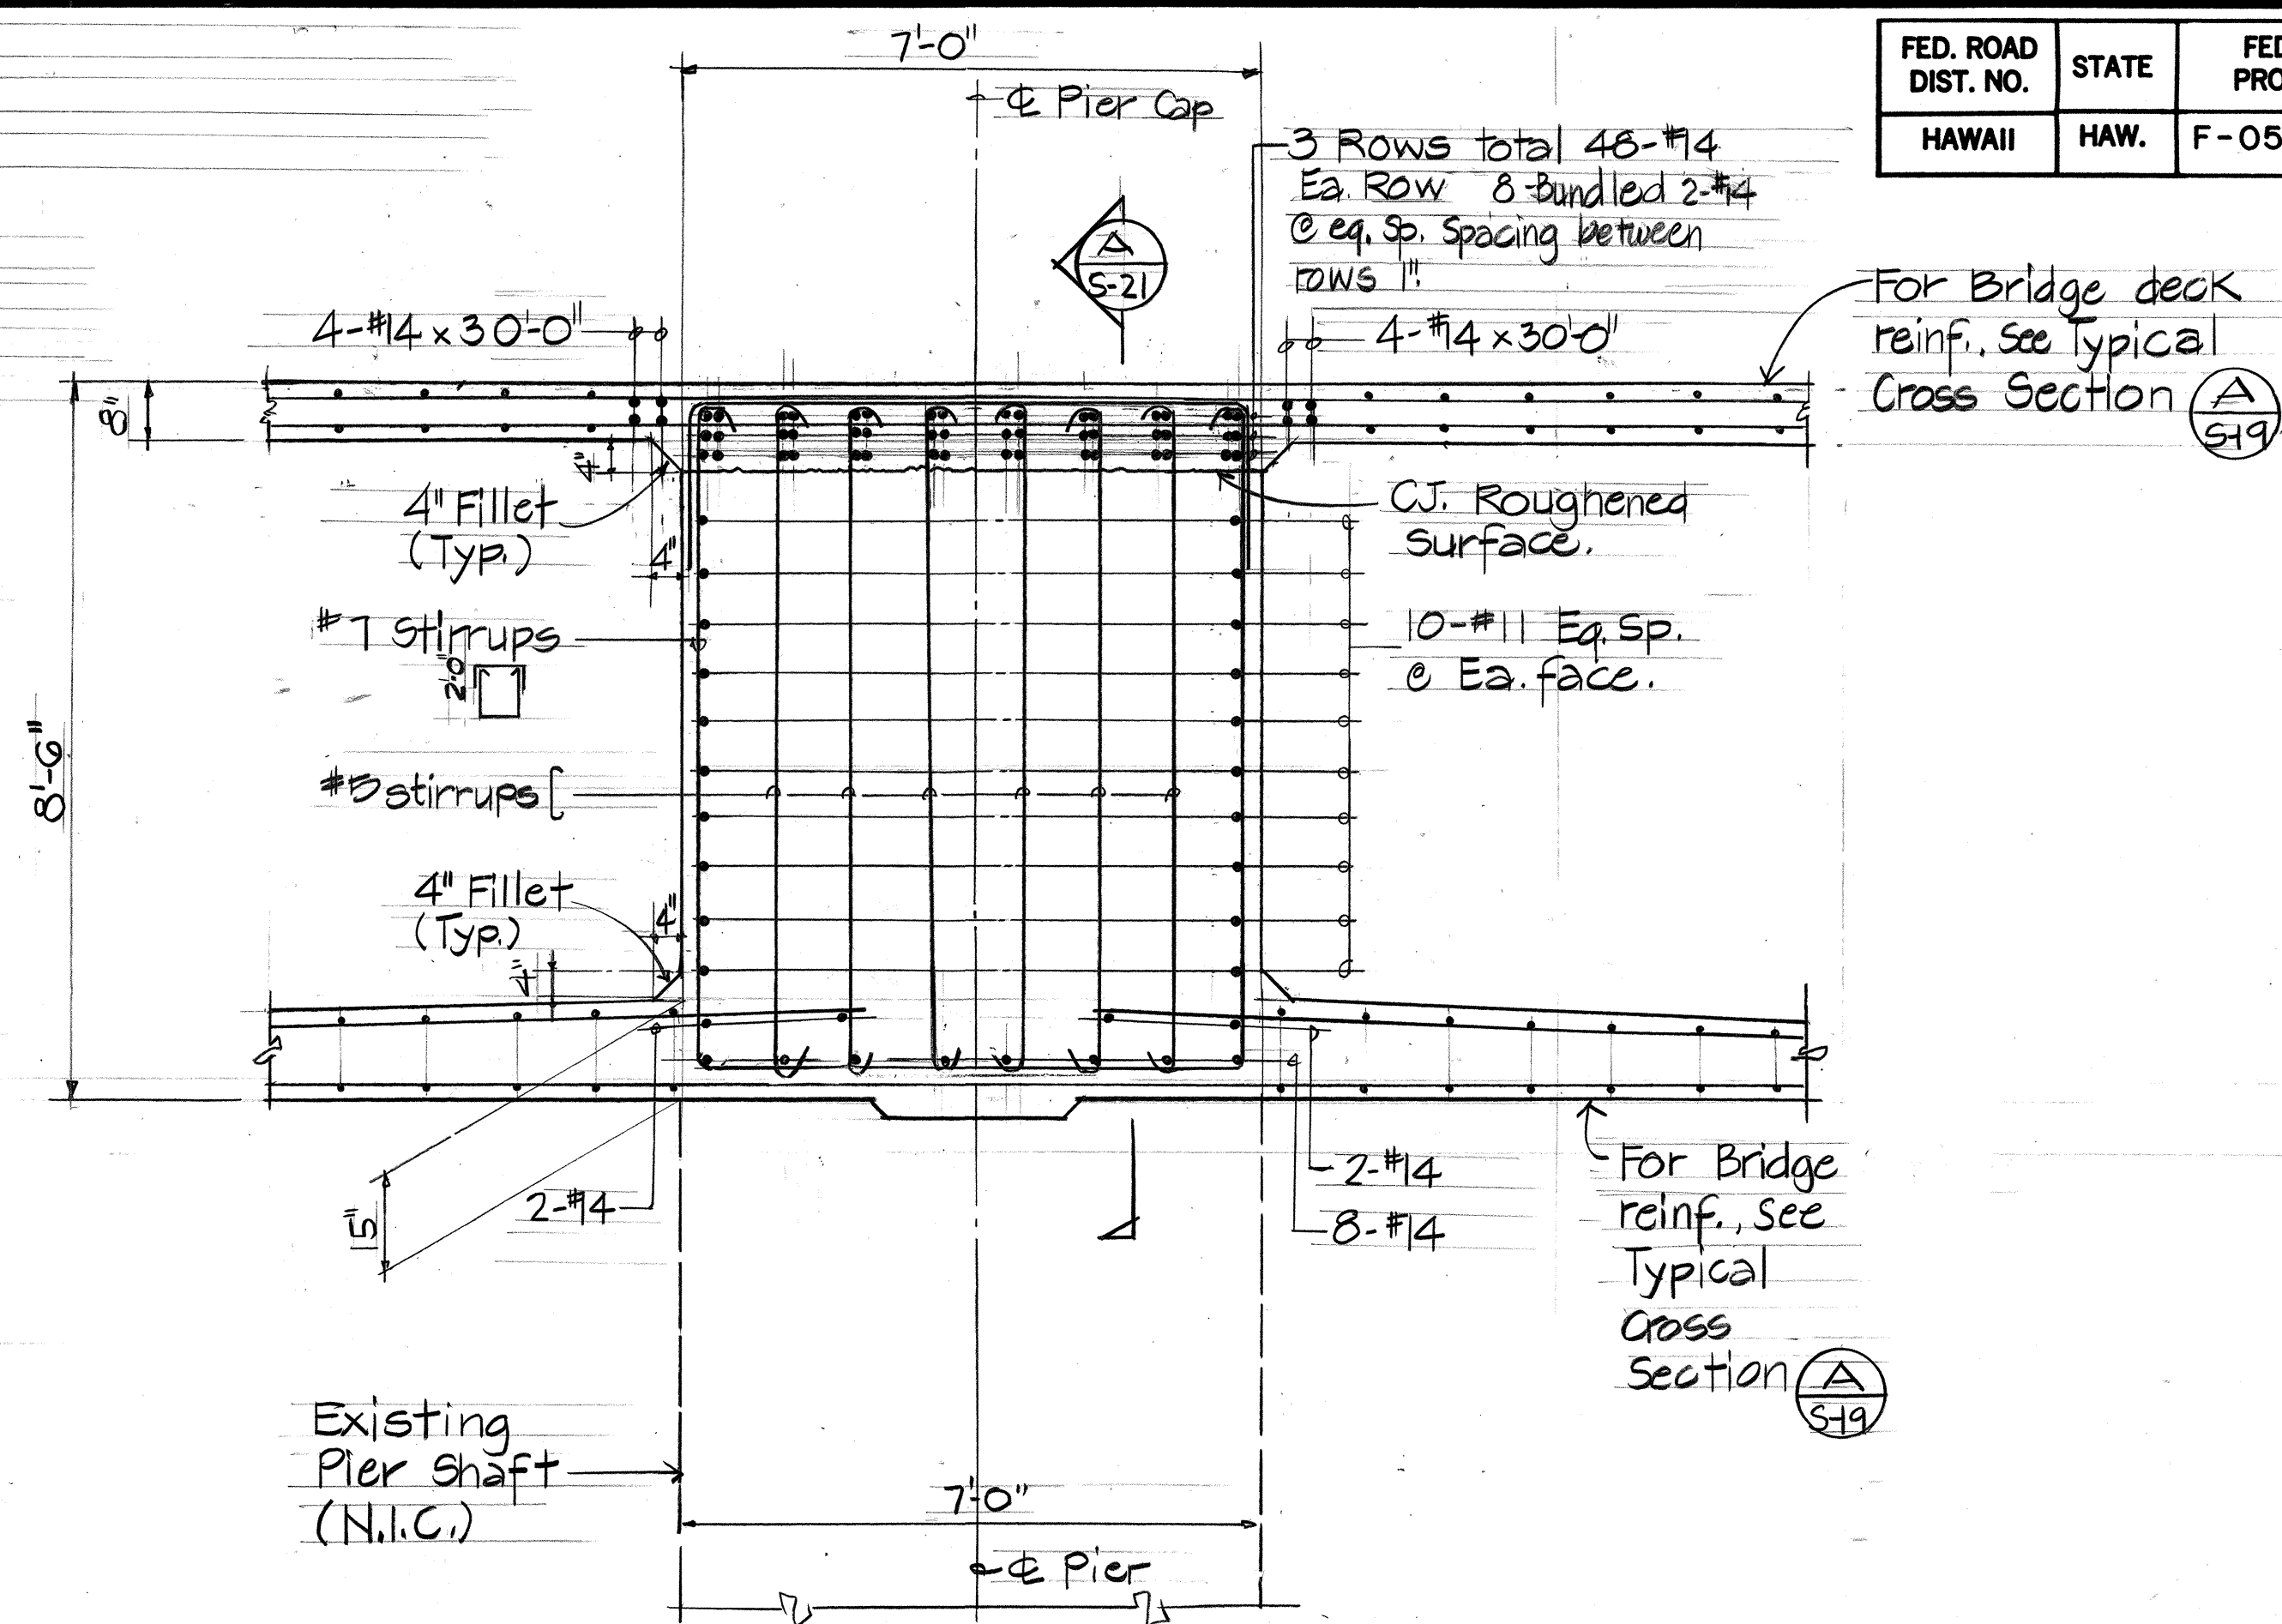

PIER CAP SECTION B
Scale: 1/2" = 1'-0"

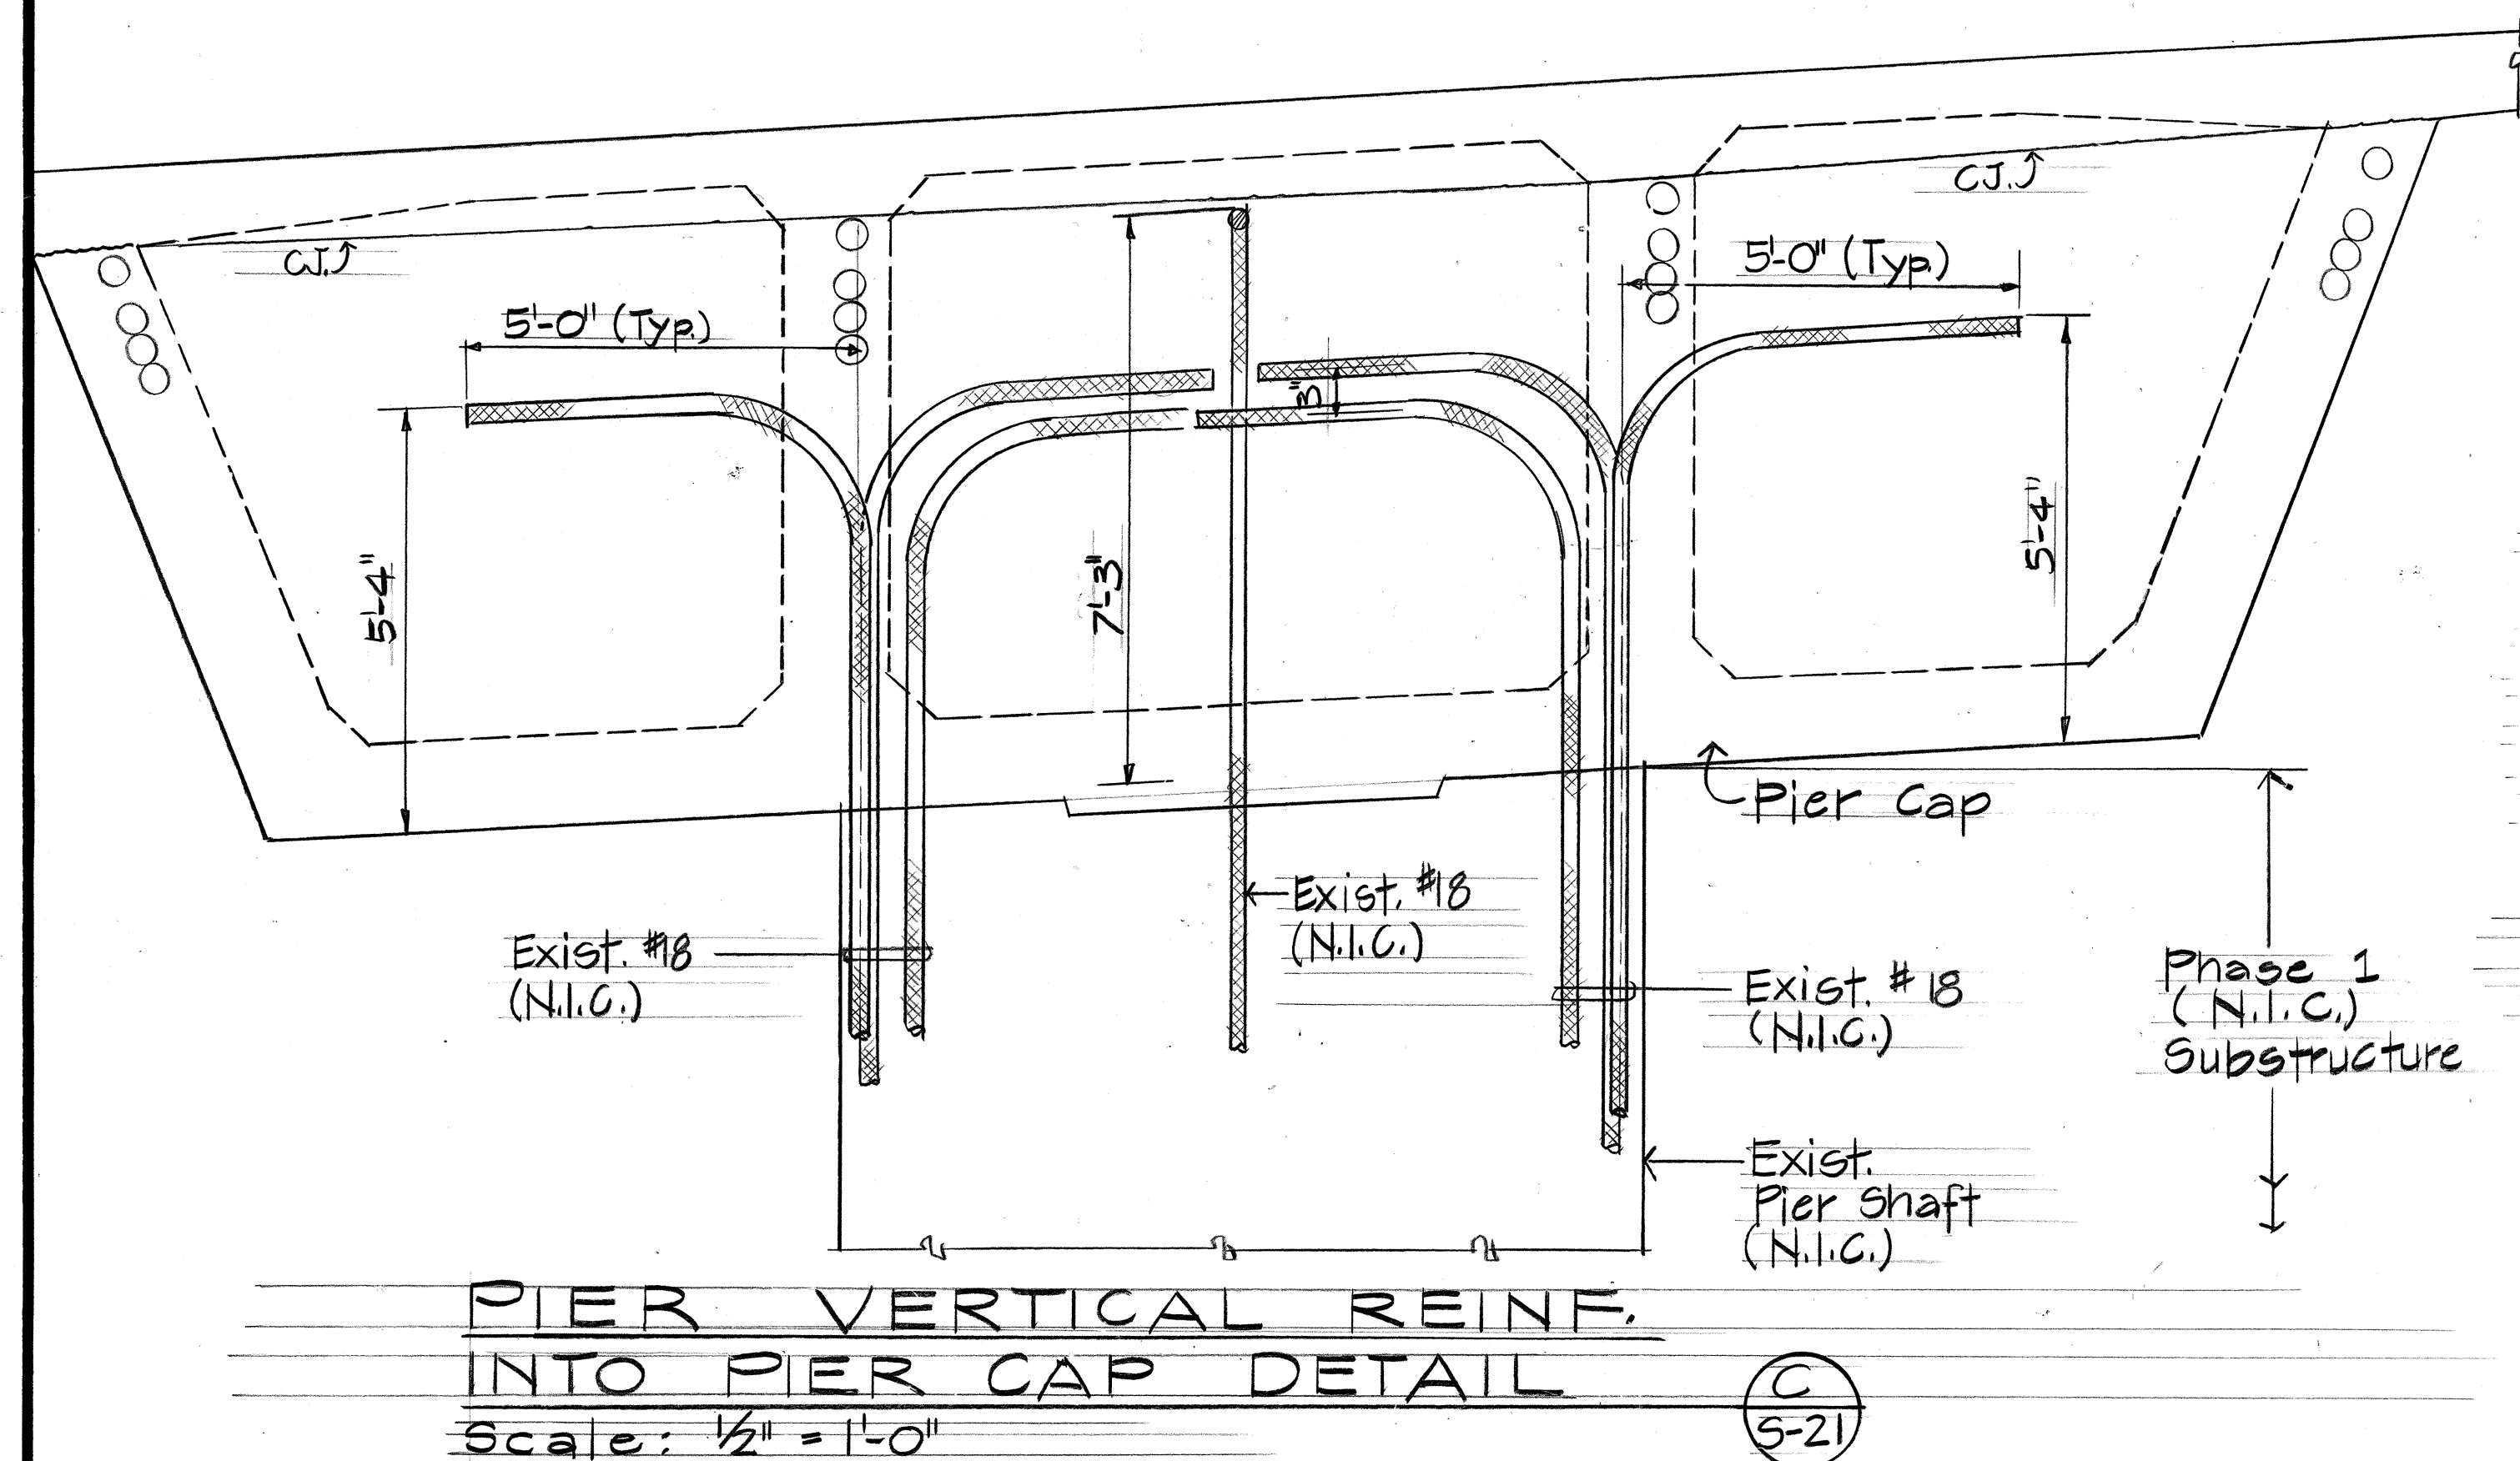

PIER VERTICAL REINF. INTO PIER CAP DETAIL C
Scale: 1/2" = 1'-0"

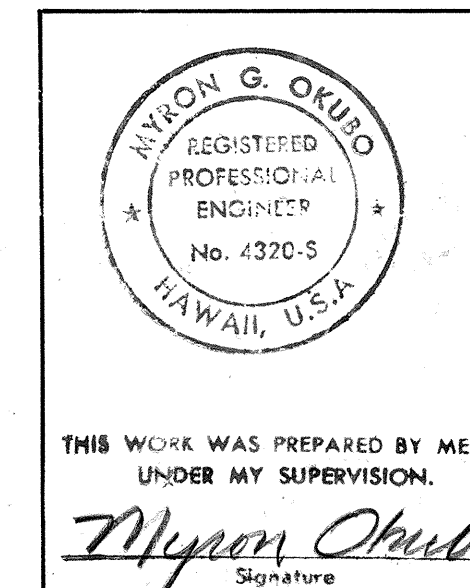

DATE	REVISION
STATE OF HAWAII DEPARTMENT OF TRANSPORTATION HIGHWAYS DIVISION PIER CAP SECTIONS HANAMAULU VIADUCT HANAMAULU-AHUKINI CUTOFF ROAD Ahukini Road to Kauai Hardwoods PROJECT NO. F-051-1(8) SCALE: AS SHOWN DATE: JULY 1985 SHEET NO. S-21 OF S-39 SHEETS	