

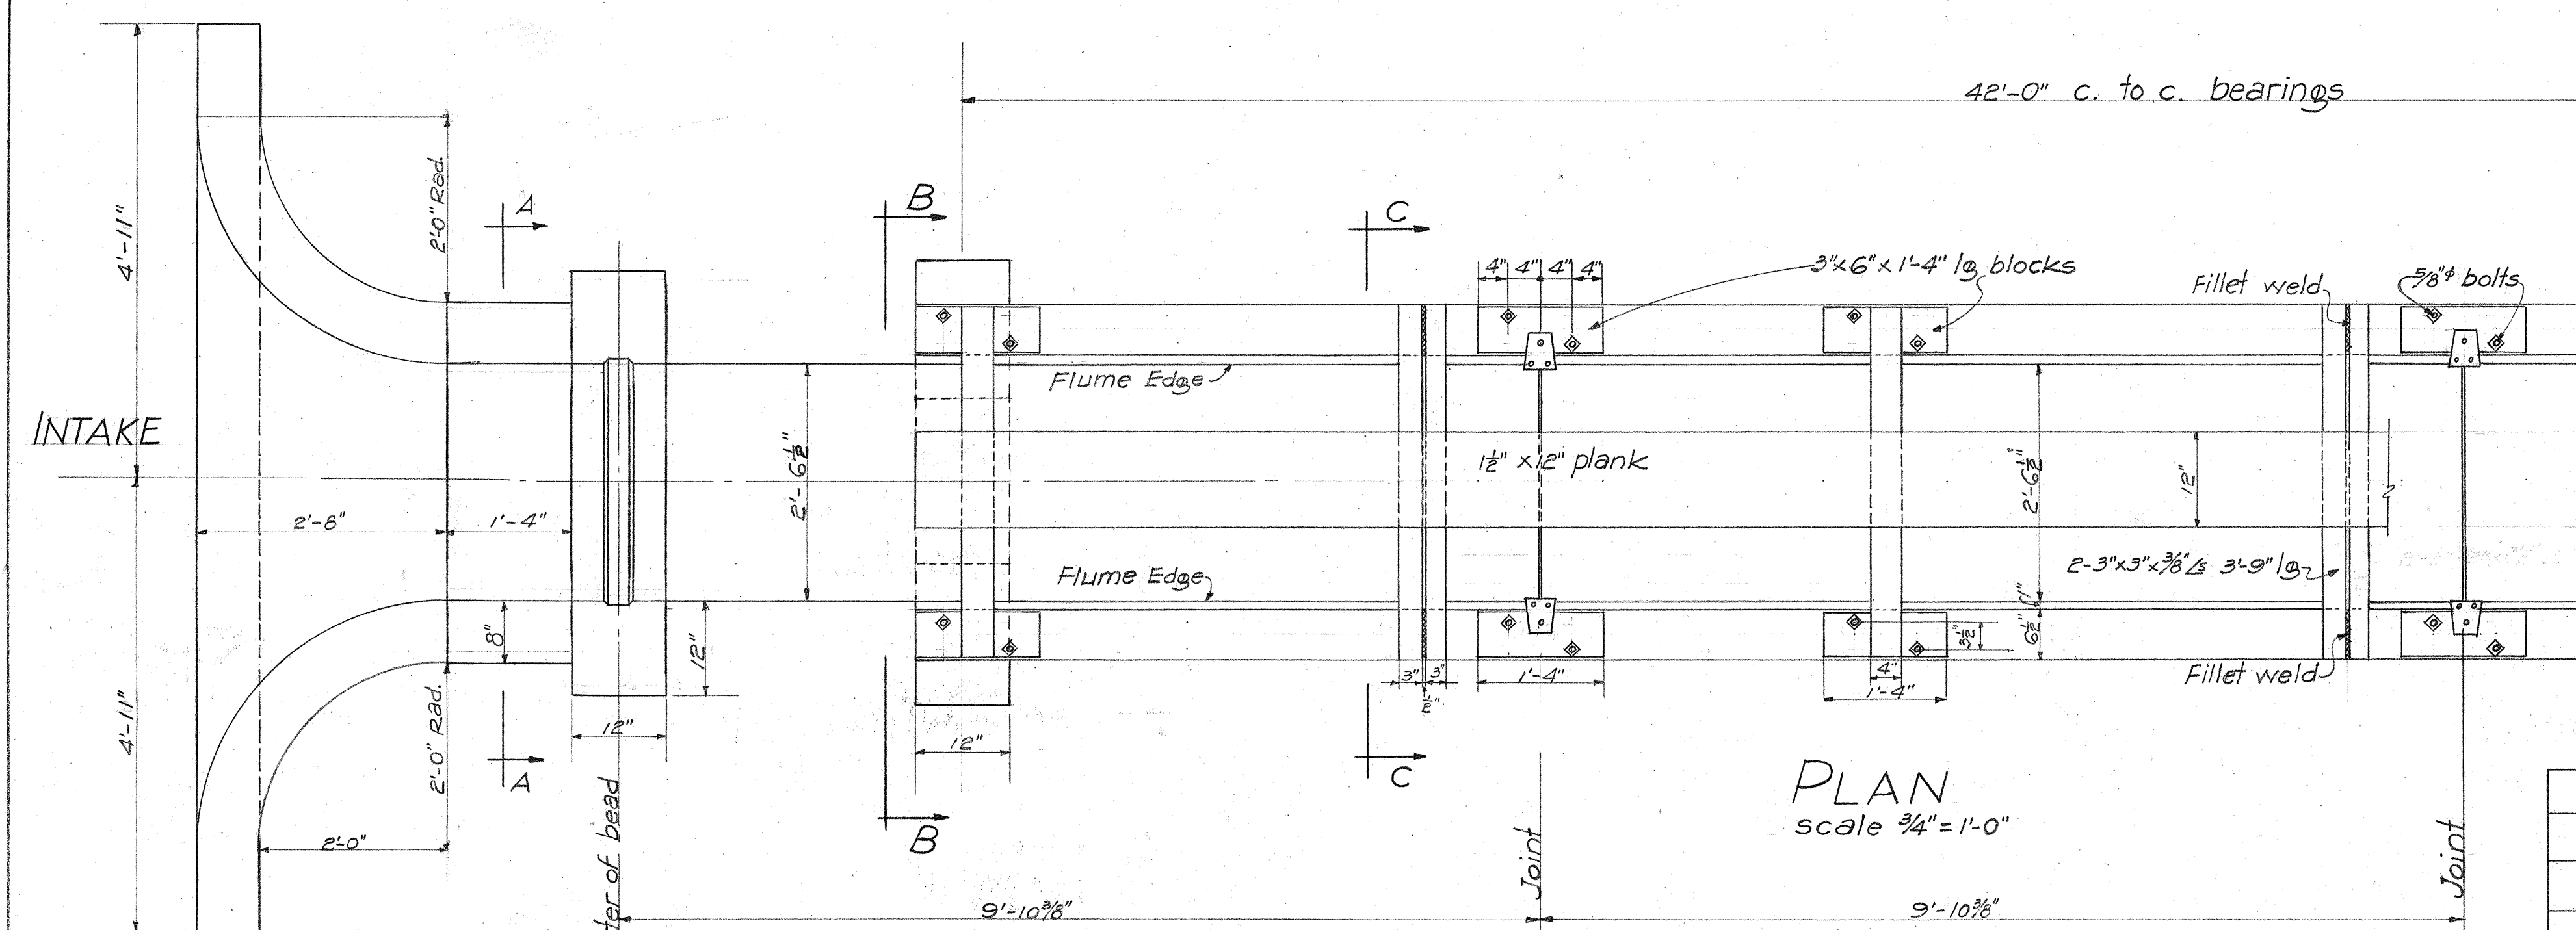
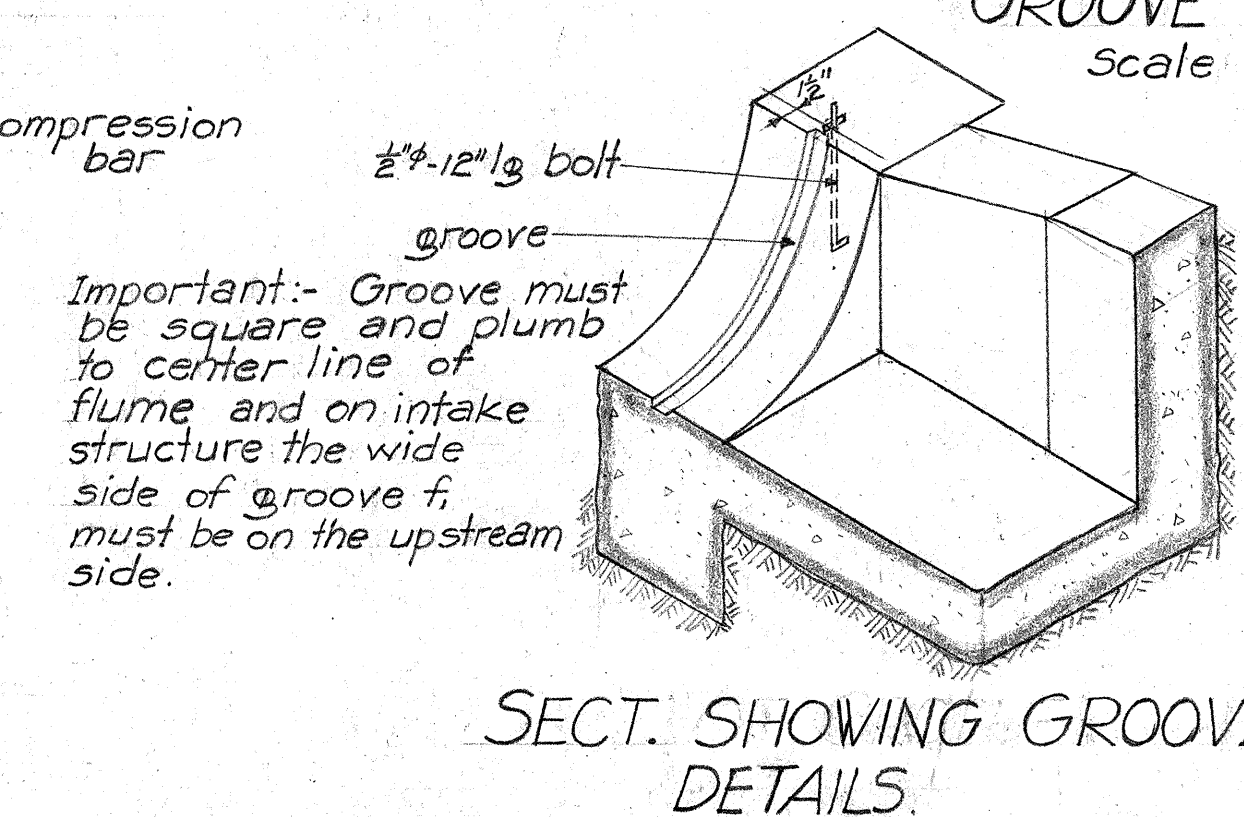
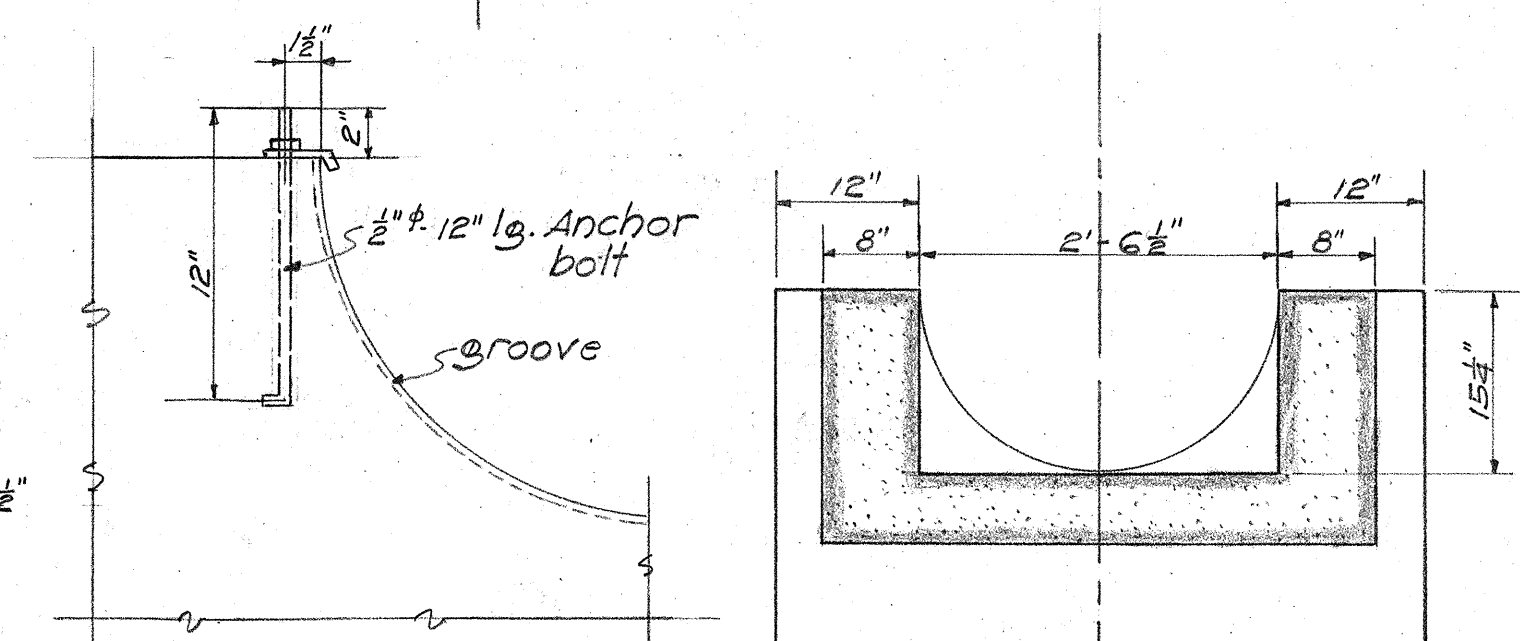
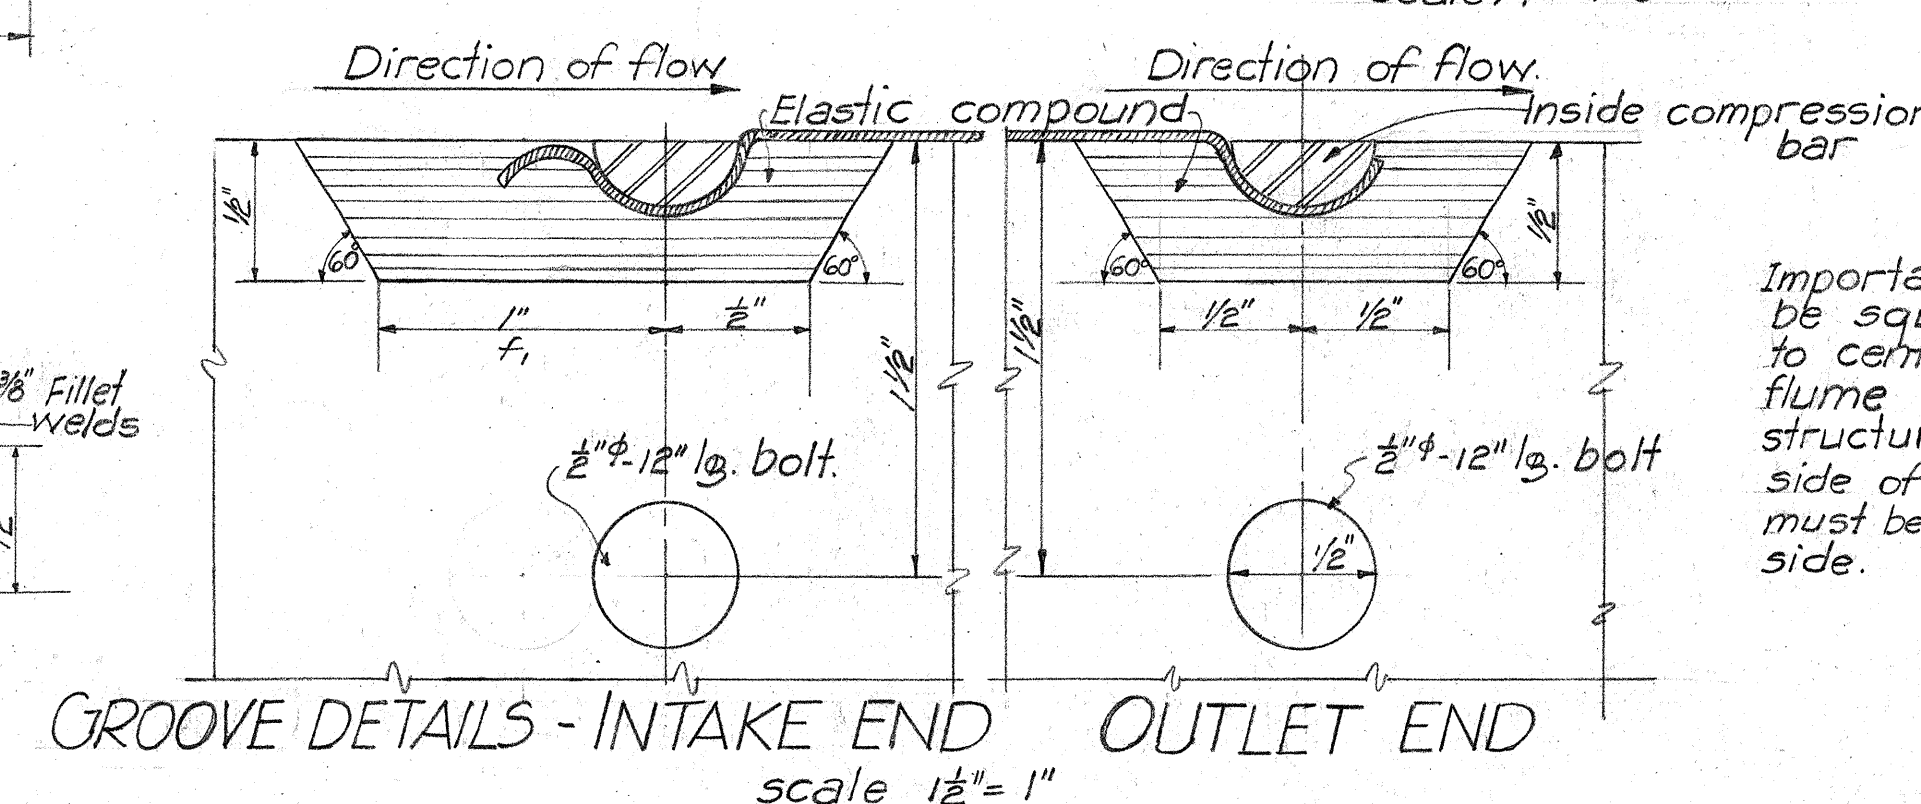
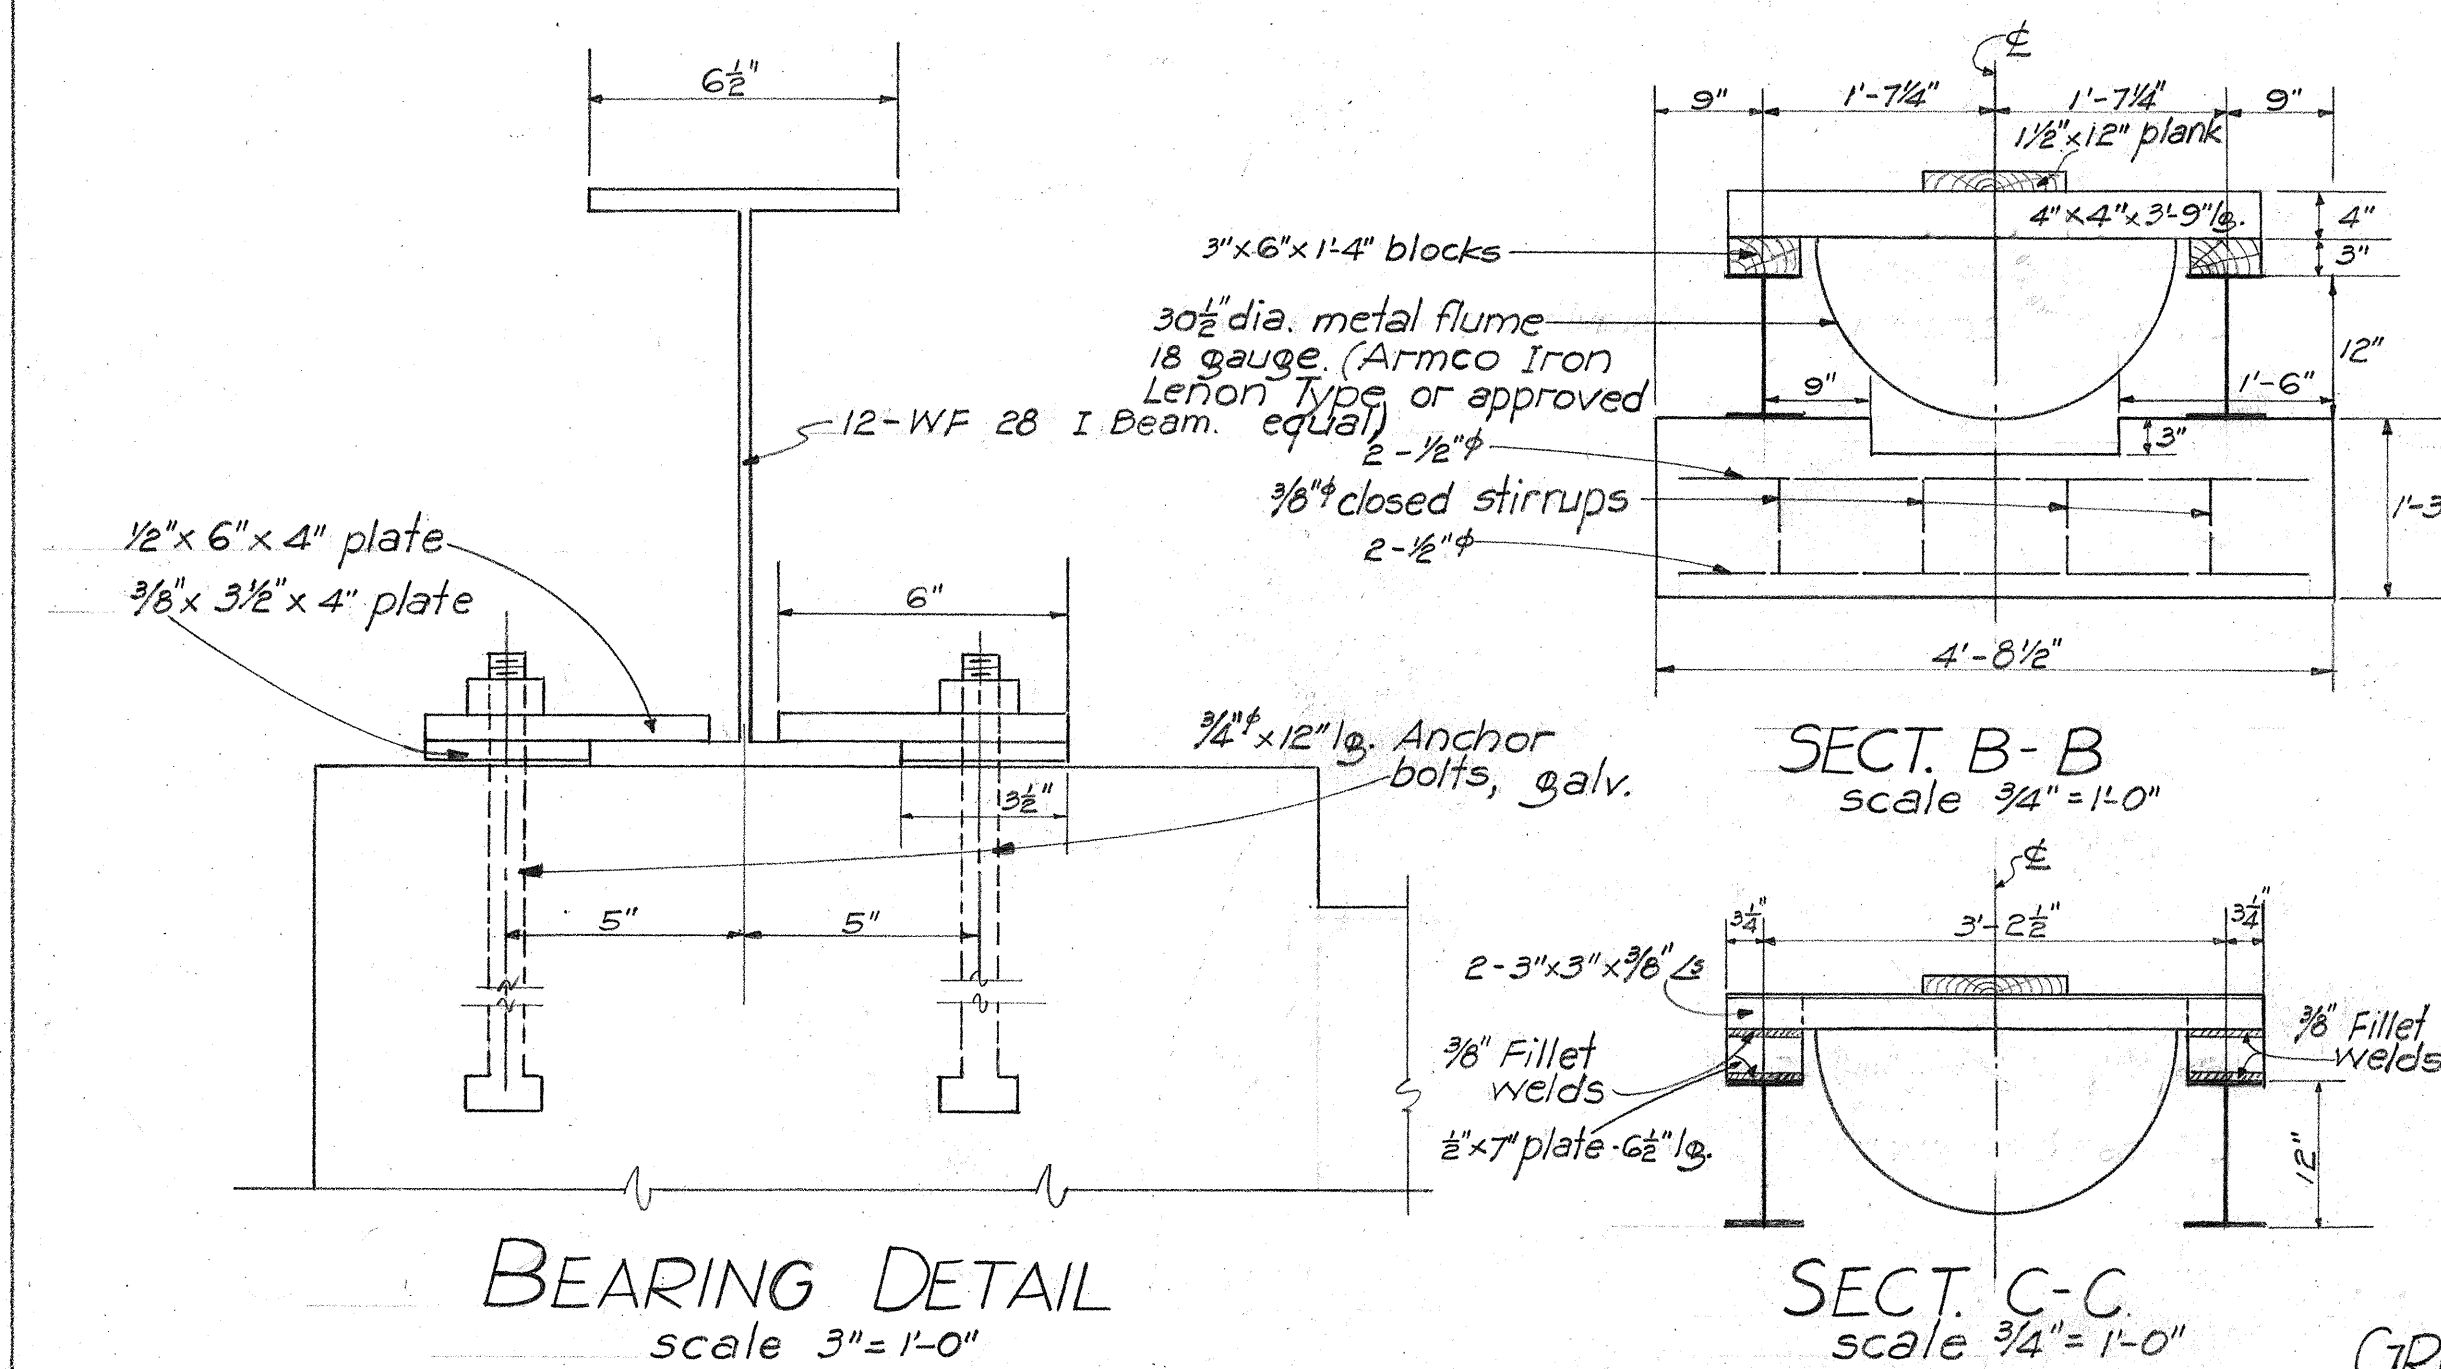


FED. ROAD DIST. NO.	STATE	FED. AID PROJ. NO.	FISCAL YEAR	SHEET NO.	TOTAL SHEETS
Hawaii	Haw.	F.A.G.H. 12A	1938	5	14

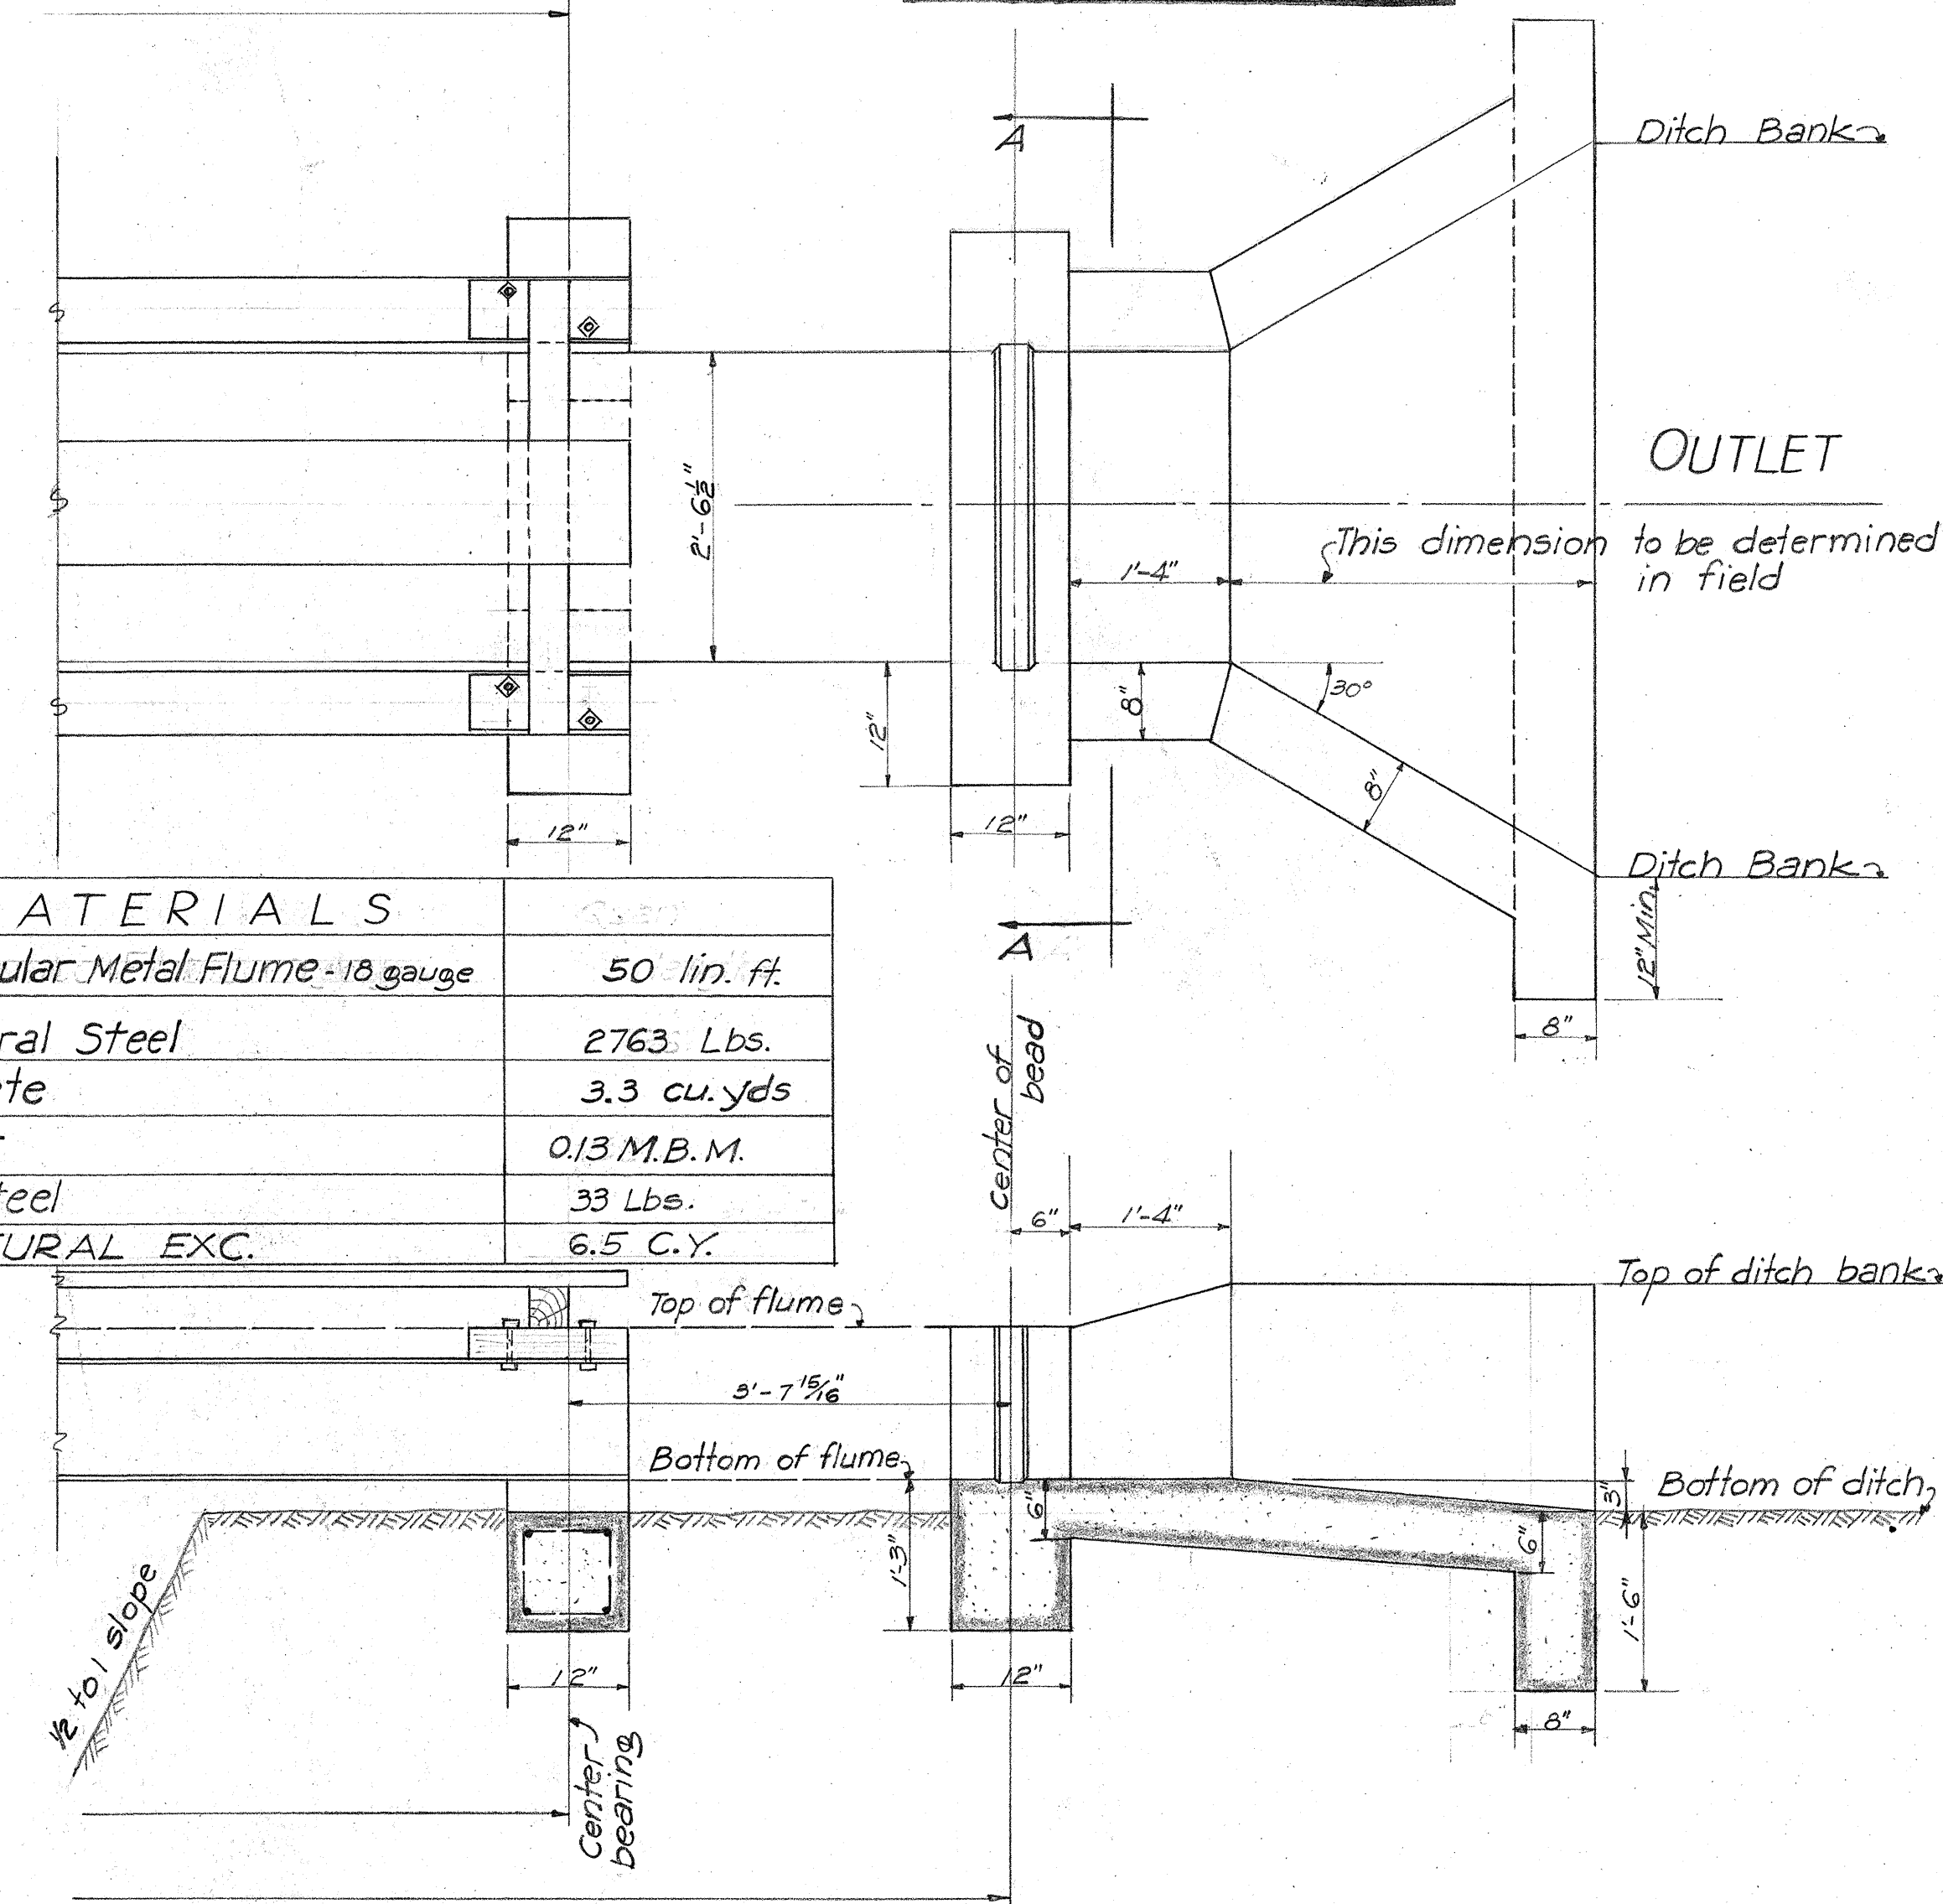

MATERIALS	
Semicircular Metal Flume - 18 gauge	50 lin. ft.
Structural Steel	2763 Lbs.
Concrete	3.3 cu. yds
Lumber	0.13 M.B.M.
Reinf. Steel	33 Lbs.
STRUCTURAL EXC.	6.5 C.Y.

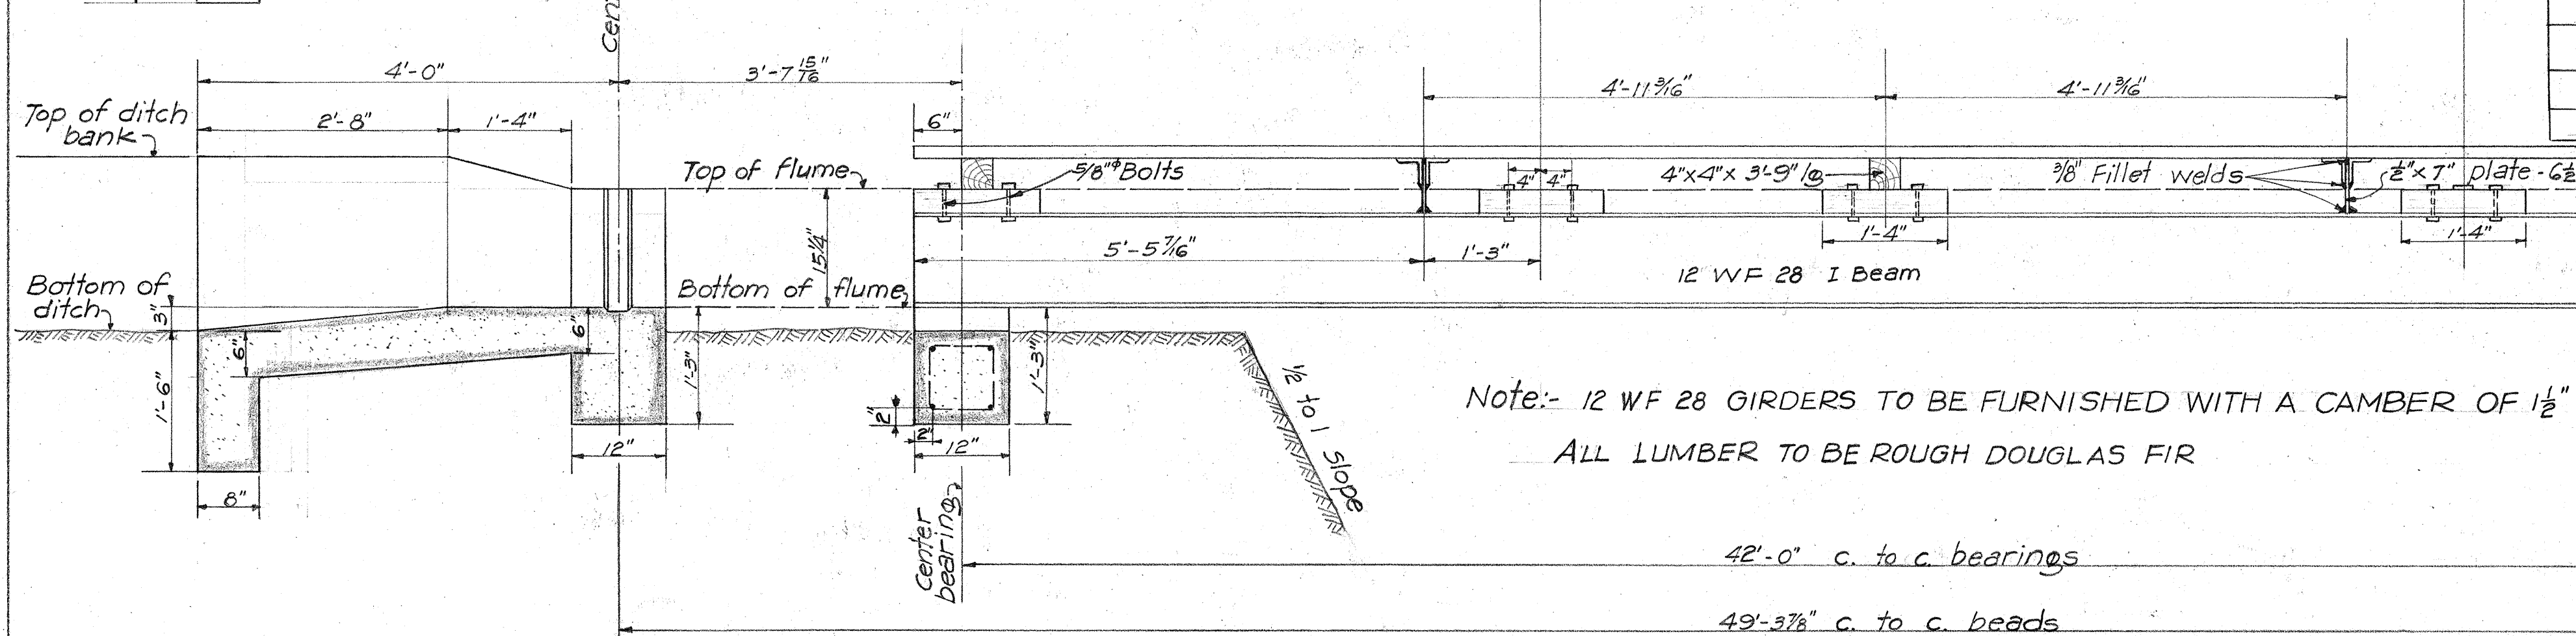

TERRITORIAL HIGHWAY DEPARTMENT
 SEMICIRCULAR METAL FLUME
 RR. STA. 18+64
 KAUAI BELT ROAD F.A.G.H. 12A
 JAN. 1938 SCALES AS NOTED