


FED. ROAD DIST. NO.	STATE	FED. AID PROJ. NO.	FISCAL YEAR	SHEET NO.	TOTAL SHEETS
HAWAII	HAW.	STP-051-1(9)	1999	ADD. 12	23


TRUE NORTH
SCALE: 1" = 40'

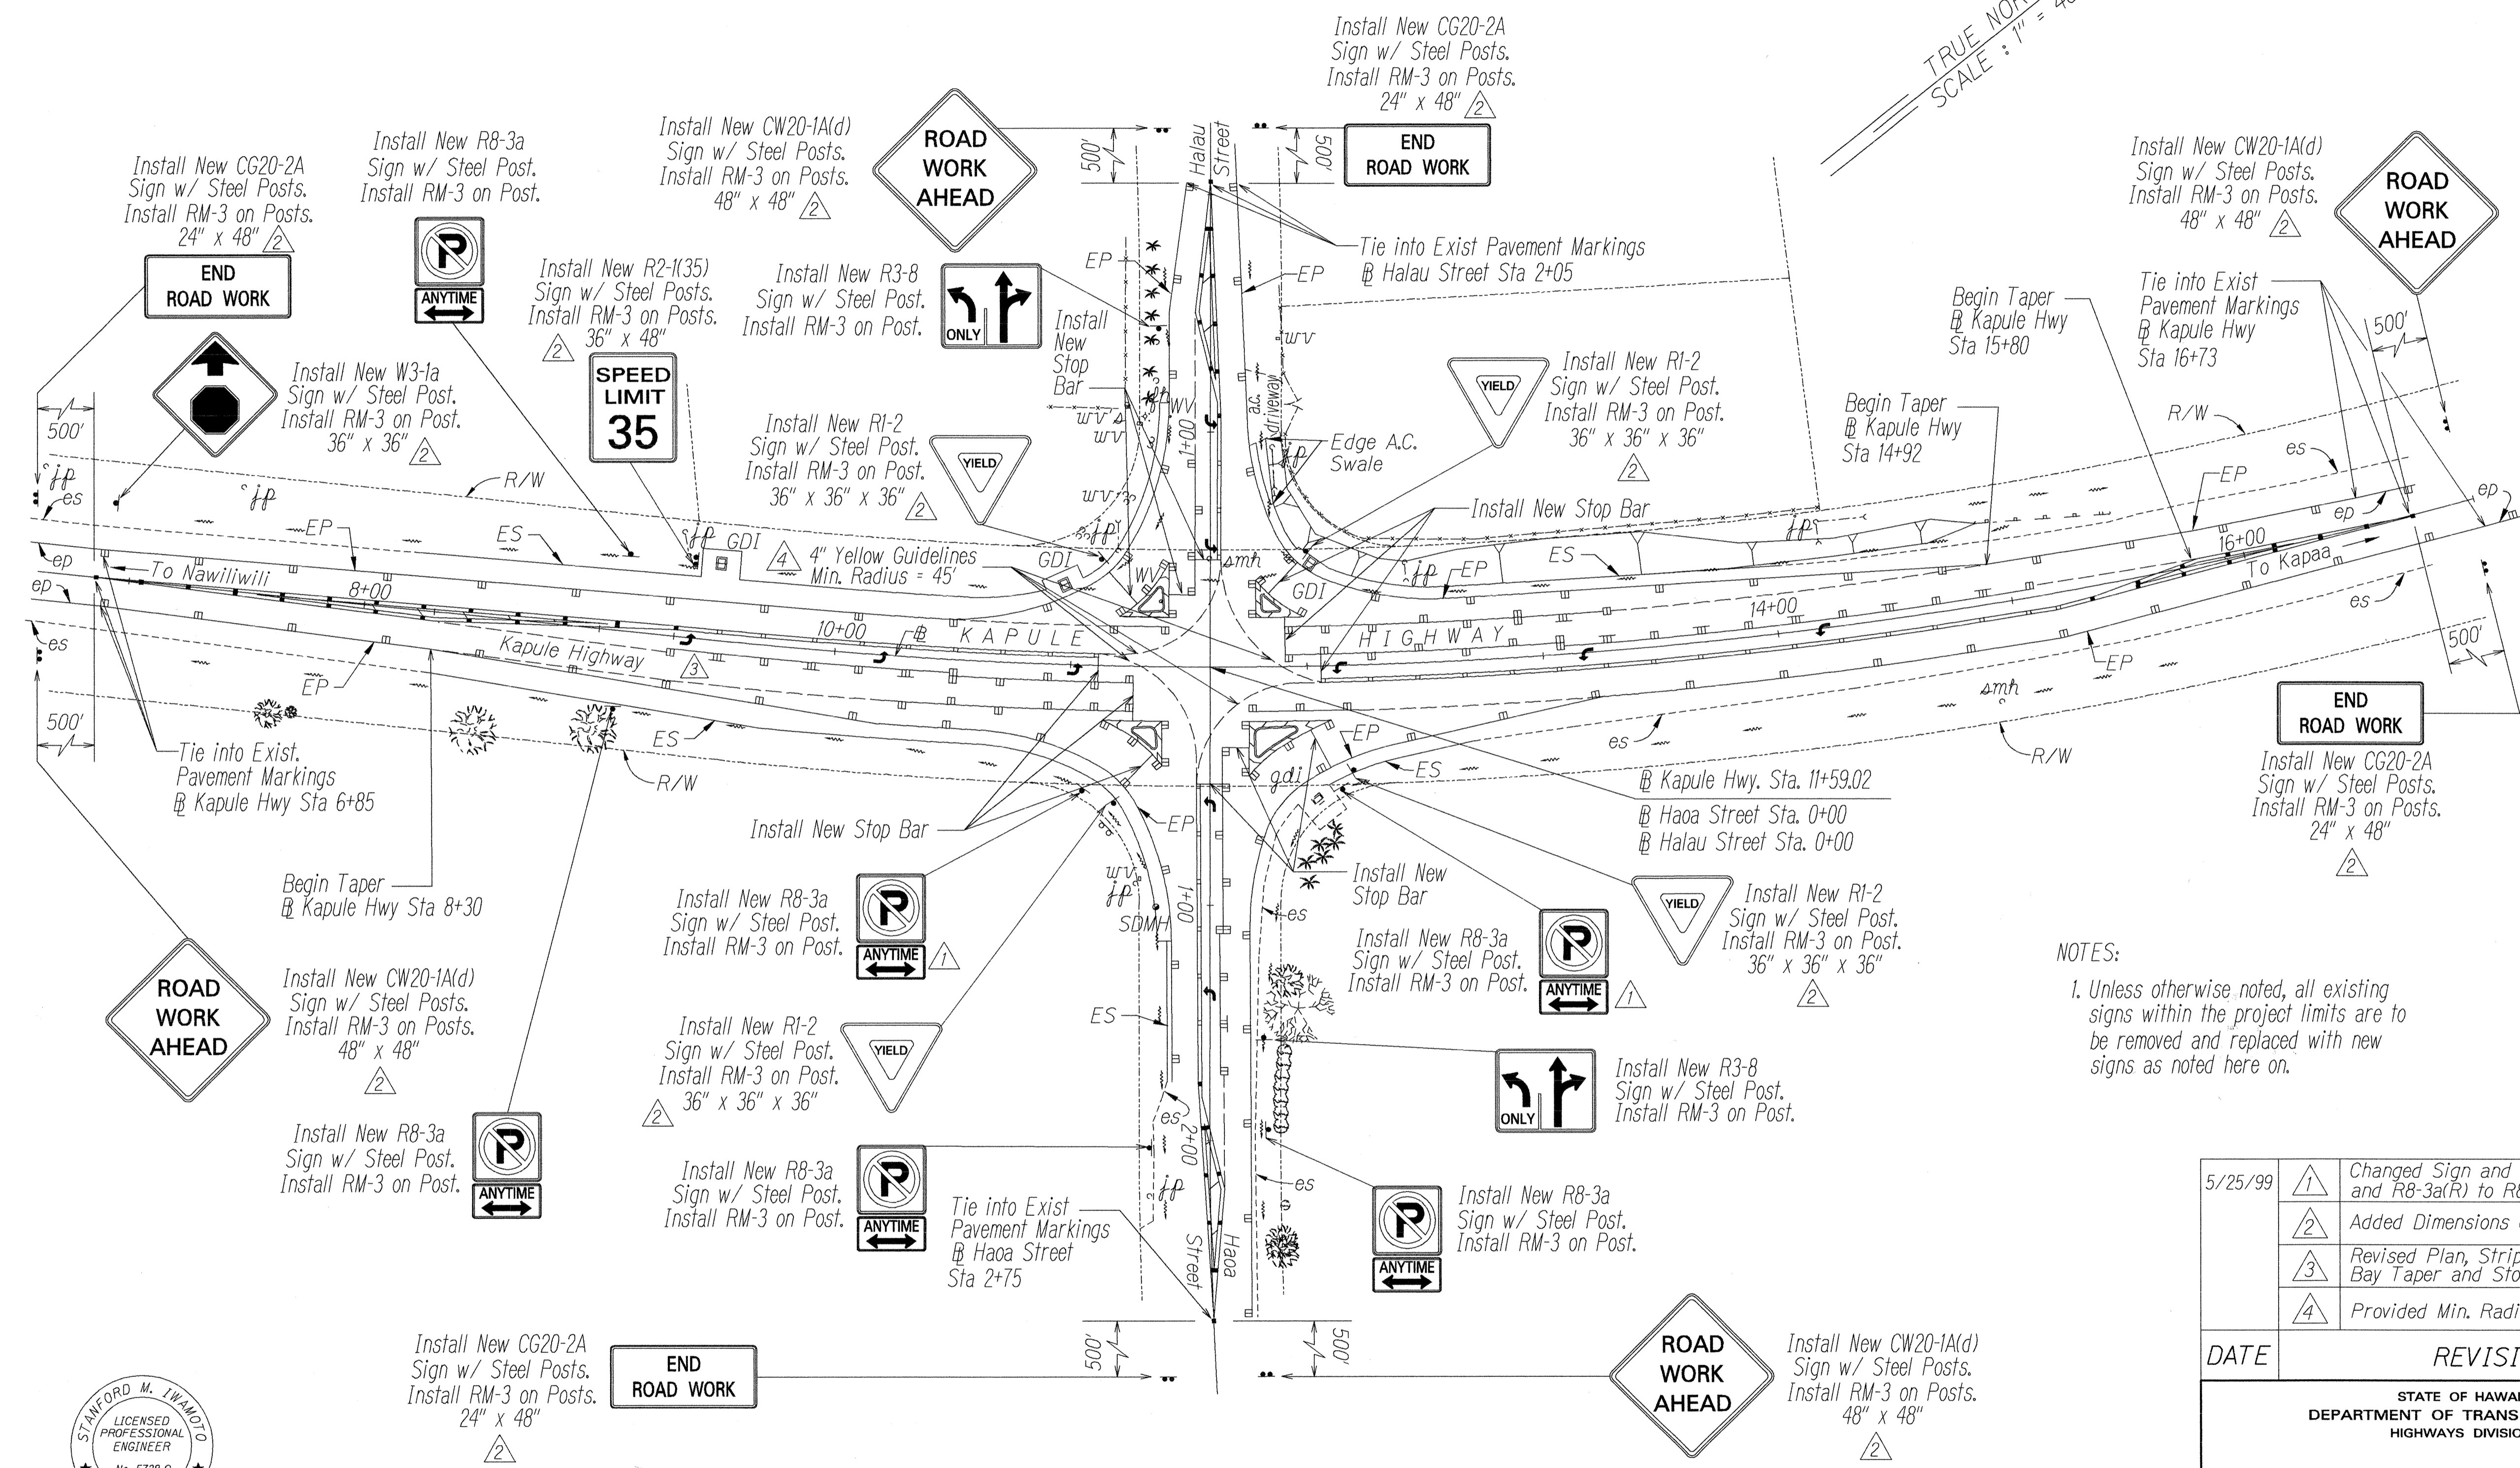

NOTES:
1. Unless otherwise noted, all existing signs within the project limits are to be removed and replaced with new signs as noted here on.

DATE	REVISION
5/25/99	1 Changed Sign and Symbol for R8-3a(L) and R8-3a(R) to R8-3a
	2 Added Dimensions of Traffic Signs
	3 Revised Plan, Striping and Marking for Bay Taper and Storage Lane
	4 Provided Min. Radius for Guide Lines

DATE	DATE	DATE	DATE	DATE	DATE
SURVEY PLOTTED BY	DRAWN BY	DESIGNED BY	QUANTITIES BY	CHECKED BY	
ORIGINAL PLAN	NOTE BOOK	No. 10/2/99			

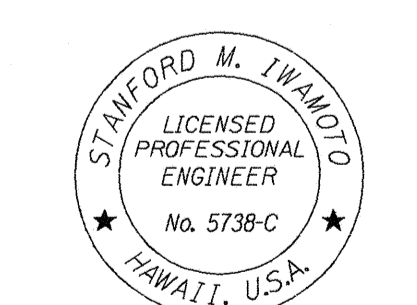

THIS WORK WAS PREPARED BY ME OR UNDER MY SUPERVISION
[Signature]
Signature

PAVEMENT MARKING AND SIGNING PLAN
Scale: 1" = 40'

[Signature]
County Engineer (For Work within the County R/W Only)
Dept. of Public Works, County of Kauai

STATE OF HAWAII
DEPARTMENT OF TRANSPORTATION
HIGHWAYS DIVISION

**PAVEMENT MARKING, STRIPING
AND TRAFFIC SIGNING PLAN**

KAPULE HIGHWAY,
INTERSECTION IMPROVEMENTS
AT HAOU STREET
Federal Aid Proj. No. STP-051-1(9)

Scale: 1" = 40' Date: Nov. 1999

SHEET No. 1 OF 1 SHEETS