INDEX TO DRAWINGS			
SHEET NO.	DESCRIPTION		
1	TITLE SHEET		
2	STANDARD PLANS SUMMARY		
3	GENERAL NOTES AND LEGEND		
4-5	TYPICAL SECTIONS		
6	ROADWAY PLAN		
7	DRAINAGE SYSTEM PLAN		
8	DRAINAGE SYSTEM PROFILE AND TRENCH SECTION		
9	DRAINAGE DETAILS		
10	PAVEMENT MARKING LEGEND AND NOTES		
11	STRIPING PLAN		
12	PAVEMENT MARKING, STRIPING AND TRAFFIC SIGNING PLAN		
13	TRAFFIC SIGN SUMMARY AND PAVEMENT MARKING SUMMARY		
14	LEGEND, NOTES AND DETAILS		
15	TRAFFIC SIGNAL PLAN		
16	PULLBOX DETAILS		
17	MISCELLANEOUS DETAILS		
18	STREET NAME SIGN DETAIL		
19	ELECTRICAL SYMBOLS & NOTES		
20	ELECTRICAL PLAN		
21	TYPICAL DUCT SECTION & MISCELLANEOUS DETAILS		
22	HIGHWAY LIGHT DETAILS		
23	HIGHWAY LIGHT CONNECTION DIAGRAM (NON-METERED)		

STATE OF HAWAII

## DEPARTMENT OF TRANSPORTATION


DIVISION HIGHWAYS HONOLULU, HAWAII

"AS-BUILT"


PLANS FOR

## KAPULE HIGHWAY INTERSECTION IMPROVEMENTS AT HAOA STREET FEDERAL AID PROJECT NO. STP-051-1(9)

DISTRICT OF LIHUE ISLAND OF KAUAI

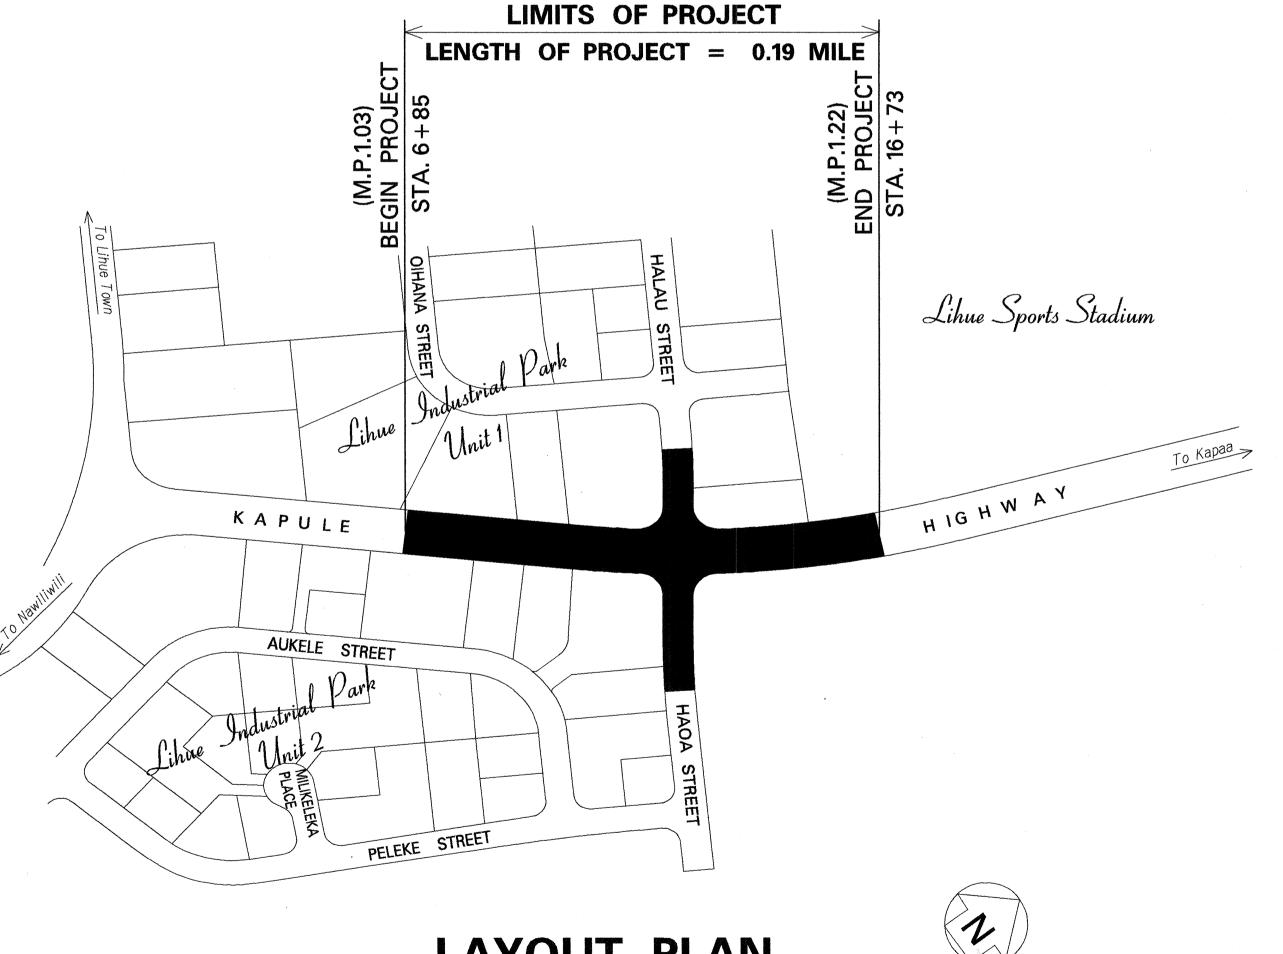



## LAYOUT PLAN

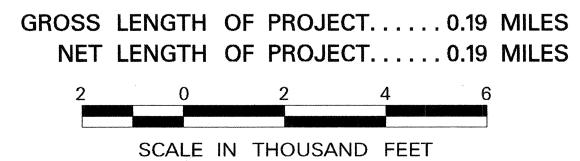

FED. ROAD DIST. NO. FED. AID PROJ. NO. FISCAL YEAR STP-051-1(9) 23



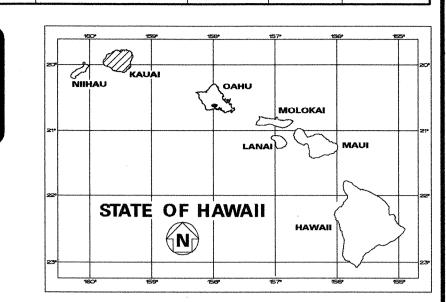

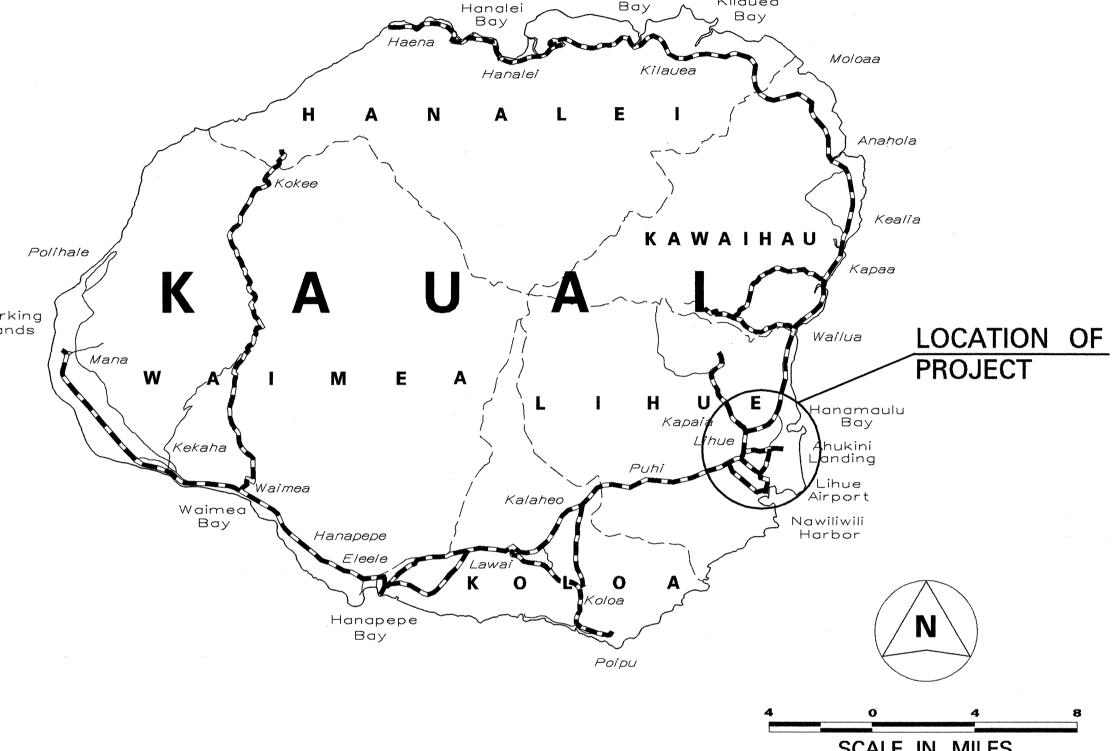

FEDERAL AID PROJECTS PREVIOUSLY CONSTRUCTED OR UNDER CONSTRUCTION

MILE POST 1.03 TO MILE POST 1.22

## DESIGN DESIGNATION

$AD^{-}$	Г (1998)	13,390
AD	Γ (2018)	22,680
DH\	V	1,930
D		55/45
T		6.0 %
V		35 M.P

ACTUAL QUANTITIES, REFER TO PROJECT LEDGER

DEPARTMENT OF TRANSPORTATION STATE OF HAWAII

**APPROVED:** 

DIR. OF TRANSPORTATION

4/14/99 DATE