



FED. ROAD DIST. NO.	STATE	FED. AID PROJ. NO.	FISCAL YEAR	SHEET NO.	TOTAL SHEETS
HAWAII	HAW.	STP-051-K(20)	2000		27

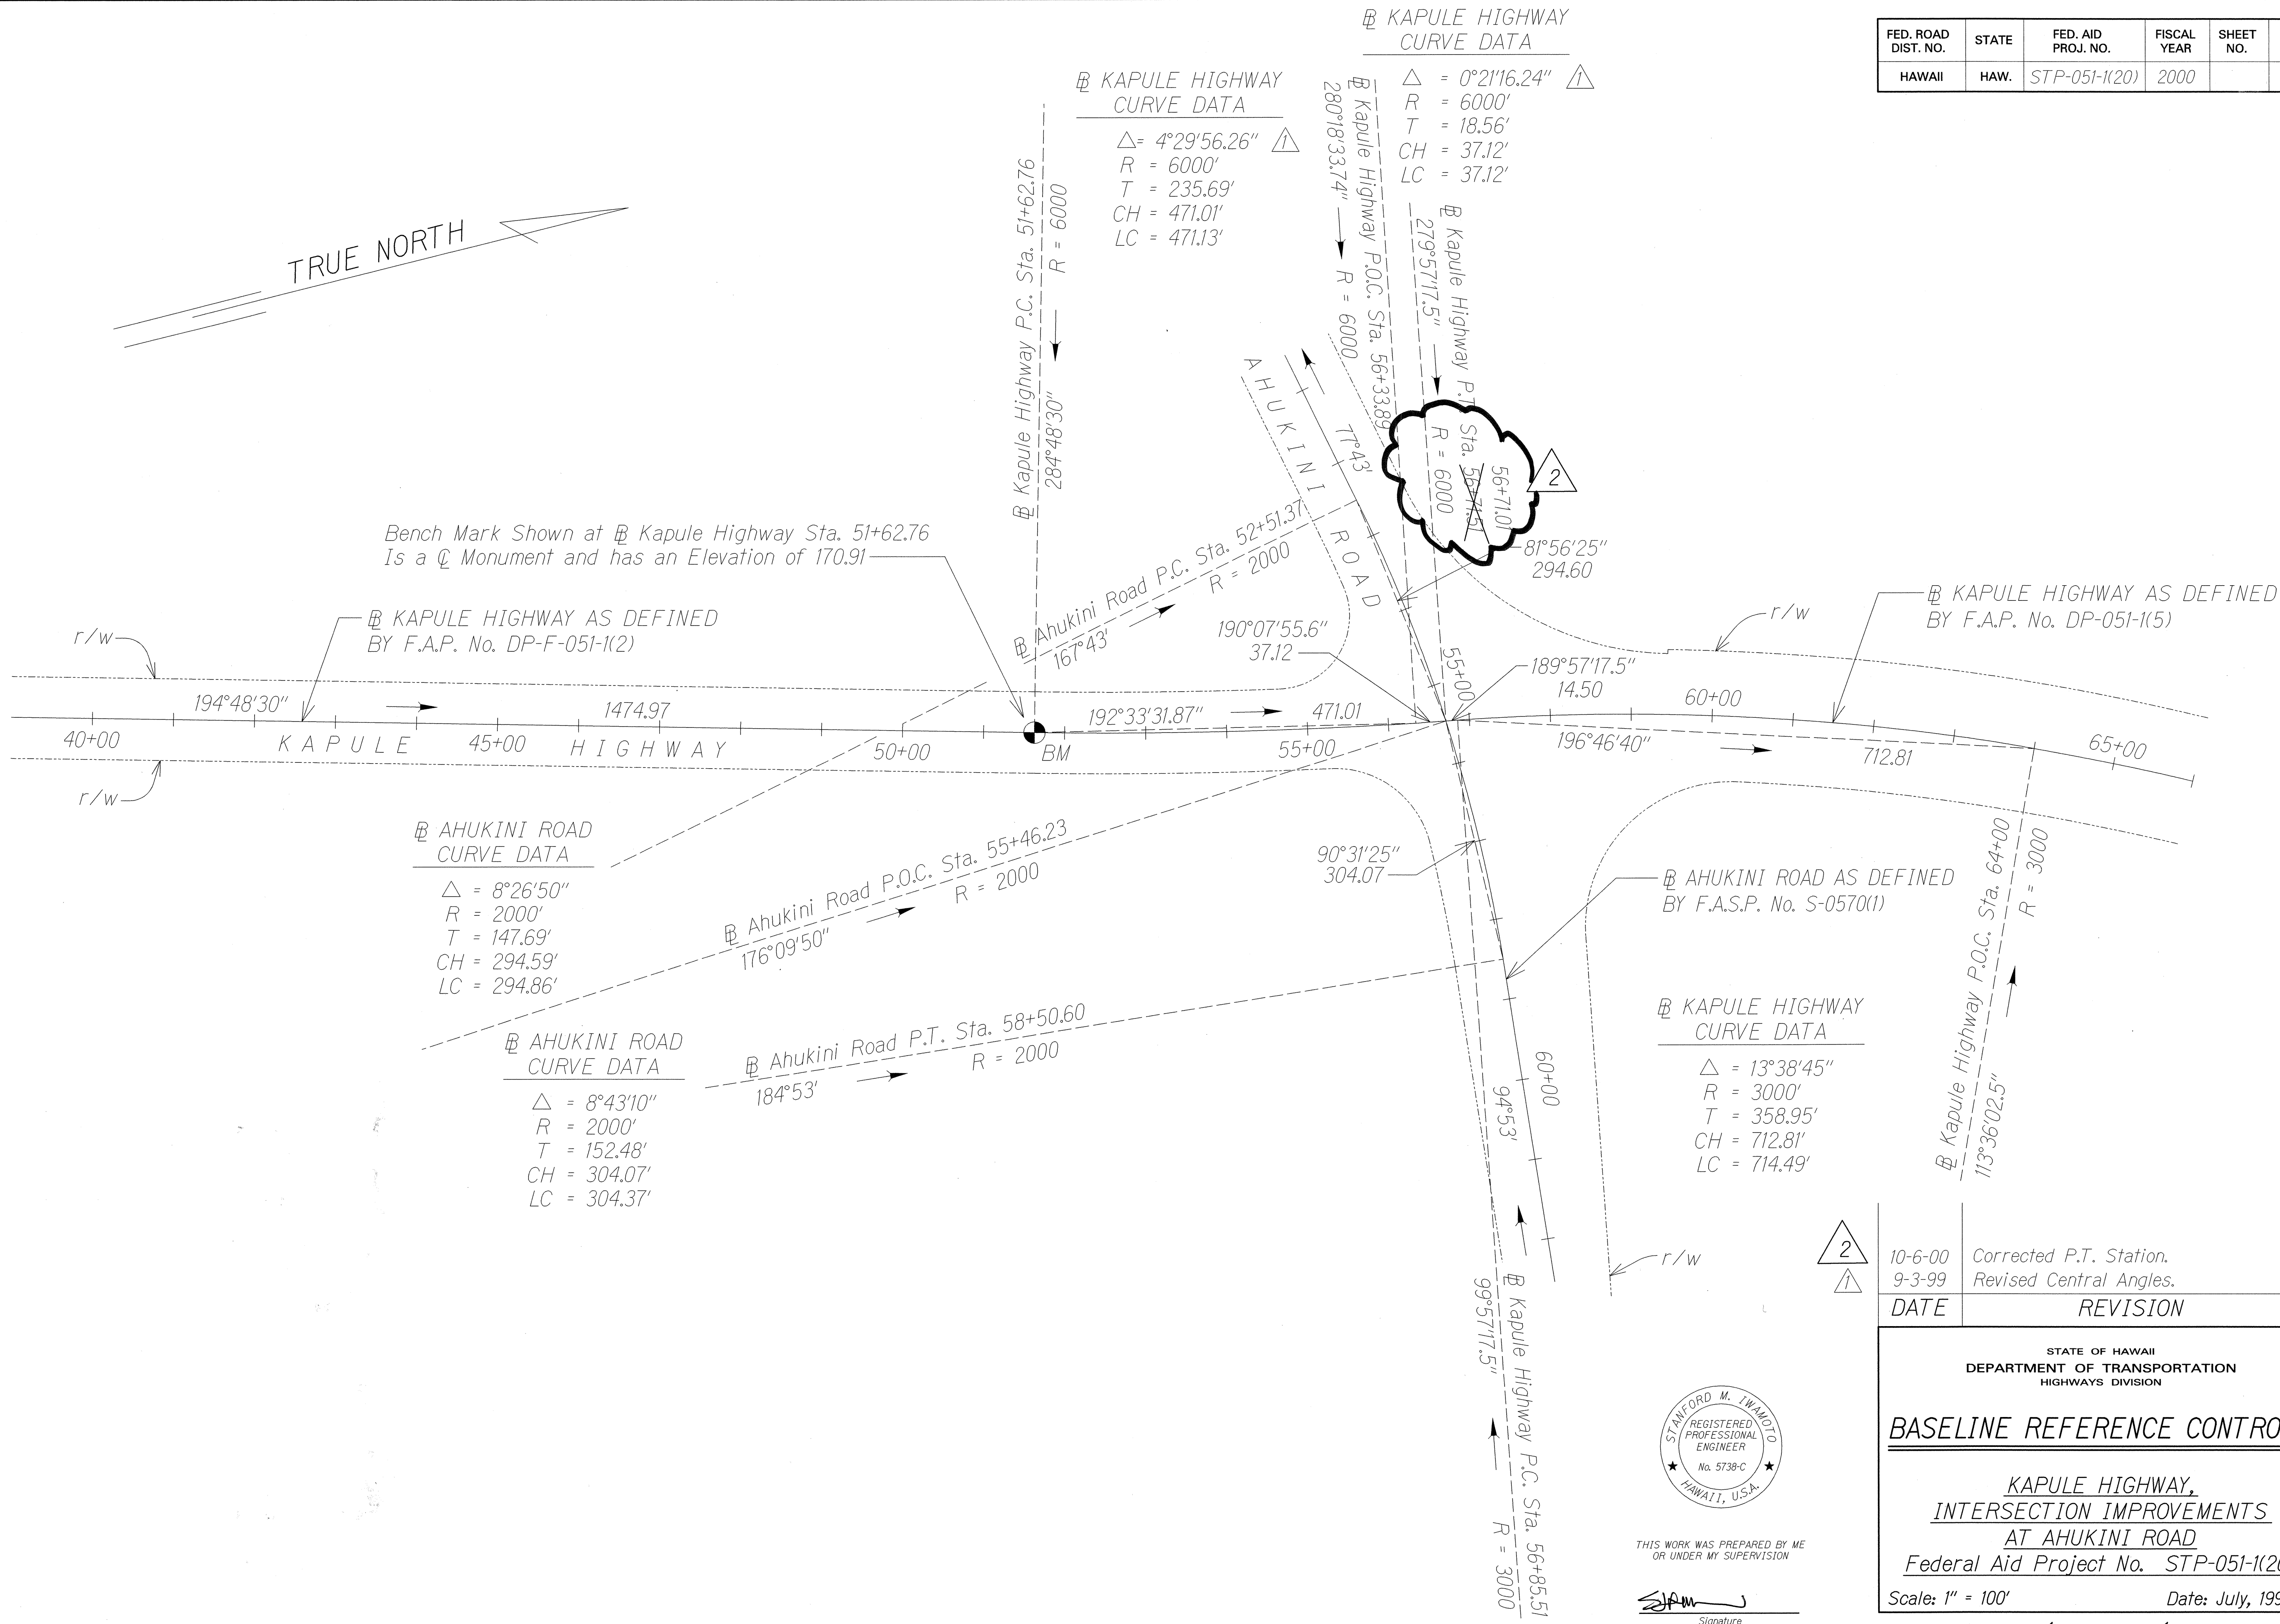

SURVEY PLOTTED BY	DATE
DRAWN BY	DATE
DESIGNED BY	DATE
QUANTITIES BY	DATE
CHECKED BY	DATE

ORIGINAL PLAN	DATE
NOTE BOOK	DATE
STAMP	DATE

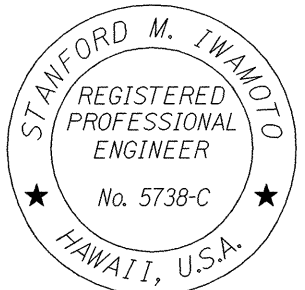

THIS WORK WAS PREPARED BY ME OR UNDER MY SUPERVISION

Signature

10-6-00	Corrected P.T. Station.
9-3-99	Revised Central Angles.
DATE	REVISION

STATE OF HAWAII DEPARTMENT OF TRANSPORTATION HIGHWAYS DIVISION	
<u>BASELINE REFERENCE CONTROLS</u>	
KAPULE HIGHWAY, INTERSECTION IMPROVEMENTS AT AHUKINI ROAD Federal Aid Project No. STP-051-K(20)	
Scale: 1" = 100'	Date: July, 1999
SHEET No. 1	OF 1 SHEETS