

FED. ROAD DIST. NO.	STATE	FED. AID PROJ. NO.	FISCAL YEAR	SHEET NO.	TOTAL SHEETS
HAWAII	HAW.	STP-051-1(20)	2000	ADD.3	27

LEGEND


GENERAL NOTES

1. The scope of work for this project includes, but is not limited to, removing existing pavement markings and traffic signs and asphalt concrete curbs, installing new pavement markings and traffic signs, placing base courses, paving asphalt concrete pavement, grading, installing concrete curbs, grading, installing traffic signals, and hydromulch seeding.
2. The Contractor is reminded of the requirements of Subsection 108.01 - Subletting of Contract, which requires him to perform work amounting to not less than 50 percent of the total contract cost less deductible items. Non-compliance with this Subsection may be grounds for rejection of bid.
3. The Contractor's attention is directed to the following Sections of the Special Provisions: Subsection 107.13 - Public Convenience and Safety, Subsection 107.21-Contractor's Responsibility for Utility Property and Services, and Section 645-Traffic Control.
4. At the end of each day's work, the Contractor shall remove all equipment and other obstructions to permit free and safe passage of public traffic.
5. The existence and location of underground utilities, manholes, monuments and structures as shown on the plans are from the latest available data but the accuracy is not guaranteed. The encountering of other obstacles during the course of the work is possible. The Contractor shall be held liable for any damages incurred to the existing facilities and/or improvements as a result of his operations.
6. The Contractor shall notify the State in writing, two (2) weeks prior to starting paving operations.
7. Smooth riding connections shall be constructed at all limits of new A.C. pavement including the beginning and end of project, connecting approaches, side streets and driveways as shown on the plans and/or as directed by the Engineer.
8. Dressing of shoulder, shall be in accordance with Section 210 - Dressing of Shoulder, of the Special Provision. (See Specifications)
9. Earth swale shall be graded to drain. This work shall be considered incidental to the various contract items.
10. The Contractor shall provide for access to and from all existing side streets and/or driveways at all times.
11. All saw cutting work shall be considered incidental to item no. 401.0400.-A.C. Pavement Mix No. IV.
12. Two lanes of traffic (one lane each direction) shall be provided at all times. Work within the State right-of-way shall be conducted between the hours of 8:30 a.m. to 3:30 p.m.. Failure of the Contractor to keep the two lanes of traffic open shall result in the assessment of liquidated damages as specified in Subsection 108.08 of the standard specifications.
13. All references to "SC" shall be read as "TS" traffic signal conduit and all references to "SCMH" shall be read as "TSPB" traffic signal pullbox, as shown in the Legend of Sheet.

	Reconstruction Areas		Existing Grated Drain Inlet
	Cold Planing Areas		Existing Catch Basin
	Resurfacing Limits		Existing Storm Drain Manhole
	Existing Electrical Lines (Overhead)		Existing Drain Line
	Existing Electrical Lines (Underground)		Existing Slotted Drain Inlet
	Existing Joint Pole		Existing Headwall
	Existing Power Pole		Existing Swale
	Existing Electrical Manhole		Existing Sewer Line
	Existing Electrical Pullbox		Existing Sewer Manhole
	Existing Telephone Lines (Overhead)		Existing Sewer Cleanout
	Existing Telephone Lines (Underground)		Existing Highway Lighting Standard
	Existing Telephone Pole		Existing Traffic Sign
	Existing Telephone Pullbox		New Traffic Sign
	Existing Telephone Manhole		Existing Guard Rail
	Adjusted Telephone Pullbox		Existing Edge Shoulder
	Existing TV Cable (Overhead)		New Edge Shoulder
	Existing Traffic Signal Conduit		Existing Edge Pavement
	New Traffic Signal Conduit		New Edge Pavement
	Existing Traffic Signal Pole		Existing Highway Right of Way
	New Traffic Signal Pole		Existing Contour
	Existing Traffic Signal Pullbox		Finish Contour
	Adjusted Traffic Signal Pullbox		Existing Grade Elevation
	New Traffic Signal Pullbox		Finish Grade Elevation
	Existing Water Meter		A.C. Curb
	Existing Water Valve Box		Existing Rock Wall
	Existing Air Valve		Existing Tree
	Existing Fire Hydrant		Slope Direction Lines
	Existing Water Line		

5-3-99	Revised Legend. Added General Note No. 13.
DATE	REVISION

SURVEY PLOTTED BY	DATE
DRAWN BY	DATE
DESIGNED BY	DATE
QUANTITIES BY	DATE
CHECKED BY	DATE
ORIGINAL PLAN	
NOTE BOOK	
N.	

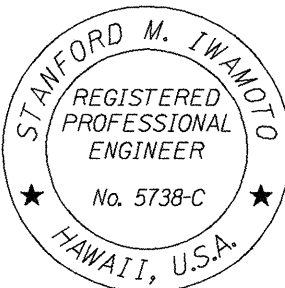

THIS WORK WAS PREPARED BY ME
OR UNDER MY SUPERVISION

Stanford M. Iwamoto
Signature

STATE OF HAWAII DEPARTMENT OF TRANSPORTATION HIGHWAYS DIVISION	
GENERAL NOTES AND LEGEND	
KAPULE HIGHWAY, INTERSECTION IMPROVEMENTS AT AHUKINI ROAD Federal Aid Project No. STP-051-1(20)	
Scale: None	Date: July, 1999
SHEET No. 1	OF 1 SHEETS