




| FED. ROAD DIST. NO. | STATE | FED. AID PROJ. NO. | FISCAL YEAR | SHEET NO. | TOTAL SHEETS |
|---------------------|-------|--------------------|-------------|-----------|--------------|
| HAWAII              | HAW.  | STP-051-K(20)      | 1999        | C.O. 13   | 27           |

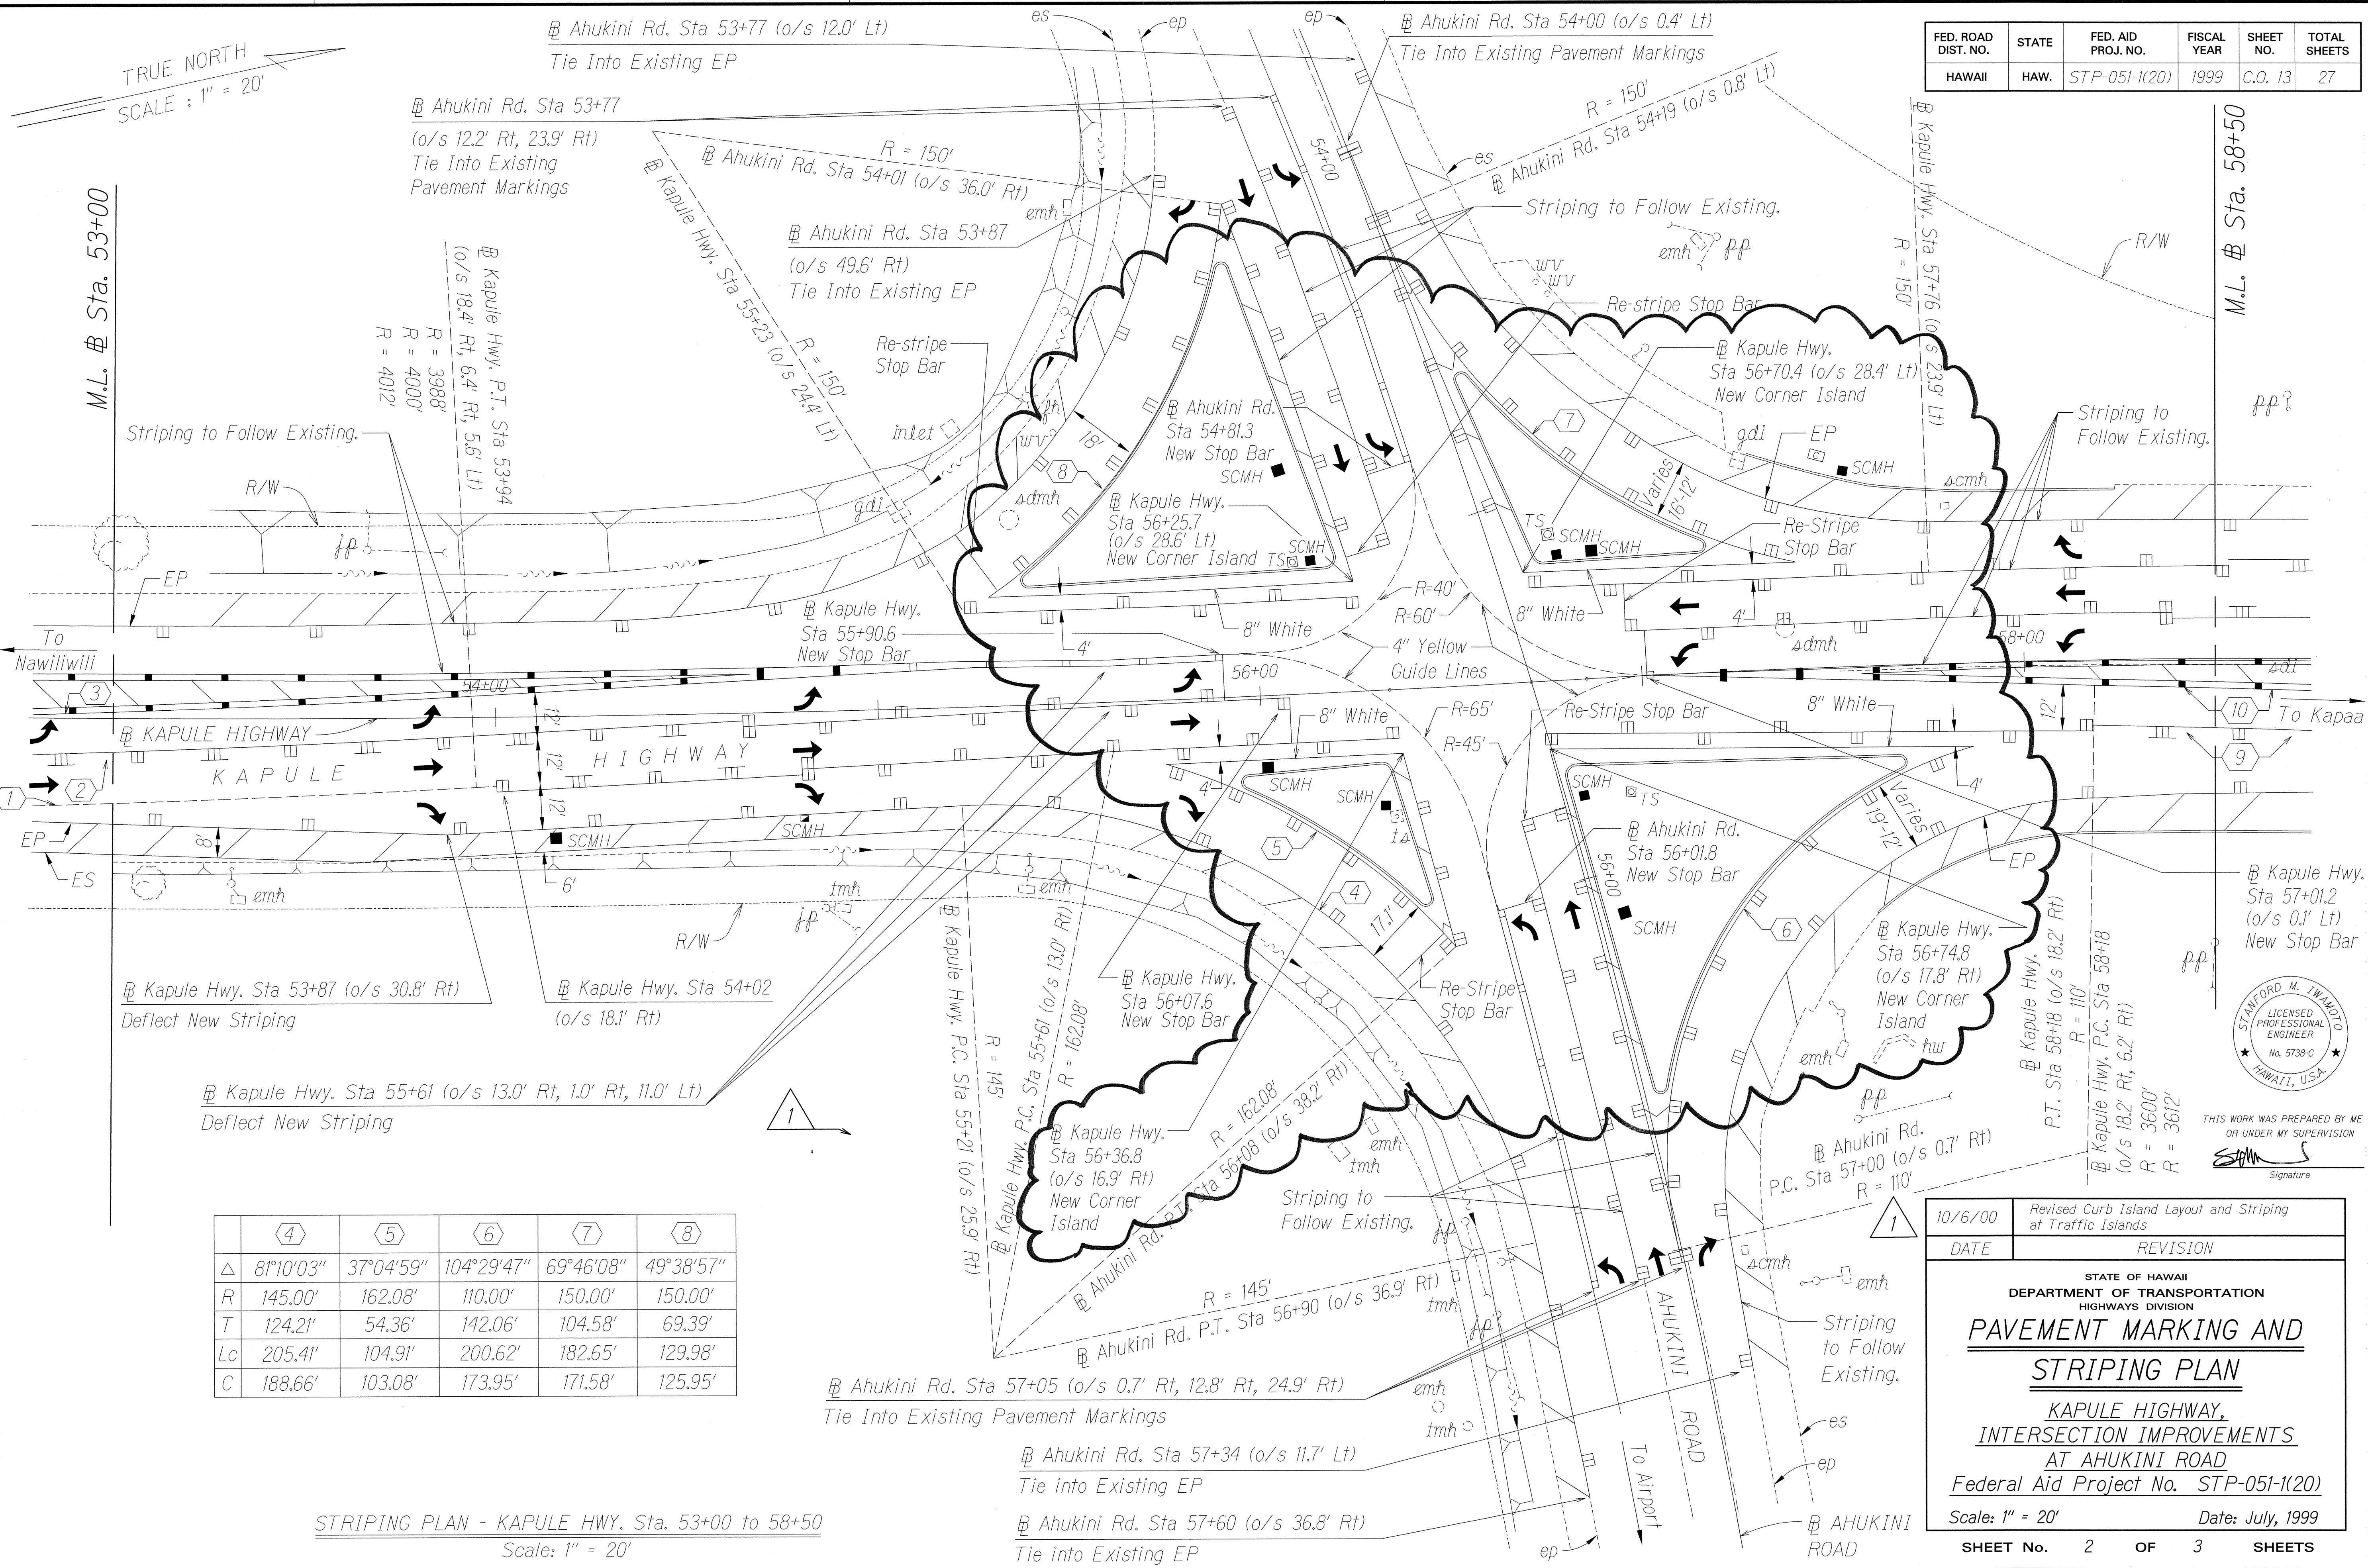

M.L. @ Sta. 53+00

M.L. @ Sta. 58+50

|    | ④         | ⑤         | ⑥          | ⑦         | ⑧         |
|----|-----------|-----------|------------|-----------|-----------|
| Δ  | 81°10'03" | 37°04'59" | 104°29'47" | 69°46'08" | 49°38'57" |
| R  | 145.00'   | 162.08'   | 110.00'    | 150.00'   | 150.00'   |
| T  | 124.21'   | 54.36'    | 142.06'    | 104.58'   | 69.39'    |
| Lc | 205.41'   | 104.91'   | 200.62'    | 182.65'   | 129.98'   |
| C  | 188.66'   | 103.08'   | 173.95'    | 171.58'   | 125.95'   |

STRIPING PLAN - KAPULE HWY. Sta. 53+00 to 58+50  
Scale: 1" = 20'

|         |                                                            |
|---------|------------------------------------------------------------|
| 10/6/00 | Revised Curb Island Layout and Striping at Traffic Islands |
| DATE    | REVISION                                                   |

STATE OF HAWAII  
DEPARTMENT OF TRANSPORTATION  
HIGHWAYS DIVISION


### PAVEMENT MARKING AND STRIPING PLAN

KAPULE HIGHWAY,  
INTERSECTION IMPROVEMENTS  
AT AHUKINI ROAD  
Federal Aid Project No. STP-051-K(20)

Scale: 1" = 20'      Date: July, 1999

SHEET No. 2 OF 3 SHEETS

|                  |                   |      |
|------------------|-------------------|------|
| ORIGINAL<br>PLAN | SURVEY PLOTTED BY | DATE |
|                  | DRAWN BY          | DATE |
|                  | DESIGNED BY       | DATE |
|                  | NOTED BY          | DATE |
| NOTE BOOK        | QUANTITIES BY     | DATE |
|                  | CHECKED BY        | DATE |
|                  |                   |      |
|                  |                   |      |

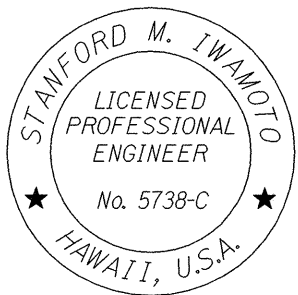

THIS WORK WAS PREPARED BY ME OR UNDER MY SUPERVISION  
Signature

