


TRUE NORTH
SCALE : 1" = 20'


FED. ROAD DIST. NO.	STATE	FED. AID PROJ. NO.	FISCAL YEAR	SHEET NO.	TOTAL SHEETS
HAWAII	HAW.	STP-051-K(20)	2000	9	27

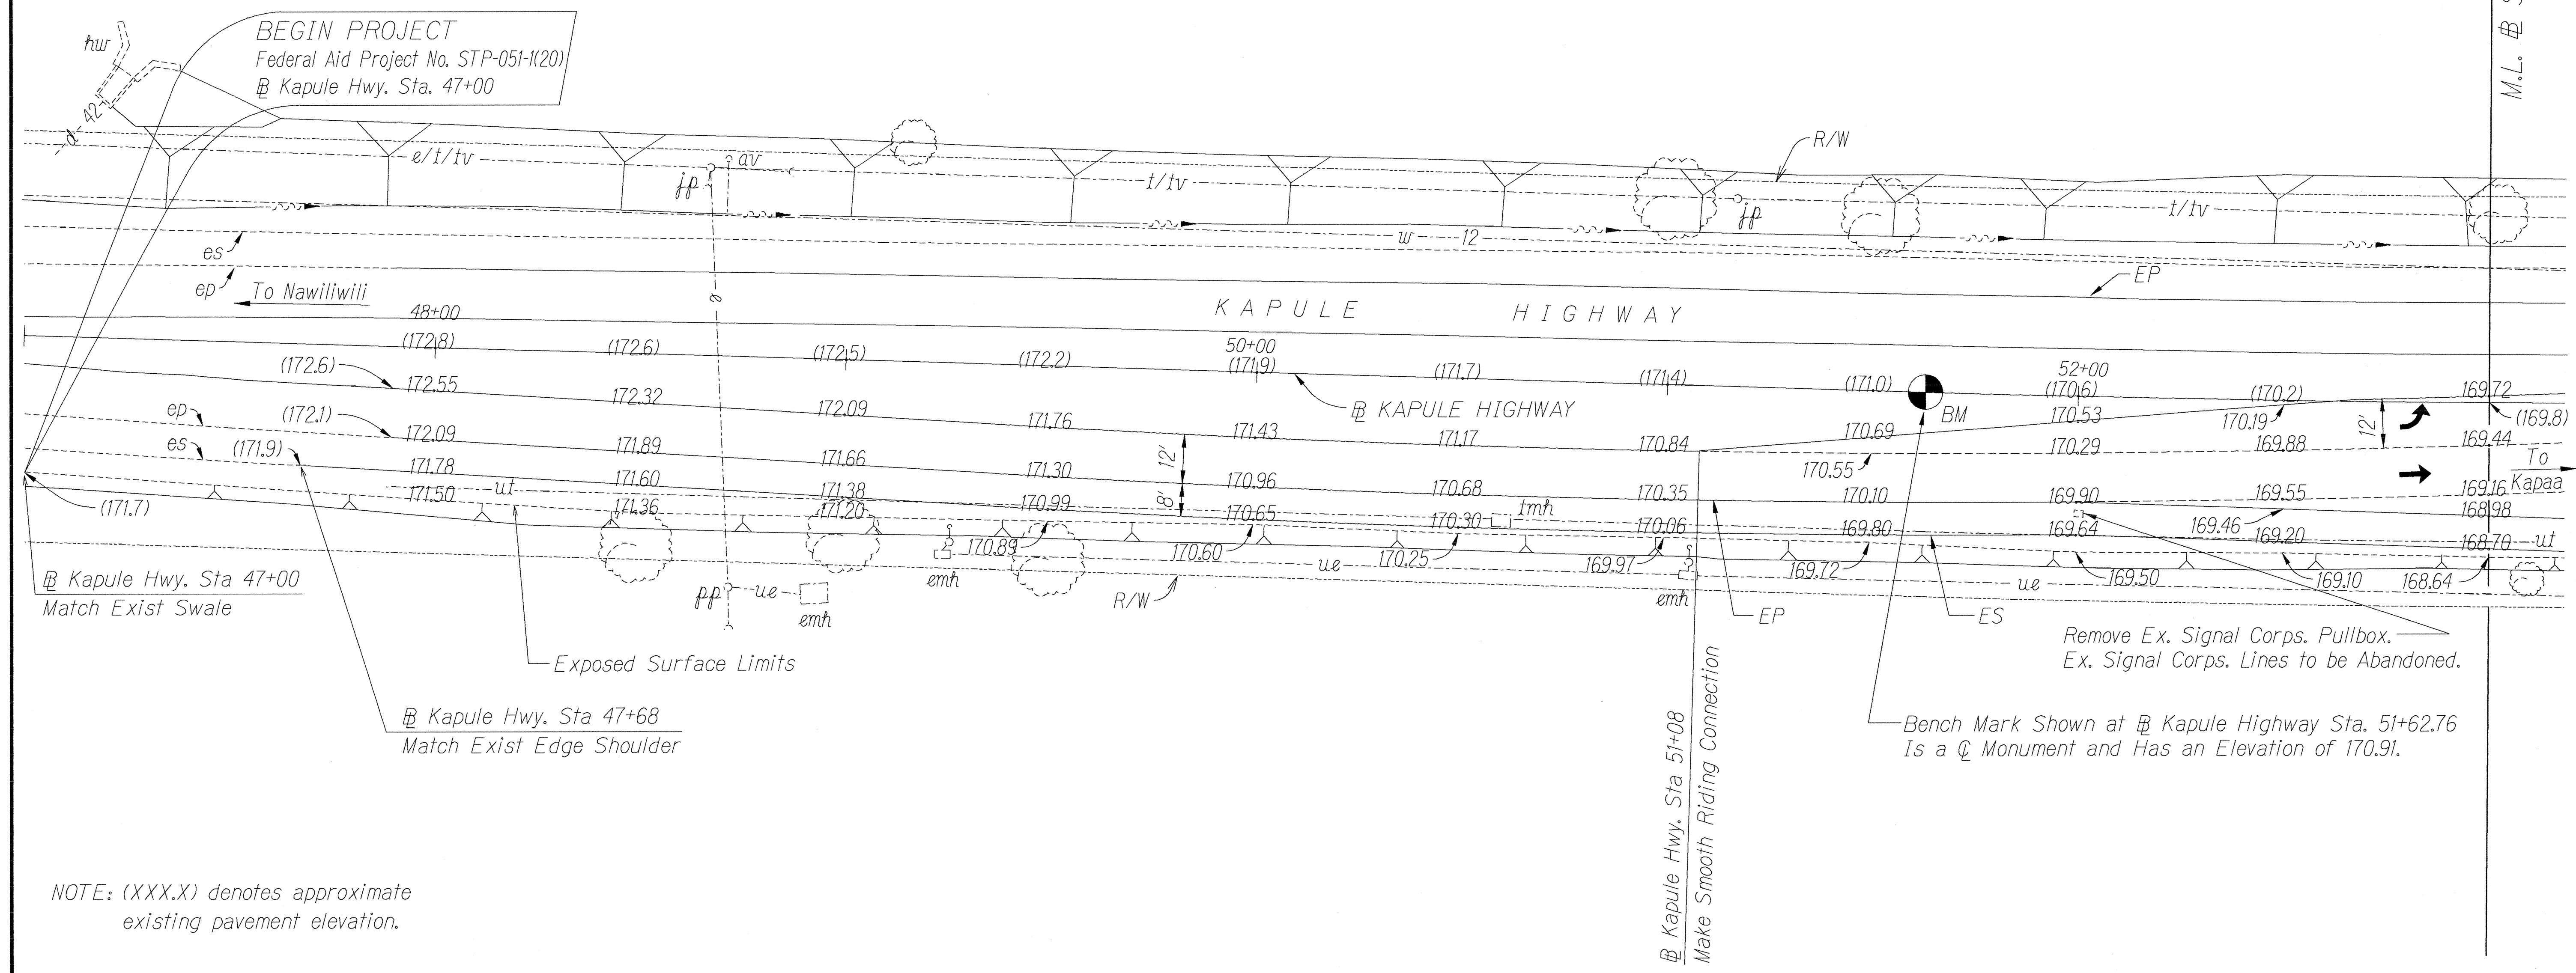

NOTE: (XXX.X) denotes approximate existing pavement elevation.

SURVEY PLOTTED BY	DATE
DRAWN BY	DATE
CHECKED BY	DATE
NOTED BY	DATE
ORIGINAL PLAN	
NOTE BOOK	
No.	

ROADWAY GRADES - KAPULE HWY. Sta. 47+00 to 53+00
Scale: 1" = 20'

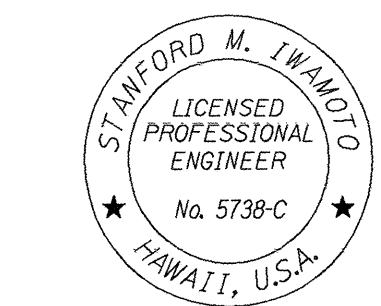

THIS WORK WAS PREPARED BY ME OR UNDER MY SUPERVISION

Signature

STATE OF HAWAII
DEPARTMENT OF TRANSPORTATION
HIGHWAYS DIVISION

ROADWAY GRADES

**KAPULE HIGHWAY,
INTERSECTION IMPROVEMENTS
AT AHUKINI ROAD**


Federal Aid Project No. STP-051-K(20)

Scale: 1" = 20' Date: July, 1999

SHEET No. 1 OF 2 SHEETS

FED. ROAD DIST. NO.	STATE	FED. AID PROJ. NO.	FISCAL YEAR	SHEET NO.	TOTAL SHEETS
HAWAII	HAW.	STP-051-1(20)	2000	C.O. 10	27

TRUE NORTH
SCALE : 1" = 20'

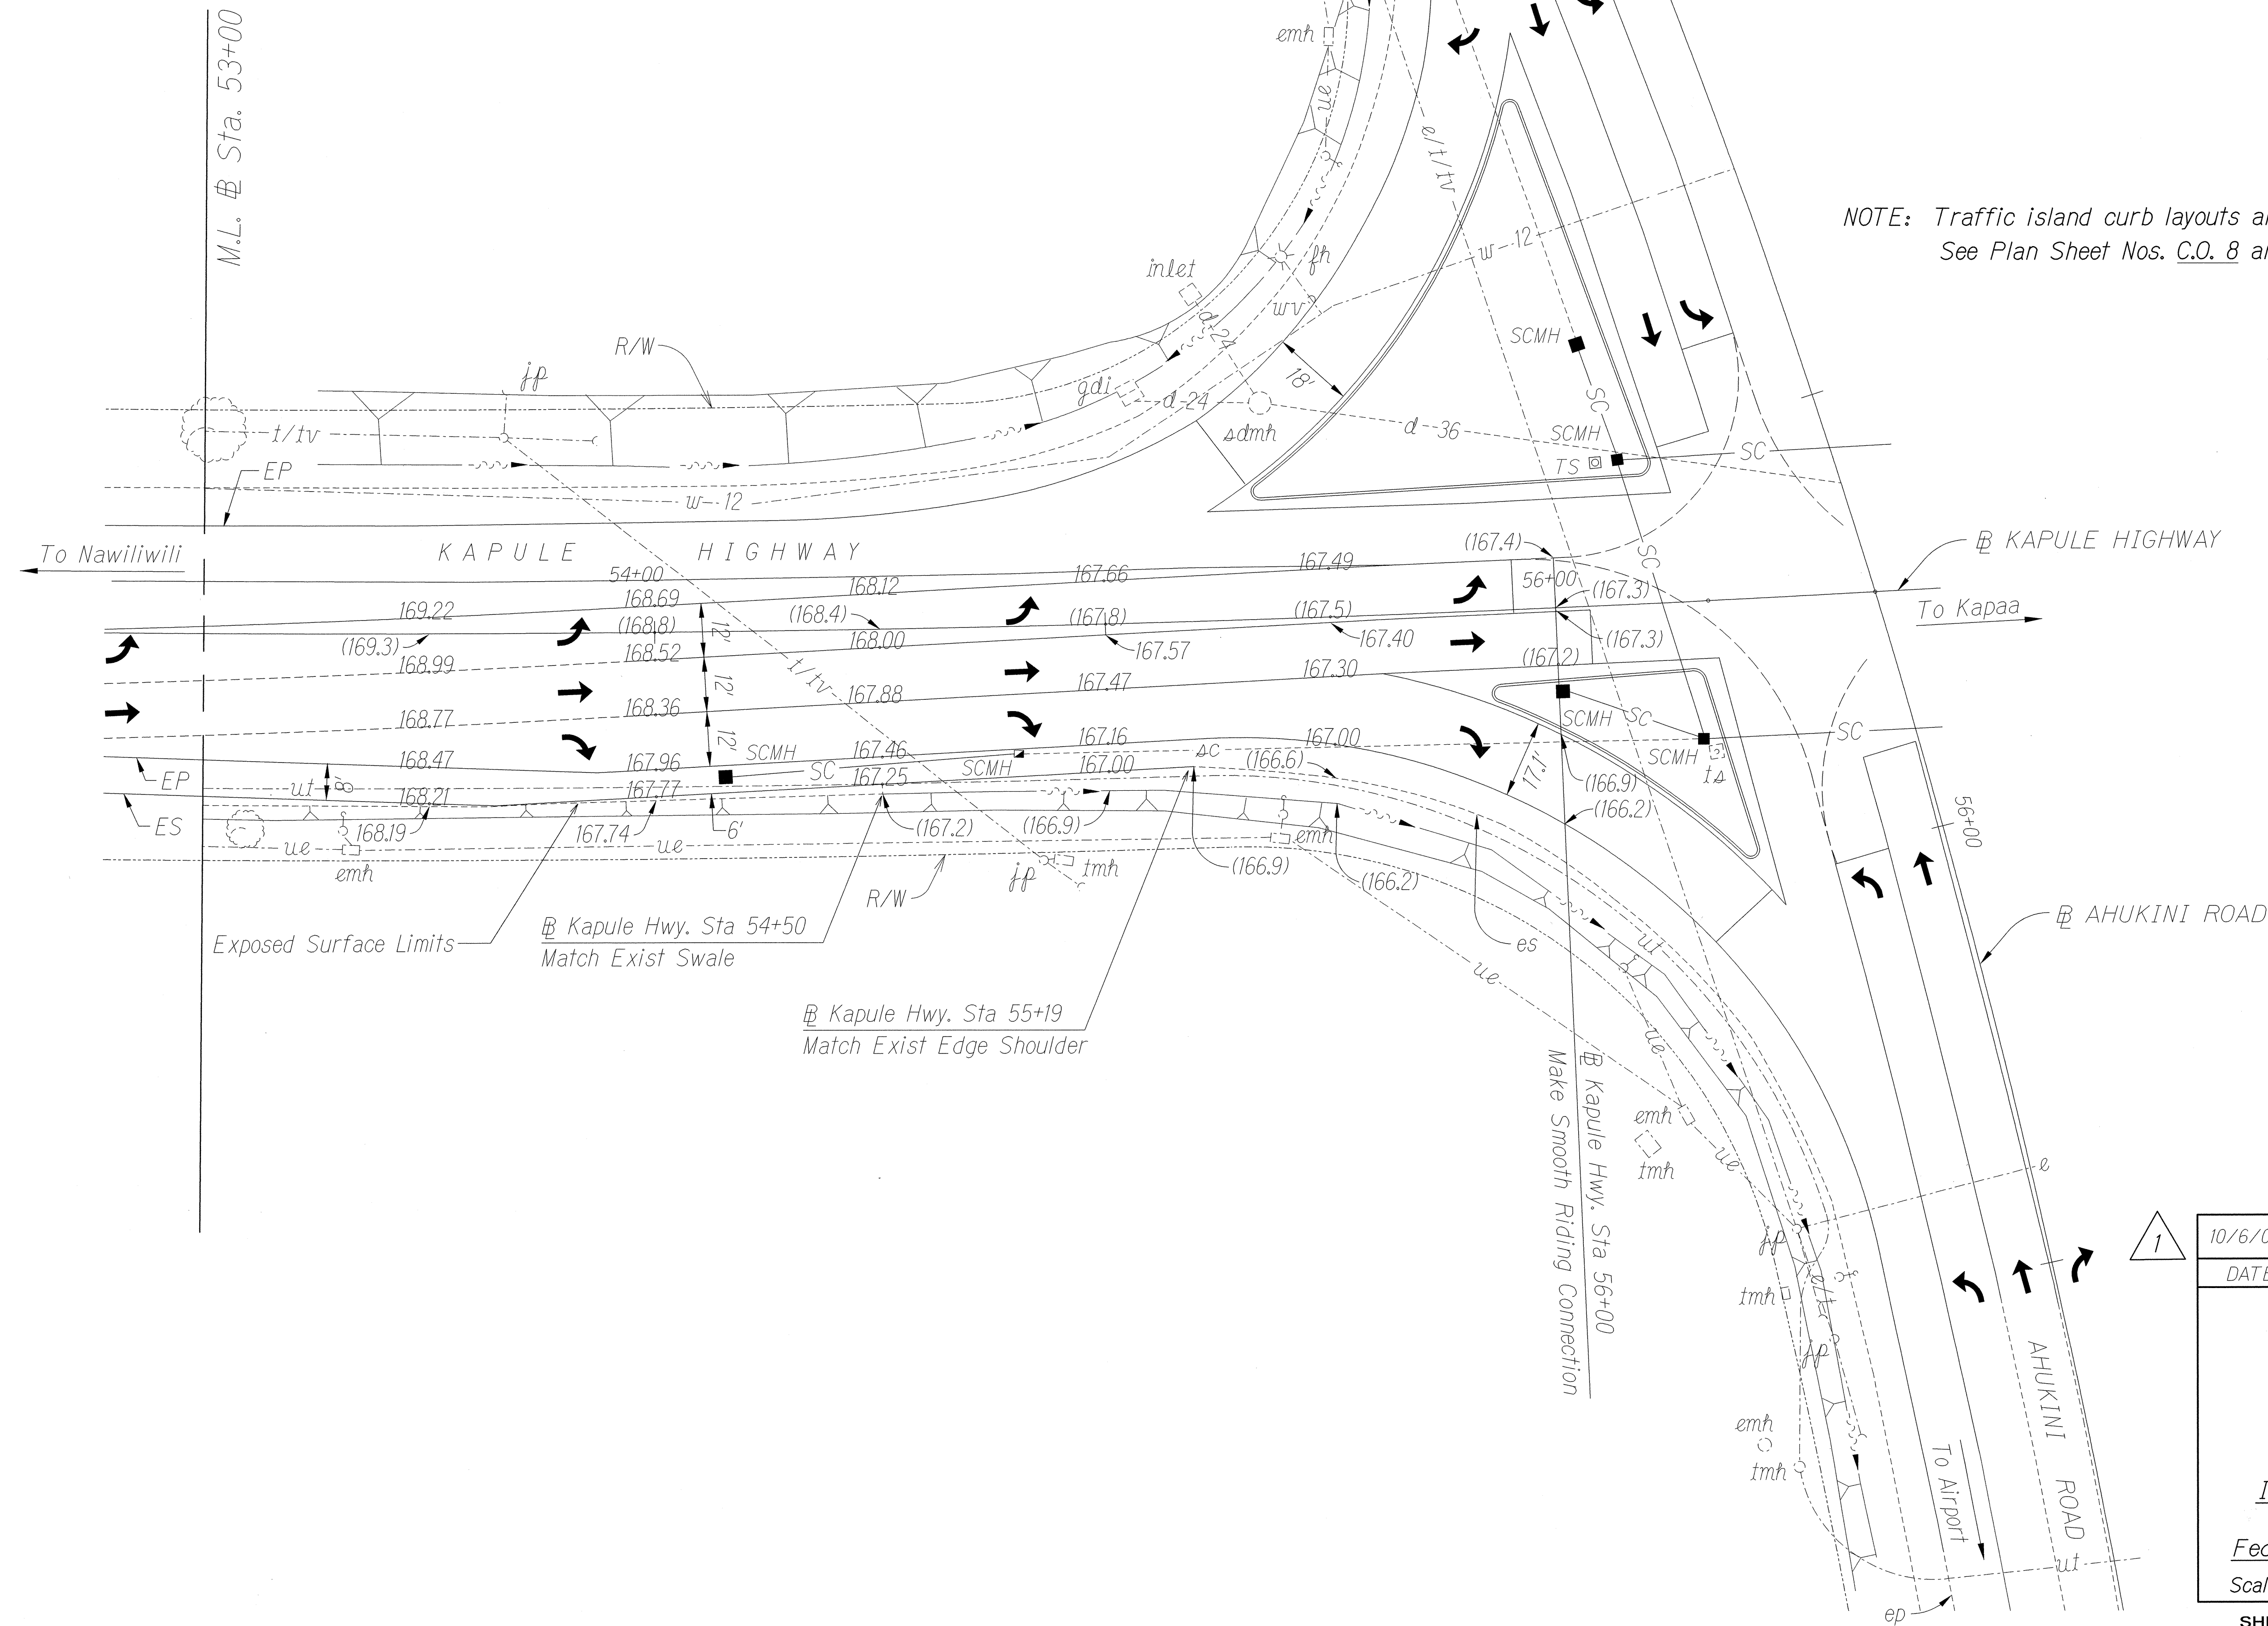

ORIGINAL PLAN	SURVEY PLOTTED BY	DATE
NOTE BOOK	DRAWN BY	DATE
CHECKED BY	DESIGNED BY	DATE
	QUANTITIES BY	DATE
	CHECKED BY	DATE