
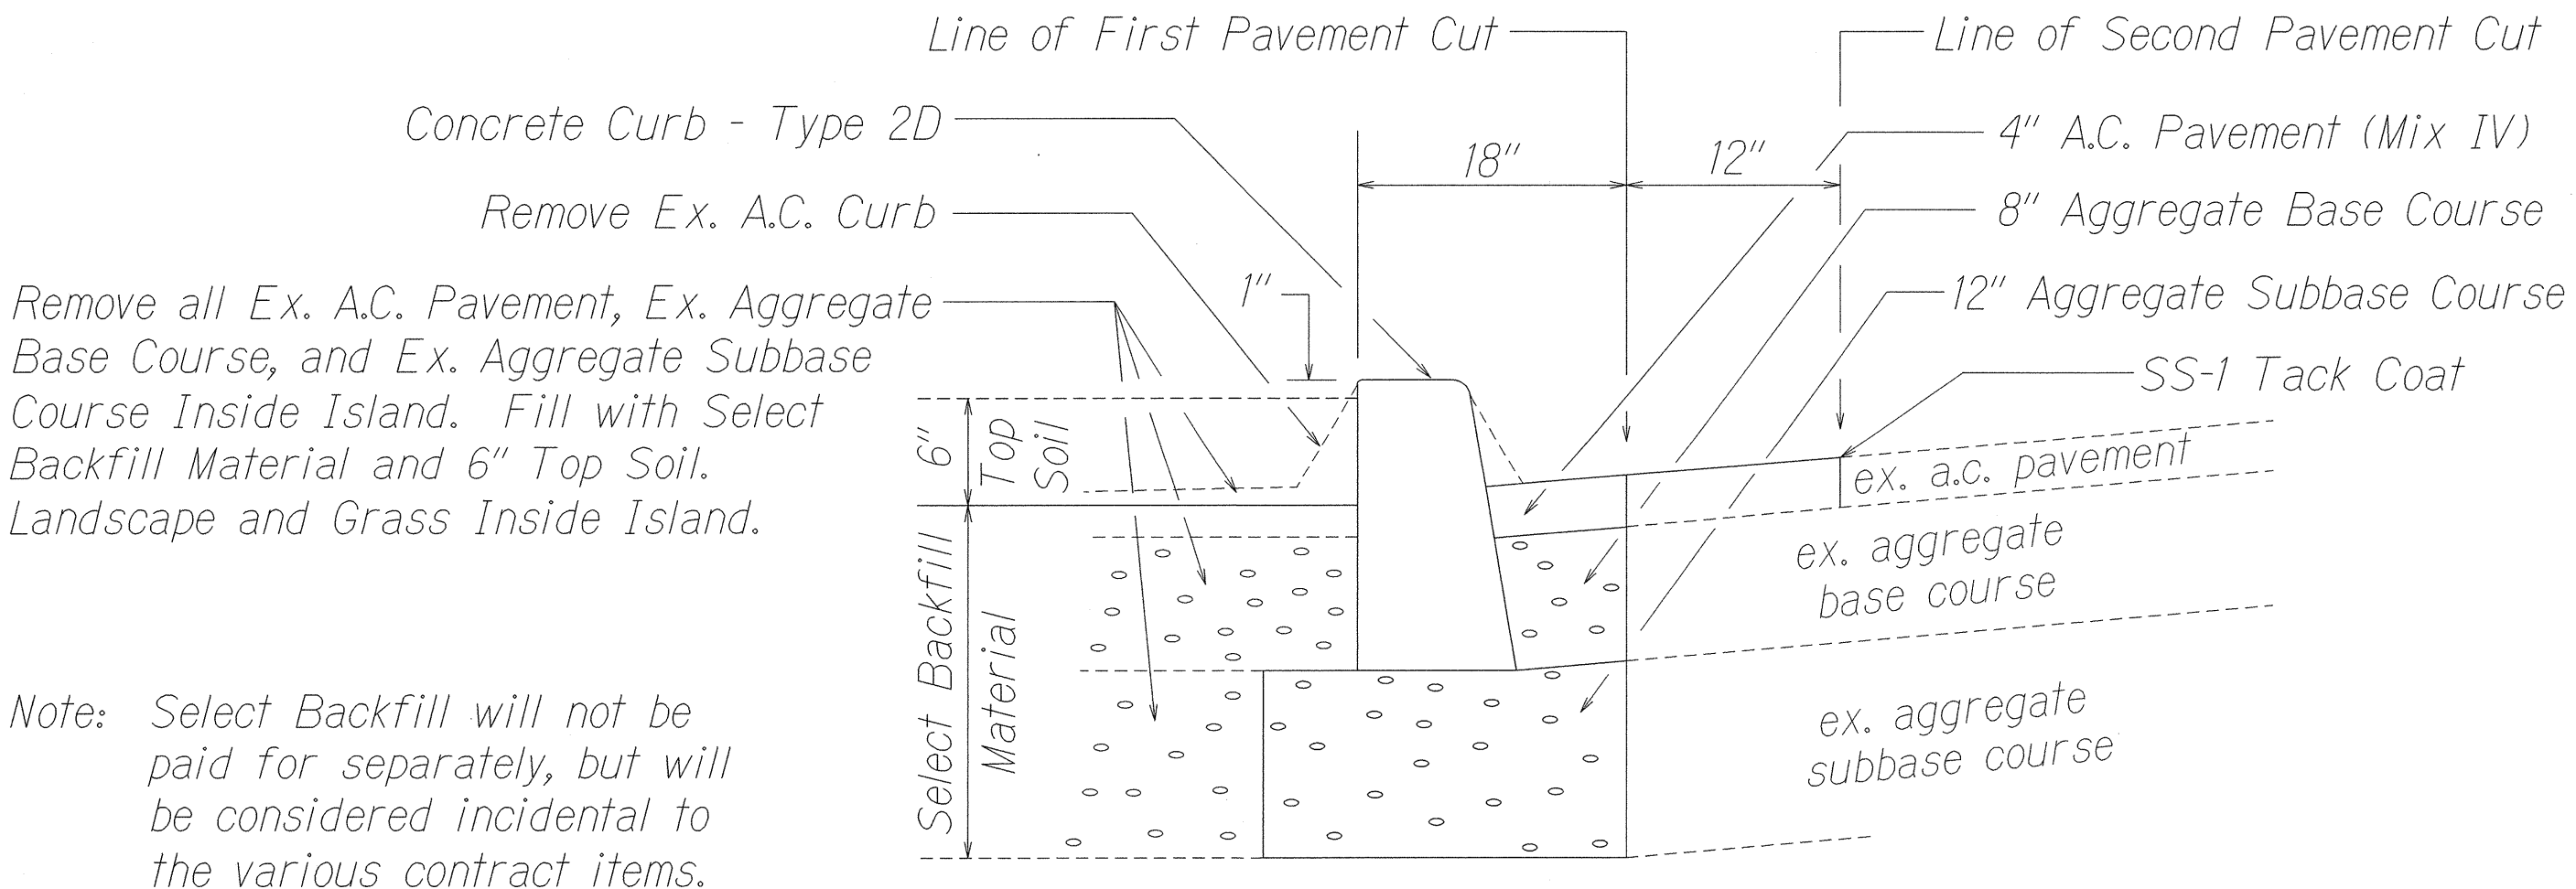


FED. ROAD DIST. NO.	STATE	FED. AID PROJ. NO.	FISCAL YEAR	SHEET NO.	TOTAL SHEETS
HAWAII	HAW.	STP-051-1(20)	2000		27

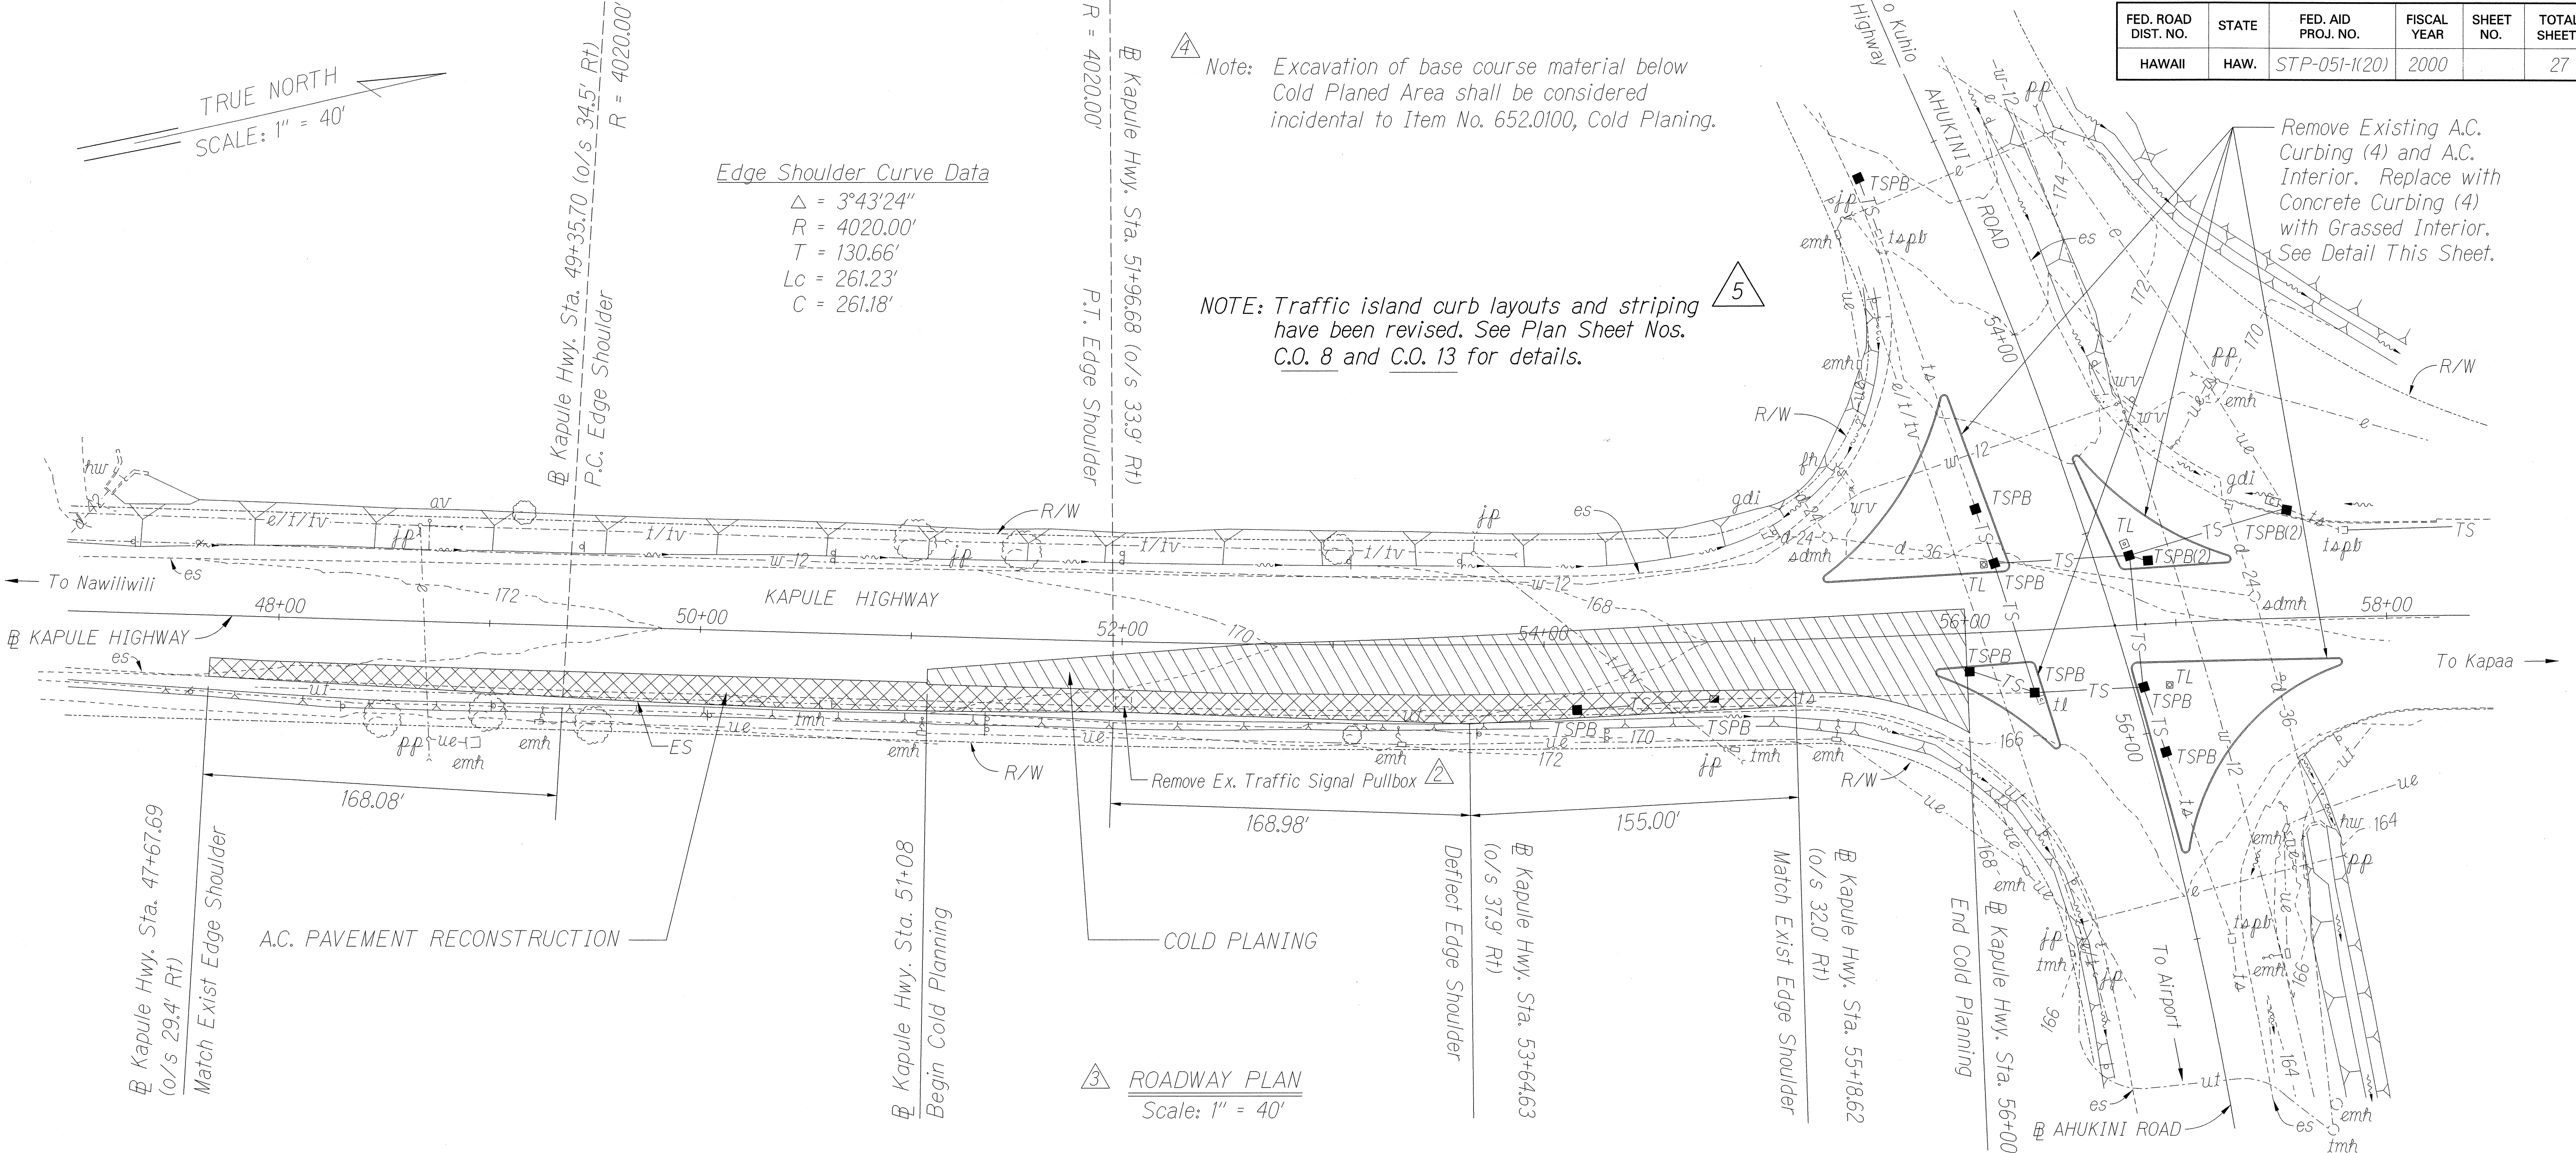


Note: Select Backfill will not be paid for separately, but will be considered incidental to the various contract items.

CONCRETE CURB DETAIL
N.T.S.

1	5-3-99	Revised Concrete Curb Detail.
2		Revised Callout.
3		Revised Traffic Signal Pullbox and Conduit Symbols.
4		Added Note.
		Removed Pavement Striping.

DATE	REVISION
10/6/00	Added Note, Revised Curb Island Layout and Revised Striping at Islands.

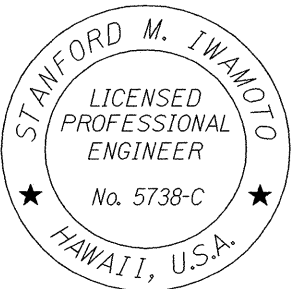

THIS WORK WAS PREPARED BY ME OR UNDER MY SUPERVISION

Signature

STATE OF HAWAII

DEPARTMENT OF TRANSPORTATION

HIGHWAYS DIVISION

ROADWAY PLAN

KAPULE HIGHWAY,

INTERSECTION IMPROVEMENTS

AT AHUKINI ROAD

Federal Aid Project No. STP-051-1(20)

Scale: 1" = 40'

Date: July, 1999

SHEET No. 1 OF 1 SHEETS

DATE	DATE	DATE	DATE	DATE	DATE
DESIGNED BY	DESIGNED BY	DESIGNED BY	DESIGNED BY	DESIGNED BY	DESIGNED BY
CHECKED BY	CHECKED BY	CHECKED BY	CHECKED BY	CHECKED BY	CHECKED BY
NOTED BY	NOTED BY	NOTED BY	NOTED BY	NOTED BY	NOTED BY
APPROVED BY	APPROVED BY	APPROVED BY	APPROVED BY	APPROVED BY	APPROVED BY