



FED. ROAD DIST. NO.	STATE	FED. AID PROJ. NO.	FISCAL YEAR	SHEET NO.	TOTAL SHEETS
HAWAII	HAW.	STP-051-1(20)	2000	ADD.17	27

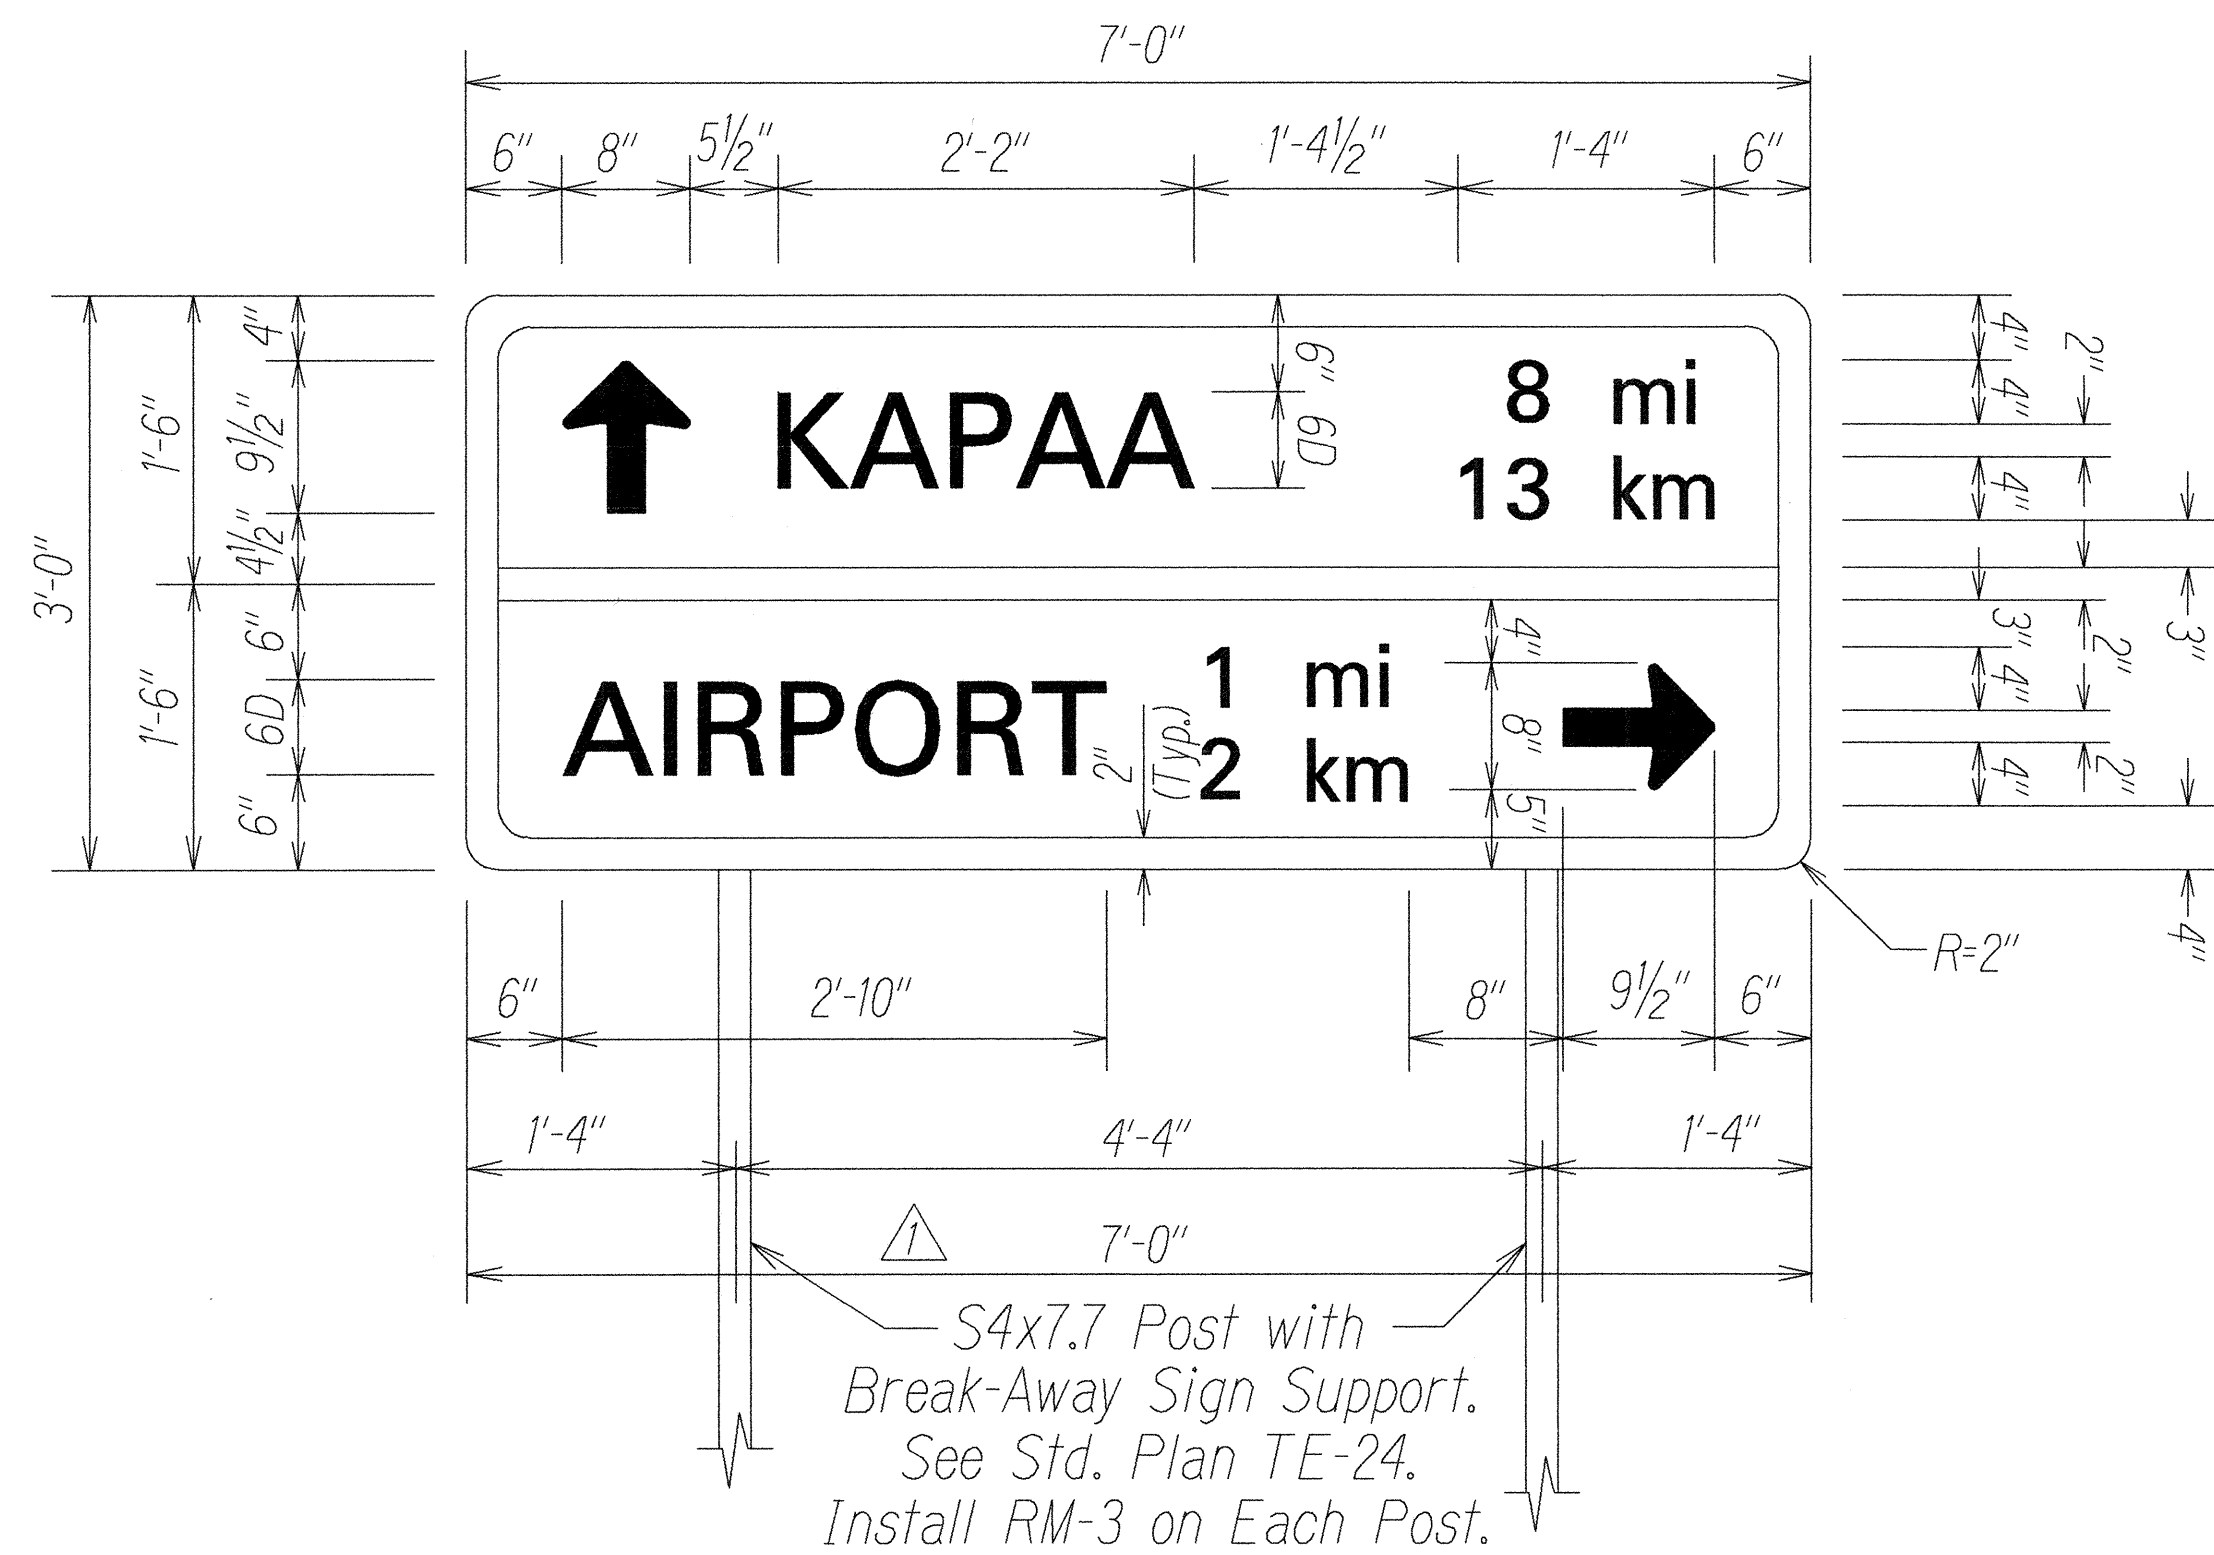


SIGN DETAIL D-1
Scale: 1" = 1'

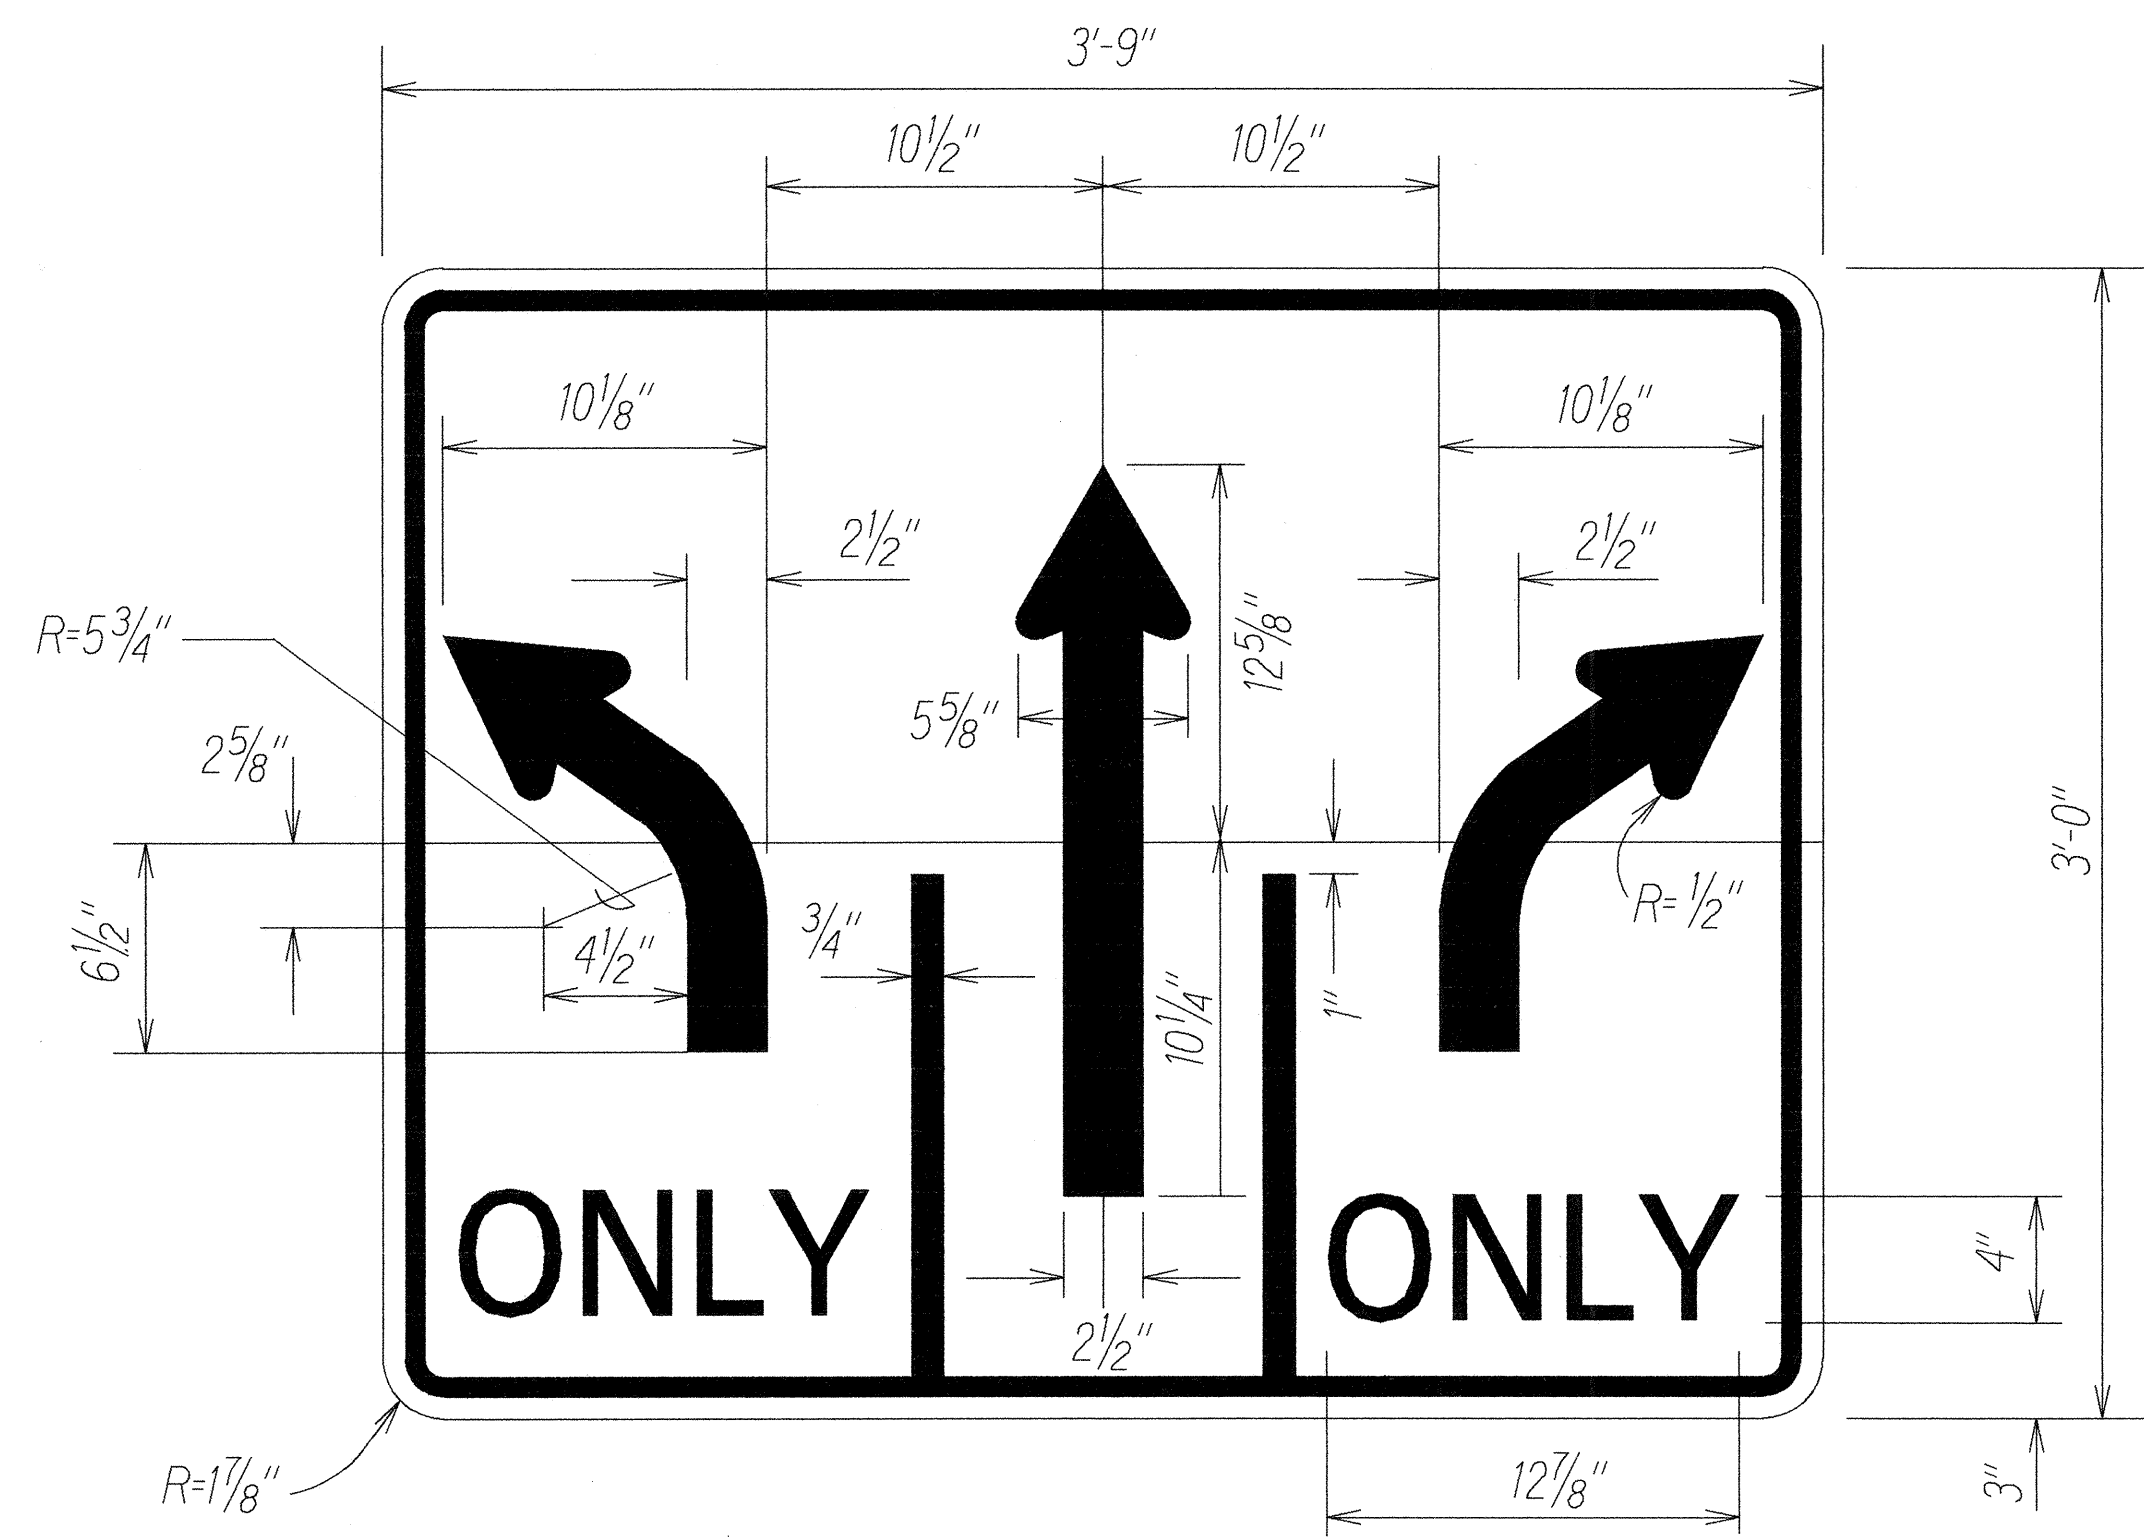

DETAIL R3-38 Modified Panel
Scale: 2" = 1'

DESTINATION SIGN LEGEND


Legend:	Color
Border	White
Lettering	White
Background	Green
Arrow	White

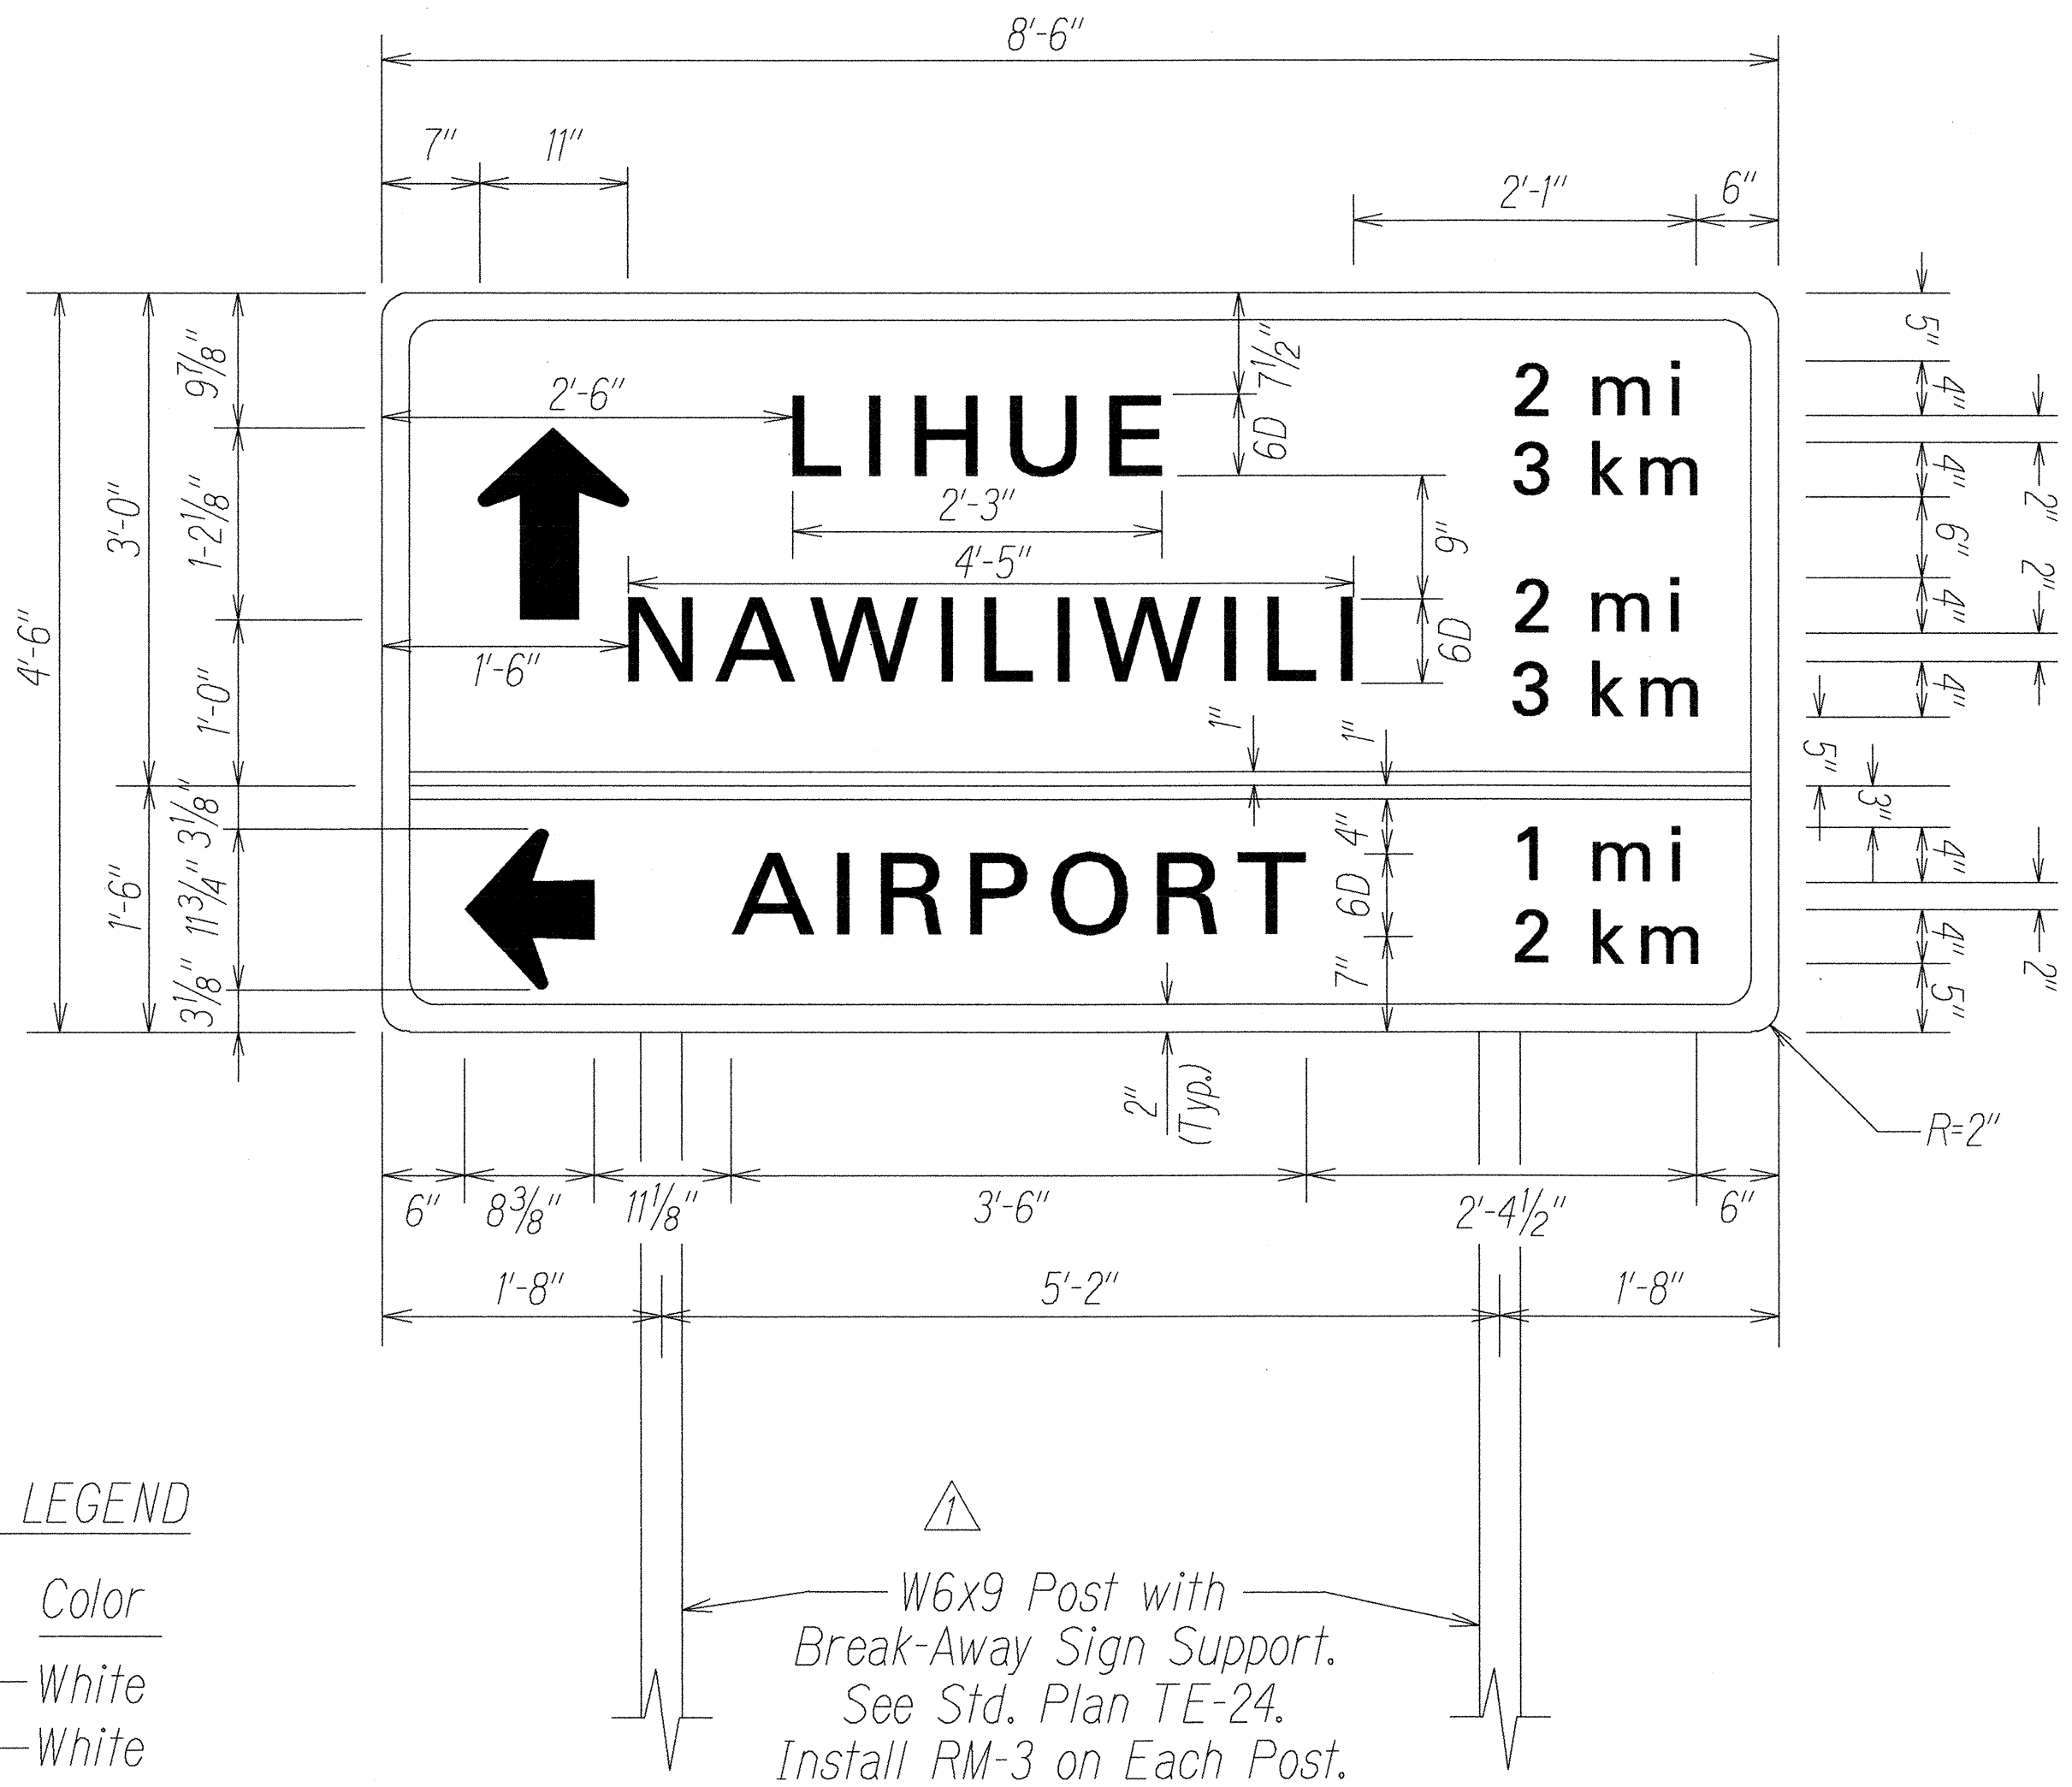

SIGN DETAIL D-2
Scale: 1" = 1'

SURVEY PLOTTED BY	DATE
DRAWN BY	DATE
CHECKED BY	DATE
DESIGNED BY	DATE
QUANTITIES BY	DATE
CHECKED BY	DATE
NOTE BOOK	DATE
NO.	

9-3-99	Revised Post Sizes.
DATE	REVISION
STATE OF HAWAII DEPARTMENT OF TRANSPORTATION HIGHWAYS DIVISION SIGN DETAILS KAPULE HIGHWAY, INTERSECTION IMPROVEMENTS AT AHUKINI ROAD Federal Aid Project No. STP-051-1(20) Scale: None Date: July, 1999	
SHEET No. 1	OF 1 SHEETS

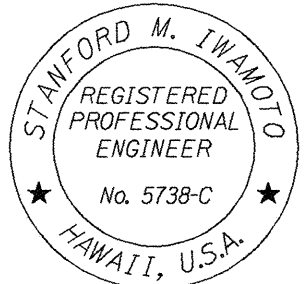

THIS WORK WAS PREPARED BY ME
OR UNDER MY SUPERVISION
[Signature]
Signature