

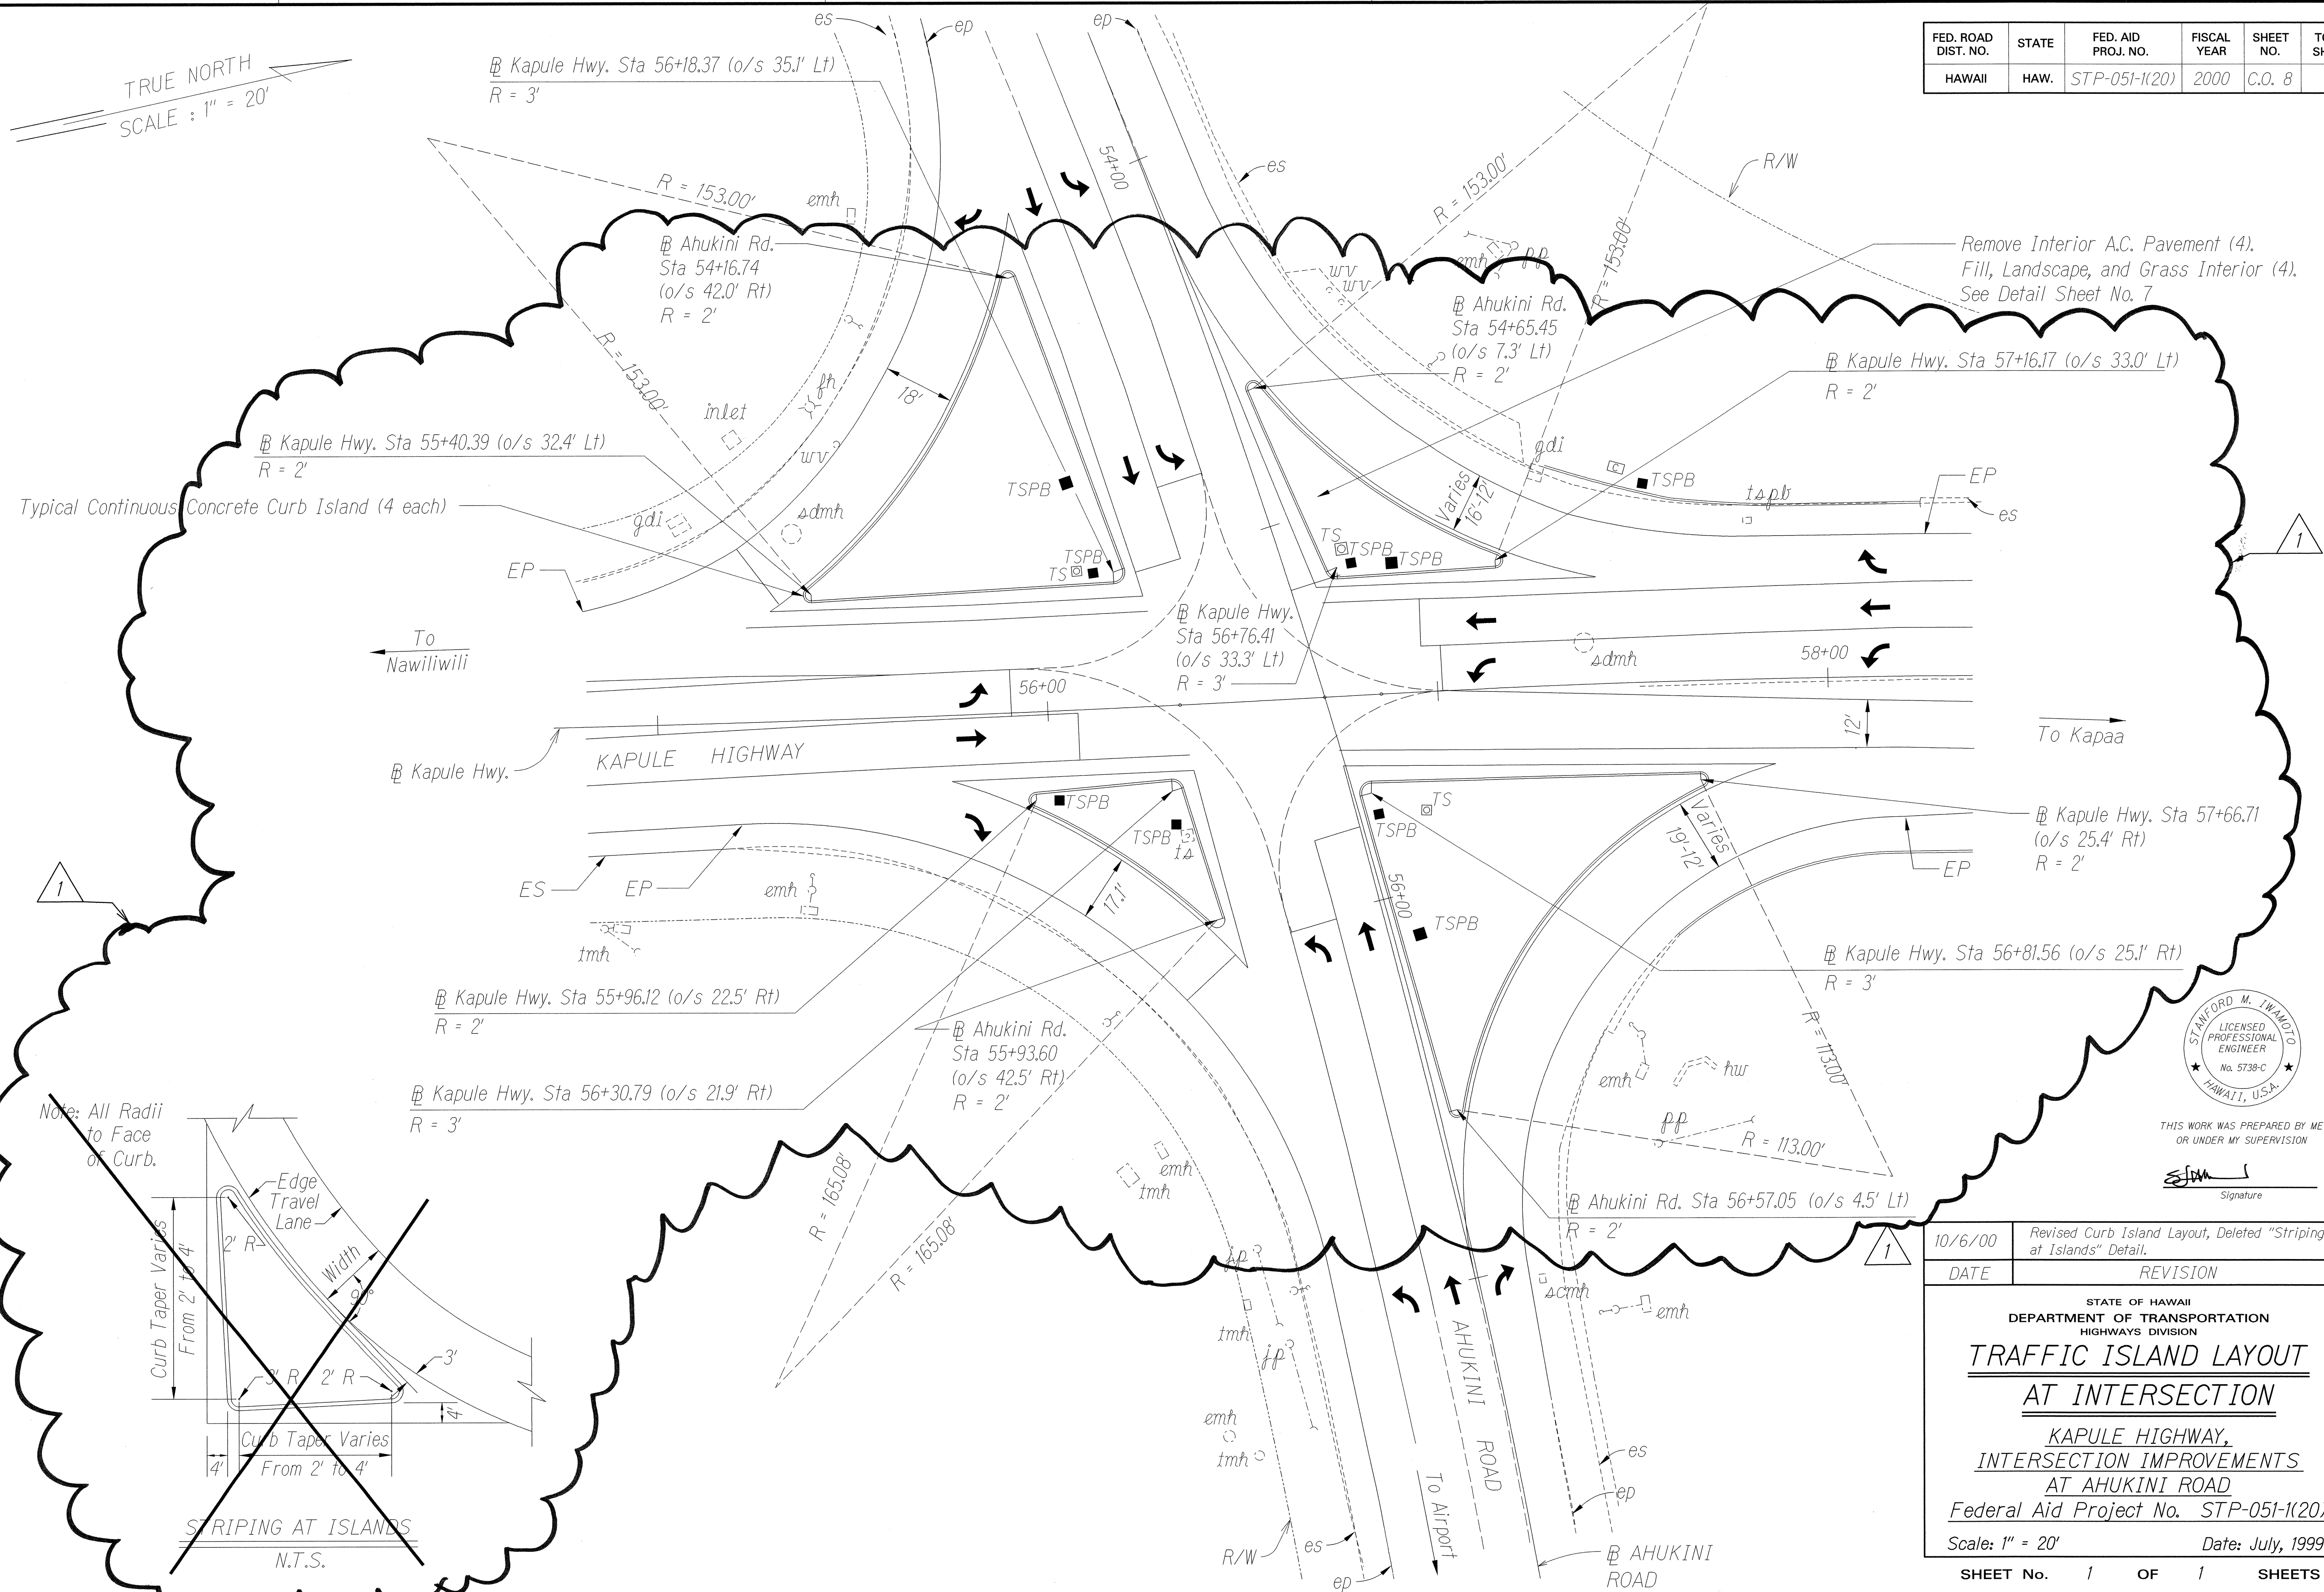


FED. ROAD DIST. NO.	STATE	FED. AID PROJ. NO.	FISCAL YEAR	SHEET NO.	TOTAL SHEETS
HAWAII	HAW.	STP-051-K(20)	2000	C.O. 8	27

TRUE NORTH
SCALE : 1" = 20'

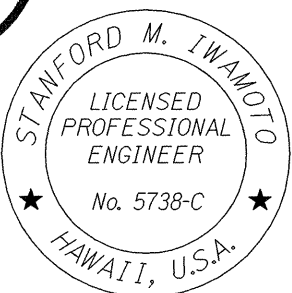

Note: All Radii to Face of Curb.

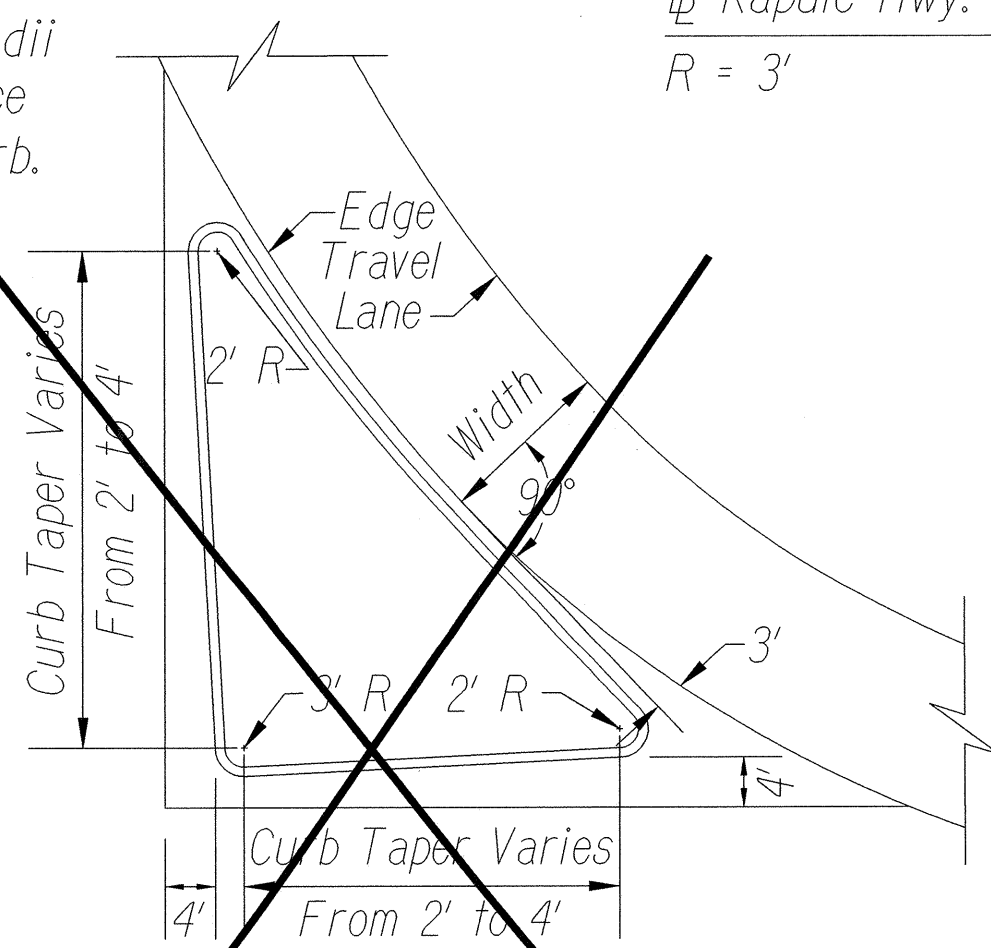

THIS WORK WAS PREPARED BY ME OR UNDER MY SUPERVISION

Signature

10/6/00	Revised Curb Island Layout, Deleted "Striping at Islands" Detail.
DATE	REVISION

STATE OF HAWAII

DEPARTMENT OF TRANSPORTATION

HIGHWAYS DIVISION

TRAFFIC ISLAND LAYOUT

AT INTERSECTION

KAPULE HIGHWAY,

INTERSECTION IMPROVEMENTS

AT AHUKINI ROAD

Federal Aid Project No. STP-051-K(20)

Scale: 1" = 20'

Date: July, 1999

SHEET No. 1 OF 1 SHEETS

C.O. 8