


INDEX TO DRAWINGS	
SHEET NO.	DESCRIPTION
1	TITLE SHEET
2	STANDARD PLANS SUMMARY
3	GENERAL NOTES & LEGEND
4	PAVEMENT RECONSTRUCTION & JOINT SEALING DETAILS
5	BRIDGE RAILING DETAILS
6	PORTABLE PHYSICAL BARRIER
7	THRIE BEAM CONNECTIONS
8 ①	GUARDRAIL DETAILS & NOTES
9	STRONG POST W-BEAM GUARDRAIL
10	STRONG POST RUBRAIL (W-BEAM) GUARDRAIL
11	STRONG POST MODIFIED THRIE BEAM GUARDRAIL
12 - 14	TYPE "A" FLARE
15	PLAN - HANAMAULU VIADUCT
16	PAVEMENT MARKING LEGEND, DETAILS & NOTES
17 - 20	PAVEMENT MARKING, STRIPING & TRAFFIC SIGNING PLAN
21	TRAFFIC SUMMARIES
22	PAVEMENT MARKING SUMMARY
23	SIGN DETAILS

SHEET NO. ① 8 9-1 IS A SUPPLEMENTAL SHEET TO THIS PROJECT. TOTAL SHEET COUNT AFTER "AS-BUILT" POSTING IS 24 SHEETS.


DESIGNED BY
HWY-K
S. MORIKAWA
P. S. & E. BY
12-15-99
DATE
274-3118
PHONE

STATE OF HAWAII
DEPARTMENT OF TRANSPORTATION
HIGHWAYS DIVISION
HONOLULU, HAWAII
"AS-BUILT"
PLANS FOR
KAPULE HIGHWAY,
MISCELLANEOUS IMPROVEMENTS
VICINITY OF AHUKINI ROAD TO KUHIO HIGHWAY
PROJECT NO. 51B-01-00M
DISTRICT OF LIHUE
ISLAND OF KAUAI

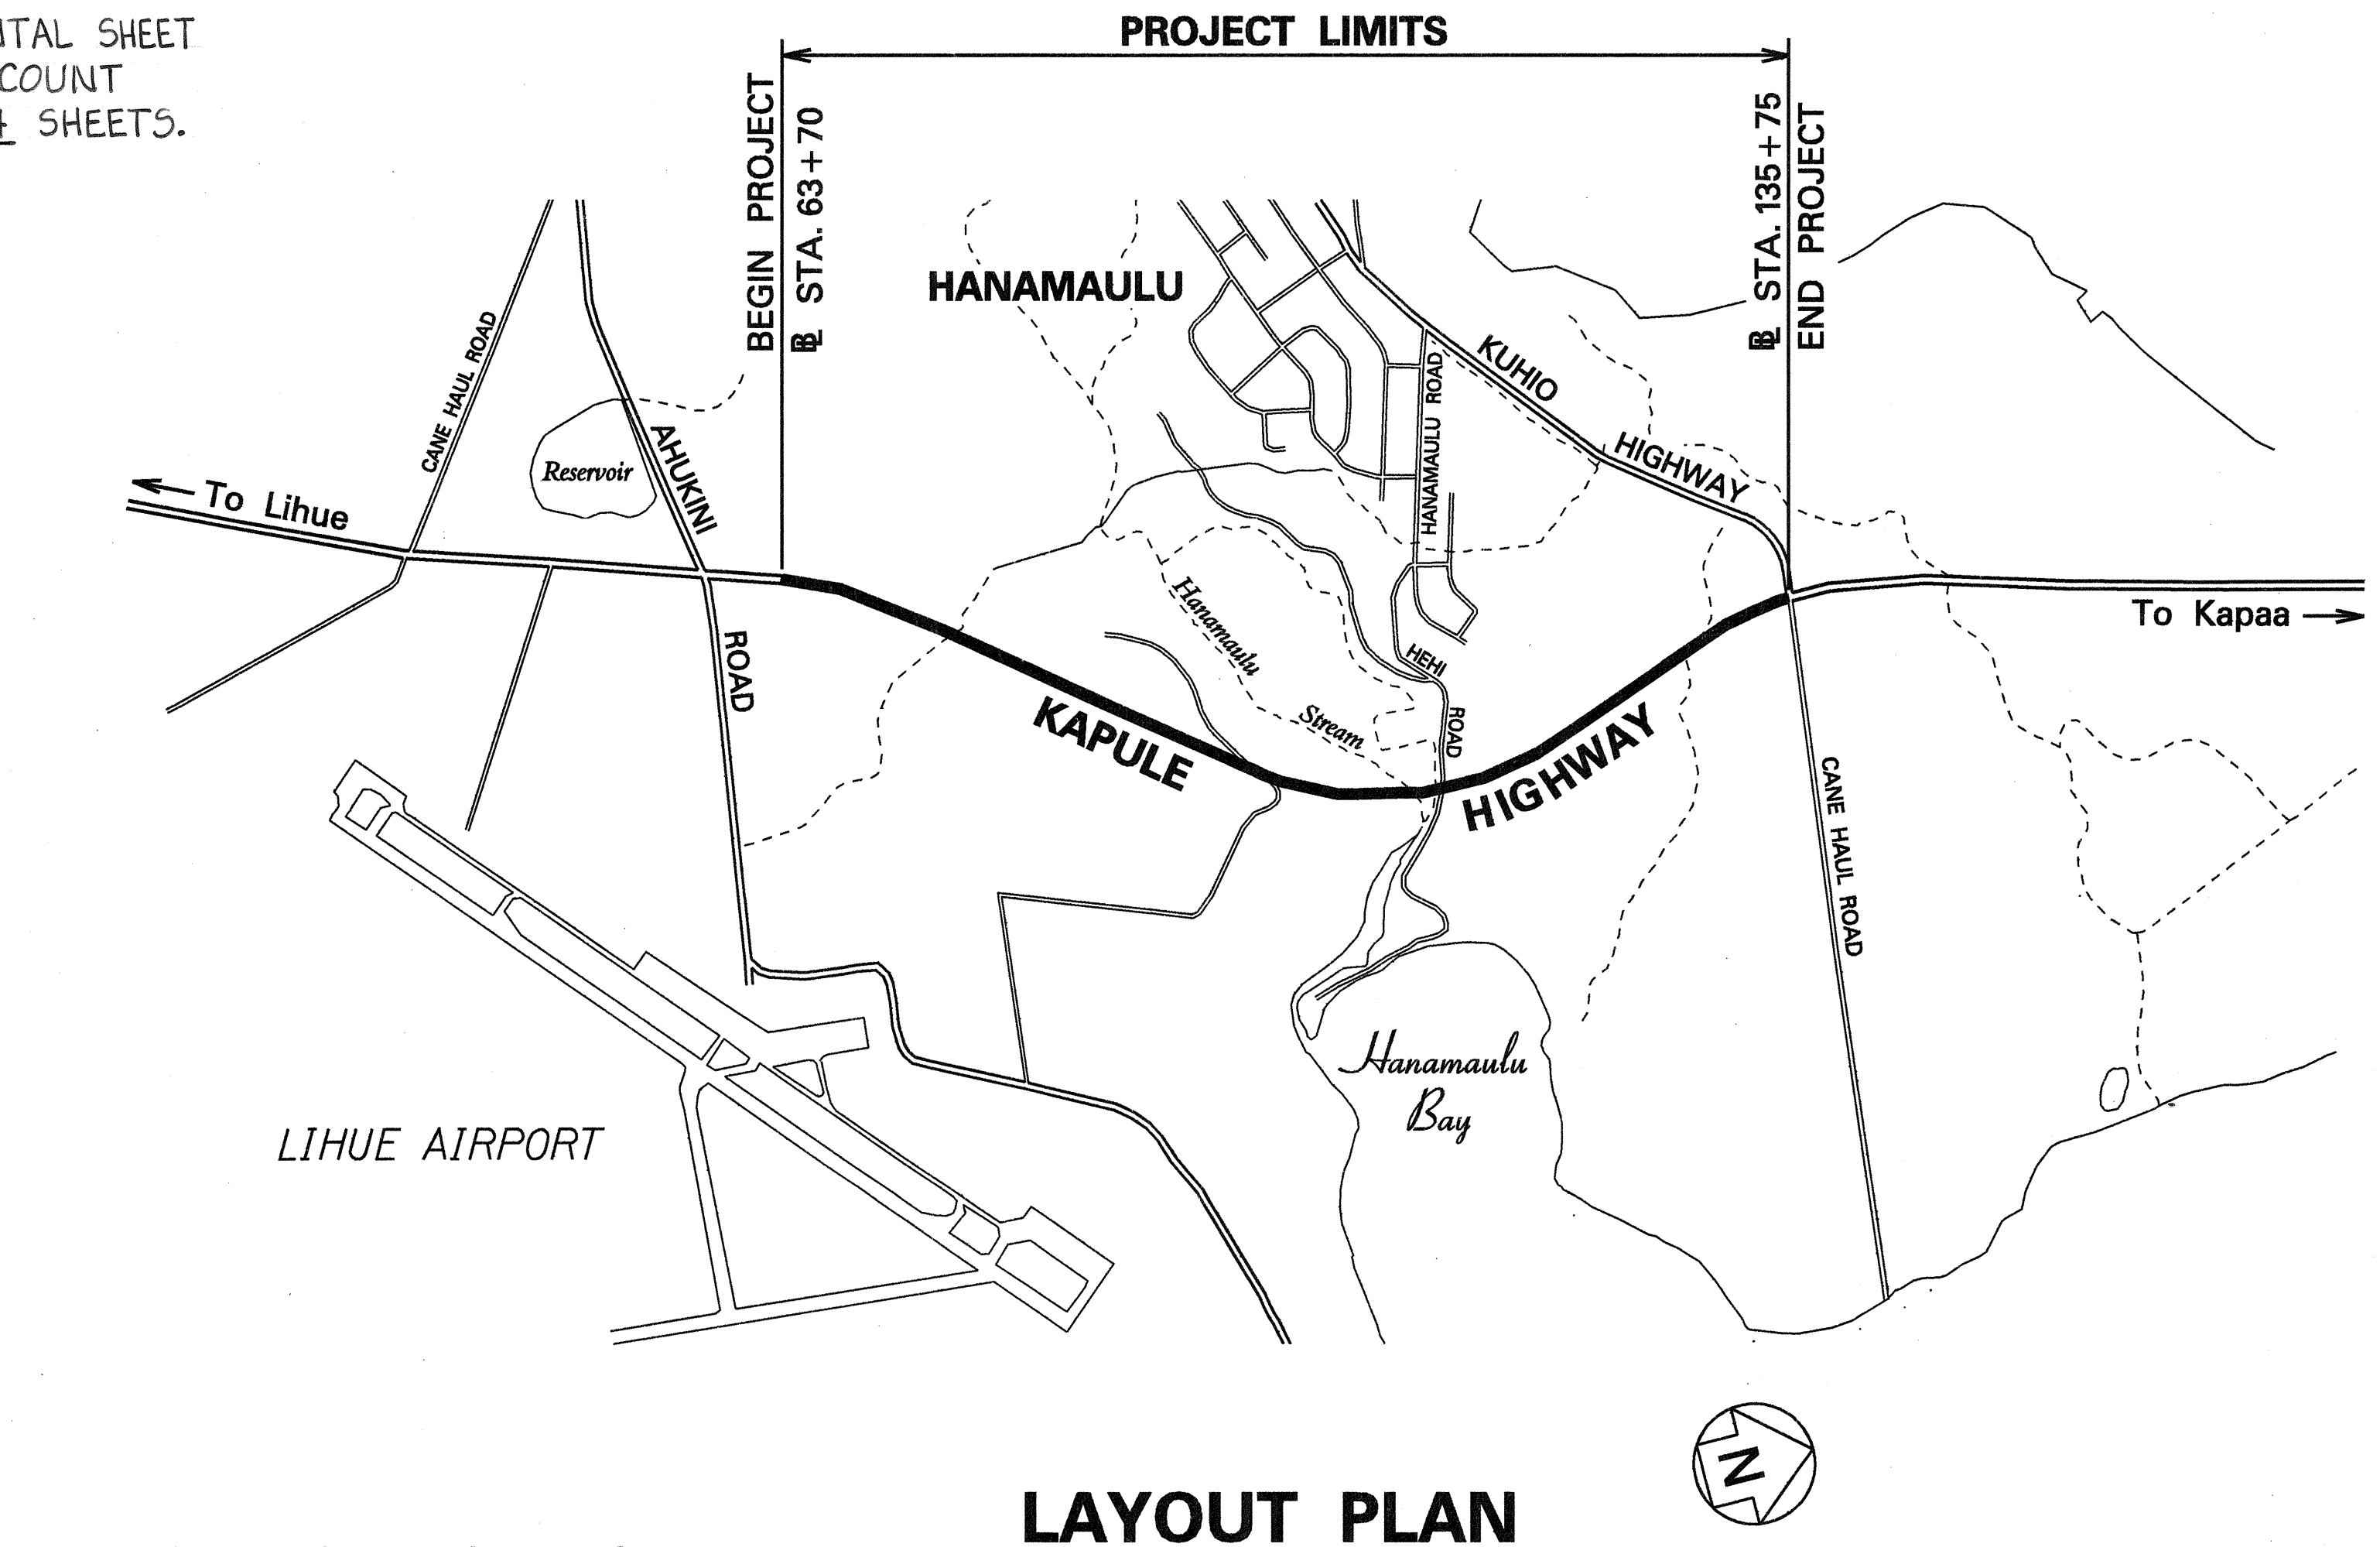


LAYOUT PLAN
GROSS LENGTH OF PROJECT.....1.36 MILES
NET LENGTH OF PROJECT.....1.36 MILES

FED. ROAD DIST. NO.	STATE	PROJ. NO.	FISCAL YEAR	SHEET NO.	TOTAL SHEETS
HAWAII	HAW.	51B-01-00M	2000	1	23

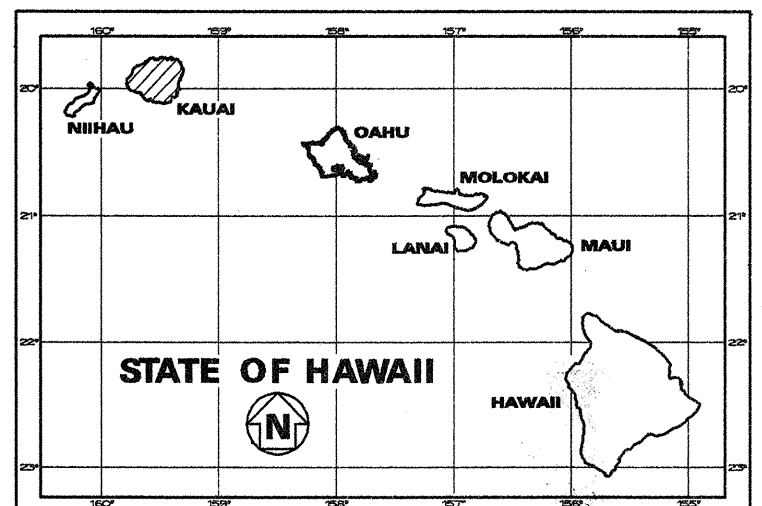

PROJECT LOCATION

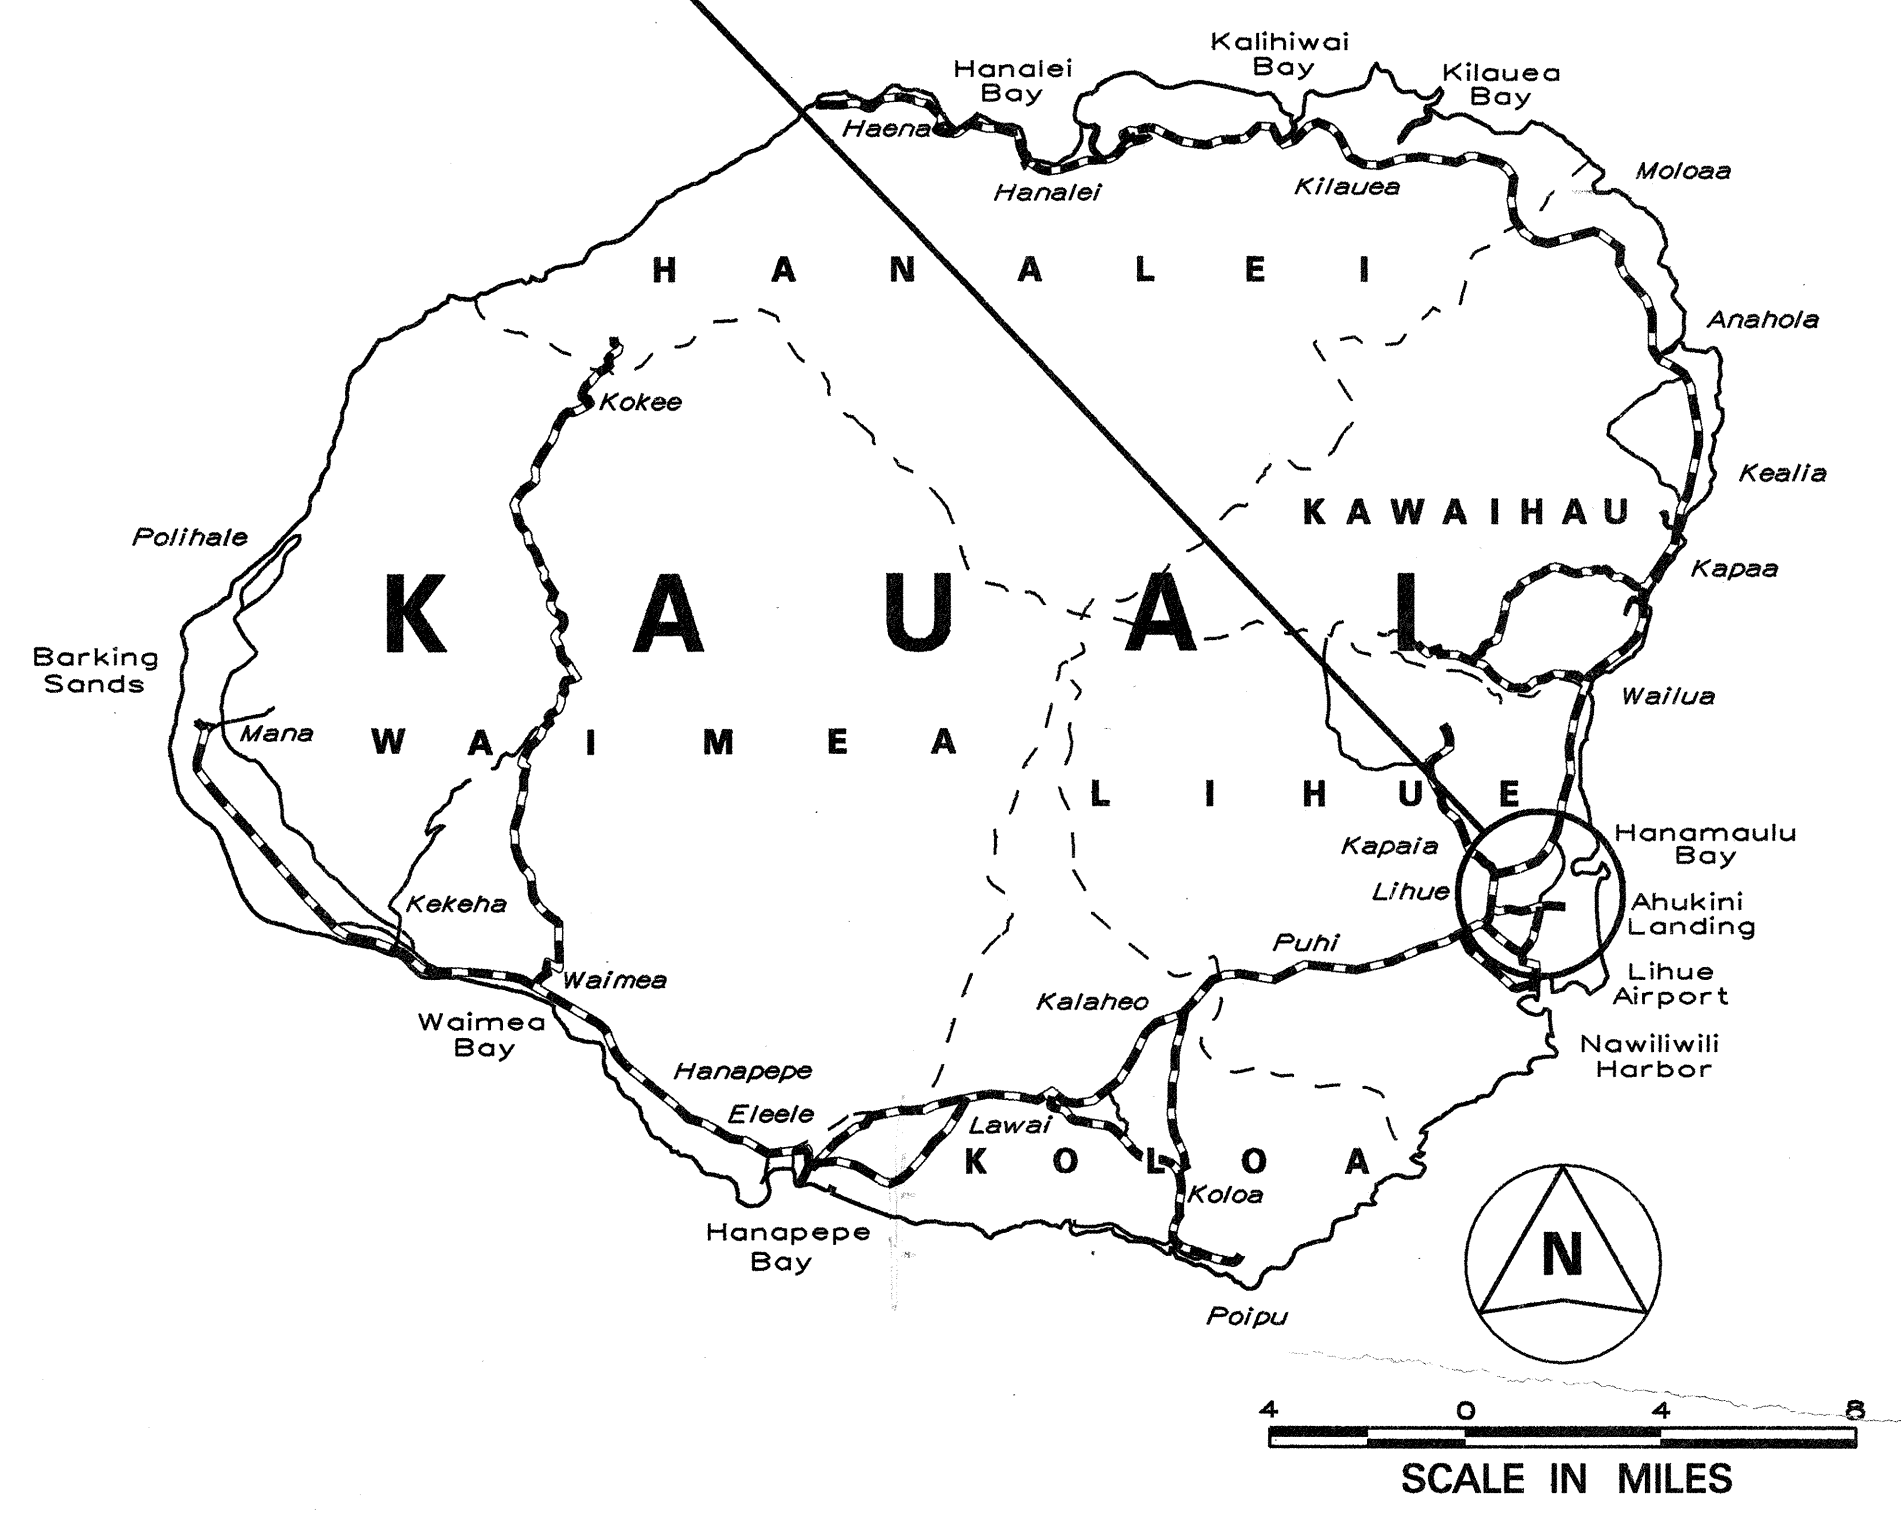

FEDERAL AID PROJECTS PREVIOUSLY CONSTRUCTED OR UNDER CONSTRUCTION
MILE POST 2.11 TO MILE POST 3.47

CHANGES MADE DURING CONSTRUCTION HAVE BEEN INCORPORATED ON THESE PLANS EXCEPT CHANGES IN THE ORIGINAL THEORETICAL QUANTITIES. FOR ACTUAL QUANTITIES, REFER TO PROJECT LEDGER AND/OR COMPUTATION BOOK.
RESIDENT ENGINEER
DATE 8.26.04

DEPARTMENT OF TRANSPORTATION
STATE OF HAWAII
APPROVED:
DIR. OF TRANSPORTATION
DATE 4/10/00