



FED. ROAD DIST. NO.	STATE	FED. AID PROJ. NO.	FISCAL YEAR	SHEET NO.	TOTAL SHEETS
HAWAII	HAW.	NH-051-1(10)	2001	22	34

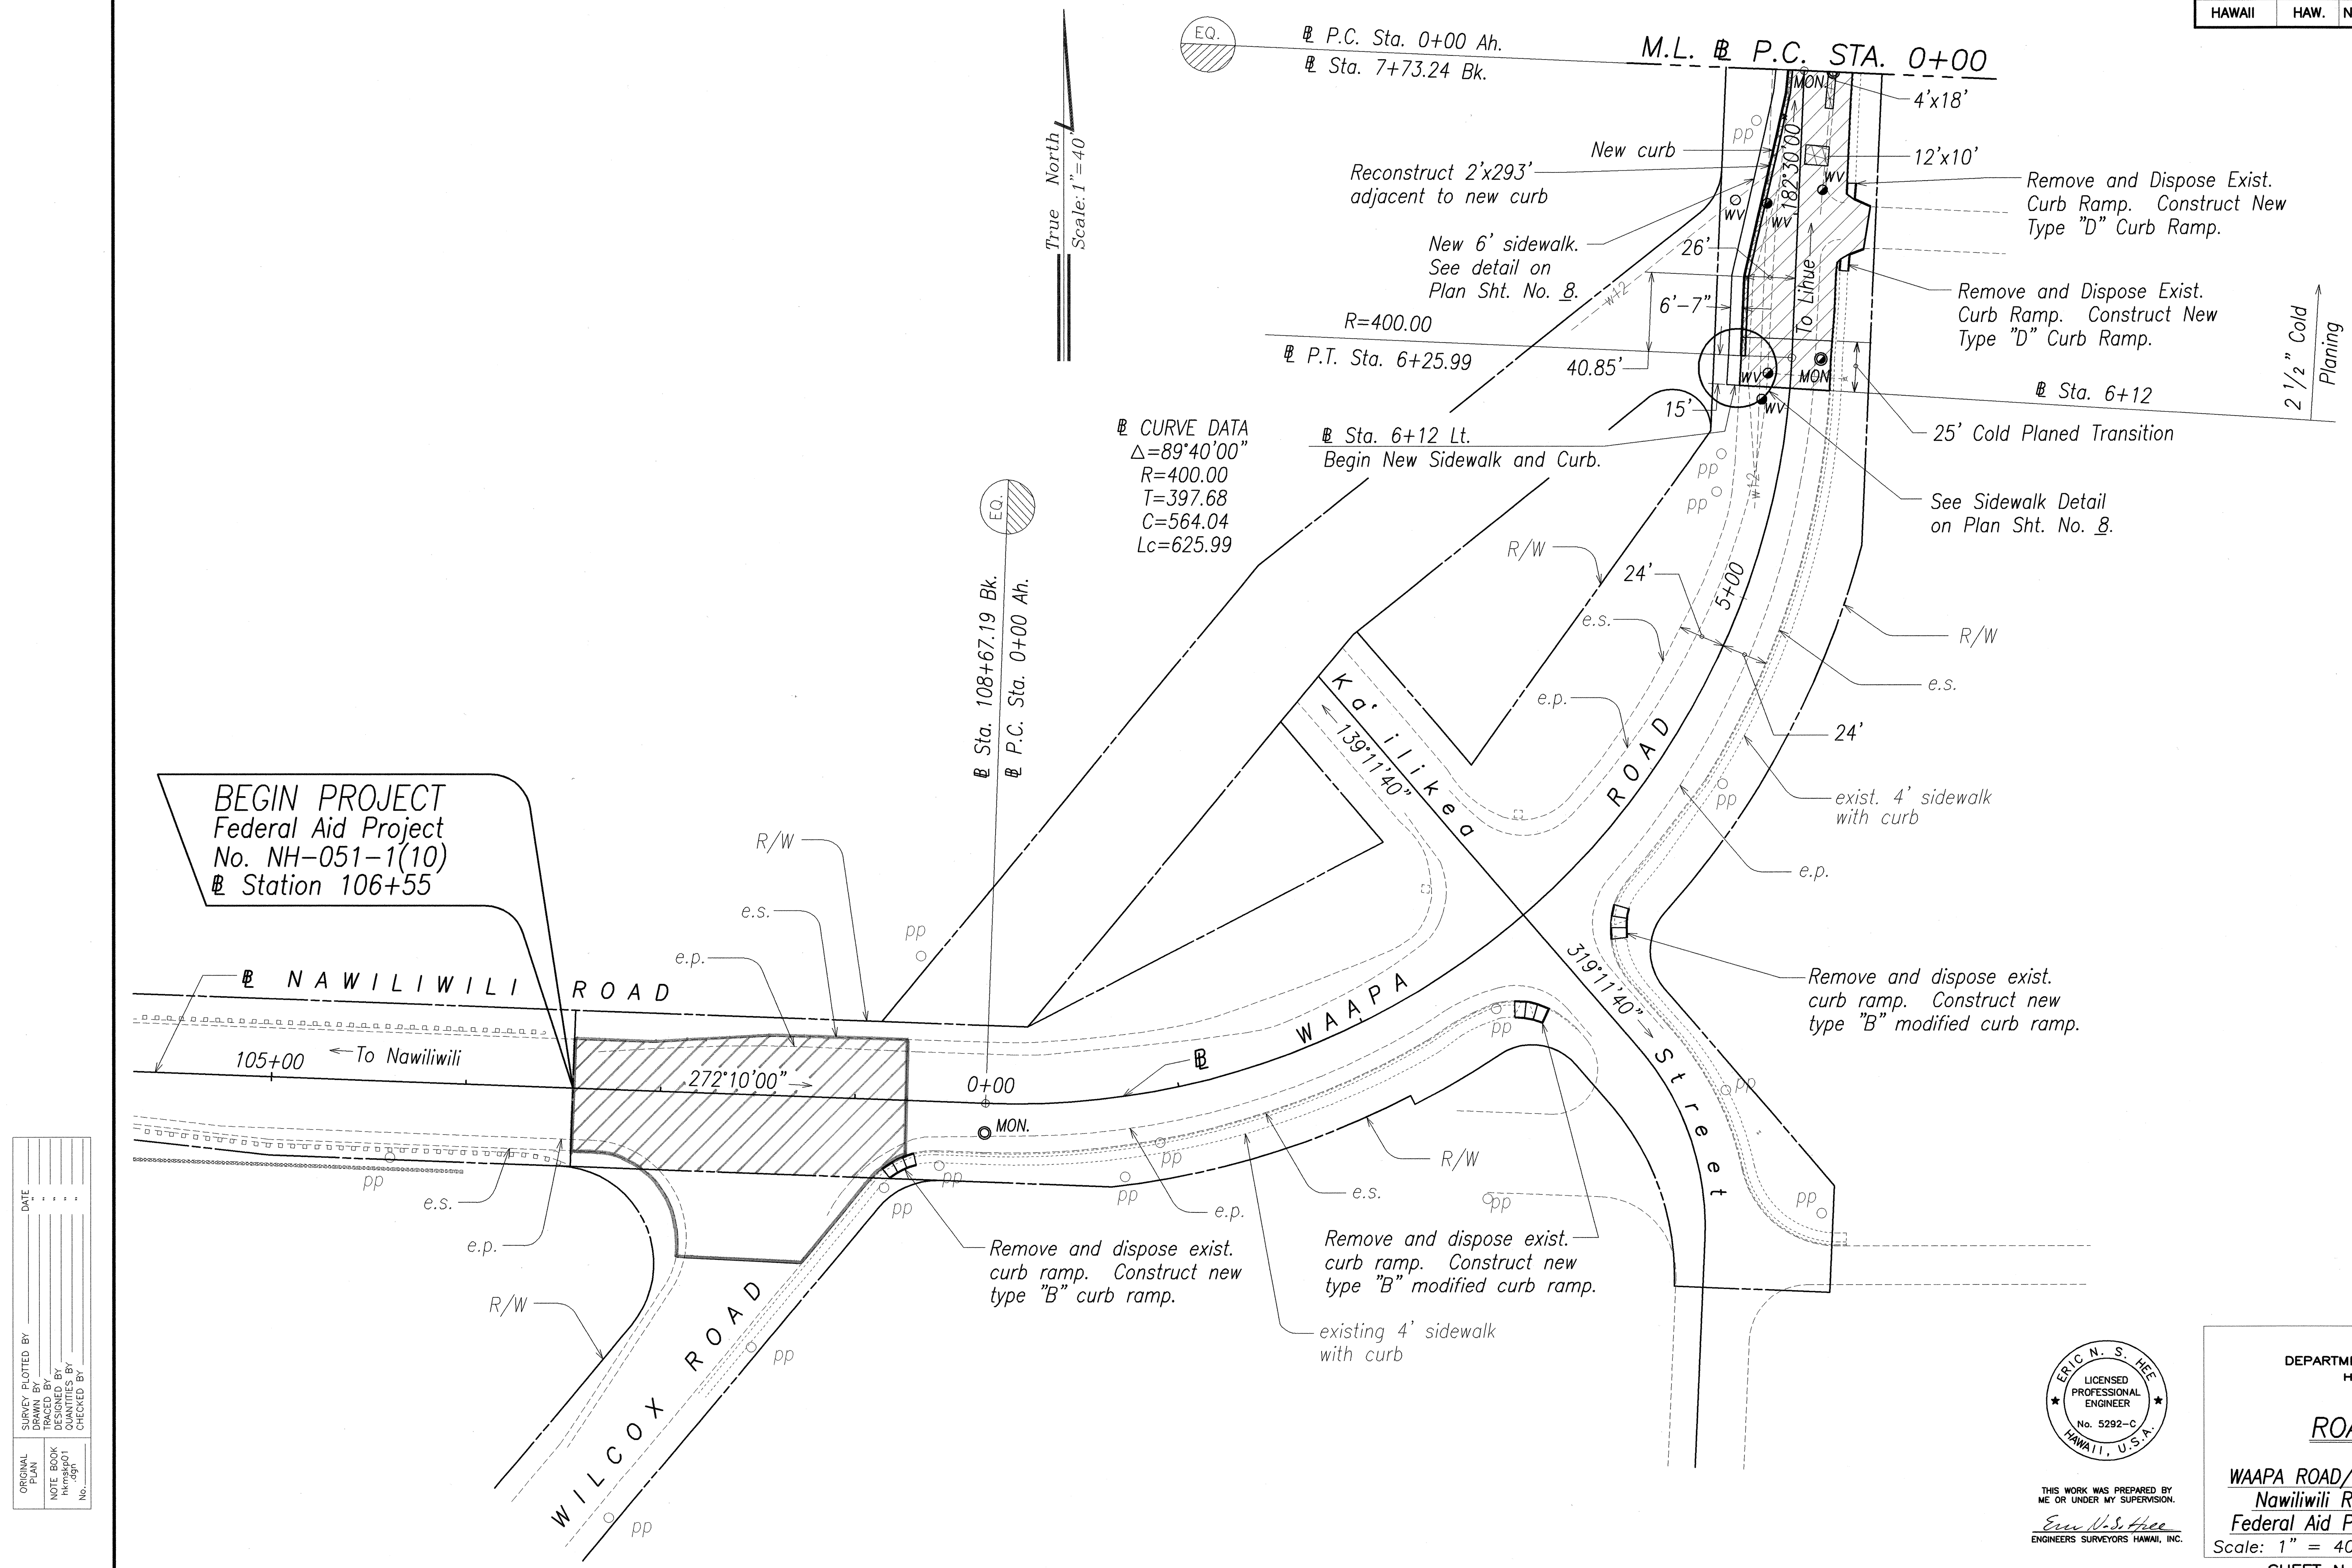

SURVEY PLOTTED BY	DATE
DRAWN BY	
TRACED BY	
CHECKED BY	
ORIGINAL PLAN	
NOTE BOOK	
hmsjg01	
No.	

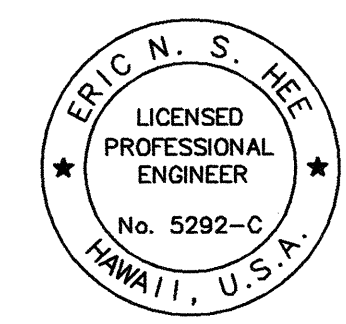

THIS WORK WAS PREPARED BY
ME OR UNDER MY SUPERVISION.
Eric N. S. Hee
ENGINEERS SURVEYORS HAWAII, INC.

STATE OF HAWAII
DEPARTMENT OF TRANSPORTATION
HIGHWAYS DIVISION


ROADWAY PLAN

WAAPA ROAD/RICE STREET RESURFACING
Nawiliwili Road To Kapule Highway
Federal Aid Project No. NH-051-1(10)
Scale: 1" = 40' Date: July, 2000
SHEET No. 1 OF 4 SHEETS

"AS-BUILT"


FED. ROAD DIST. NO.	STATE	FED. AID PROJ. NO.	FISCAL YEAR	SHEET NO.	TOTAL SHEETS
HAWAII	HAW.	NH-051-1(10)	2001	23	34

True North
Scale: 1"=40'

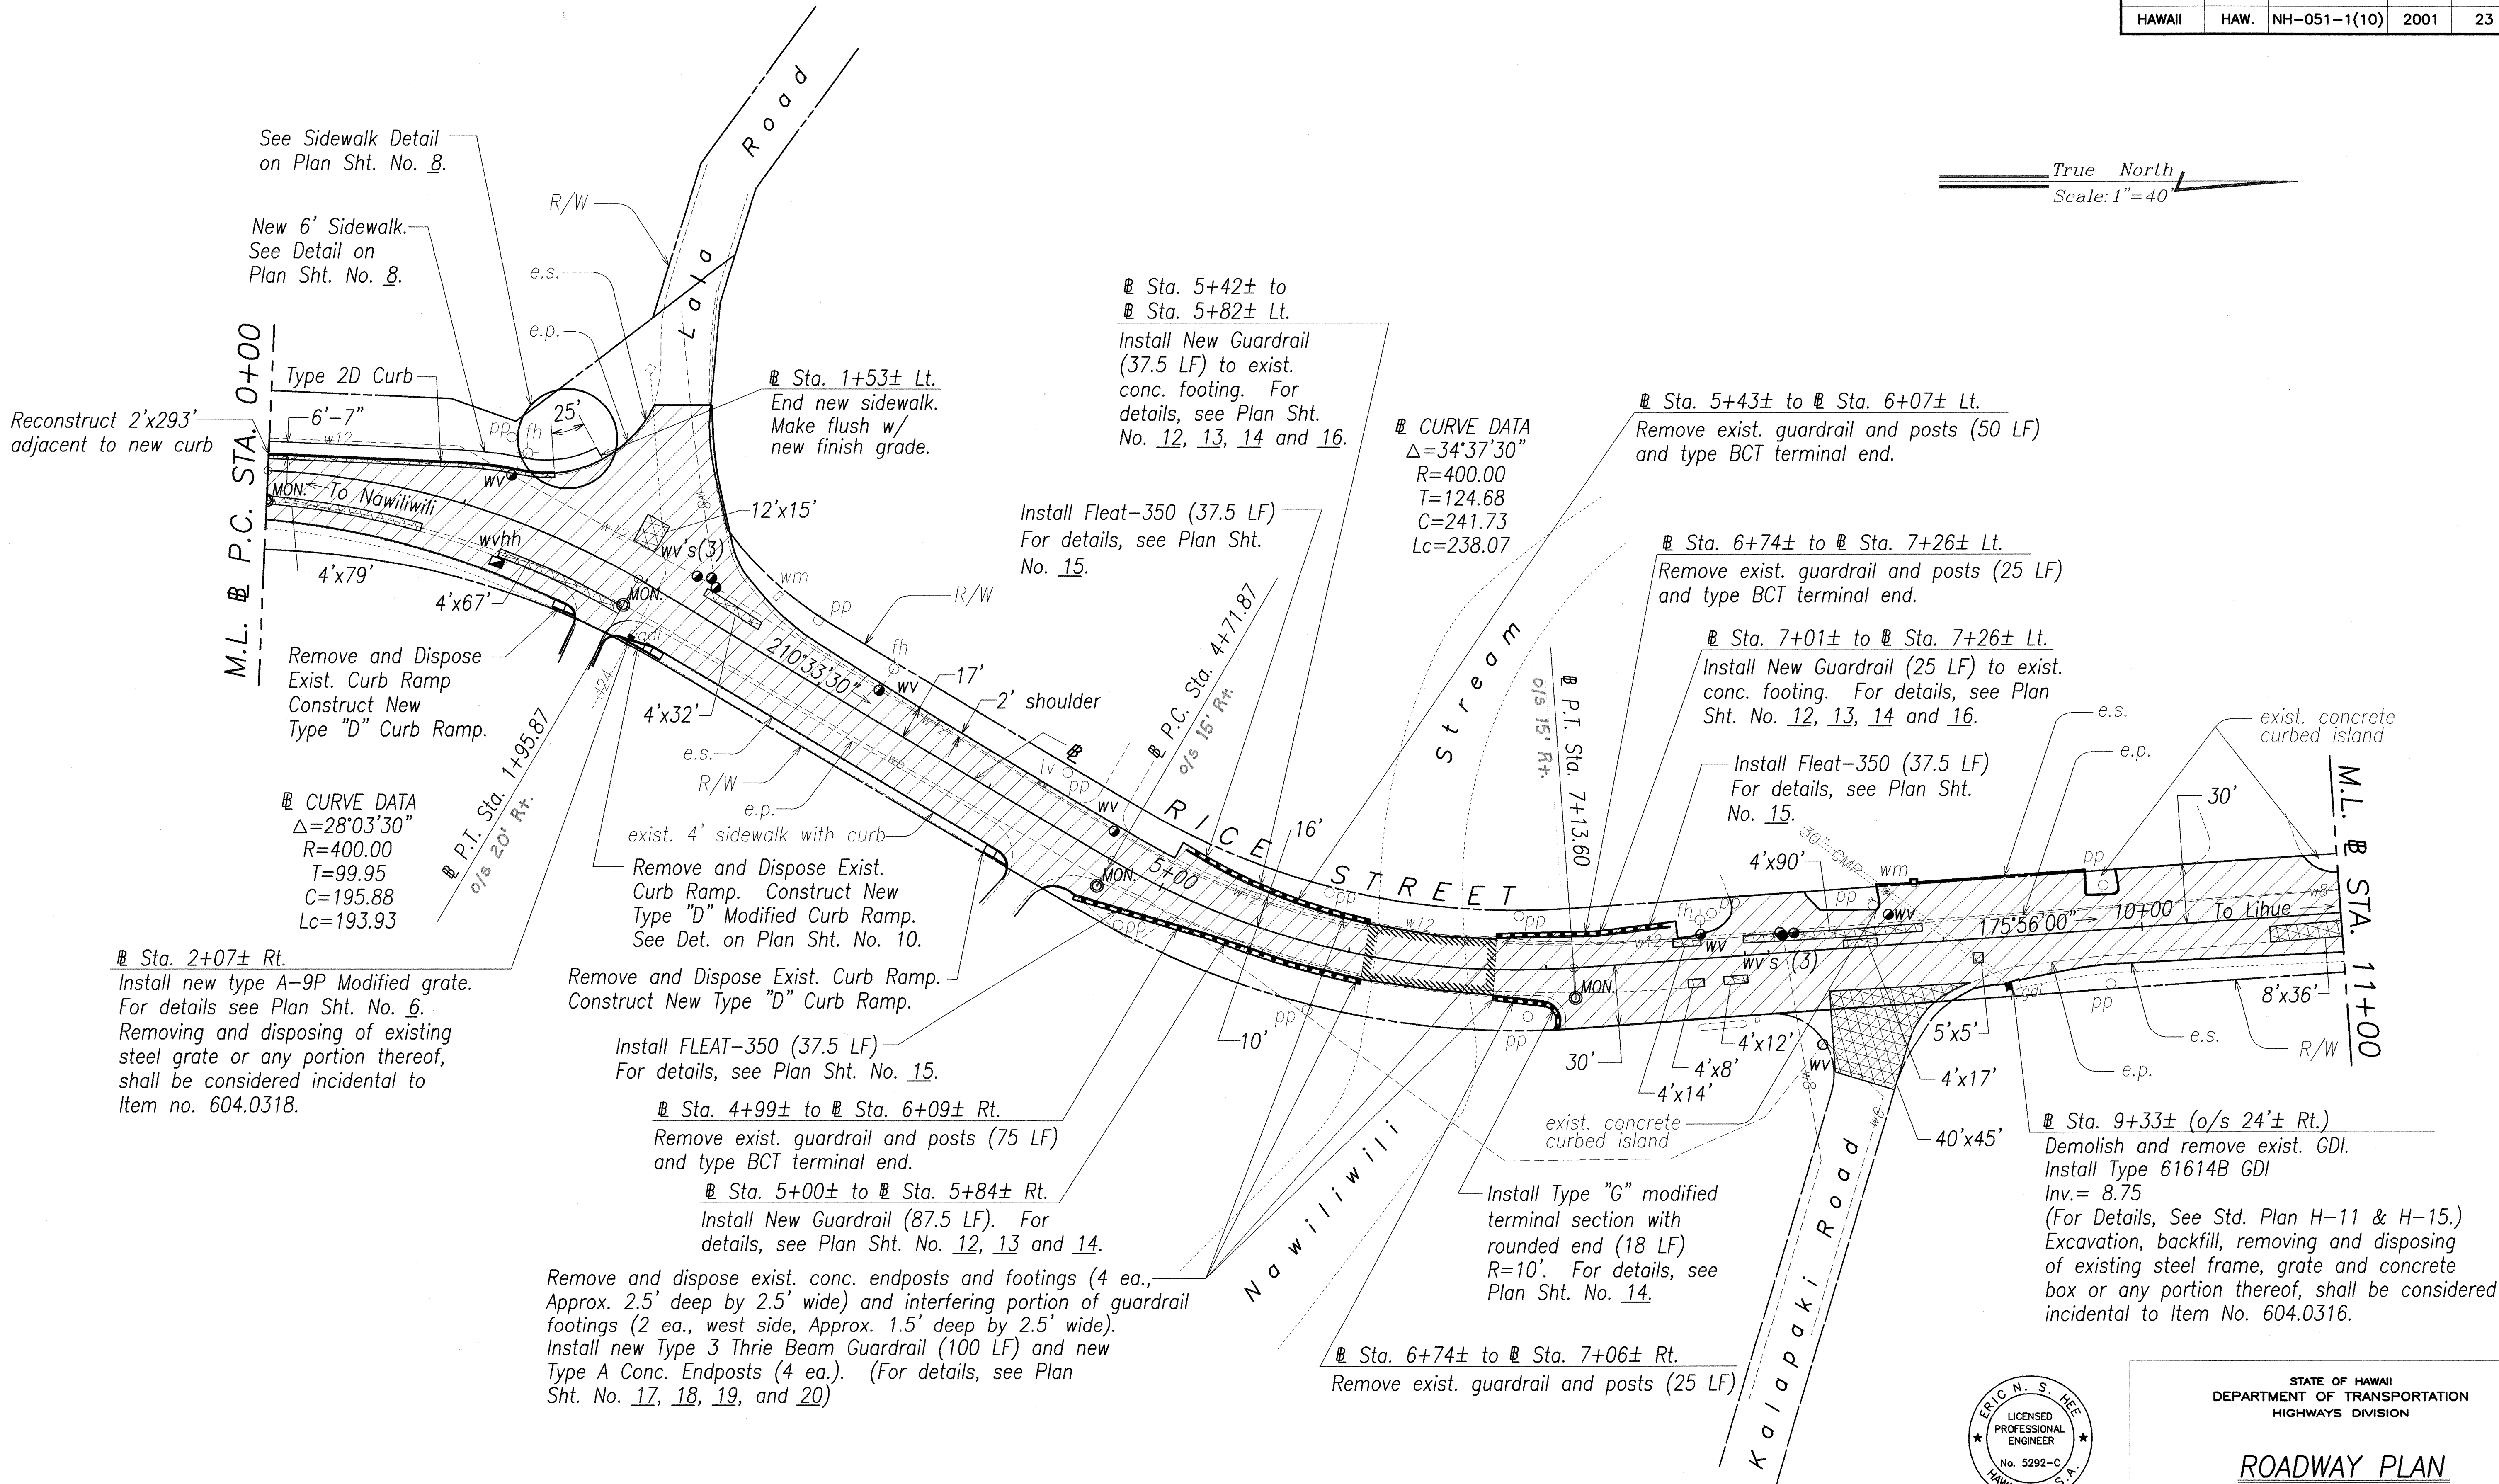

ORIGINAL PLAN	DATE
DESIGNED BY	
CHECKED BY	
NOTED BY	
DATE	

APPROVED: (FOR WORK WITHIN COUNTY R/W ONLY)
COUNTY ENGINEER, DEPT. OF PUBLIC WORKS, COUNTY OF KAUAI

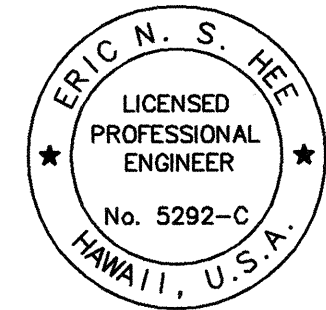

THIS WORK WAS PREPARED BY
ME OR UNDER MY SUPERVISION.
Eric N. S. Hee
ENGINEERS SURVEYORS HAWAII, INC.


STATE OF HAWAII
DEPARTMENT OF TRANSPORTATION
HIGHWAYS DIVISION

ROADWAY PLAN


WAAPA ROAD/RICE STREET RESURFACING
Nawiliwili Road To Kapule Highway
Federal Aid Project No. NH-051-1(10)
Scale: 1" = 40' Date: July, 2000
SHEET No. 2 OF 4 SHEETS

"AS-BUILT"

FED. ROAD DIST. NO.	STATE	FED. AID PROJ. NO.	FISCAL YEAR	SHEET NO.	TOTAL SHEETS
HAWAII	HAW.	NH-051-1(10)	2001	24	34

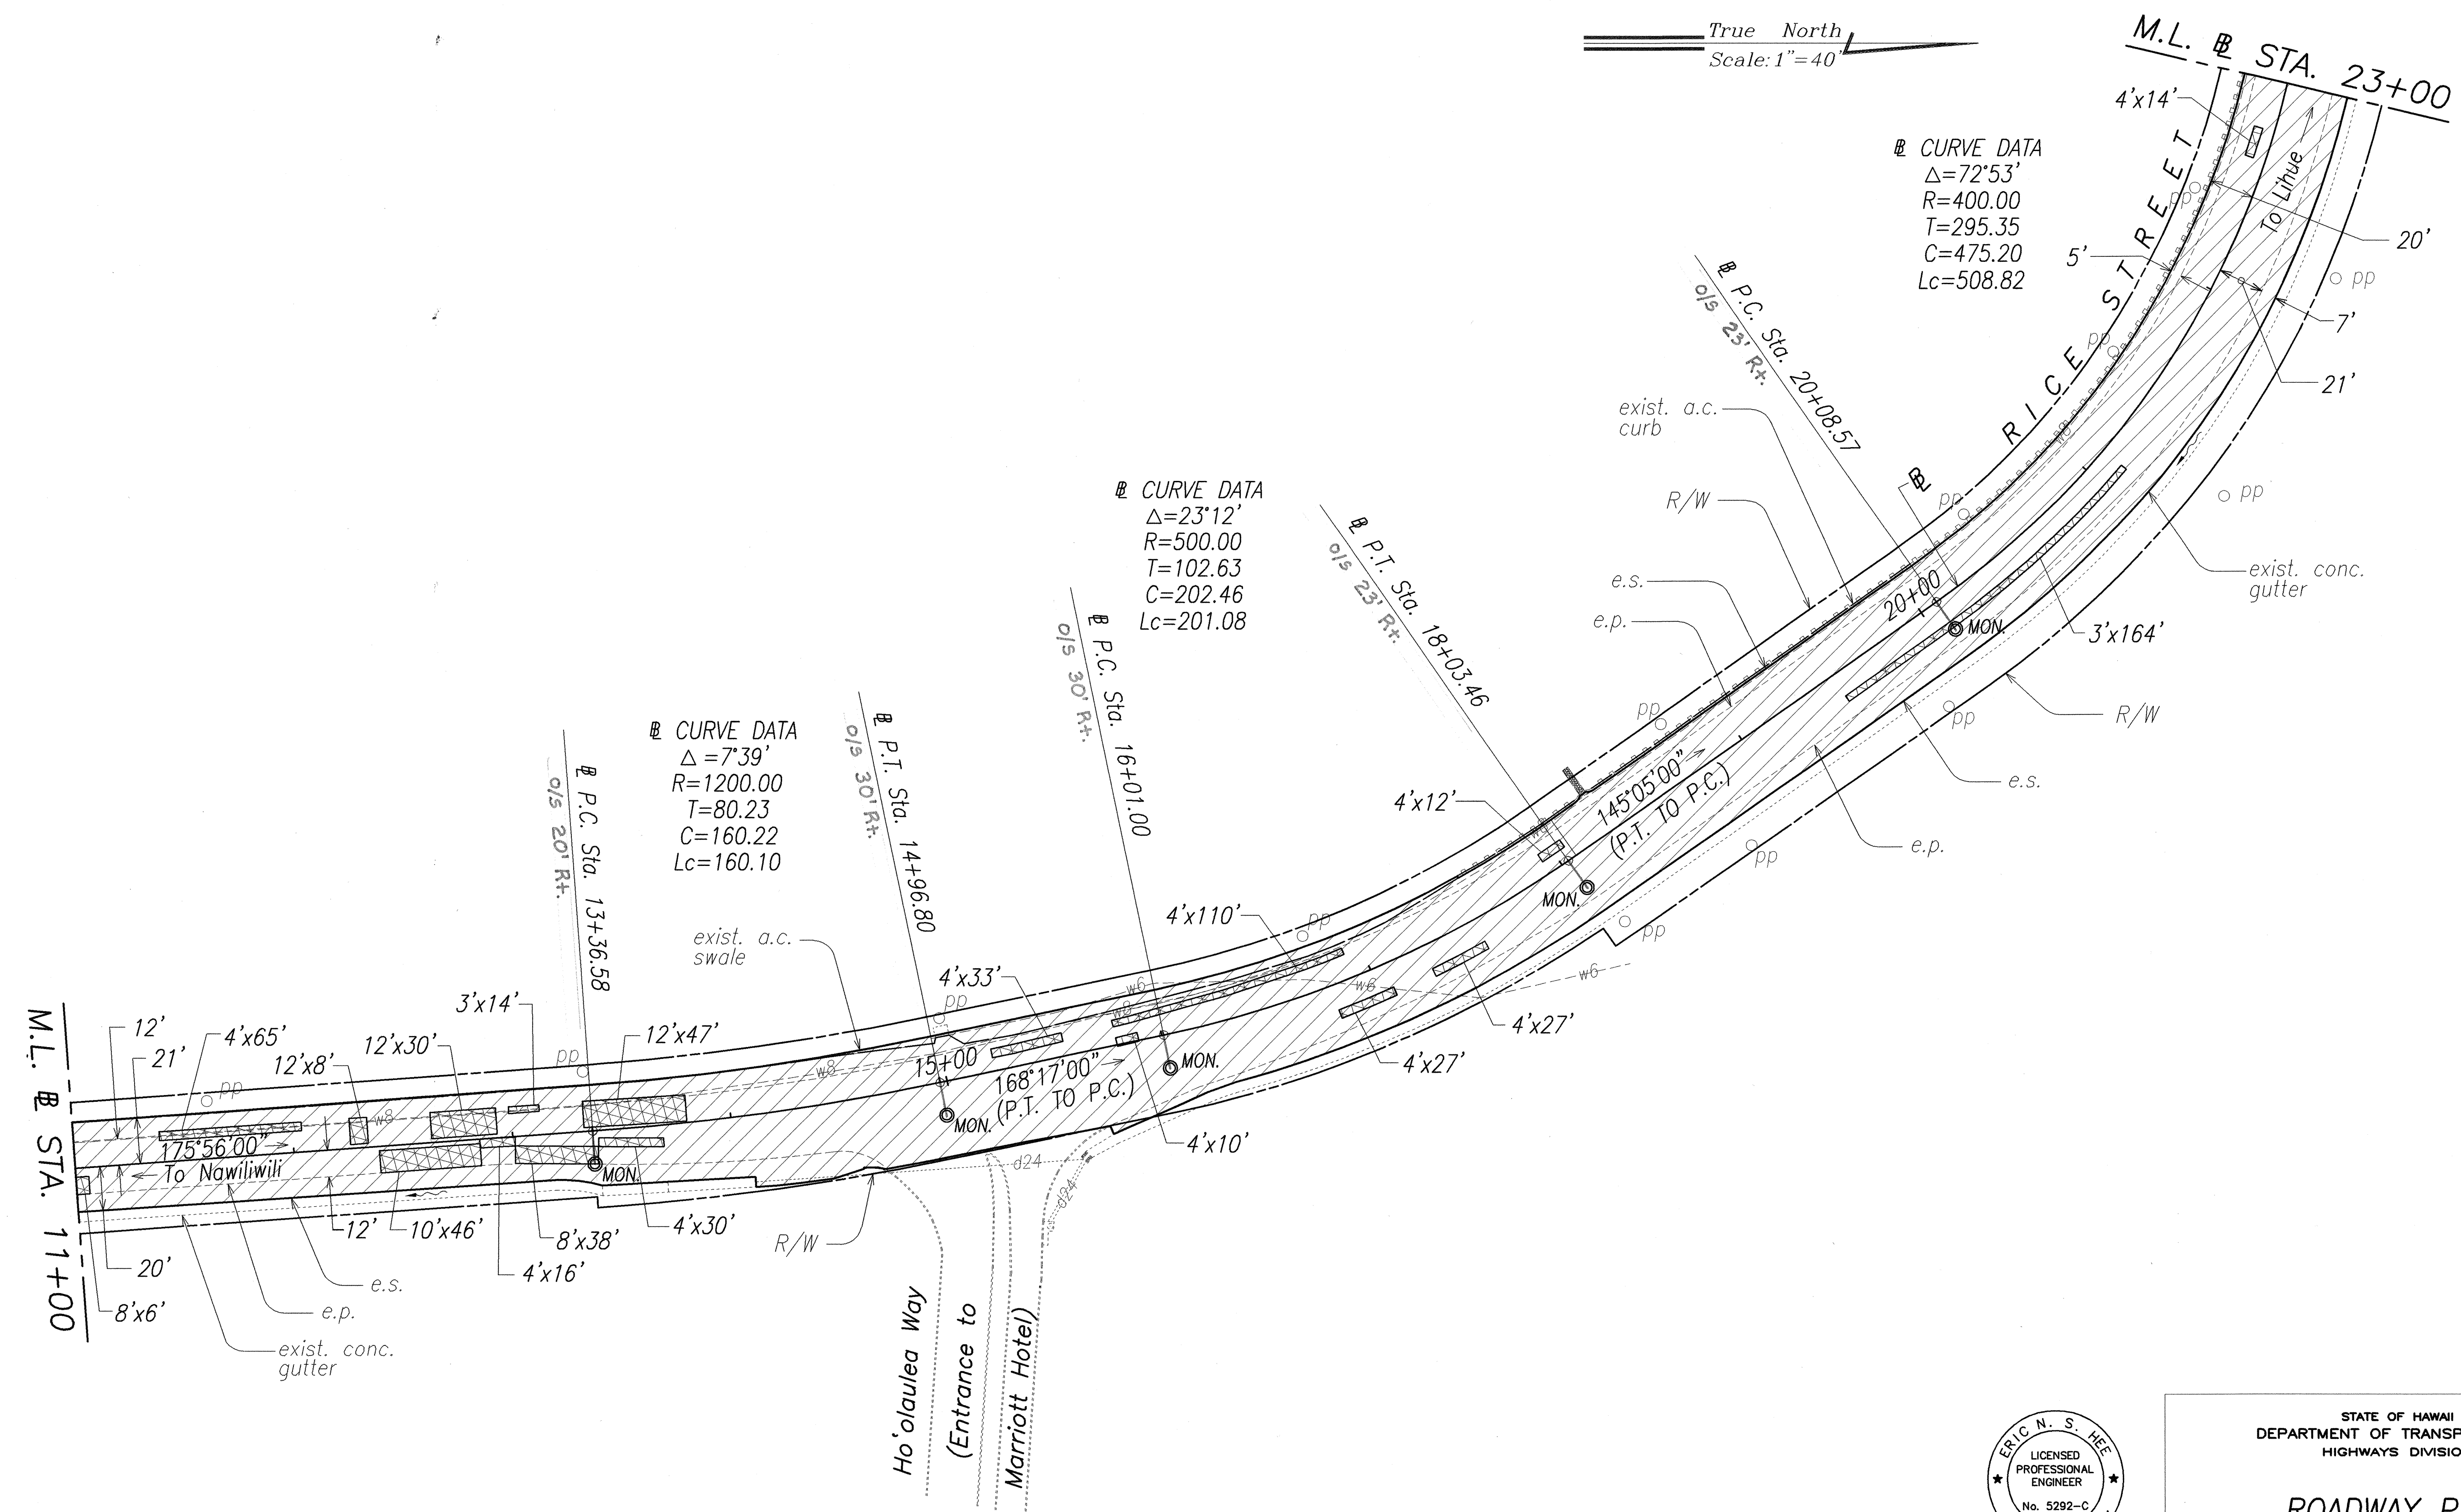

DATE	
SURVEY PLOTTED BY	
DRAWN BY	
DESIGNED BY	
CHECKED BY	
ORIGINAL PLAN	
NOTE BOOK	
hmsg003	
No.	

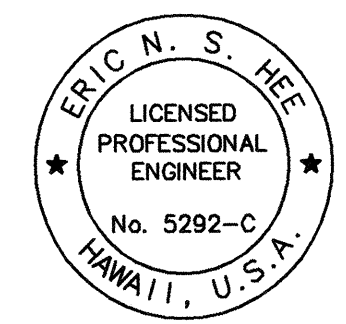

THIS WORK WAS PREPARED BY
ME OR UNDER MY SUPERVISION.
Eric N. S. Hee
ENGINEERS SURVEYORS HAWAII, INC.


STATE OF HAWAII
DEPARTMENT OF TRANSPORTATION
HIGHWAYS DIVISION

ROADWAY PLAN

WAAPA ROAD/RICE STREET RESURFACING
Nawiliwili Road To Kapule Highway
Federal Aid Project No. NH-051-1(10)
Scale: 1" = 40' Date: July, 2000
SHEET No. 3 OF 4 SHEETS

"AS-BUILT"

FED. ROAD DIST. NO.	STATE	FED. AID PROJ. NO.	FISCAL YEAR	SHEET NO.	TOTAL SHEETS
HAWAII	HAW.	NH-051-1(10)	2001	25	34

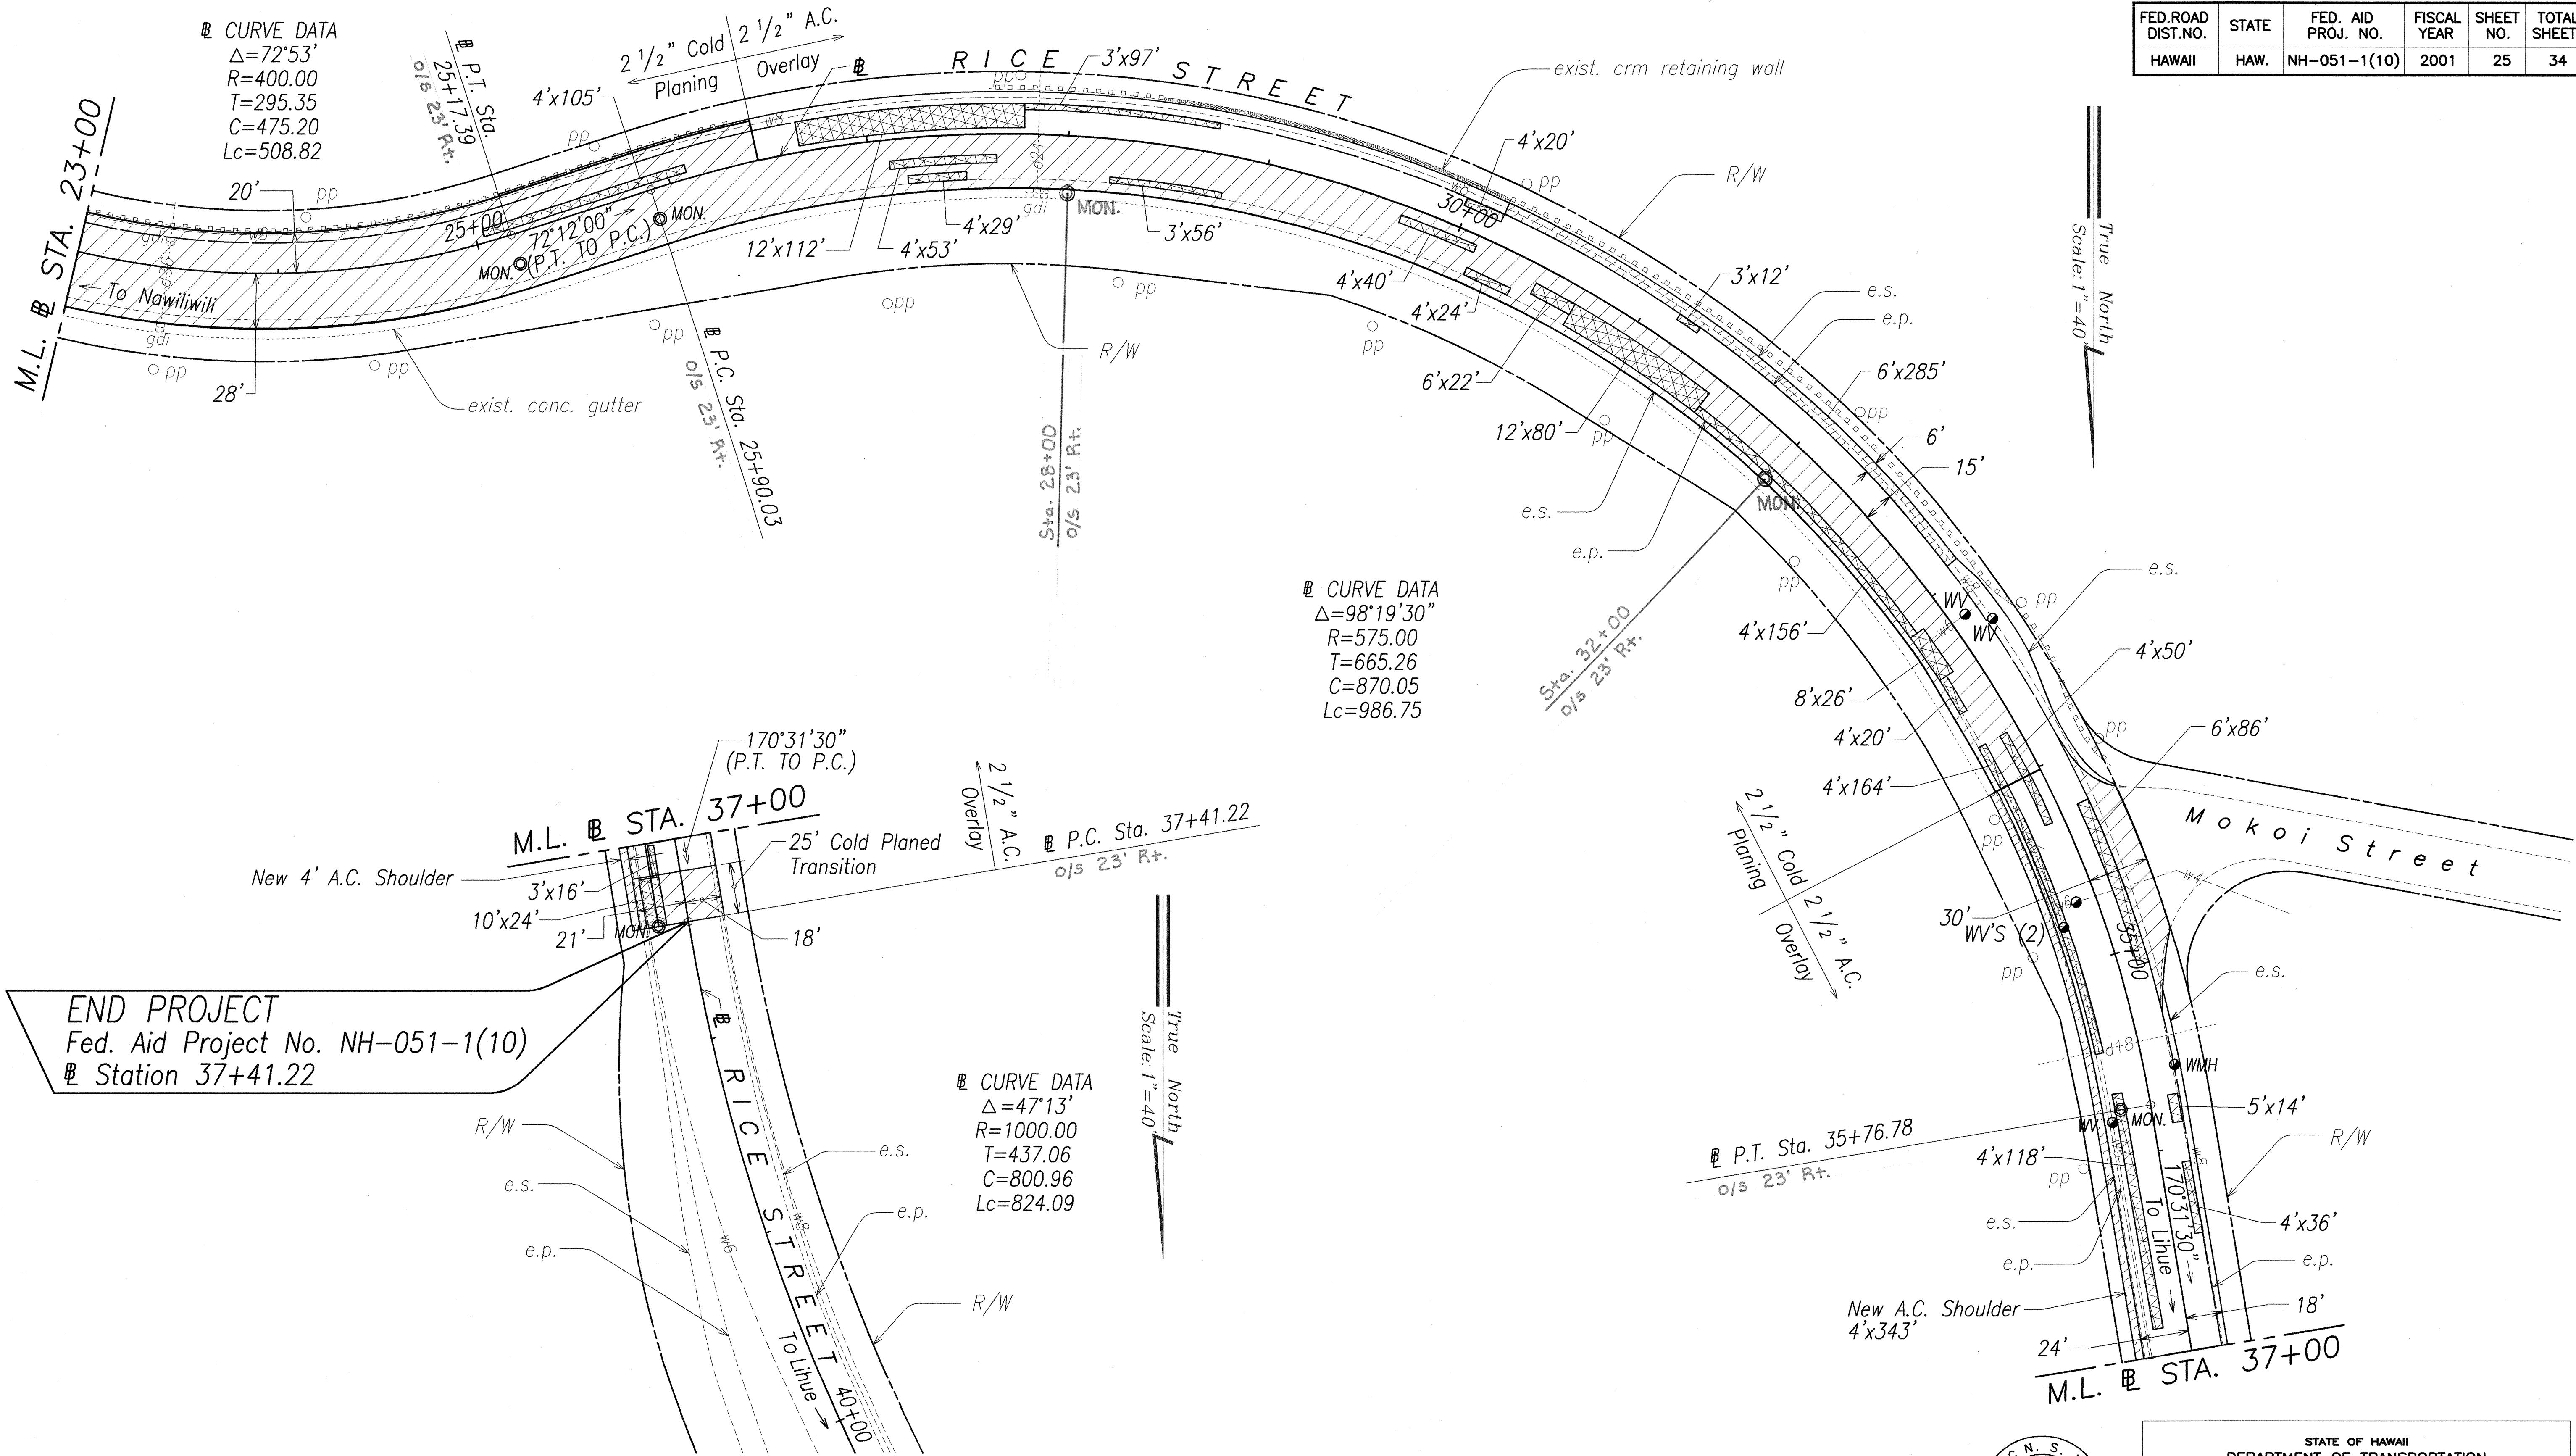

DATE	
SURVEY PLOTTED BY	
DRAWN BY	
DESIGNED BY	
QUANTITIES BY	
CHECKED BY	
ORIGINAL PLAN	
NOTE BOOK	
FILE NO.	
NO.	

"AS-BUILT"