


FED. ROAD DIST. NO.	STATE	PROJ. NO.	FISCAL YEAR	SHEET NO.	TOTAL SHEETS
HAWAII	HAW.	51B-01-08M	2008	21	33

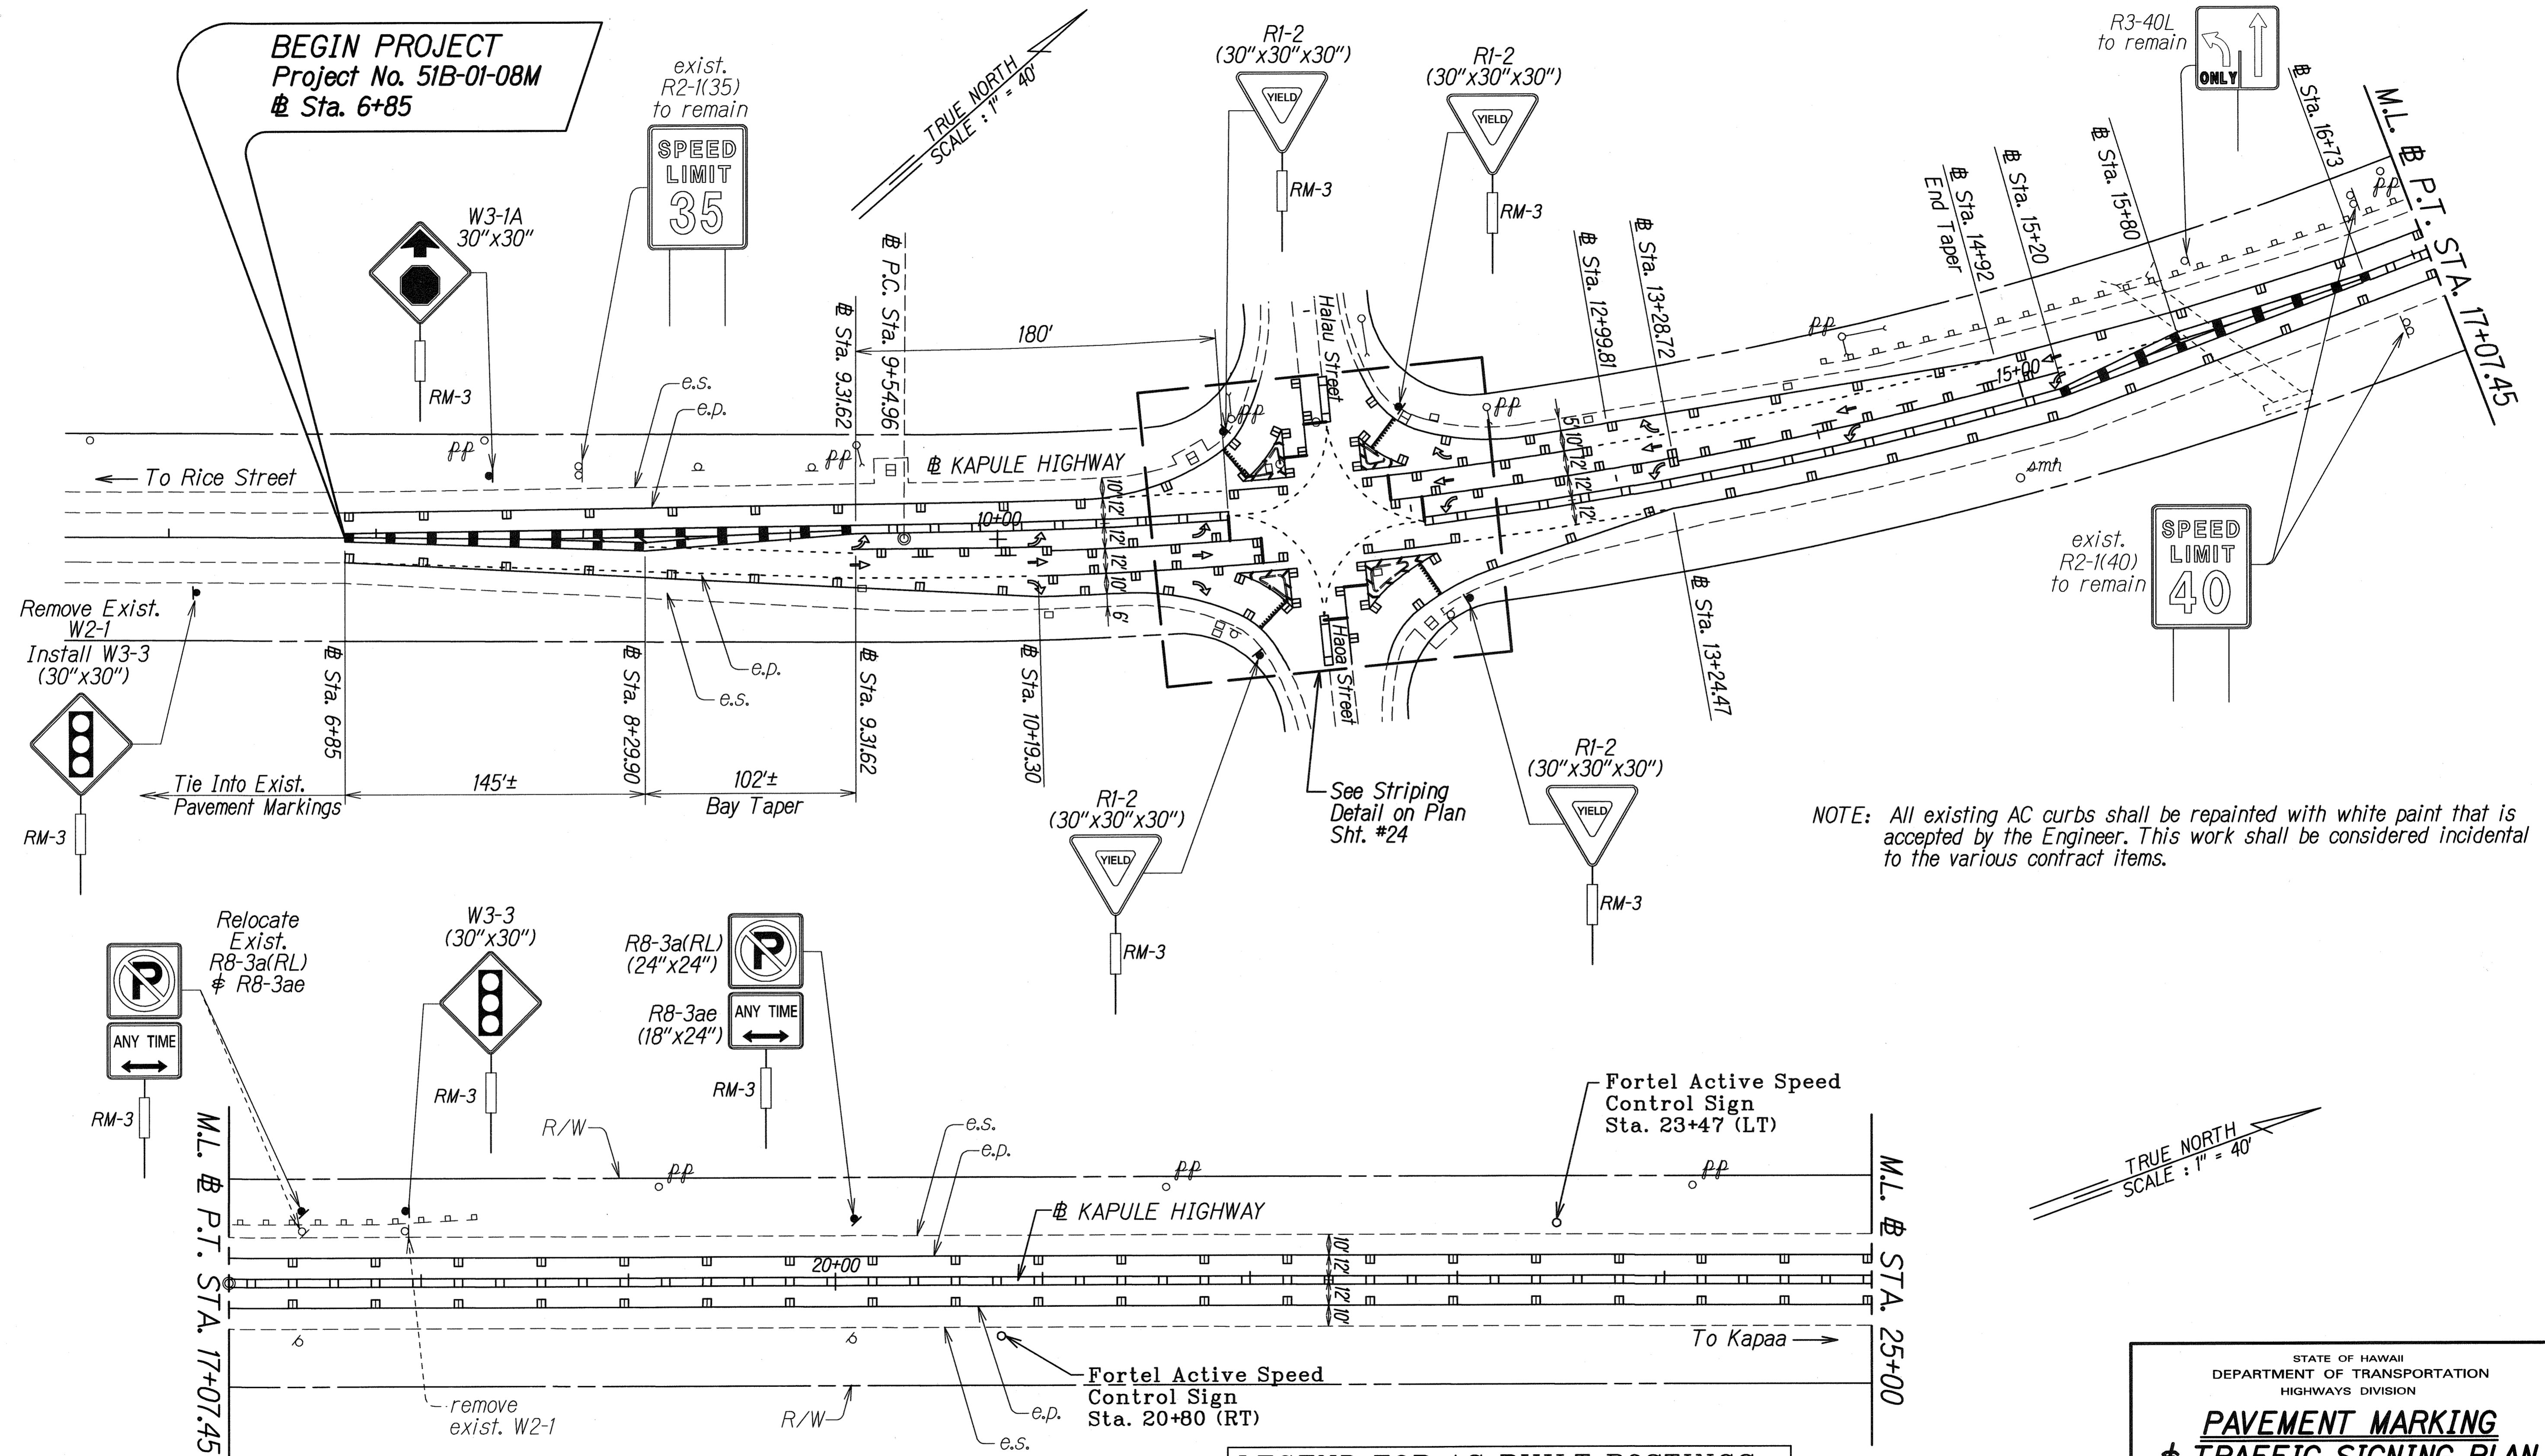

NOTE: All existing AC curbs shall be repainted with white paint that is accepted by the Engineer. This work shall be considered incidental to the various contract items.

DATE	_____
SURVEY PLOTTED BY	_____
DRAWN BY	_____
DESIGNED BY	_____
NOTED BY	_____
CHECKED BY	_____
ORIGINAL PLAN	_____
NOTE BOOK	_____
QUANTITIES BY	_____
CHECKED BY	_____

LEGEND FOR AS-BUILT POSTINGS	
	Squiggly line for as-built deletion
	Double line for as-built deletion
Roadway	Text for as-built posting


STATE OF HAWAII
DEPARTMENT OF TRANSPORTATION
HIGHWAYS DIVISION

**PAVEMENT MARKING
& TRAFFIC SIGNING PLAN**
KAPULE HIGHWAY RESURFACING
Rice Street to Ahukini Road
Project No. 51B-01-08M

Scale: 1" = 40' Date: May 2008

SHEET No. 1 OF 3 SHEETS

FED. ROAD DIST. NO.	STATE	PROJ. NO.	FISCAL YEAR	SHEET NO.	TOTAL SHEETS
HAWAII	HAW.	51B-01-08M	2008	22	33

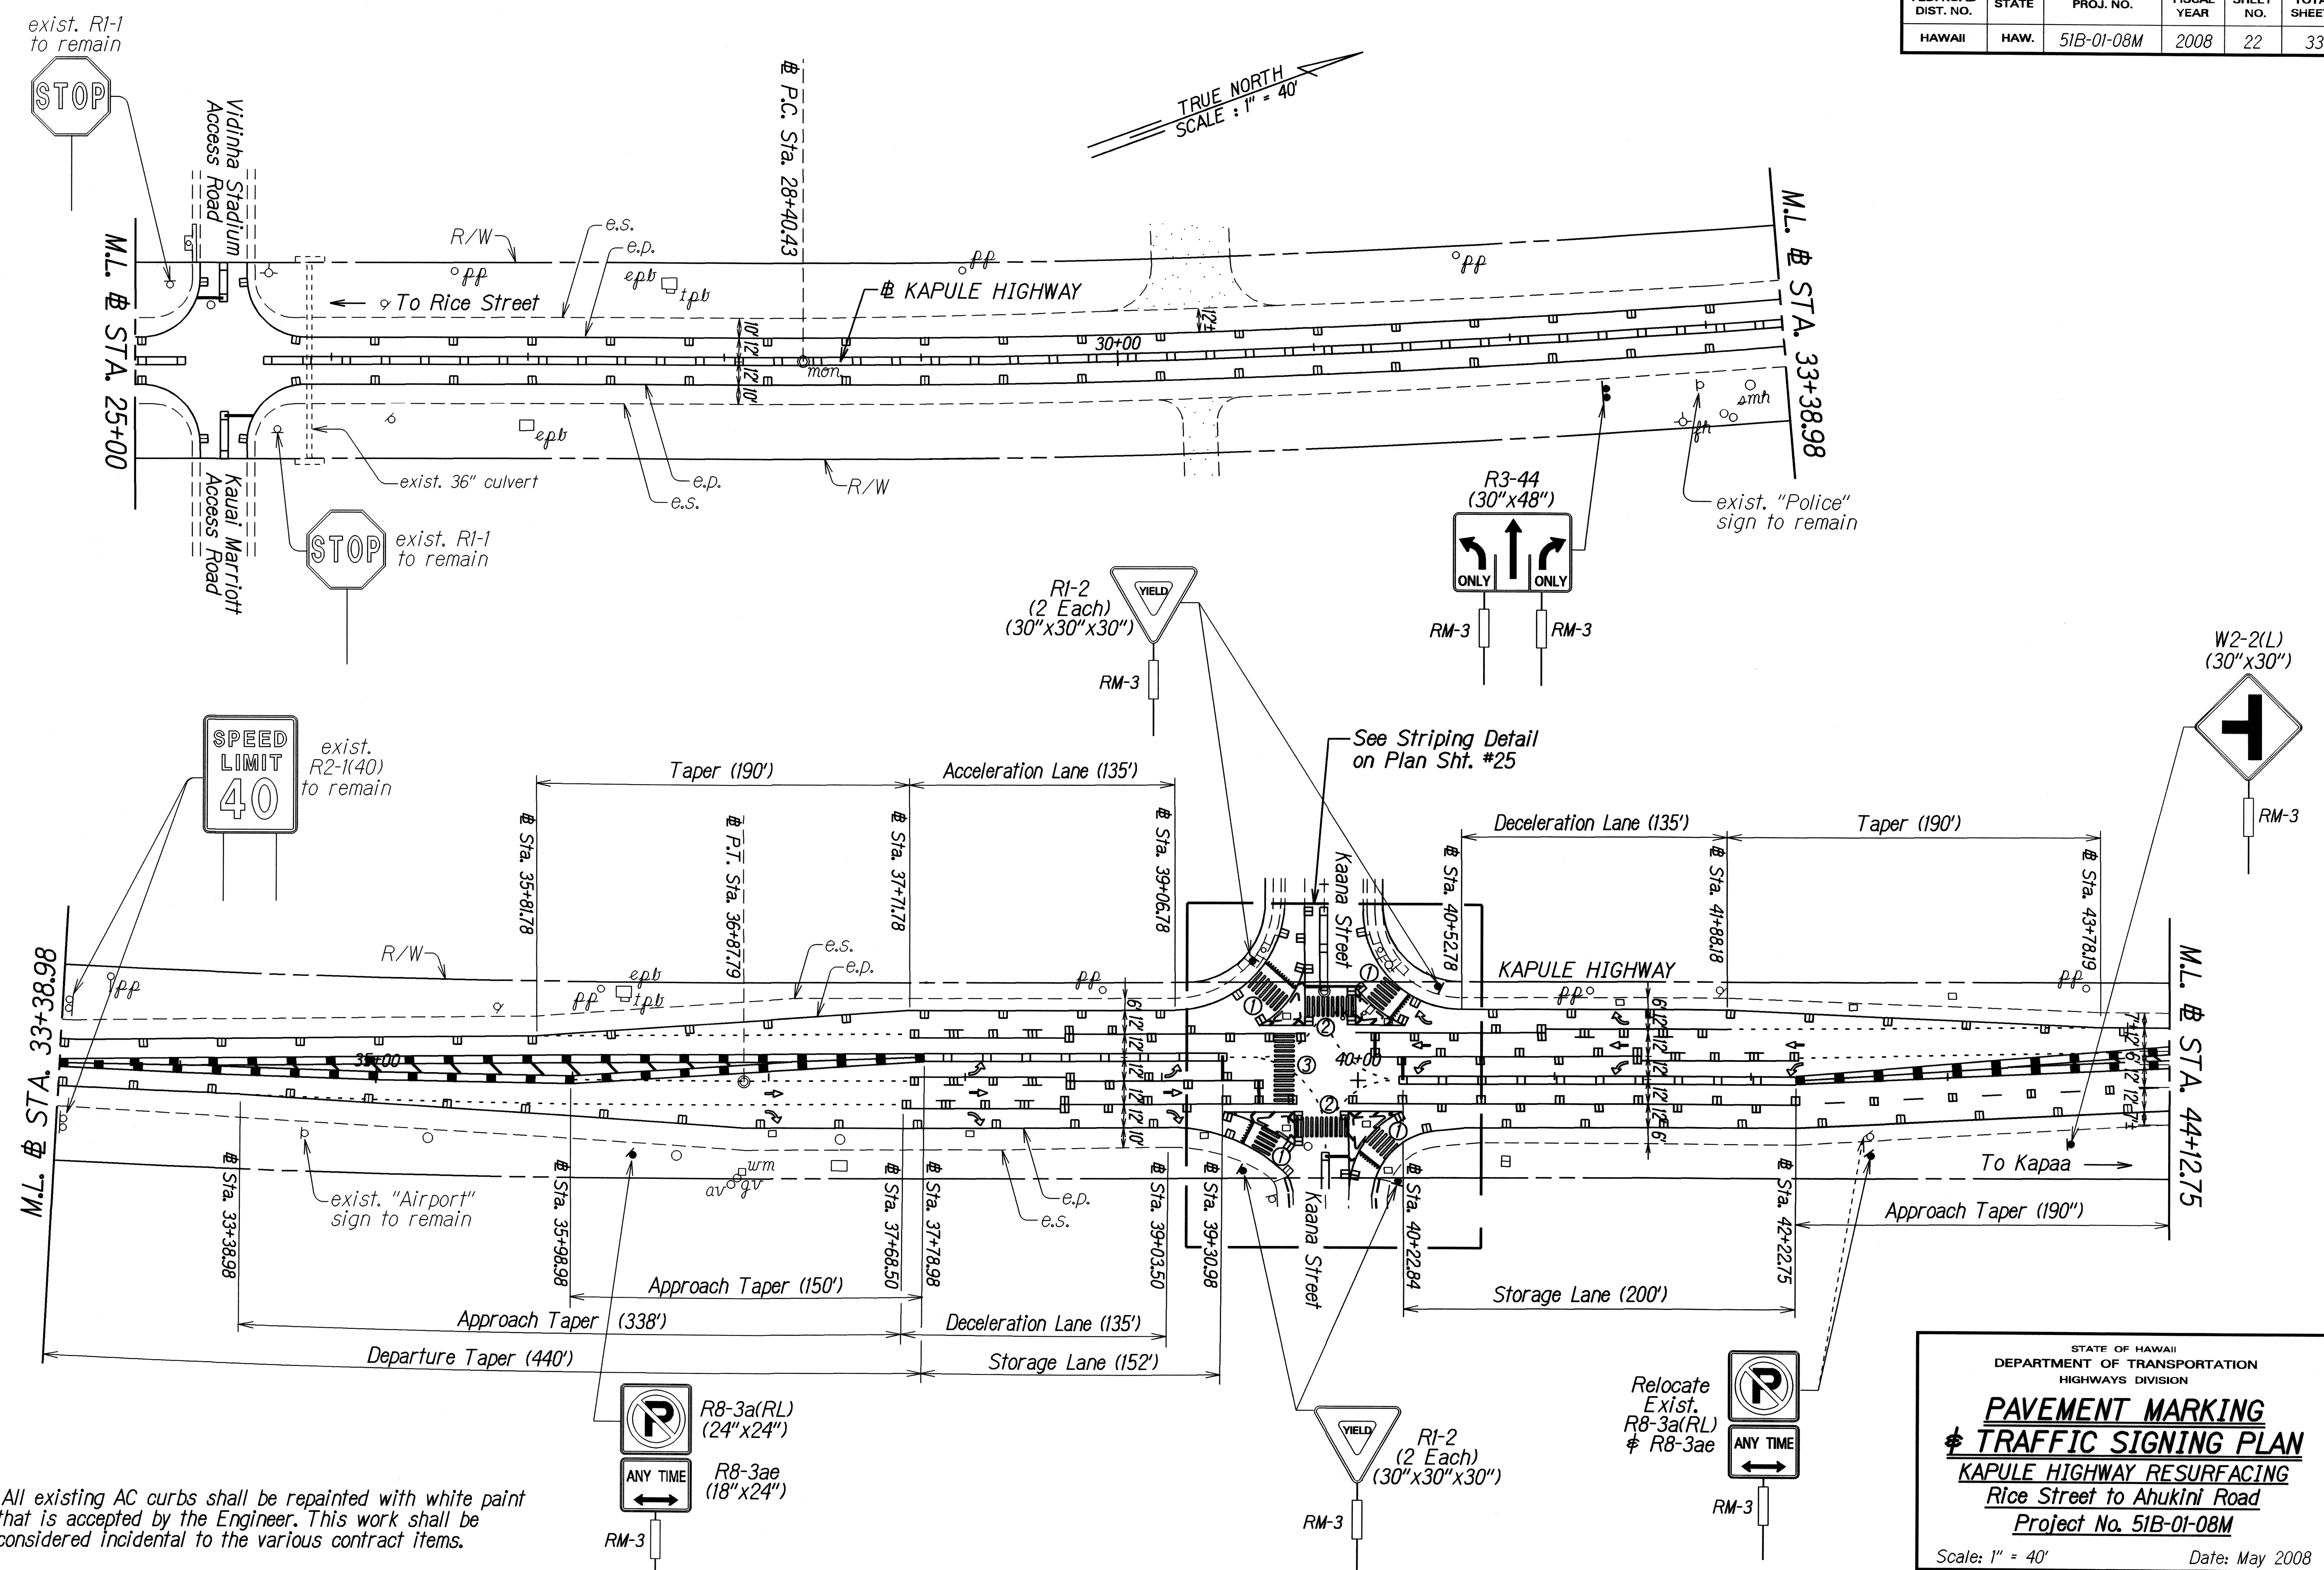

NOTE: All existing AC curbs shall be repainted with white paint that is accepted by the Engineer. This work shall be considered incidental to the various contract items.

DATE	____
SURVEY PLOTTED BY	____
TRACED BY	____
DESIGNED BY	____
QUANTITIES BY	____
CHECKED BY	____
ORIGINAL PLAN	____
NOTE BOOK	____
5/20/08	____

STATE OF HAWAII
DEPARTMENT OF TRANSPORTATION
HIGHWAYS DIVISION


**PAVEMENT MARKING
TRAFFIC SIGNING PLAN**

KAPULE HIGHWAY RESURFACING
Rice Street to Ahukini Road
Project No. 51B-01-08M

Scale: 1" = 40' Date: May 2008

SHEET No. 2 OF 3 SHEETS

FED. ROAD DIST. NO.	STATE	PROJ. NO.	FISCAL YEAR	SHEET NO.	TOTAL SHEETS
HAWAII	HAW.	51B-01-08M	2008	23	33

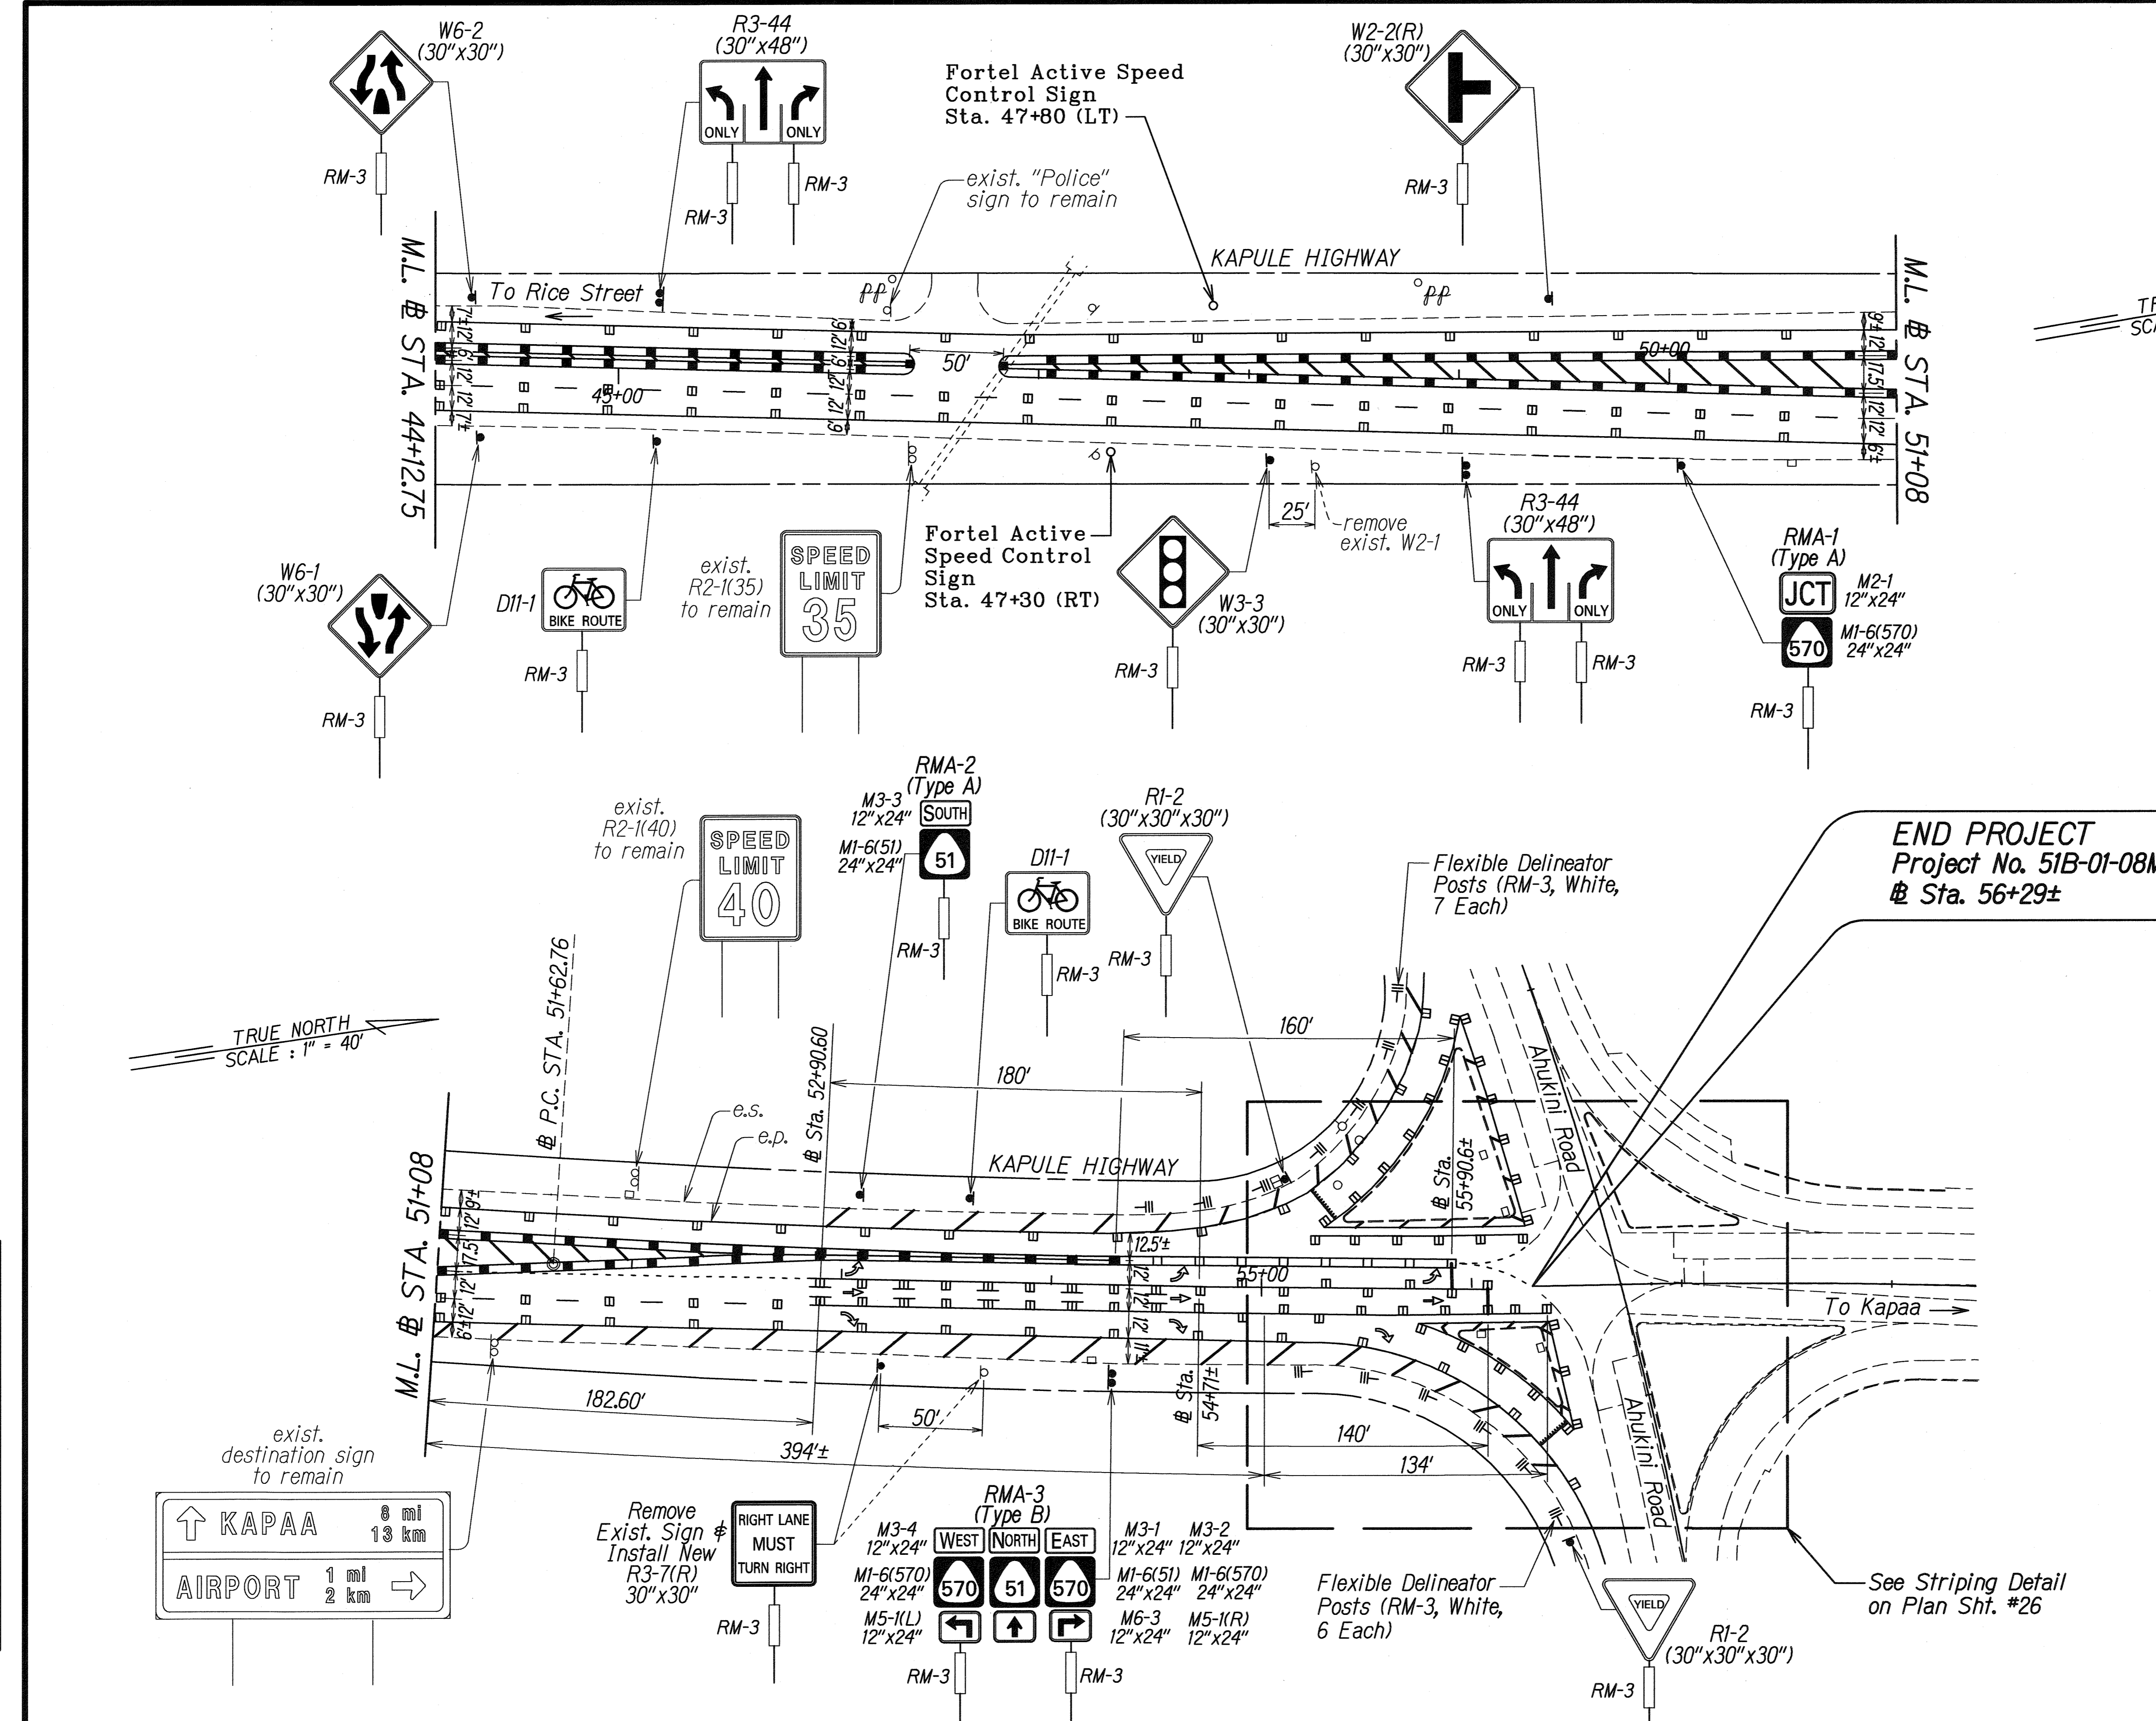

TRUE NORTH
SCALE: 1" = 40'


TRUE NORTH
SCALE: 1" = 40'

END PROJECT
Project No. 51B-01-08M
Sta. 56+29±









LEGEND FOR AS-BUILT POSTINGS

	Squiggly line for as-built deletion
	Double line for as-built deletion
Roadway	Text for as-built posting

SURVEY PLOTTED BY	DATE
DRAWN BY	
TRACED BY	
NOTED BY	
CHECKED BY	
ORIGINAL PLAN	
NOTE BOOK	
DATE	

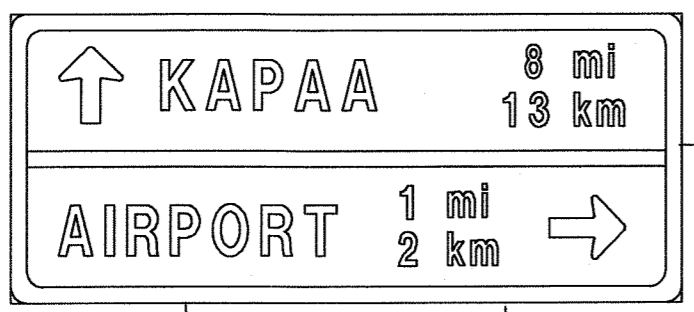

Remove Exist. Sign & Install New R3-7(R) 30"x30"

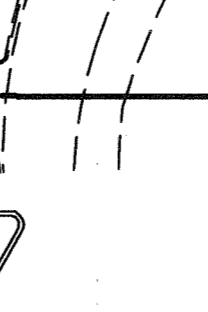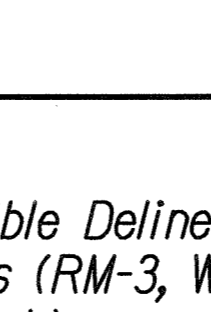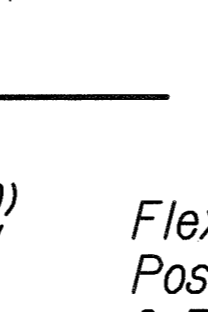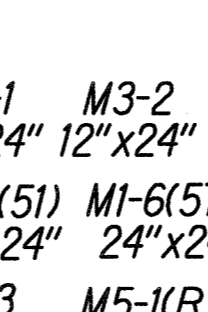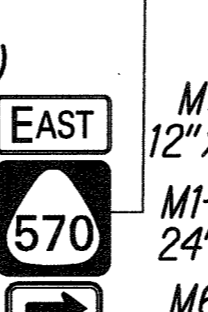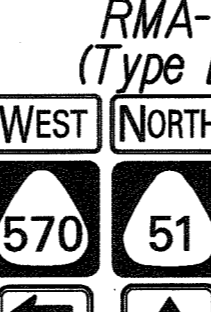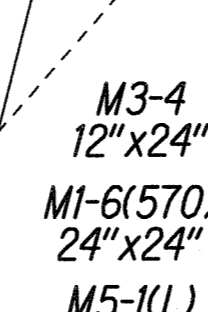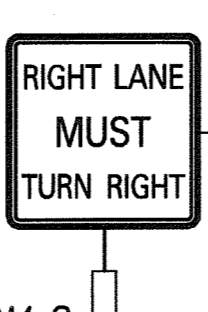

STATE OF HAWAII
DEPARTMENT OF TRANSPORTATION
HIGHWAYS DIVISION

PAVEMENT MARKING & TRAFFIC SIGNING PLAN
KAPULE HIGHWAY RESURFACING
Rice Street to Ahukini Road
Project No. 51B-01-08M

Scale: 1" = 40' Date: May 2008
SHEET No. 3 OF 3 SHEETS