



FED. ROAD DIST. NO.	STATE	PROJ. NO.	FISCAL YEAR	SHEET NO.	TOTAL SHEETS
HAWAII	HAW.	51B-01-08M	2008	15	33

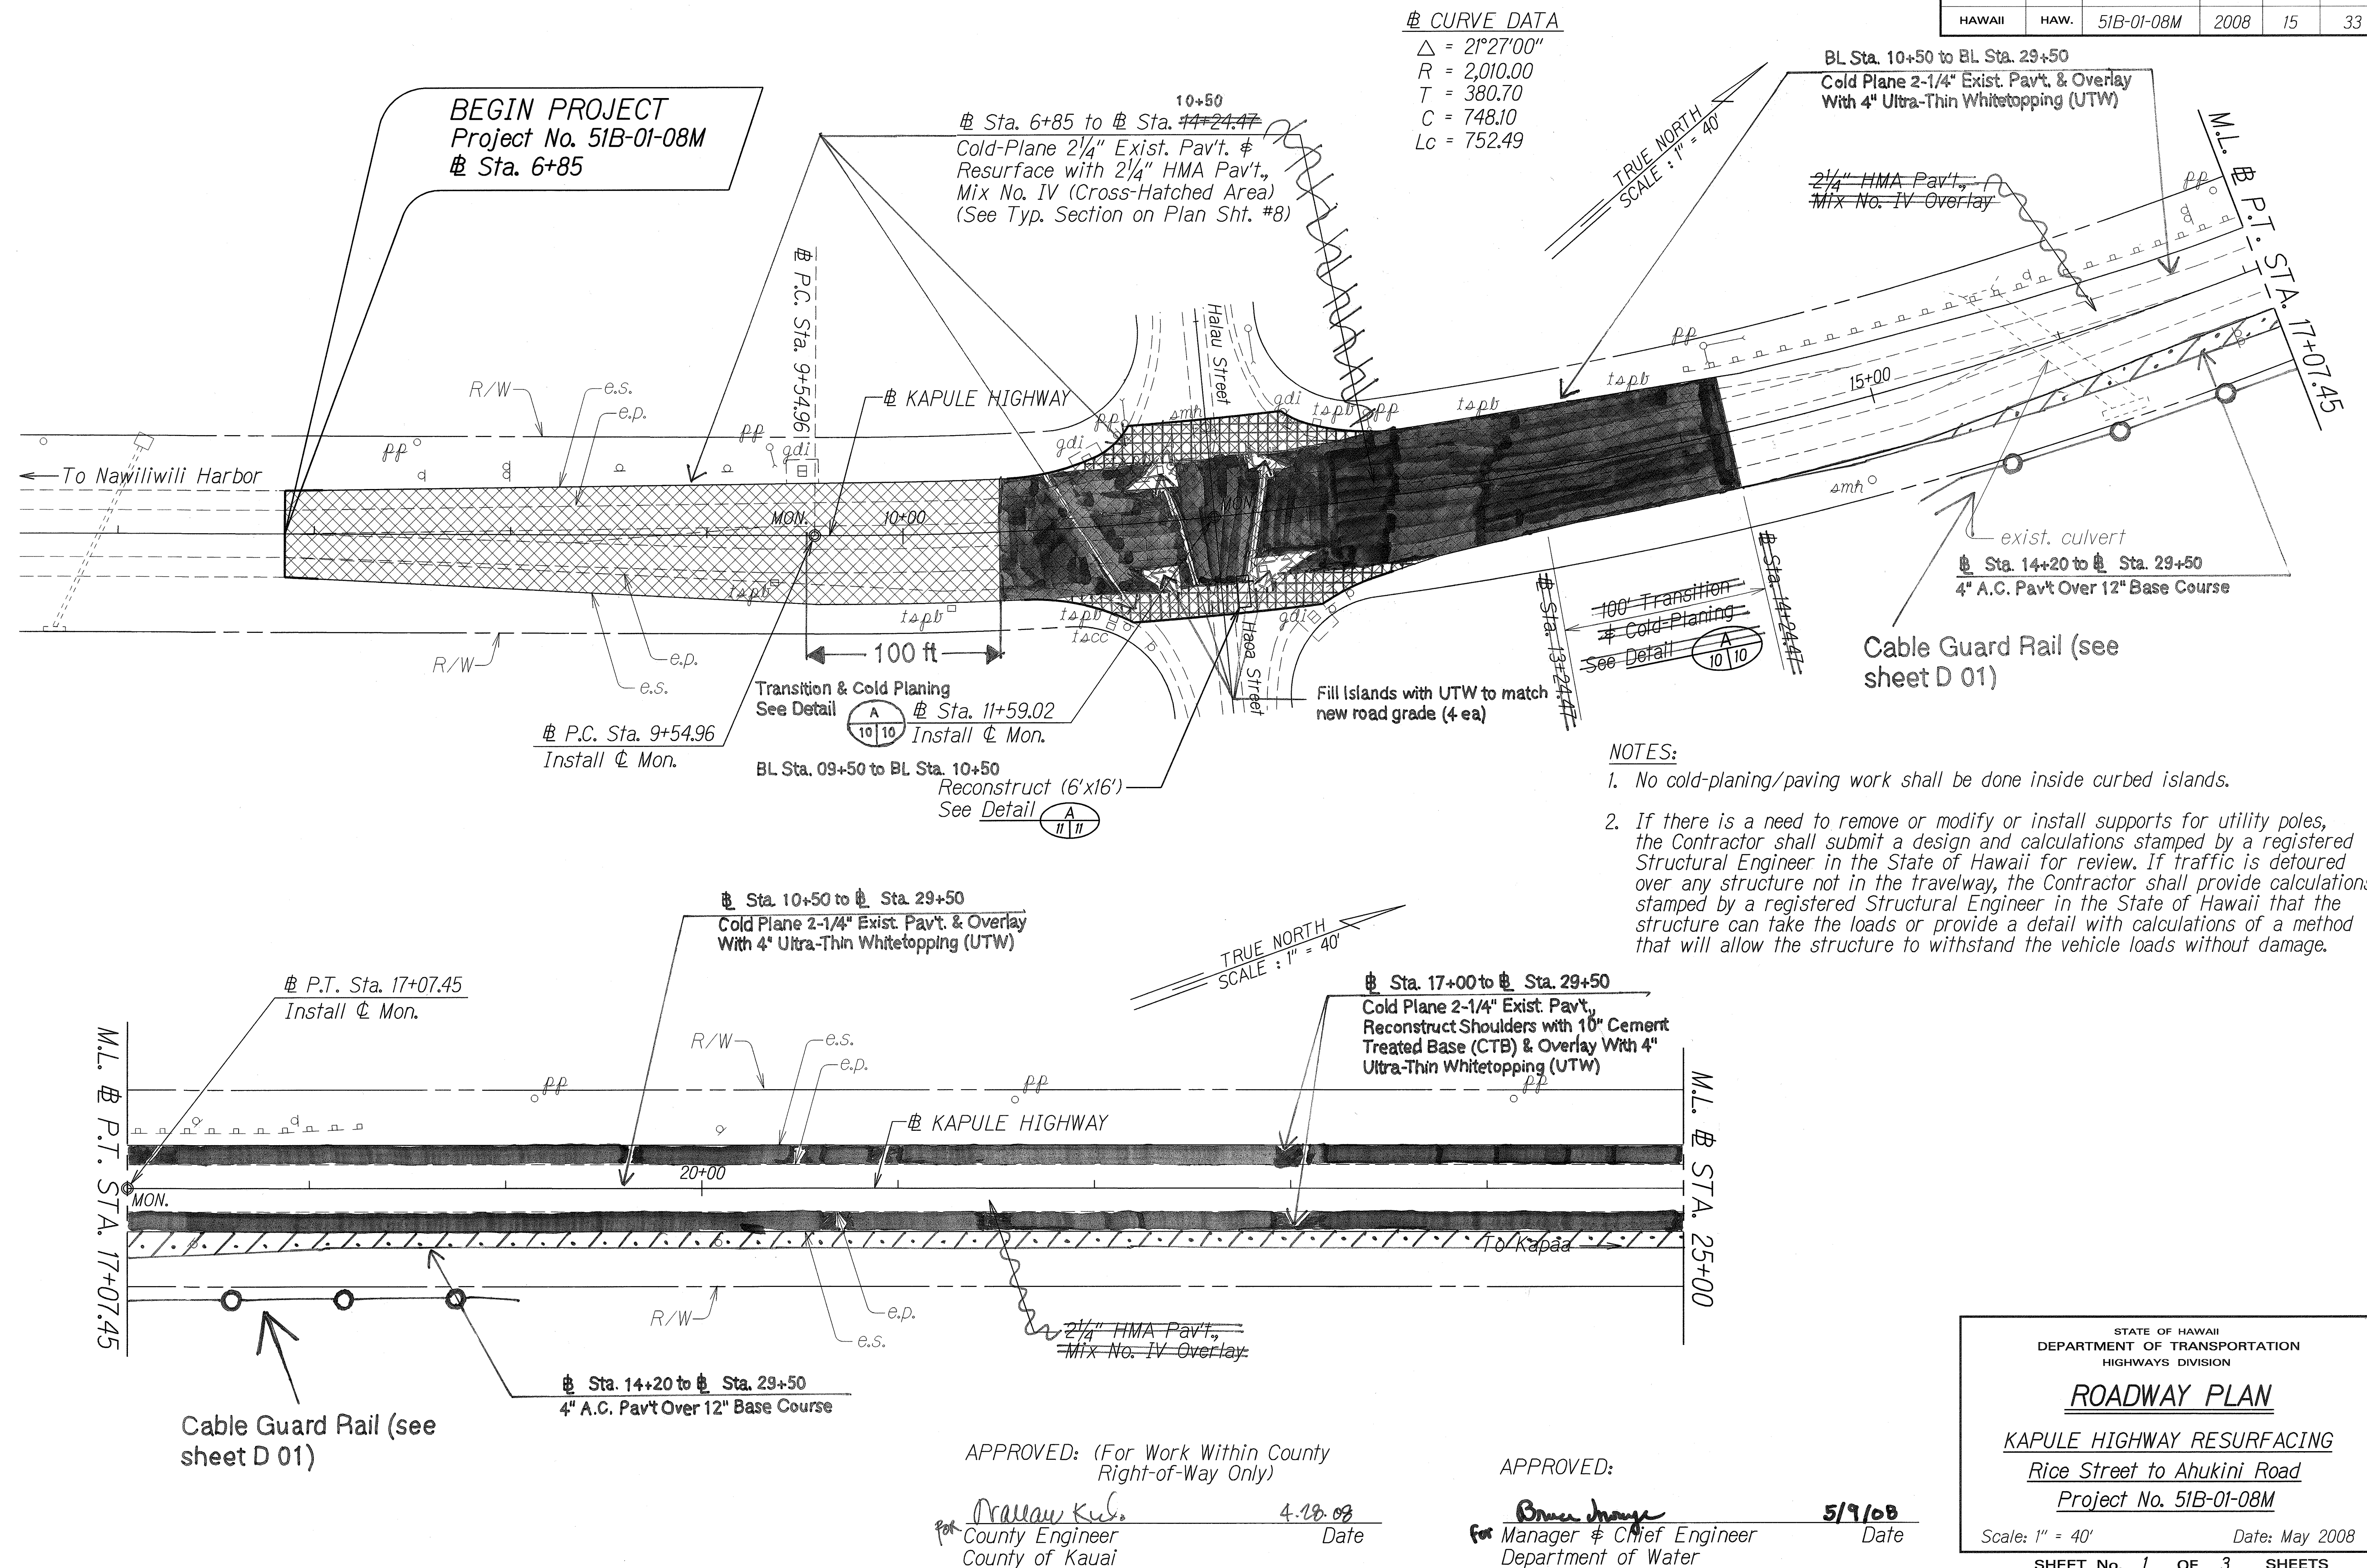

ORIGINAL PLAN	DATE
DRAWN BY	
TRACED BY	
QUANTITIES BY	
CHECKED BY	
NOTES	
NO.	

FED. ROAD DIST. NO.	STATE	PROJ. NO.	FISCAL YEAR	SHEET NO.	TOTAL SHEETS
HAWAII	HAW.	51B-01-08M	2008	16	33

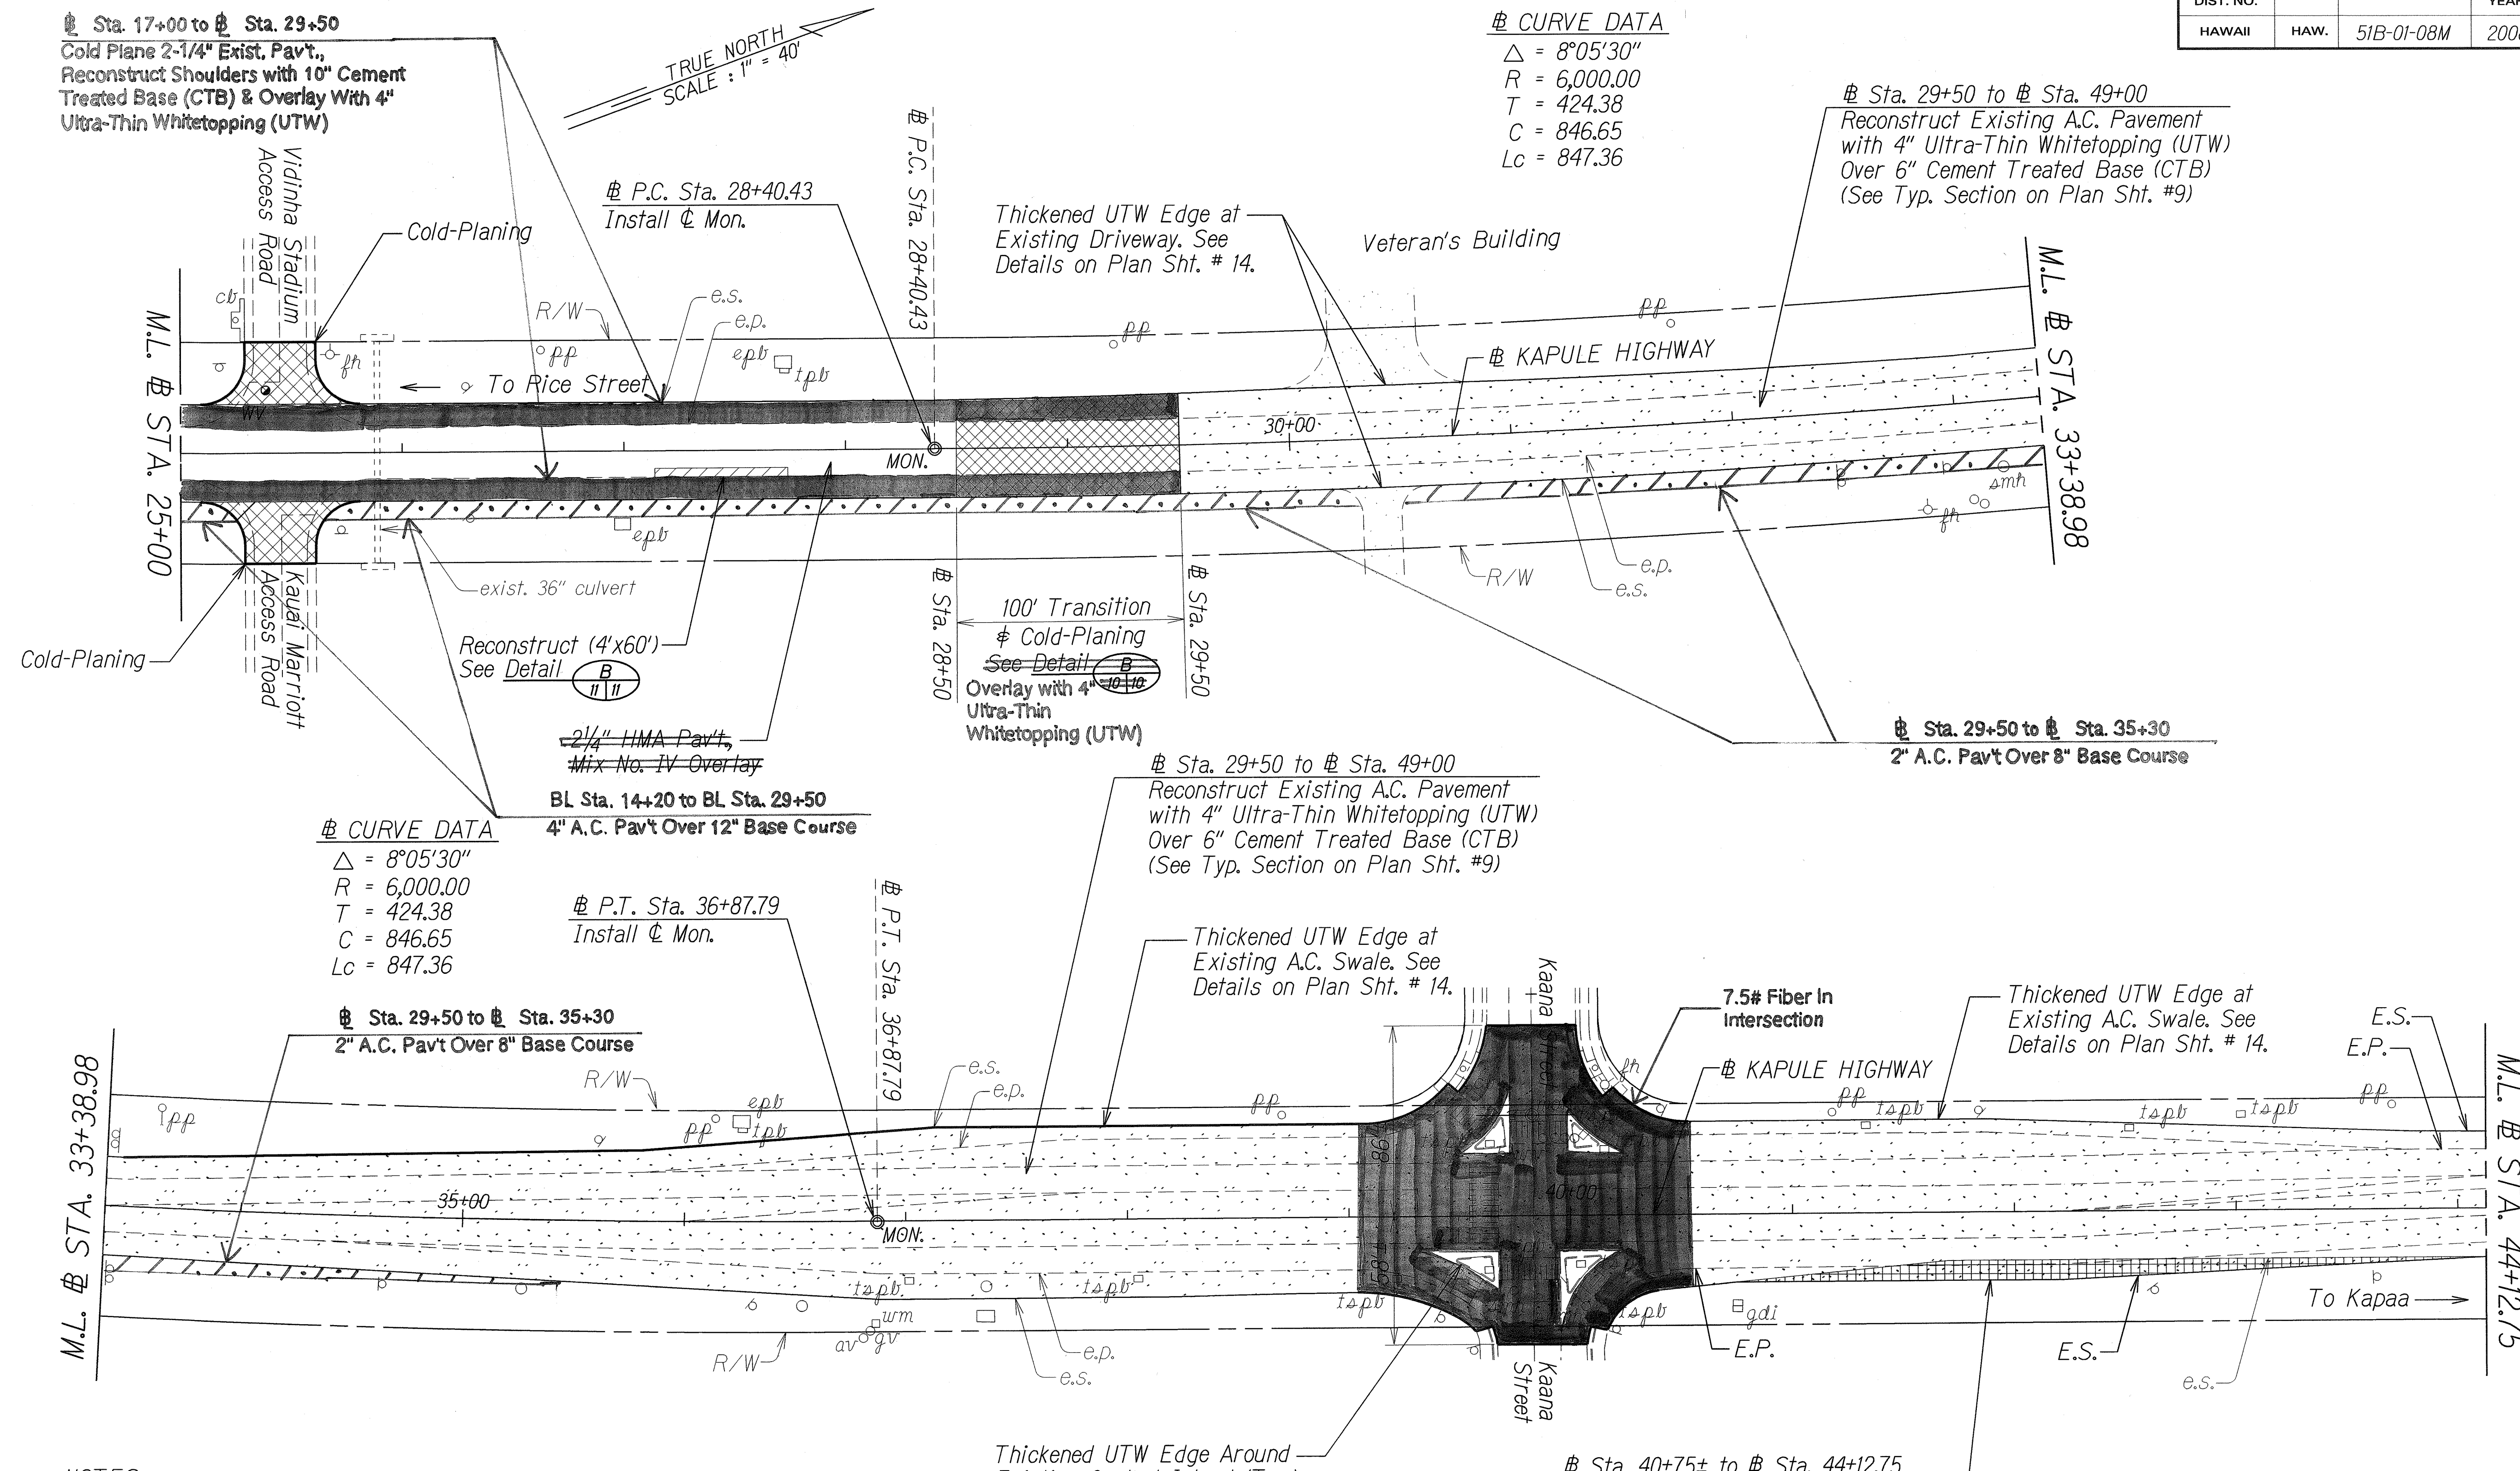

NOTES:

1. No reconstruction work shall be done inside curbed islands.
2. See Plan Sht. #27 for detectable warning plan and details on Kaana Street intersection.
3. See Plan Sht. #14 for reconstruction at existing curbed island locations.

APPROVED: (For Work Within County Right-of-Way Only)

for Nathan Kuo 4.28.08
County Engineer
County of Kauai Date

APPROVED:

for Bruce J. Hays 5/9/08
Manager & Chief Engineer
Department of Water Date

STATE OF HAWAII
DEPARTMENT OF TRANSPORTATION
HIGHWAYS DIVISION

ROADWAY PLAN

KAPULE HIGHWAY RESURFACING

Rice Street to Ahukini Road

Project No. 51B-01-08M



Scale: 1" = 40'

Date: May 2008

SHEET No. 2 OF 3 SHEETS

"AS-BUILT"

FED. ROAD DIST. NO.	STATE	PROJ. NO.	FISCAL YEAR	SHEET NO.	TOTAL SHEETS
HAWAII	HAW.	51B-01-08M	2008	17	33

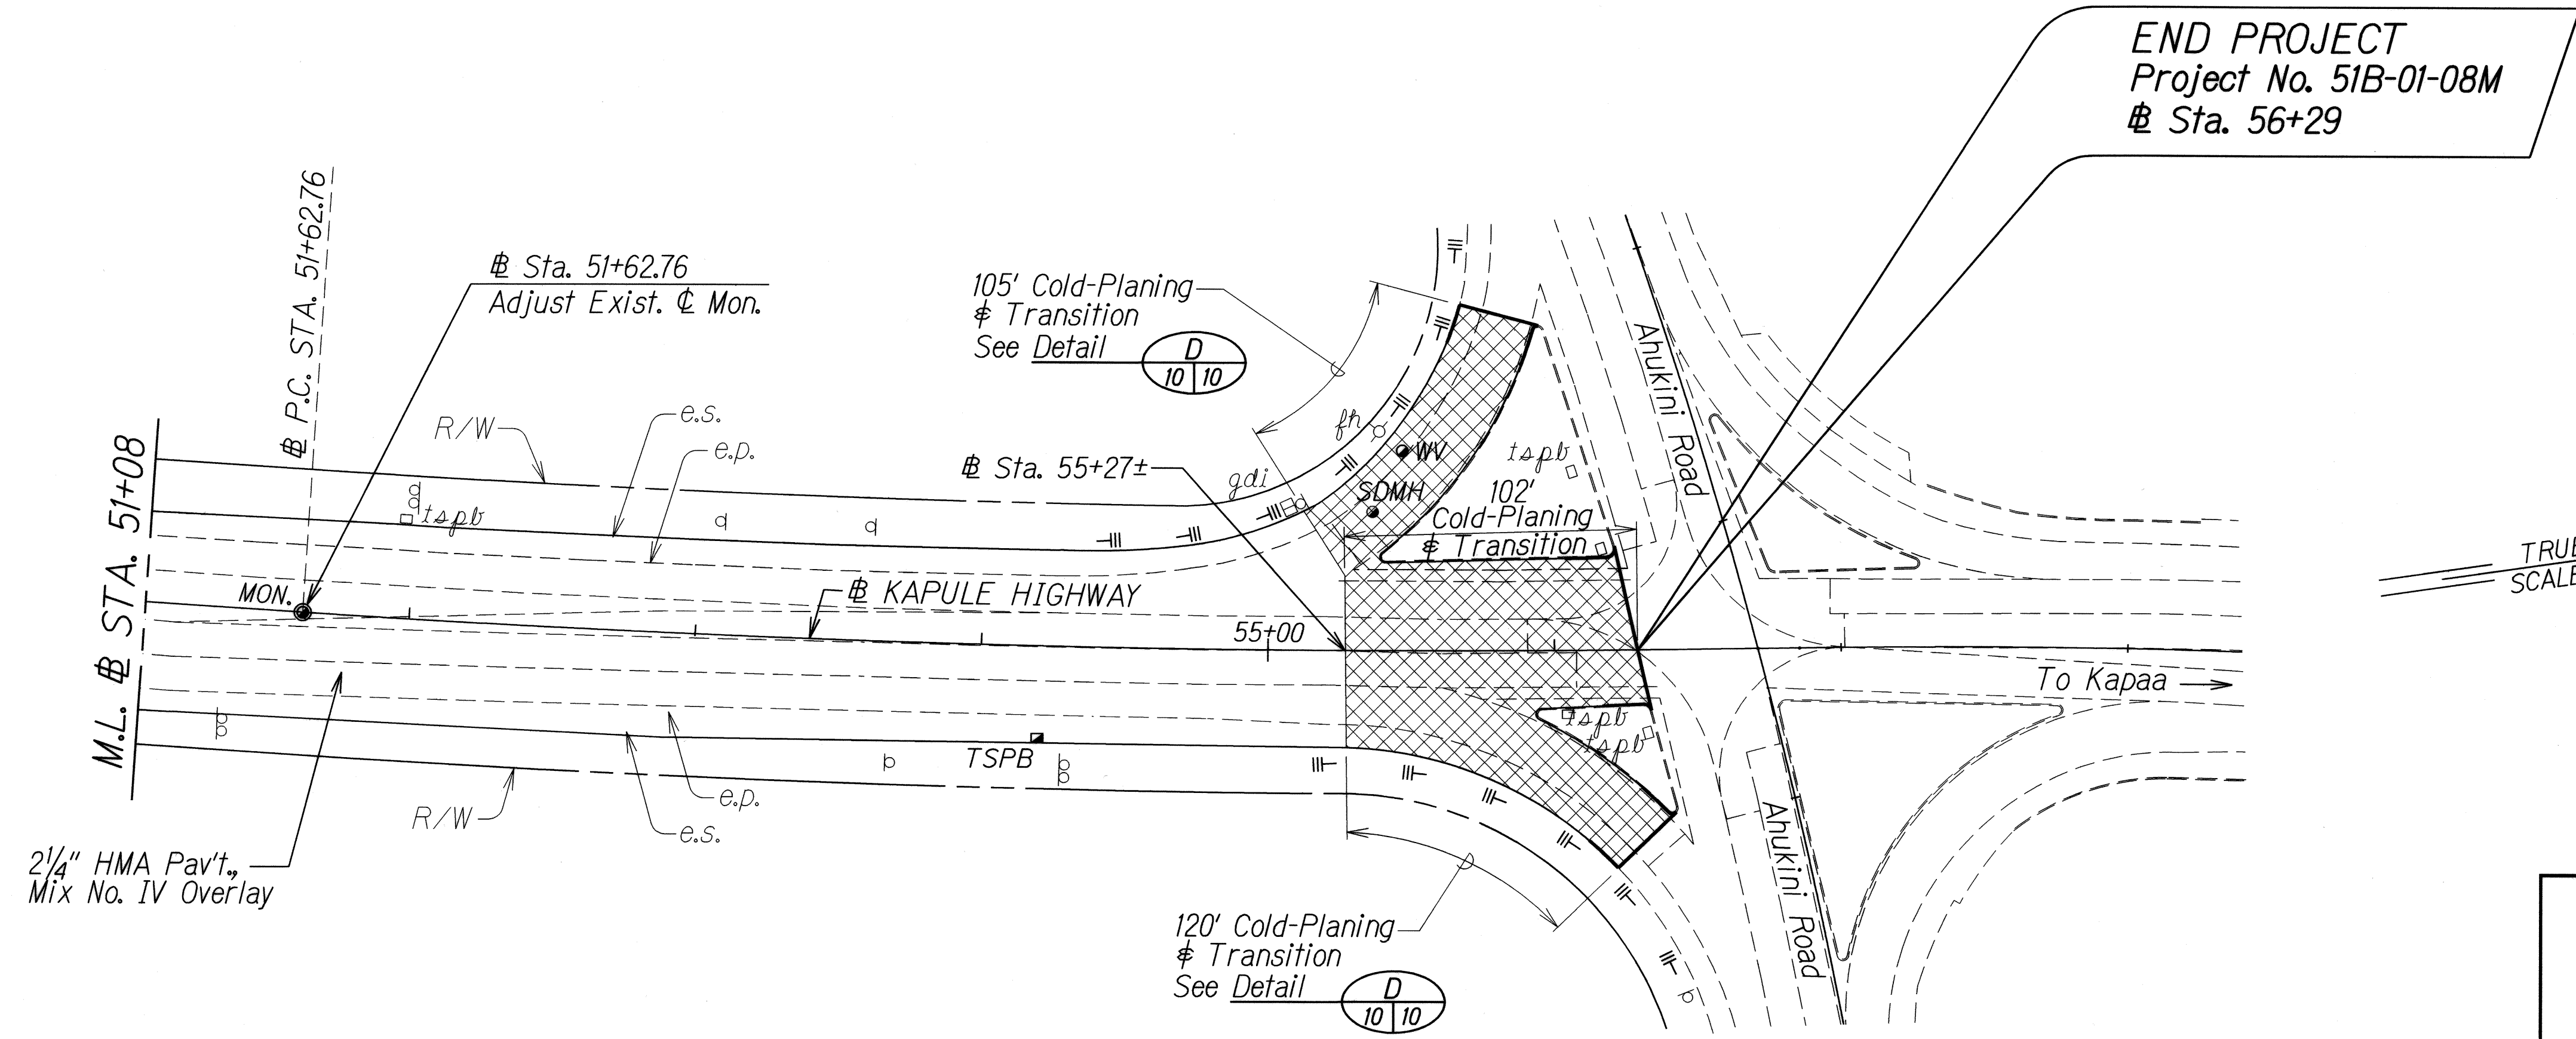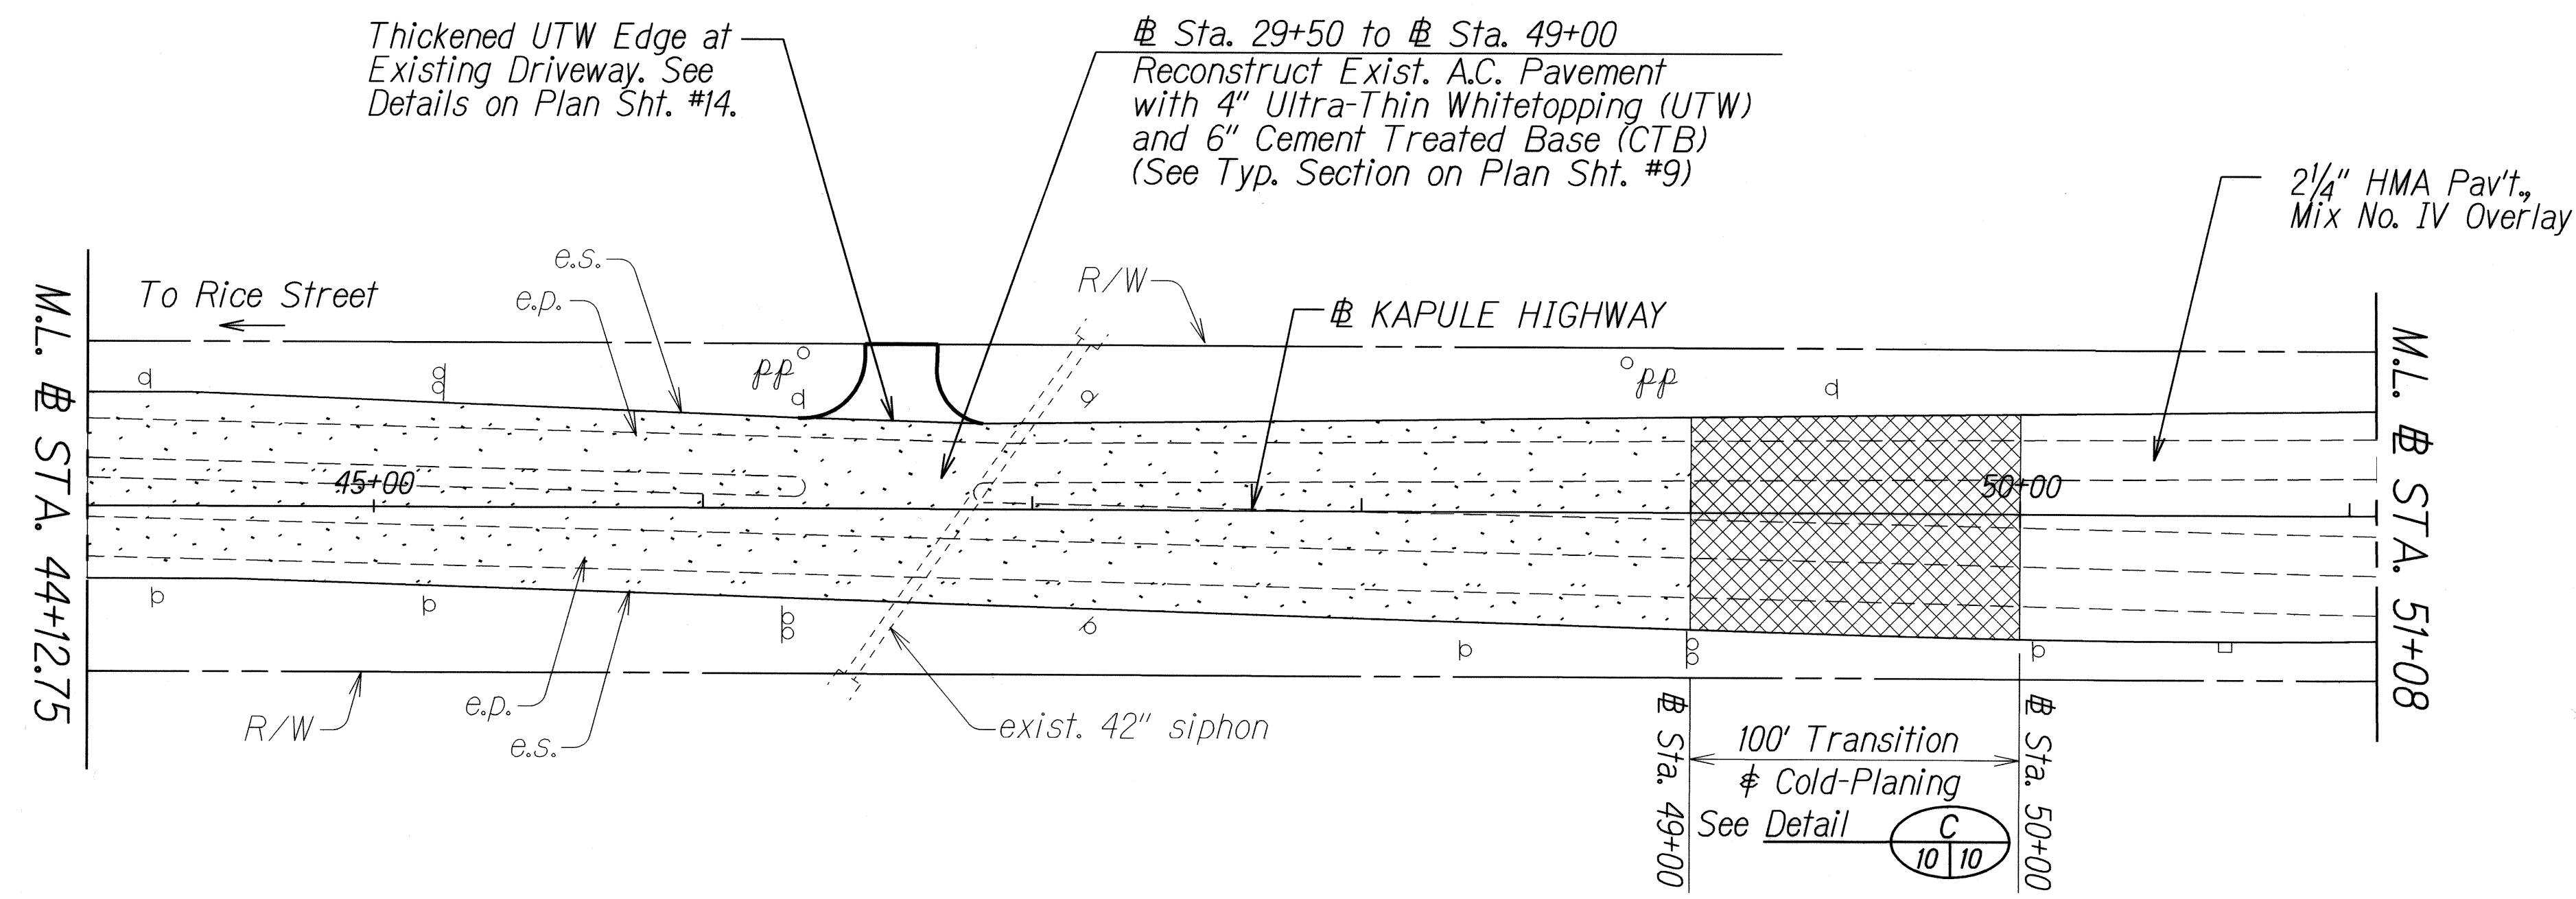

ORIGINAL PLAN	SURVEY PLOTTED BY	DATE
NOTED BY	DRAWN BY	
CHECKED BY	TRACED BY	
	QUANTITIES BY	
	CHECKED BY	

APPROVED:
Bruce Inoué
 for Manager & Chief Engineer
 Department of Water
 5/9/08
 Date

STATE OF HAWAII
DEPARTMENT OF TRANSPORTATION
HIGHWAYS DIVISION

ROADWAY PLAN

KAPULE HIGHWAY RESURFACING

Rice Street to Ahukini Road

Project No. 51B-01-08M

Scale: 1" = 40' Date: May 2008

SHEET No. 3 OF 3 SHEETS